

1

2

3

4

5

6

7

8

A

B

C

D

E

F

CONFIDENTIAL, ALL RIGHTS RESERVED DIN 34

Format ISO/DIN A3

Purpose of Document

Informationfor Approval

Type of Document

As Built

Place for digital signature of Contractor

Place for digital signature of Revisor

AS BUILT

00	As built	Tamara Trogrlić	Antonio Aleksić	Grga Kolić		01.10.2026.
Rev.	Revision Description	Drawn by	Checked by	Approved by Designer	Approved by Contractor	Date

Document No. (CSD)PER-E-8-KA1&KA2-SCH-001-00-VHHR

Employer:



Elektroprivreda Crne Gore AD

Consultant:



HIDROINŽENJERING a.d.

Contractor:



VOITH HYDRO GmbH&CoKG
St. Pölten

Project:

Reconstruction and Modernisation of HPP Perucica - Phase II

Title:

Unit KA1 control cubicle circuit diagrams

Approved by Contractor			Reconstruction and Modernisation of HPP Perucica - Phase II		 Sintaksa - A Voith Company Ulica Domovinskog rata 104C, 21 000 Split, Hrvatska	Unit KA1 control cubicle circuit diagrams	DRAWING No.: PERU-01-19-170-31-001	REV No.: 00	= UACJA10GH100 + UACJA10	
Approved by Designer	Grga Kolić	01.10.2026.				TITLE PAGE	Designer No.:	SALES No.:	PAGE	1
Checked by	Antonio Aleksić	01.10.2026.							PAGE	1 / 156
Drawn by	Tamara Trogrlić	01.10.2026.							PROJECT NAME	EMPLOYER

1

2

3

4

5

6

7

8

1

2

3

4

5

6

7

8

CONFIDENTIAL, ALL RIGHTS RESERVED DIN 34

Format ISO/DIN A3

Page	Page type	Page description	Rev.
2	Table of contents	TABLE OF CONTENTS	
3	Table of contents	TABLE OF CONTENTS	
4	Schematic multi-line	DESIGNATION CODES	
5	Schematic multi-line	AC DISTRIBUTION	
6	Schematic multi-line	DC DISTRIBUTION 220VDC	
7	Schematic multi-line	DC DISTRIBUTION 220VDC	
8	Schematic multi-line	DC DISTRIBUTION 24VDC	
9	Schematic multi-line	DC DISTRIBUTION 24VDC	
10	Schematic multi-line	DC DISTRIBUTION 24VDC	
11	Schematic multi-line	DC DISTRIBUTION 24VDC	
12	Schematic multi-line	PLC CONFIGURATION	
13	Schematic multi-line	PLC CONFIGURATION	
14	Schematic multi-line	PLC CONFIGURATION	
15	Schematic multi-line	PLC DIGITAL INPUTS: INTERNAL SIGNALS	
16	Schematic multi-line	DIGITAL INPUTS: 0.0 - 0.7	
17	Schematic multi-line	DIGITAL INPUTS: 1.0 - 1.7	
18	Schematic multi-line	DIGITAL INPUTS: 2.0 - 2.7	
19	Schematic multi-line	DIGITAL INPUTS: 3.0 - 3.7	
20	Schematic multi-line	DIGITAL INPUTS: 4.0 - 4.7	
21	Schematic multi-line	DIGITAL INPUTS: 5.0 - 5.7	
22	Schematic multi-line	DIGITAL INPUTS: 6.0 - 6.7	
23	Schematic multi-line	DIGITAL INPUTS: 7.0 - 7.7	
24	Schematic multi-line	DIGITAL INPUTS: 8.0 - 8.7	
25	Schematic multi-line	DIGITAL INPUTS: 9.0 - 9.7	
26	Schematic multi-line	DIGITAL INPUTS: 10.0 - 10.7	
27	Schematic multi-line	DIGITAL INPUTS: 11.0 - 11.7	
28	Schematic multi-line	DIGITAL INPUTS: 12.0 - 12.7	
29	Schematic multi-line	DIGITAL INPUTS: 13.0 - 13.7	
30	Schematic multi-line	DIGITAL INPUTS: 14.0 - 14.7	
31	Schematic multi-line	DIGITAL INPUTS: 15.0 - 15.7	
32	Schematic multi-line	DIGITAL INPUTS: 16.0 - 16.7	
33	Schematic multi-line	DIGITAL INPUTS: 17.0 - 17.7	
34	Schematic multi-line	DIGITAL INPUTS: 18.0 - 18.7	
35	Schematic multi-line	DIGITAL INPUTS: 19.0 - 19.7	
36	Schematic multi-line	DIGITAL OUTPUTS: 0.0 - 0.7	
37	Schematic multi-line	DIGITAL OUTPUTS: 1.0 - 1.7	
38	Schematic multi-line	DIGITAL OUTPUTS: 2.0 - 2.7	
39	Schematic multi-line	DIGITAL OUTPUTS: 3.0 -3.7	
40	Schematic multi-line	DIGITAL OUTPUTS: 4.0 - 4.7	
41	Schematic multi-line	DIGITAL OUTPUTS: 5.0 - 5.7	

Page	Page type	Page description	Rev.
42	Schematic multi-line	DIGITAL OUTPUTS: 6.0 - 6.7	
43	Schematic multi-line	DIGITAL OUTPUTS: 7.0 - 7.7	
44	Schematic multi-line	ANALOG INPUTS: 1 - 4	
45	Schematic multi-line	ANALOG INPUTS: 5 - 8	
46	Schematic multi-line	ANALOG OUTPUTS: 1 - 2	
47	Schematic multi-line	ANALOG OUTPUTS: 3 - 4	
48	Schematic multi-line	SPEED MEASUREMENT	
49	Schematic multi-line	HPU CONTROL	
50	Schematic multi-line	HPU CONTROL	
51	Schematic multi-line	ESD VALVE CONTROL	
52	Schematic multi-line	MIV CONTROL 24VDC	
53	Schematic multi-line	LOCAL CONTROL	
54	Schematic multi-line	CB CONTROL	
55	Schematic multi-line	EXCITATION CB TRIP COMMAND	
56	Schematic multi-line	EMERGENCY SHUTDOWN	
57	Schematic multi-line	EMERGENCY SHUTDOWN	
58	Schematic multi-line	GENERATOR PROTECTION ESD	
59	Schematic multi-line	SYNCHRONIZATION CONTROL	
60	Schematic multi-line	SYNCHRONIZATION CONTROL	
61	Schematic multi-line	SYNCHRONIZATION	
62	Schematic multi-line	SYNCHRONIZATION	
63	Schematic multi-line	SYNCHRONIZATION	
64	Schematic multi-line	SYNCHRONIZATION	
65	Schematic multi-line	SIGNALIZATION - EXCITATION	
66	Schematic multi-line	SIGNALIZATION - PROTECTION	
67	Schematic multi-line	SIGNALIZATION	
68	Schematic multi-line	SIGNAL COLUMN	
69	Schematic multi-line	ALARM ANNUCIATOR - ALARM	
70	Schematic multi-line	ALARM ANNUCIATOR - TRIP	
71	Schematic multi-line	ALARM ANNUCIATOR - TRIP	
72	Schematic multi-line	SPARE CONTACTS	
73	Schematic multi-line	CT CIRCUITS	
74	Schematic multi-line	VT CIRCUITS	
75	Schematic multi-line	VT CIRCUITS	
76	Schematic multi-line	VT CIRCUITS	
77	Schematic multi-line	VT CIRCUITS	
78	Schematic multi-line	SWITCH	
79	Schematic multi-line	COMMUNICATION	
80	Overview	HMI - TOUCH PANEL	
81	Overview	PLC OVERVIEW	

Approved by Contractor			Reconstruction and Modernisation of HPP Perucica - Phase II		 A Voith Company Sintaksa - A Voith Company Ulica Domovinskog rata 104C, 21 000 Split, Hrvatska	Unit KA1 control cubicle circuit diagrams	DRAWING No.:	REV No.:	= UACJA10GH100
Approved by Designer	Grga Kolić	01.10.2026.					PERU-01-19-170-31-001	02	+ UACJA10
Checked by	Antonio Aleksić	01.10.2026.					Designer No.:	SALES No.:	PAGE 2
Drawn by	Tamara Trogrlić	01.10.2026.					PROJECT NAME	EMPLOYER	DESIGNER

1

2

3

4

5

6


7

8

1		2		3		4		5		6		7		8			
A	CONFIDENTIAL, ALL RIGHTS RESERVED DIN 34																A
	Format ISO/DIN A3																
B																	B
C																	C
D																	D
E																	E
F																	F
1		2		3		4		5		6		7		8			
1		2		3		4		5		6		7		8			
1		2															

1		2		3		4		5		6		7		8									
A																A							
		SYSTEM/EQUIPMENT				DEVICE				DOCUMENT				CIRCUIT DIAGRAM INDEX				WIRE AND CABLE COLOURS					
B		=UAMKC10GH100+UAMKC11 =UACHA10GH100+UACHA10 =0UA01+UV01 EXCITATION PROTECTION VIBRATION MONITORING				A - Assemblies, subassemblies B - Transducers from non-electric to electric quantities or vice versa C - Capacitors D - Binary elements E - Miscellaneous F - Protective devices G - Generators, power supplies H - Signaling devices J - K - Relays, contactors L - Inductors, reactors M - Motors N - Amplifiers, controllers P - Measuring instruments, test equipment Q - Switching devices for power circuits R - Resistors S - Switches for control circuits, selectors T - Transformers U - Modulators V - Tubes, semiconductors W - Transmission paths, cables, busbars, antennas X - Terminals, plugs, sockets Y - Electrically operated mechanical devices Z - Terminations, hybrid transformers, filters, equilizers, limiters 100..199 - Station services 200..299 - Control 300..399 - Protection 400..499 - Measuring 500..599 - Freely disposable				001...099 - Text documents, chapters 100...999 - Drawings: Block-diagrams, Single line diagrams, General arrangement drawings, Circuit diagrams, Cubicle layouts, Cubicle assigned drawings, Cable lists, cable core lists, Grounding and lightning, Unassigned drawings,				A - Indexes, title sheet, document list B - Function diagrams C - Designation code D - AC power supply (heating, lighting voltage distribution, fuses...) E - F - G - DC power supply (voltage distribution...) H - Signaling devices J - K - L - Operating mechanisms for switching devices (circuit breakers, disconnectors...) M - Control (local, remote, station...) N - Protection P - Interlocking Q - Position indication (local, remote, station...) R - Alarm (signaling, monitoring...) S - Instruments transformers circuits (measuring, protection...) T - Measuring (local, remote station... unless under "S") U - Feedback control (voltage regulator...) V - Communication W - Wiring diagrams, terminal matrix X - Cable list, cable core list Y - Z - Equipment documents for "C" to "W"				BK - Black BN - Brown RD - Red OG - Orange YE - Yellow GN - Green BU - Blue VT - Violet GY - Grey WH - White PK - Pink TO - Turquoise GNYE - Green yellow LB - Light Blue				B	
C																							
D																							
E																							
F																							
G																							
H																							
I																							
J																							
K																							
L																							
M																							
N																							
O																							
P																							
Q																							
R																							
S																							
T																							
U																							
V																							
W																							
X																							
Y																							
Z																							
AA																							
AB																							
AC																							
AD																							
AE																							
AF																							
AG																							
AH																							
AI																							
AJ																							
AK																							
AL																							
AM																							
AN																							
AO																							
AP																							
AQ																							
AR																							
AS																							
AT																							
AU																							
AV																							
AW																							
AX																							
AY																							
AZ																							
BA																							
BB																							
BC																							
BD																							
BE																							
BF																							
BG																							
BH																							
BI																							
BJ																							
BK																							
BL																							
BM																							
BN																							
BO																							
BP																							
BQ																							
BR																							
BS																							
BT																							
BU																							
BV																							
BW																							
BX																							
BY																							
BZ																							
CA																							
CB																							
CC																							
CD																							
CE																							
CF																							
CG																							
CH																							
CI																							
CJ																							
CK																							
CL																							
CM																							
CN																							
CO																							
CP																							
CQ																							
CR																							
CS																							
CT																							
CU																							
CV																							
CW																							
CX																							
CY																							
CZ																							
DA																							
DB																							
DC																							
DD																							
DE																							
DF																							
DG																							
DH																							
DI																							
DJ																							
DK																							
DL																							
DM																							
DN																							
DO																							
DP																							
DQ																							
DR																							
DS																							
DT																							
DU																							
DV																							
DW																							
DX																							
DY																							
DZ																							
EA																							
EB																							
EC																							
ED																							
EE																							
EF																							
EG																							
EH																							
EI																							
EJ																							
EK																							
EL																							
EM																							
EN																							
EO																							
EP																							
EQ																							
ER																							
ES																							
ET																							
EU																							
EV																							
EW																							
EX																							
EY																							
EZ																							
FA																							
FB																							
FC																							
FD																							
FE																							
FF																							
FG																							
FH																							
FI																							
FJ																							
FK																							
FL																							
FM																							
FN																							
FO																							
FP																							
FQ																							
FR																							
FS																							
FT																							
FU																							
FV																							
FW																							
FX																							
FY																							
FZ																							
GA																							
GB																							
GC																							
GD																							
GE																							
GF																							
GG																							
GH																							
GI																							
GJ																							
GK																							
GL																							
GM																							
GN																							
GO																							
GP																							
GQ																							
GR																							
GS																							
GT																							
GU																							
GV																							
GW																							
GX																							
GY																							
GZ																							
HA																							
HB																							
HC																							
HD																							
HE																							
HF																							
HG																							
HH																							
HI																							
HJ																							
HK																							
HL																							
HM																							
HN																							
HO																							
HP																							
HQ																							
HR																							
HS																							
HT																							
HU																							
HV																							
HW																							
HX																							
HY																							
HZ																							
IA																							
IB																							
IC																							
ID																							
IE																							
IF																							
IG																							
IH																							
II																							
IJ																							
IK																							
IL																							
IM																							
IN																							
IO																							
IP																							
IQ																							
IR																							
IS																							
IT																							
IU																							
IV																							
IW																							
IX																							
IY																							
IZ																							
JA																							
JB																							
JC																							
JD																							
JE																							
JF																							
JG																							
JH																							
JI																							
JJ																							
JK																							
JL																							
JM																							
JN																							
JO																							
JP																							
JQ																							
JR																							
JS																							
JT																							
JU																							
JV																							
JW																							
JX																							
JY																							
JZ																							
KA																							
KB																							
KC																							
KD																							
KE																							
KF																							
KG																							
KH																							
KI																							
KJ																							
KK																							
KL																							
KM																							
KN																							
KO																							
KP																							
KQ																							
KR																							
KS																							
KT																							
KU																							
KV																							
KW																							
KX																							
KY																							
KZ																							
LA																							
LB																							
LC																							
LD																							
LE																							
LF																							
LG																							
LH																							
LI																							
LJ																							
LK																							
LL																							
LM																							
LN																							
LO																							
LP																							
LQ																							
LR																							
LS																							
LT																							
LU																							
LV																							
LW																							
LX																							
LY																							
LZ																							
MA																							
MB																							
MC																							
MD																							
ME																							
MF																							
MG																							
MH																							
MI																							
MJ																							
MK																							
ML																							
MM																							
MN																							
MO																							
MP																							
MQ																							
MR																							
MS																							
MT																							
MU																							
MV																							
MW																							
MX																							
MY																							
MZ																							
NA																							
NB																							
NC																							
ND																							
NE																							
NF																							
NG																							
NH																							
NI																							
NJ																							
NK																							
NL																							
NM																							
NN																							
NO																							
NP																							
NQ																							
NR																							
NS																							
NT																							
NU																							
NV																							
NW																							
NX																							
NY																							
NZ																							
OA																							
OB																							
OC																							
OD																							
OE																							
OF																							
OG																							
OH																							
OI																							
OJ																							
OK																							
OL																							
OM																							
ON																							
OO																							
OP																							
OQ																							
OR																							
OS																							
OT																							
OU																							
OV																							
OW																							
OX																							
OY																							
OZ																							
PA																							
PB																							
PC																							
PD																							
PE																							
PF																							
PG																							
PH																							
PI																							
PJ																							
PK																							
PL																							
PM																							
PN																							
PO																							
PP																							
PQ																							
PR																							
PS																							
PT																							
PU																							
PV																							
PW																							
PX																							
PY																							
PZ																							
QA																							
QB																							
QC																							
QD																							
QE																							
QF																							
QG																							
QH																							
QI																							
QJ																							
QK																							
QL																							
QM																							
QN																							
QO																							
QP																							
QQ																							
QR																							
QS																							
QT																							
QU																							
QV																							
QW																							
QX																							
QY																							
QZ																							
RA																							
RB																							
RC																							
RD																							
RE																							
RF																							
RG																							
RH																							
RI																							
RJ																							
RK																							
RL																							
RM																							
RN																							
RO																							
RP																							
RQ																							
RR																							
RS																							
RT																							
RU																							
RV																							
RW																							
RX																							
RY																							
RZ																							
SA																							
SB																							
SC																							
SD																							
SE																							
SF																							
SG																							
SH																							
SI																							
SJ																							
SK																							
SL																							
SM																							
SN																							
SO																							
SP																							
SQ																							
SR																							
SS																							
ST																							
SU																							
SV																							
SW																							
SX																							
SY																							
SZ																							
TA																							
TB																							
TC																							
TD																							
TE																							
TF																							
TG																							
TH																							
TI																							
TJ																							
TK																							
TL																							
TM																							
TN																							
TO																							
TP																							
TQ																							
TR																							
TS																							
TT																							
TU																							
TV																							
TW																							
TX																							
TY																							
TZ																							
UA																							
UB																							
UC																							
UD																							
UE																							
UF																							
UG																							
UH																							
UI																							
UJ																							
UK																							
UL																							
UM																							
UN																							
UO																							
UP																							
UQ																							
UR																							
US																							
UT																							
UU																							
UV																							
UW																							
UX																							
UY																							
UZ																							
VA																							
VB																							
VC																							
VD																							
VE																							
VF																							
VG																							
VH																							
VI																							
VJ																							
VK																							
VL																							
VM																							
VN																							
VO																							
VP																							
VQ																							
VR																							
VS																							
VT																							
VU																							
VV																							
VW																							
VX																							
VY																							
VZ																							
WA																							
WB																							
WC																							
WD																							
WE																							
WF																							
WG																							
WH																							
WI																							
WJ																							
WK																							
WL																							
WM																							
WN																							
WO																							
WP																							
WQ																							
WR																							
WS																							
WT																							
WU																							
WV																							
WW																							
WX																							
WY																							
WZ																							
XA																							
XB																							
XC																							
XD																							
XE																							
XF																							
XG																							
XH																							
XI																							
XJ																							
XK																							
XL																							
XM																							
XN																							
XO																							
XP																							
XQ																							
XR																							
XS																							
XT																							
XU																							
XV																							
XW																							
XX																							
XY																							
XZ																							
YA																							
YB																							
YC																							
YD																							
YE																							
YF																							
YG																							
YH																							
YI																							
YJ																							
YK																							
YL																							
YM																							
YN																							
YO																							
YP																							
YQ																							
YR																							
YS																							
YT																							
YU																							
YV																							
YW																							
YX																							
YY																							
YZ																							
ZA																							
ZB																							
ZC																							
ZD																							
ZE																							
ZF																							
ZG																							
ZH																							
ZI																							
ZJ																							
ZK																							
ZL																							
ZM																							
ZN																							
ZO																							
ZP																							
ZQ																							
ZR																							
ZS																							
ZT																							
ZU																							
ZV																							
ZW																							
ZX																							
ZY																							
ZZ																							
AA																							
AB																							
AC																							
AD																							
AE																							
AF																							
AG																							
AH																							
AI																							
AJ																							
AK																							
AL																							
AM																							
AN																							
AO																							
AP																							
AQ																							
AR																							
AS																							
AT																							
AU																							
AV																							
AW																							
AX																							
AY																							
AZ																							
BA																							
BB																							
BC																							
BD																							
BE																							
BF																							
BG																							
BH																							
BI																							
BJ																							
BK																							
BL																							
BM																							
BN																							
BO																							
BP																							
BQ																							
BR																							
BS																							
BT																							
BU																							
BV																							
BW																							
BX																							
BY																							
BZ																							
CA																							
CB																							
CC																							
CD																							
CE																							
CF																							
CG																							
CH																							
CI																							
CJ																							
CK																							
CL																							
CM																							
CN																							
CO																							
CP																							
CQ																							
CR																							
CS																							
CT																							
CU																							
CV																							
CW																							
CX																							
CY																							
CZ																							
DA																							
DB																							
DC																							
DD																							
DE																							
DF																							
DG																							
DH																							
DI																							
DJ																							
DK																							
DL																							
DM																							
DN																							
DO																							
DP																							
DQ																							
DR																							
DS																							
DT																							
DU																							
DV																							
DW																							
DX																							
DY																							
DZ																							
EA																							
EB																							
EC																							
ED																							
EE																							
EF																							
EG																							
EH																							
EI																							
EJ																							
EK																							
EL																							
EM																							
EN																							
EO																							
EP																							
EQ																							
ER																							
ES																							
ET																							
EU																							
EV																							
EW																							
EX																							
EY																							
EZ																							
FA																							
FB																							
FC																							
FD																							
FE																							
FF																							
FG																							
FH																							
FI																							
FJ																							
FK																							
FL																							
FM																							
FN																							
FO																							
FP																							
FQ																							
FR																							
FS																							
FT																							
FU																							
FV																							
FW																							
FX																							
FY																							
FZ																							
GA																							
GB																							
GC																							
GD																							
GE																							
GF																							
GG																							
GH																							




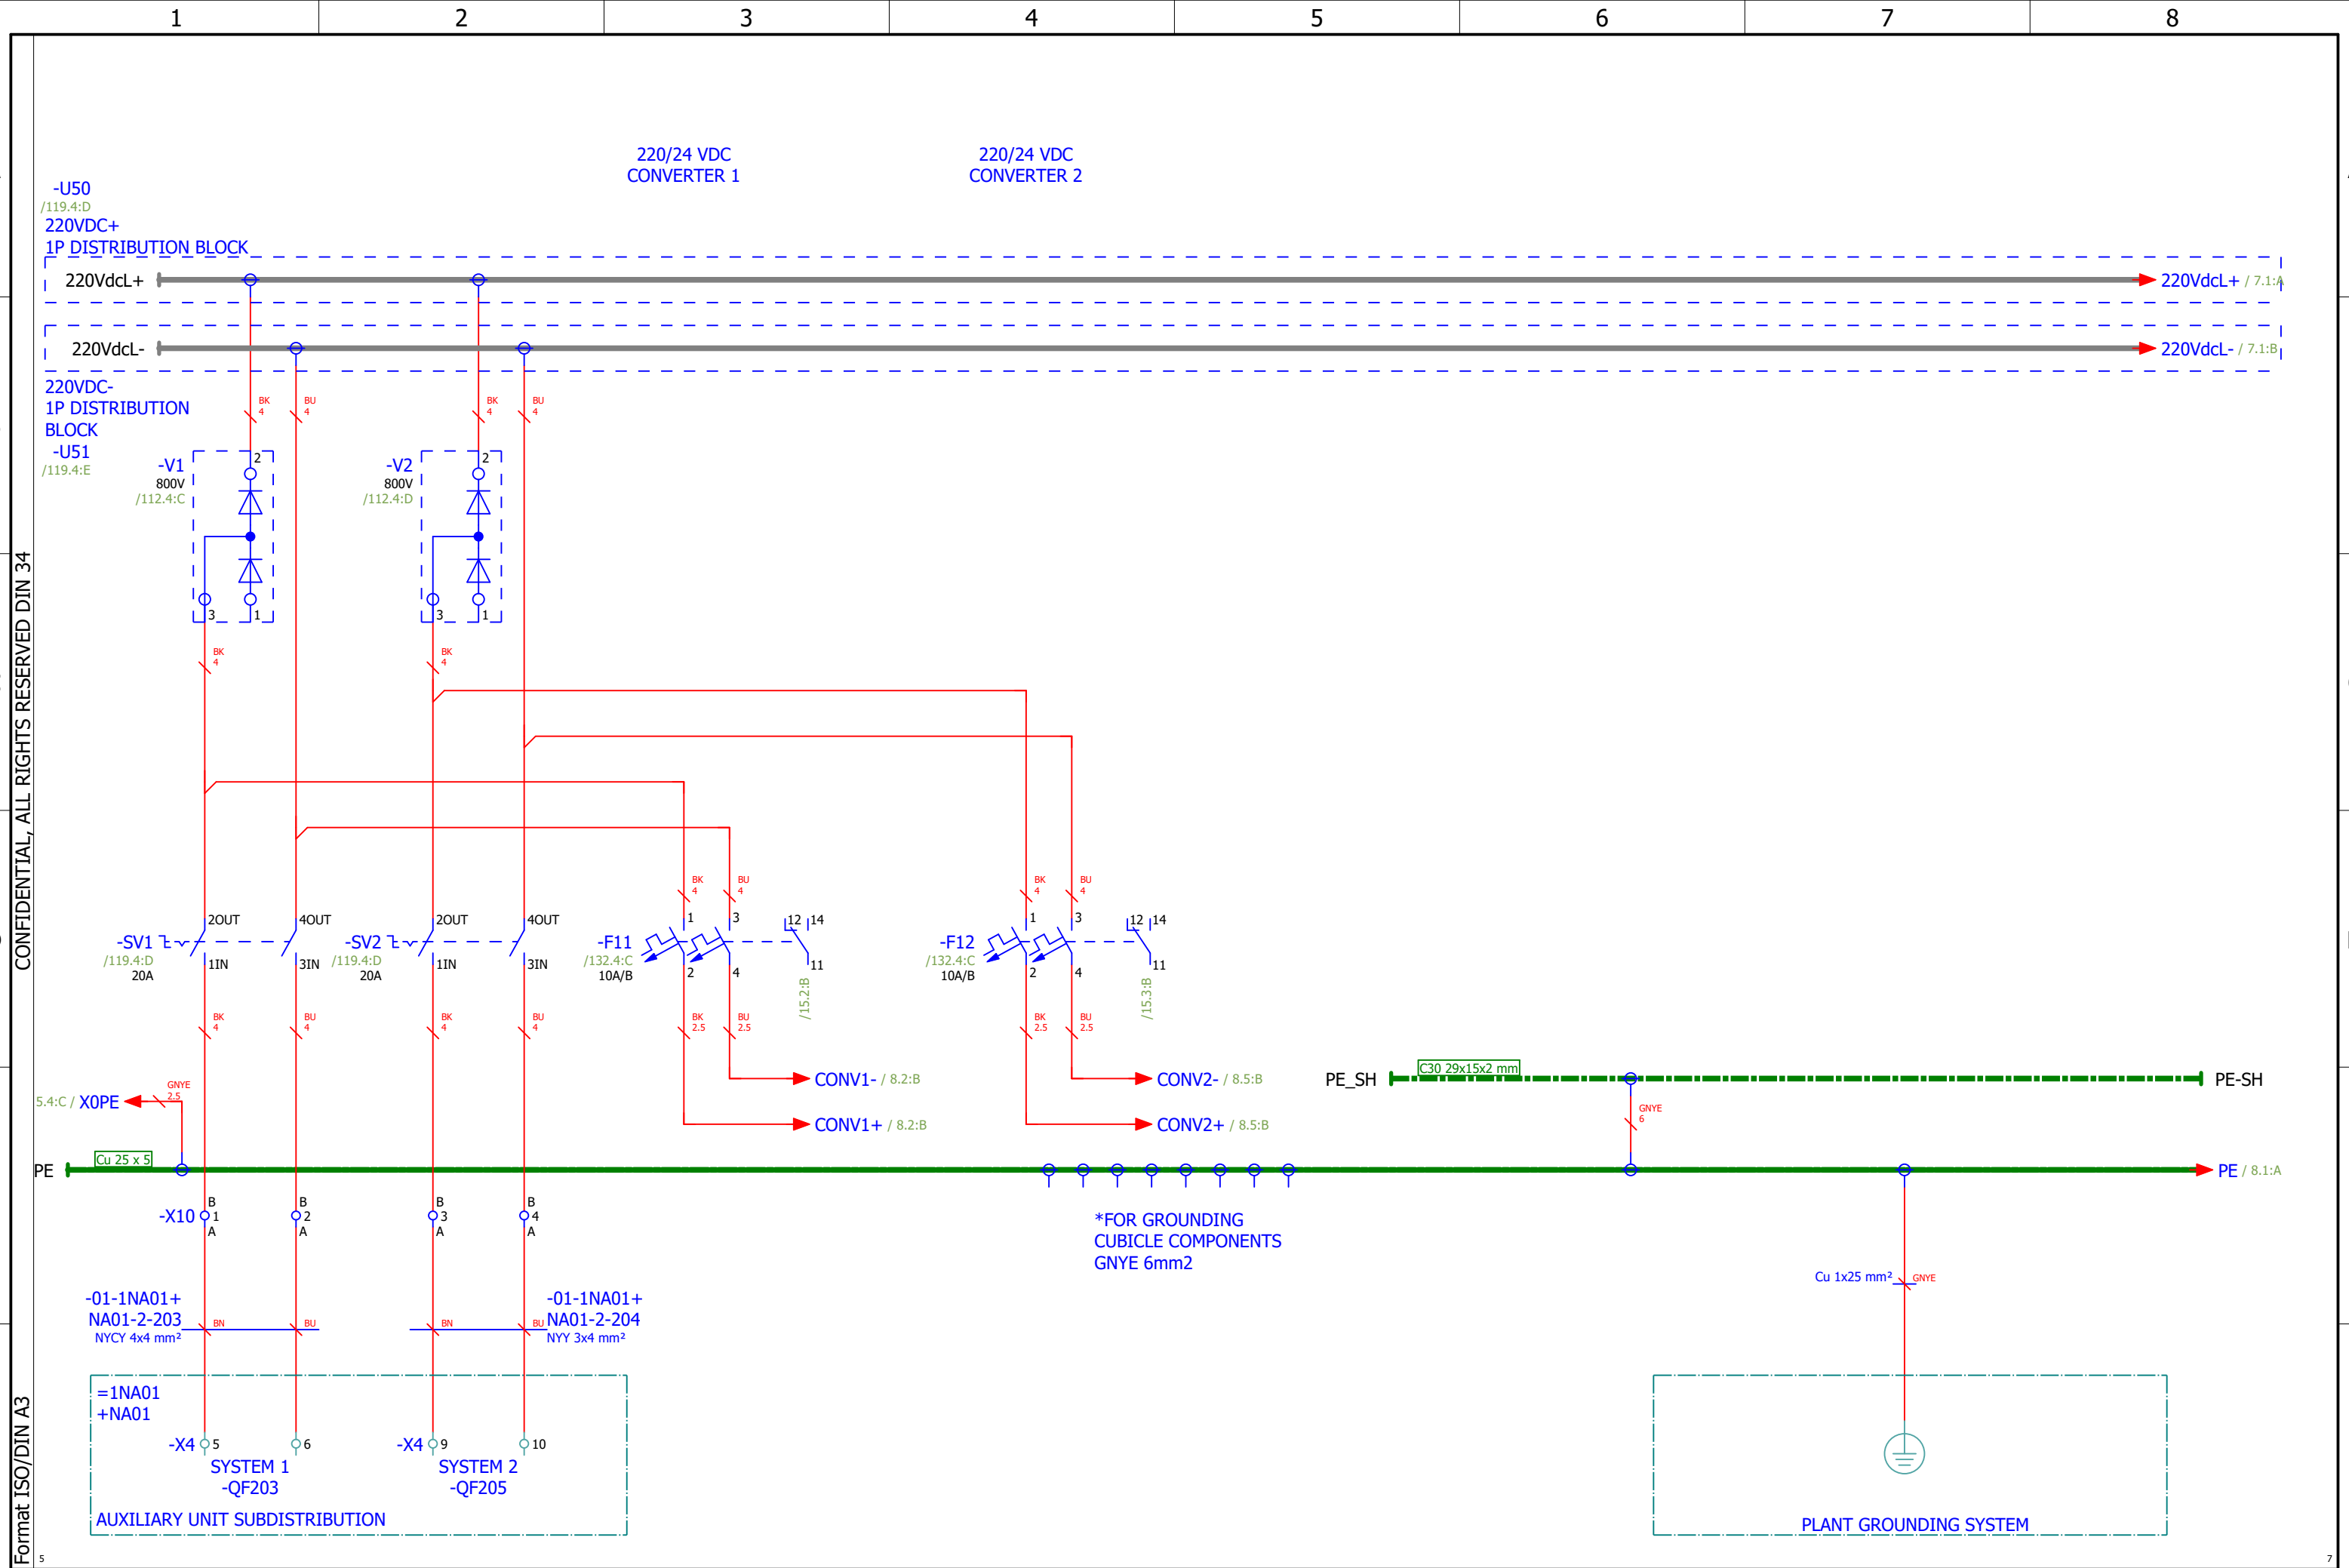

Approved by Contractor			Reconstruction and Modernisation of HPP Perucica - Phase II		 Sintaksa - A Voith Company Ulica Domovinskog rata 104C, 21 000 Split, Hrvatska	Unit KA1 control cubicle circuit diagrams	DRAWING No.: PERU-01-19-170-31-001	REV No.: 02	= UACJA10GH100
Approved by Designer	Grga Kolić	01.10.2026.	of HPP Perucica - Phase II			DC DISTRIBUTION 220VDC	Designer No.:	SALES No.:	+ UACJA10
Checked by	Antonio Aleksić	01.10.2026.	PROJECT NAME	EMPLOYER	DESIGNER				PAGE 6
Drawn by	Tamara Trogrlić	01.10.2026.							PAGE 6 / 156

CONFIDENTIAL, ALL RIGHTS RESERVED DIN 34

Format ISO/DIN A3

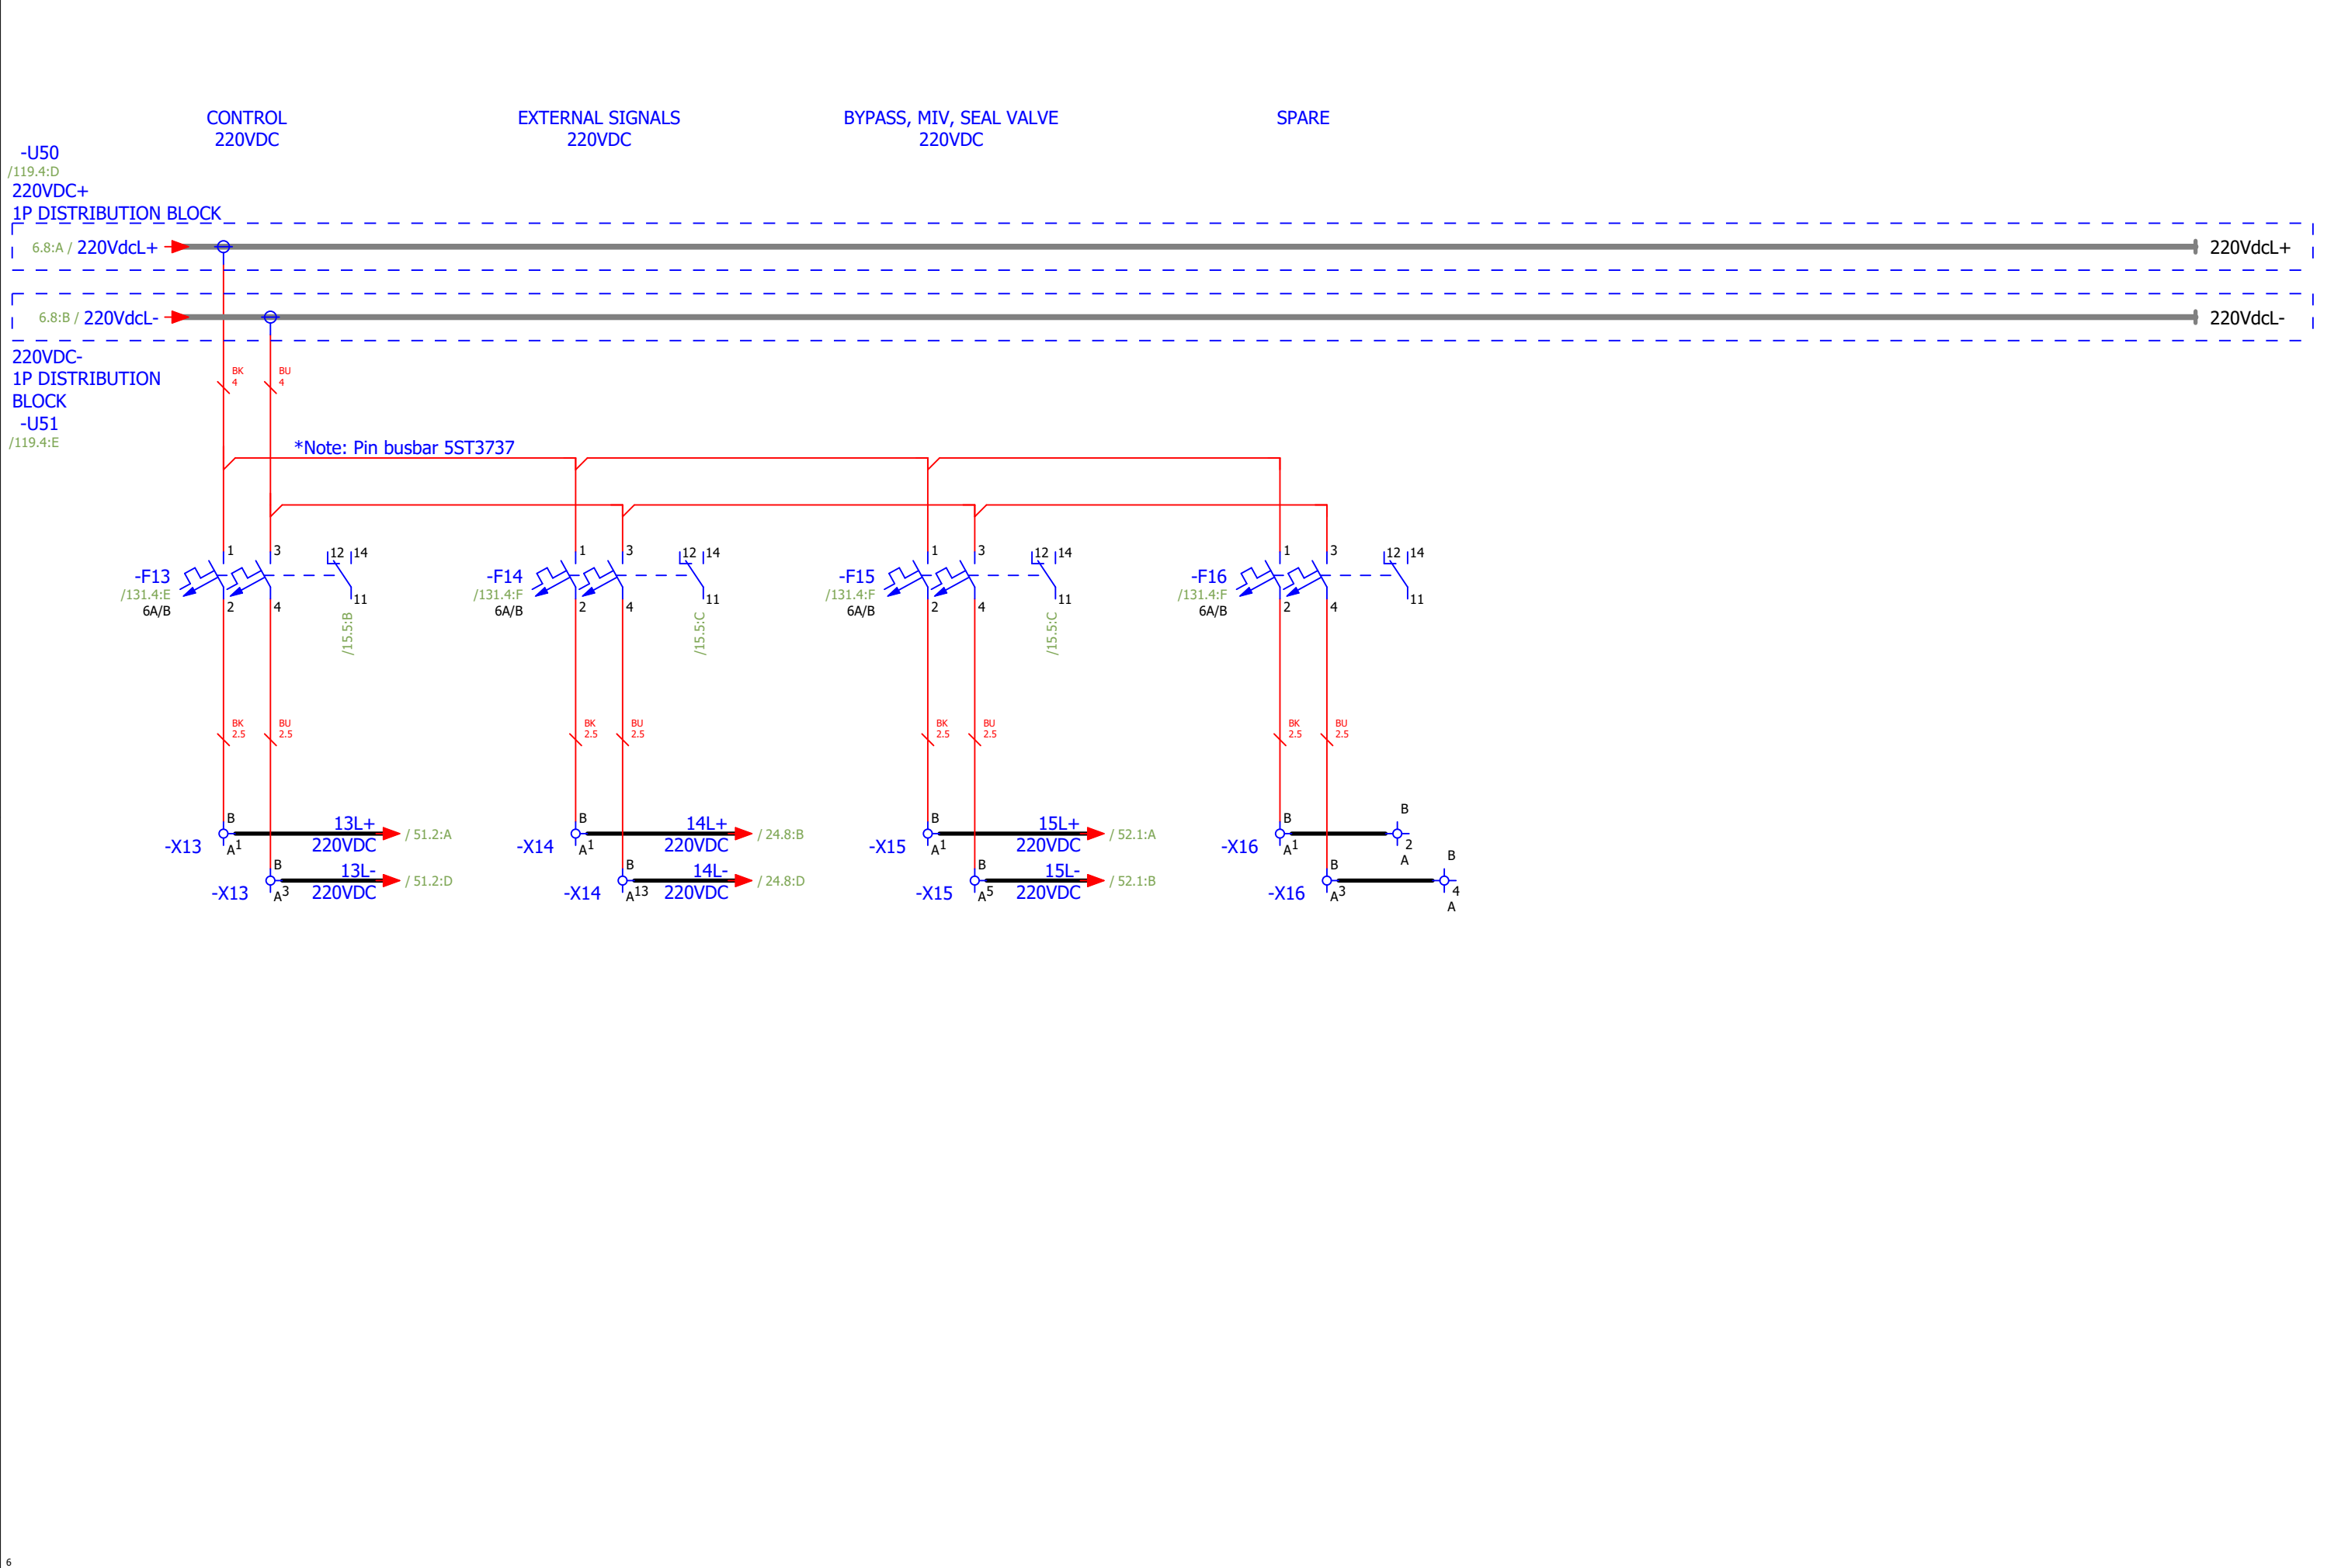


Approved by Contractor			Reconstruction and Modernisation of HPP Perucica - Phase II		 A Voith Company Sintaksa - A Voith Company Ulica Domovinskog rata 104C, 21 000 Split, Hrvatska	Unit KA1 control cubicle circuit diagrams DC DISTRIBUTION 220VDC	DRAWING No.: PERU-01-19-170-31-001	REV No.: 02	= UACJA10GH100 + UACJA10
Approved by Designer	Grga Kolić	01.10.2026.					Designer No.:	SALES No.:	PAGE 7
Checked by	Antonio Aleksić	01.10.2026.							
Drawn by	Tamara Trogrlić	01.10.2026.							PAGE 7 / 156

CONFIDENTIAL, ALL RIGHTS RESERVED DIN 34


Format ISO/DIN A3

7

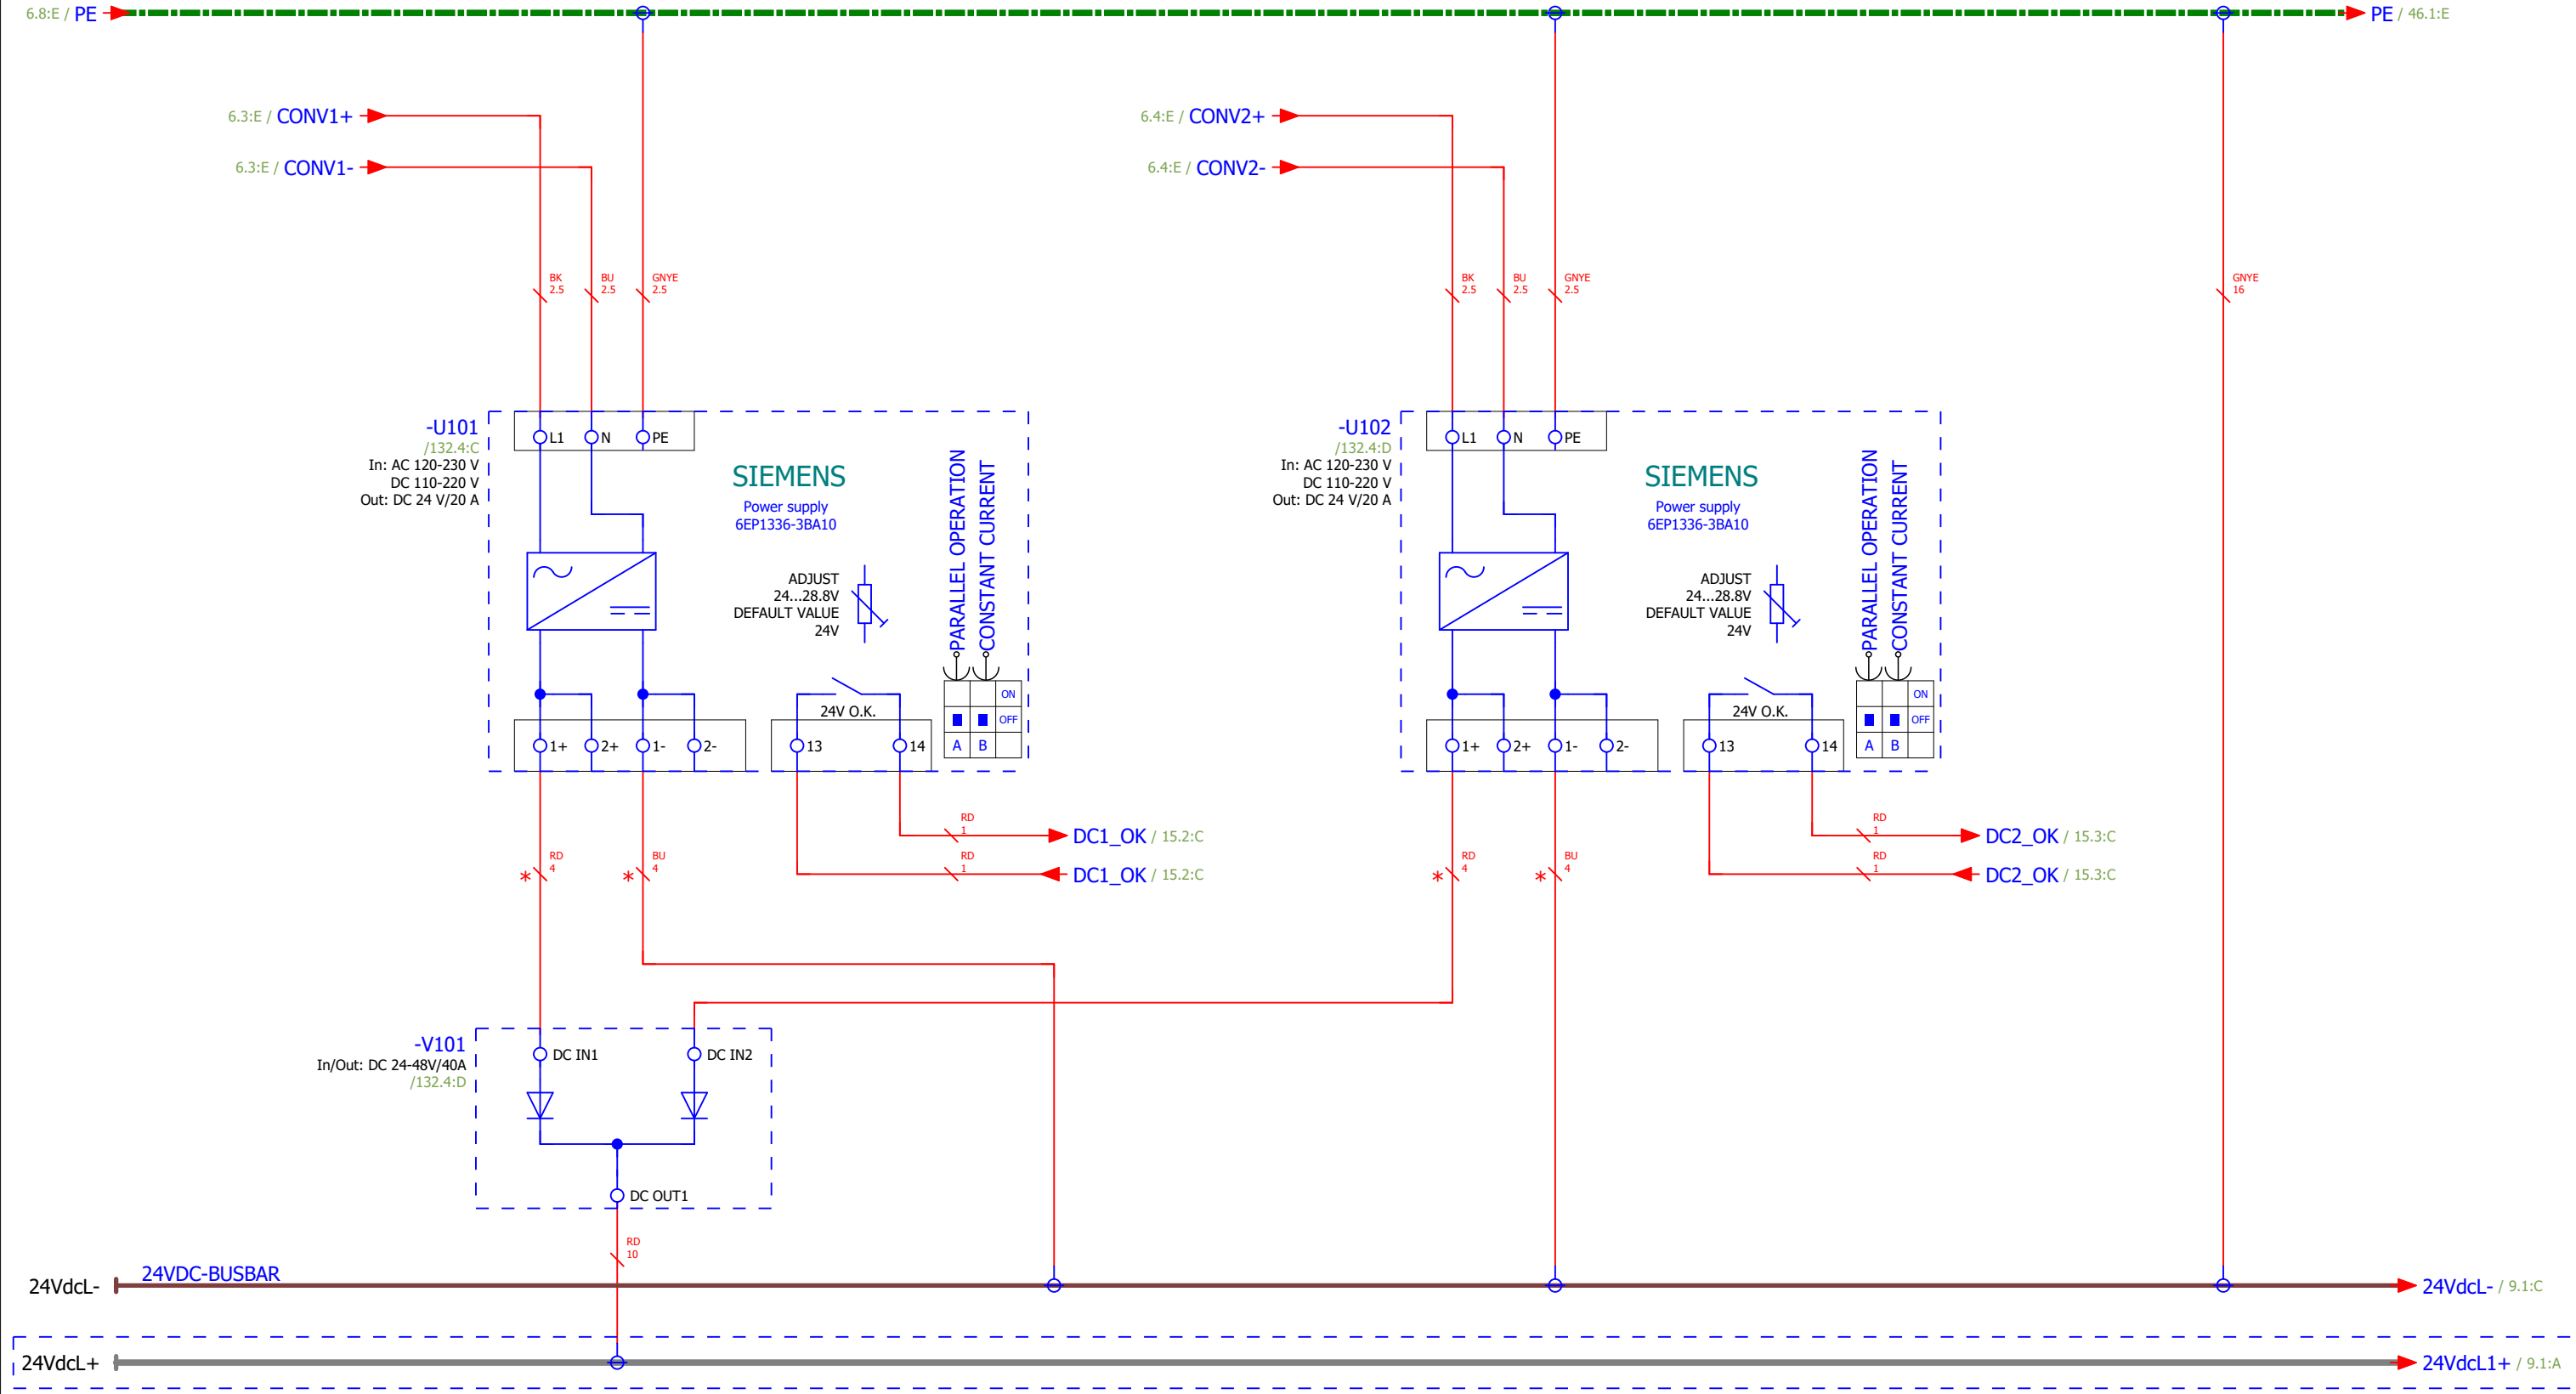



Approved by Contractor			Reconstruction and Modernisation of HPP Perucica - Phase II		 A Voith Company Sintaksa - A Voith Company Ulica Domovinskog rata 104C, 21 000 Split, Hrvatska	Unit KA1 control cubicle circuit diagrams DC DISTRIBUTION 24VDC	DRAWING No.:	REV No.:	= UACJA10GH100
Approved by Designer	Grga Kolić	01.10.2026.					PERU-01-19-170-31-001	02	+ UACJA10
Checked by	Antonio Aleksić	01.10.2026.					Designer No.:	SALES No.:	PAGE
Drawn by	Tamara Trogrlić	01.10.2026.							8
			PROJECT NAME	EMPLOYER	DESIGNER				PAGE

9

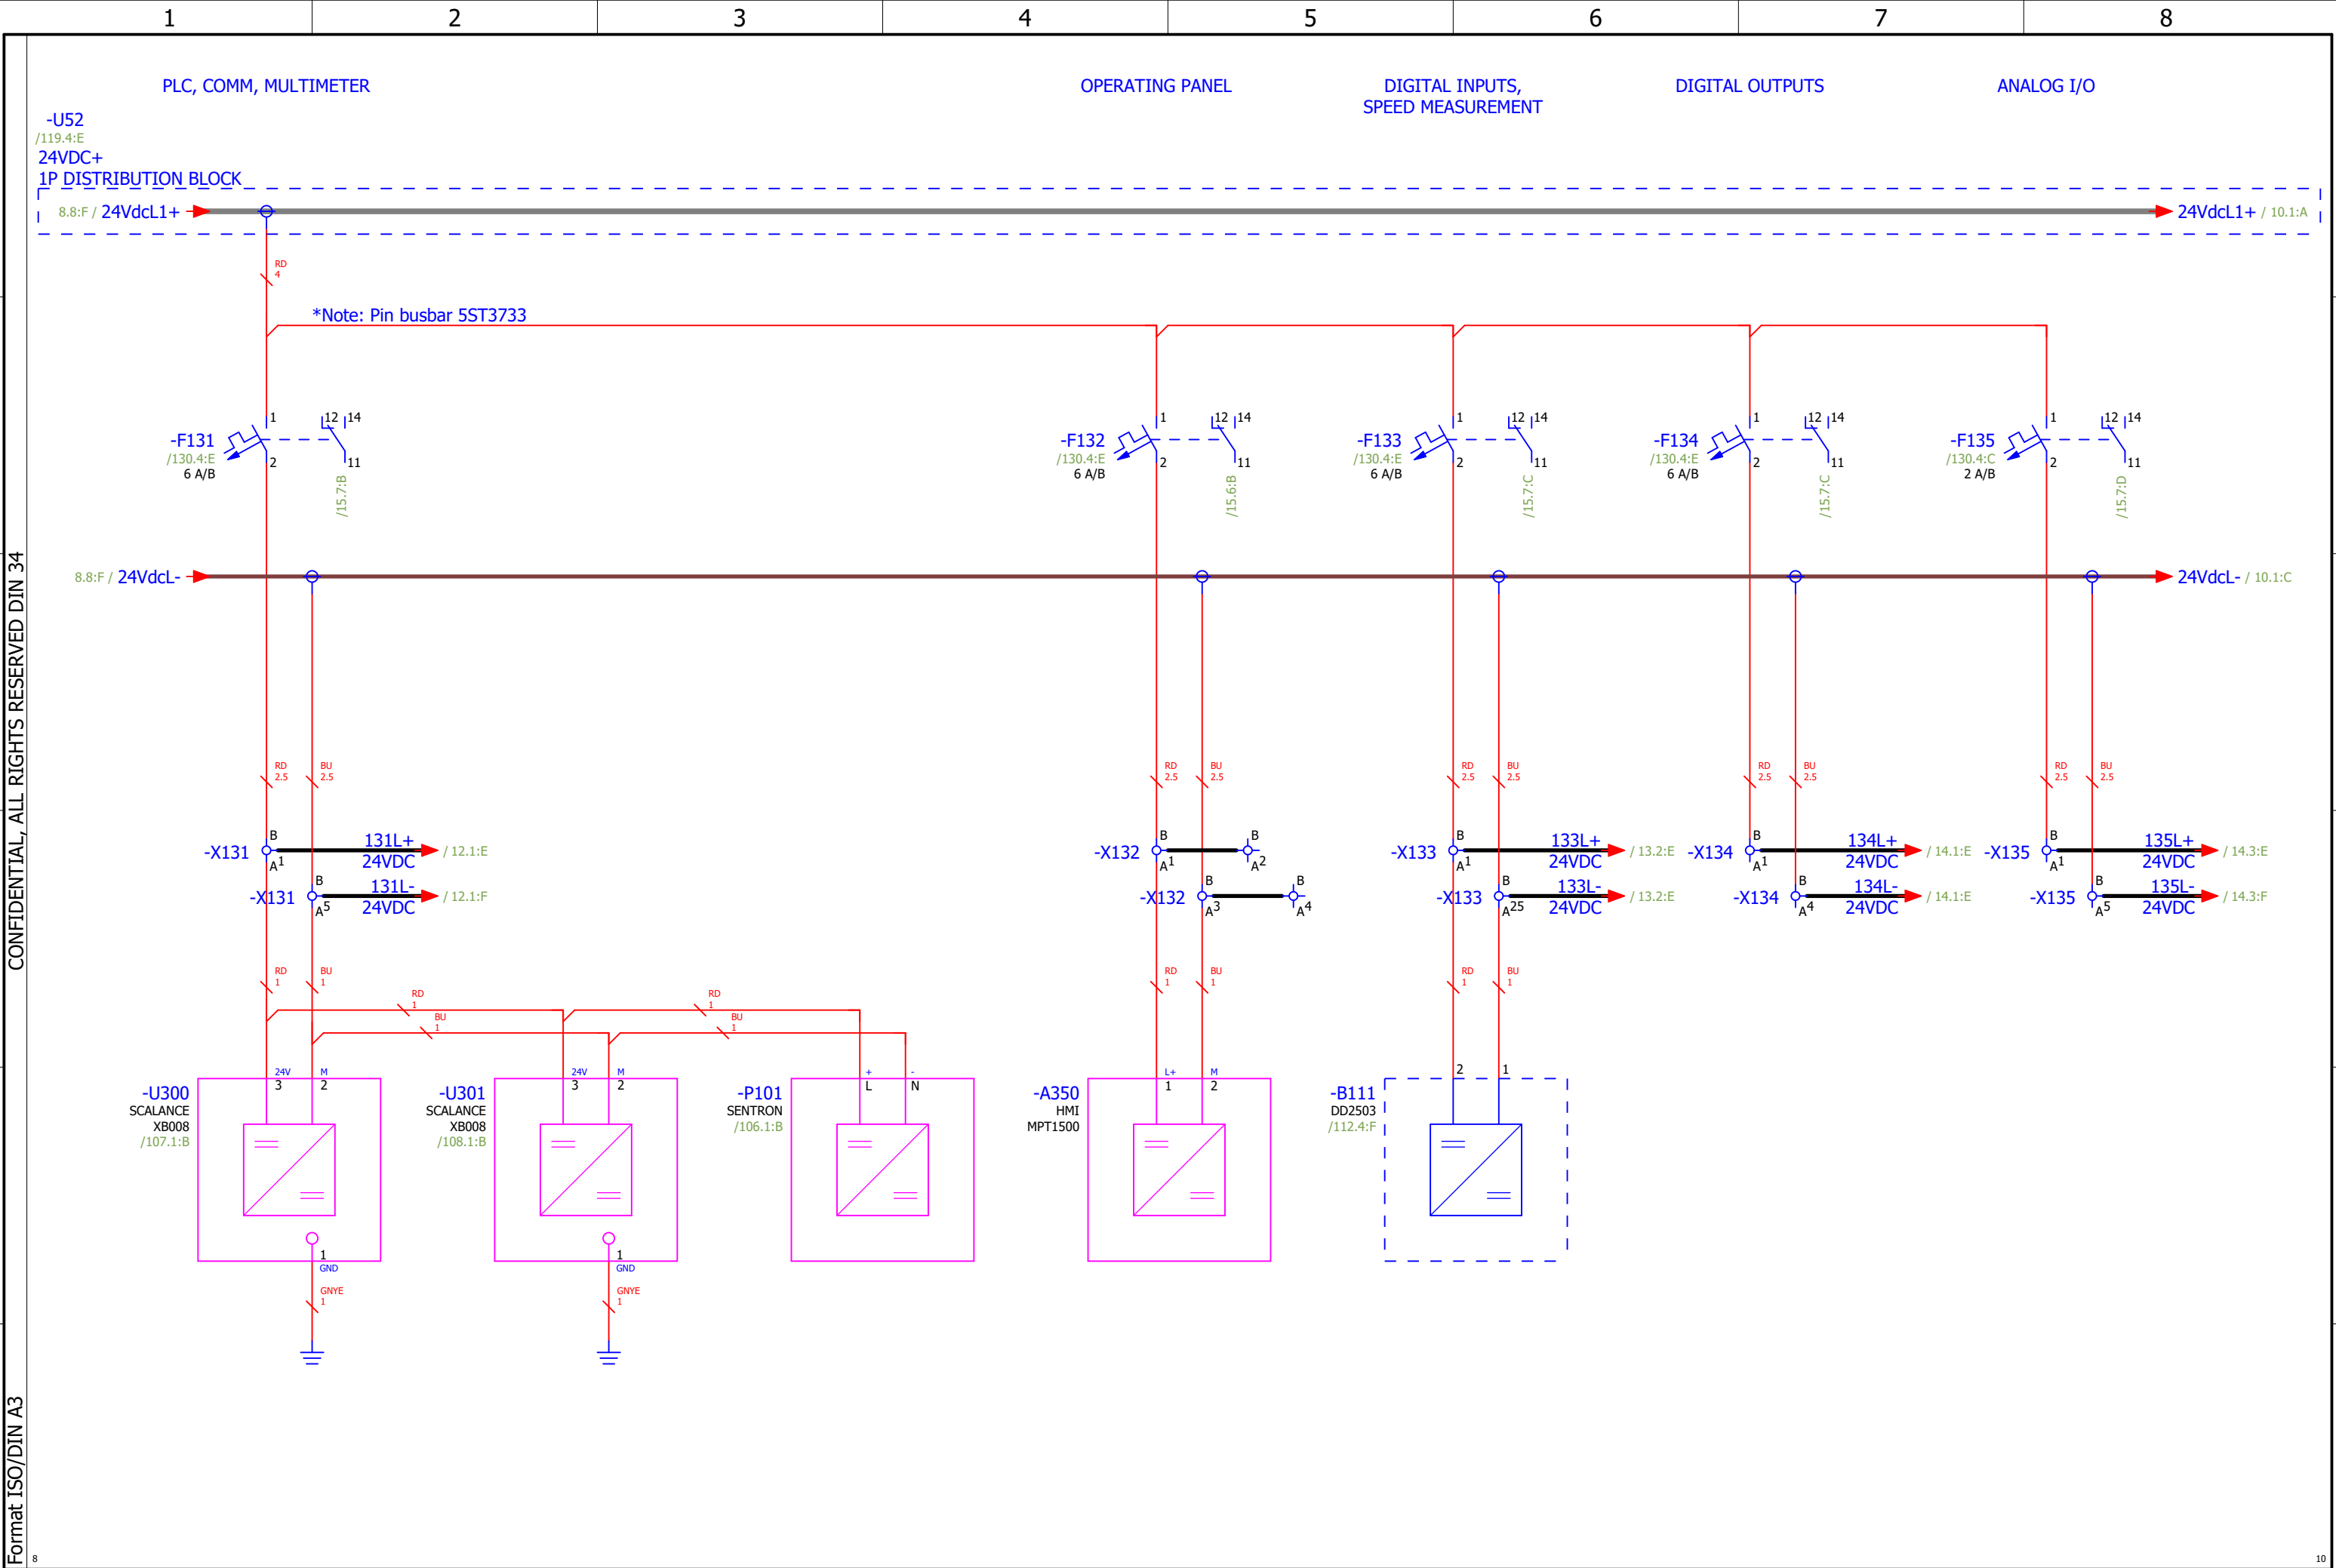

Approved by Contractor			Reconstruction and Modernisation of HPP Perucica - Phase II		 A Voith Company Sintaksa - A Voith Company Ulica Domovinskog rata 104C, 21 000 Split, Hrvatska	Unit KA1 control cubicle circuit diagrams DC DISTRIBUTION 24VDC	DRAWING No.: PERU-01-19-170-31-001	REV No.: 02	= UACJA10GH100 + UACJA10
Approved by Designer	Grga Kolić	01.10.2026.					Designer No.:	SALES No.:	PAGE 9
Checked by	Antonio Aleksić	01.10.2026.							
Drawn by	Tamara Trogrlić	01.10.2026.							PAGE 9 / 156

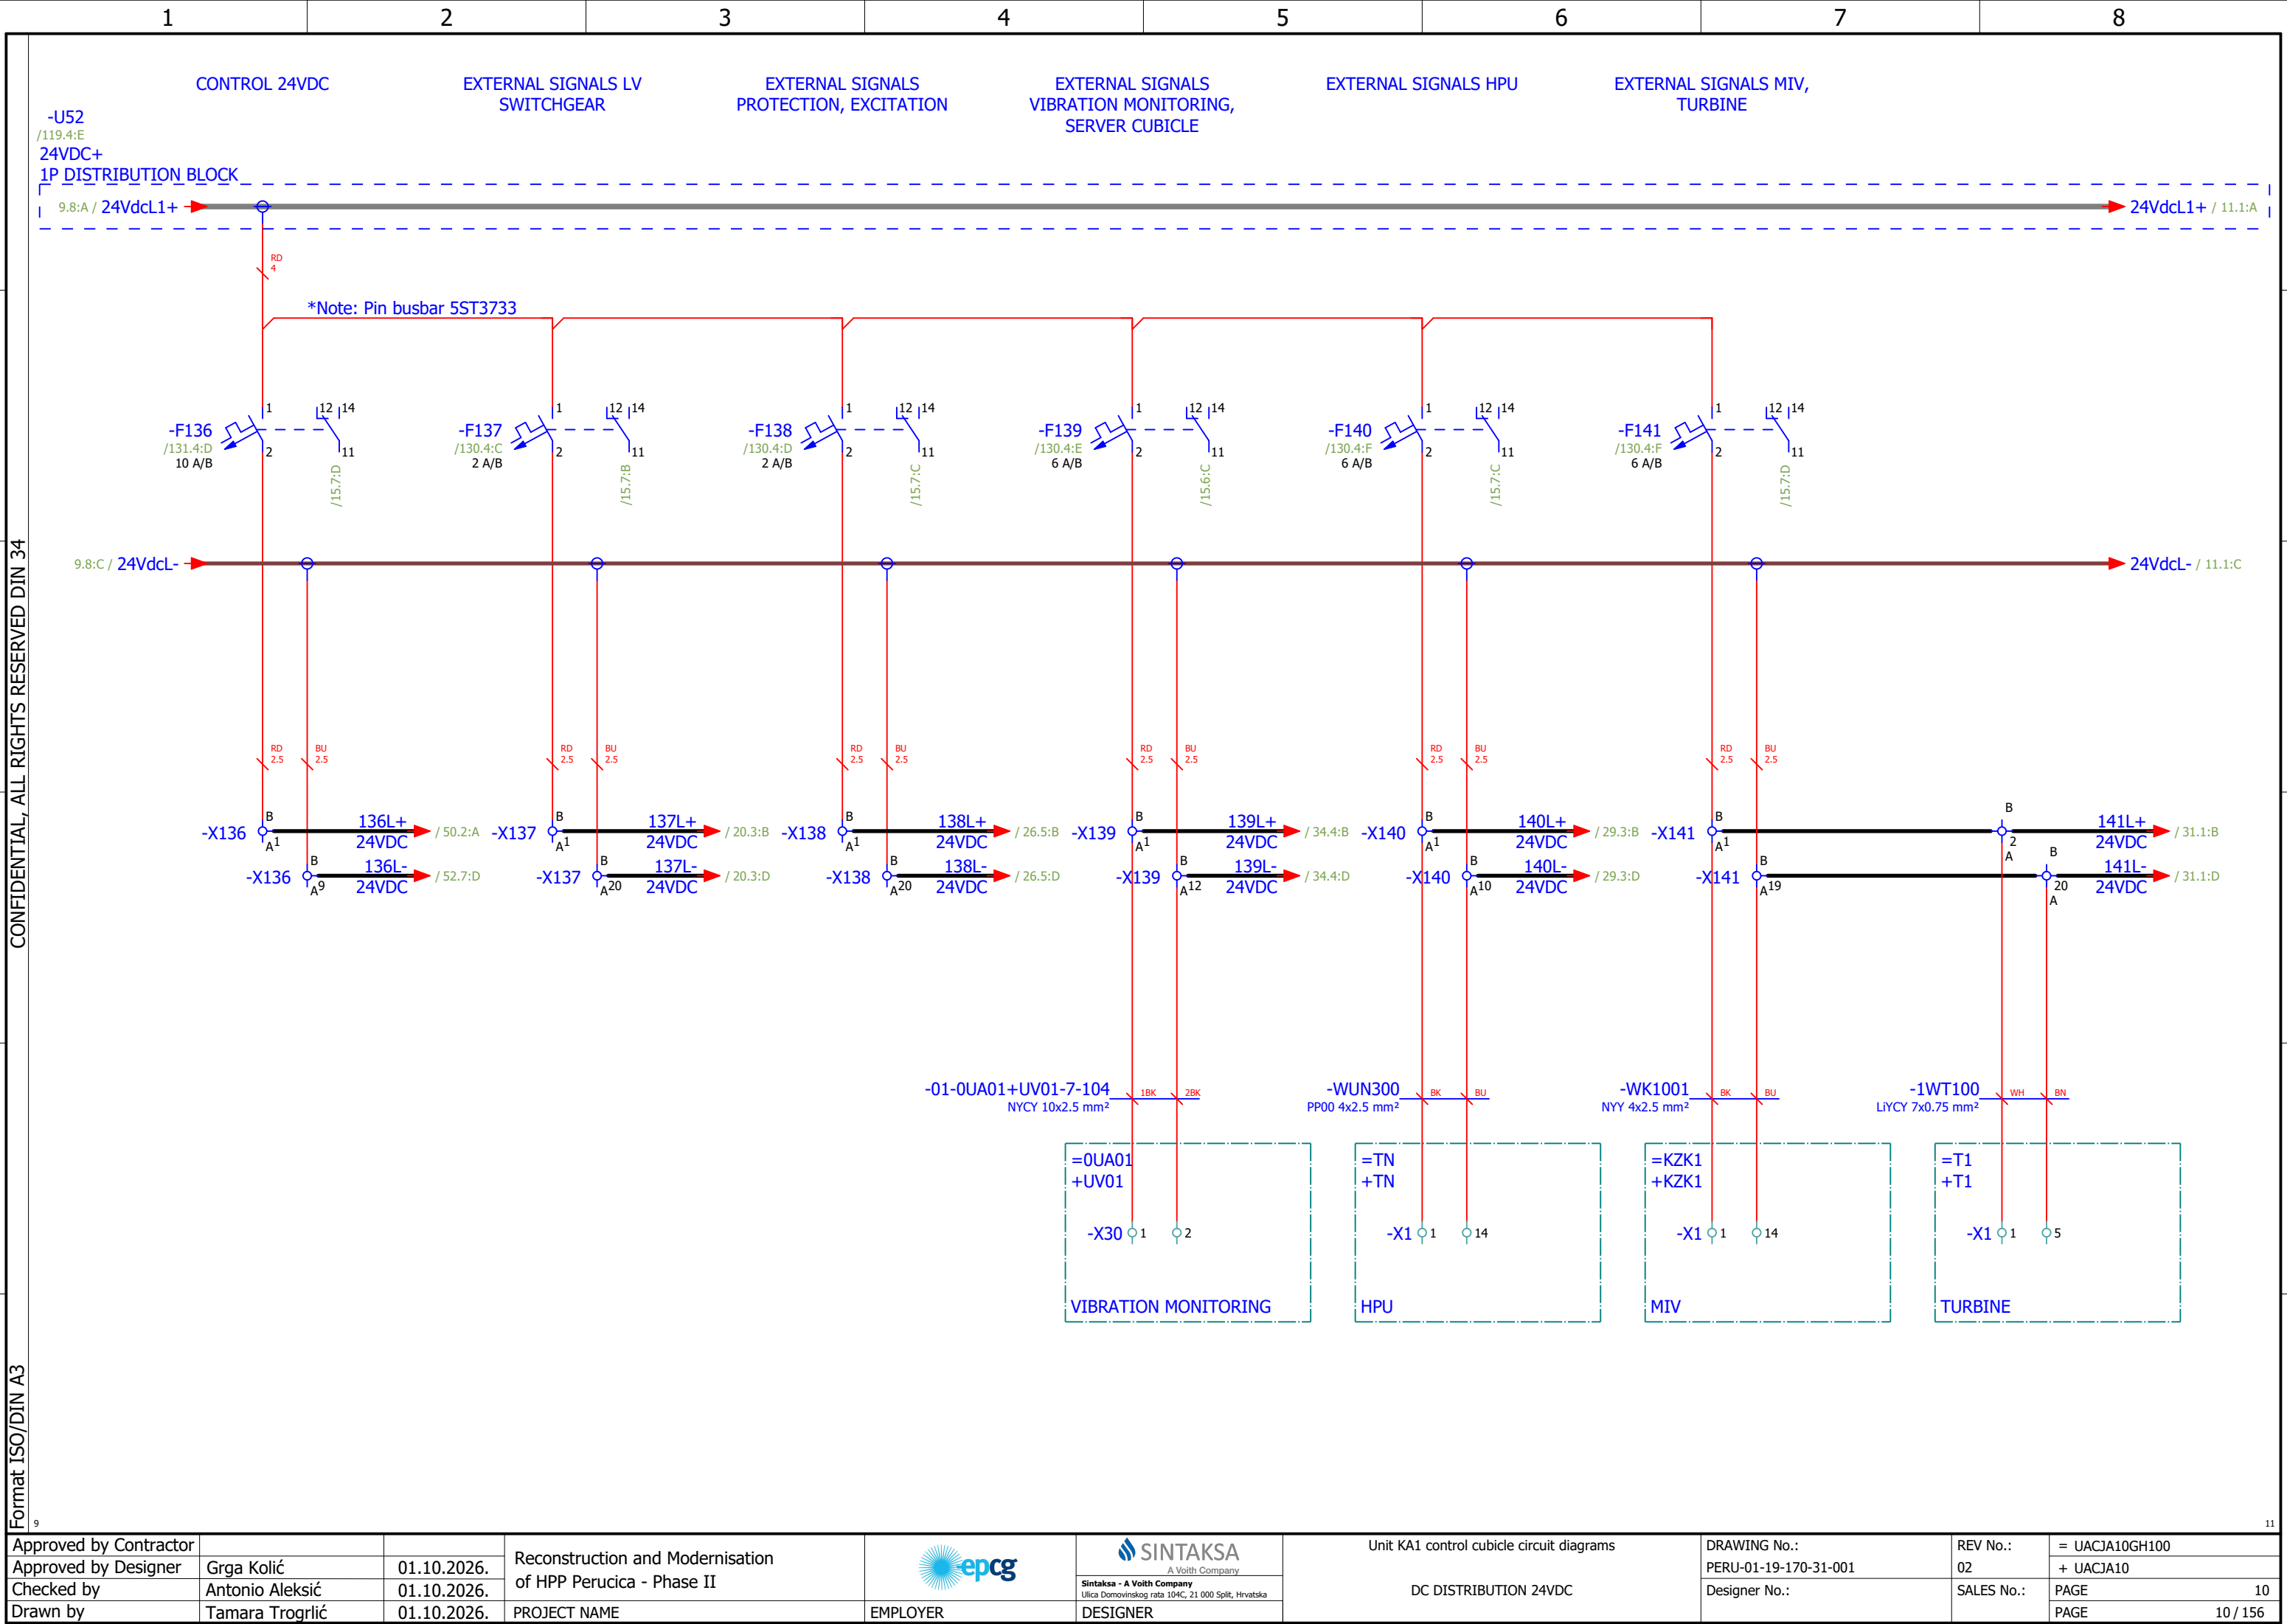

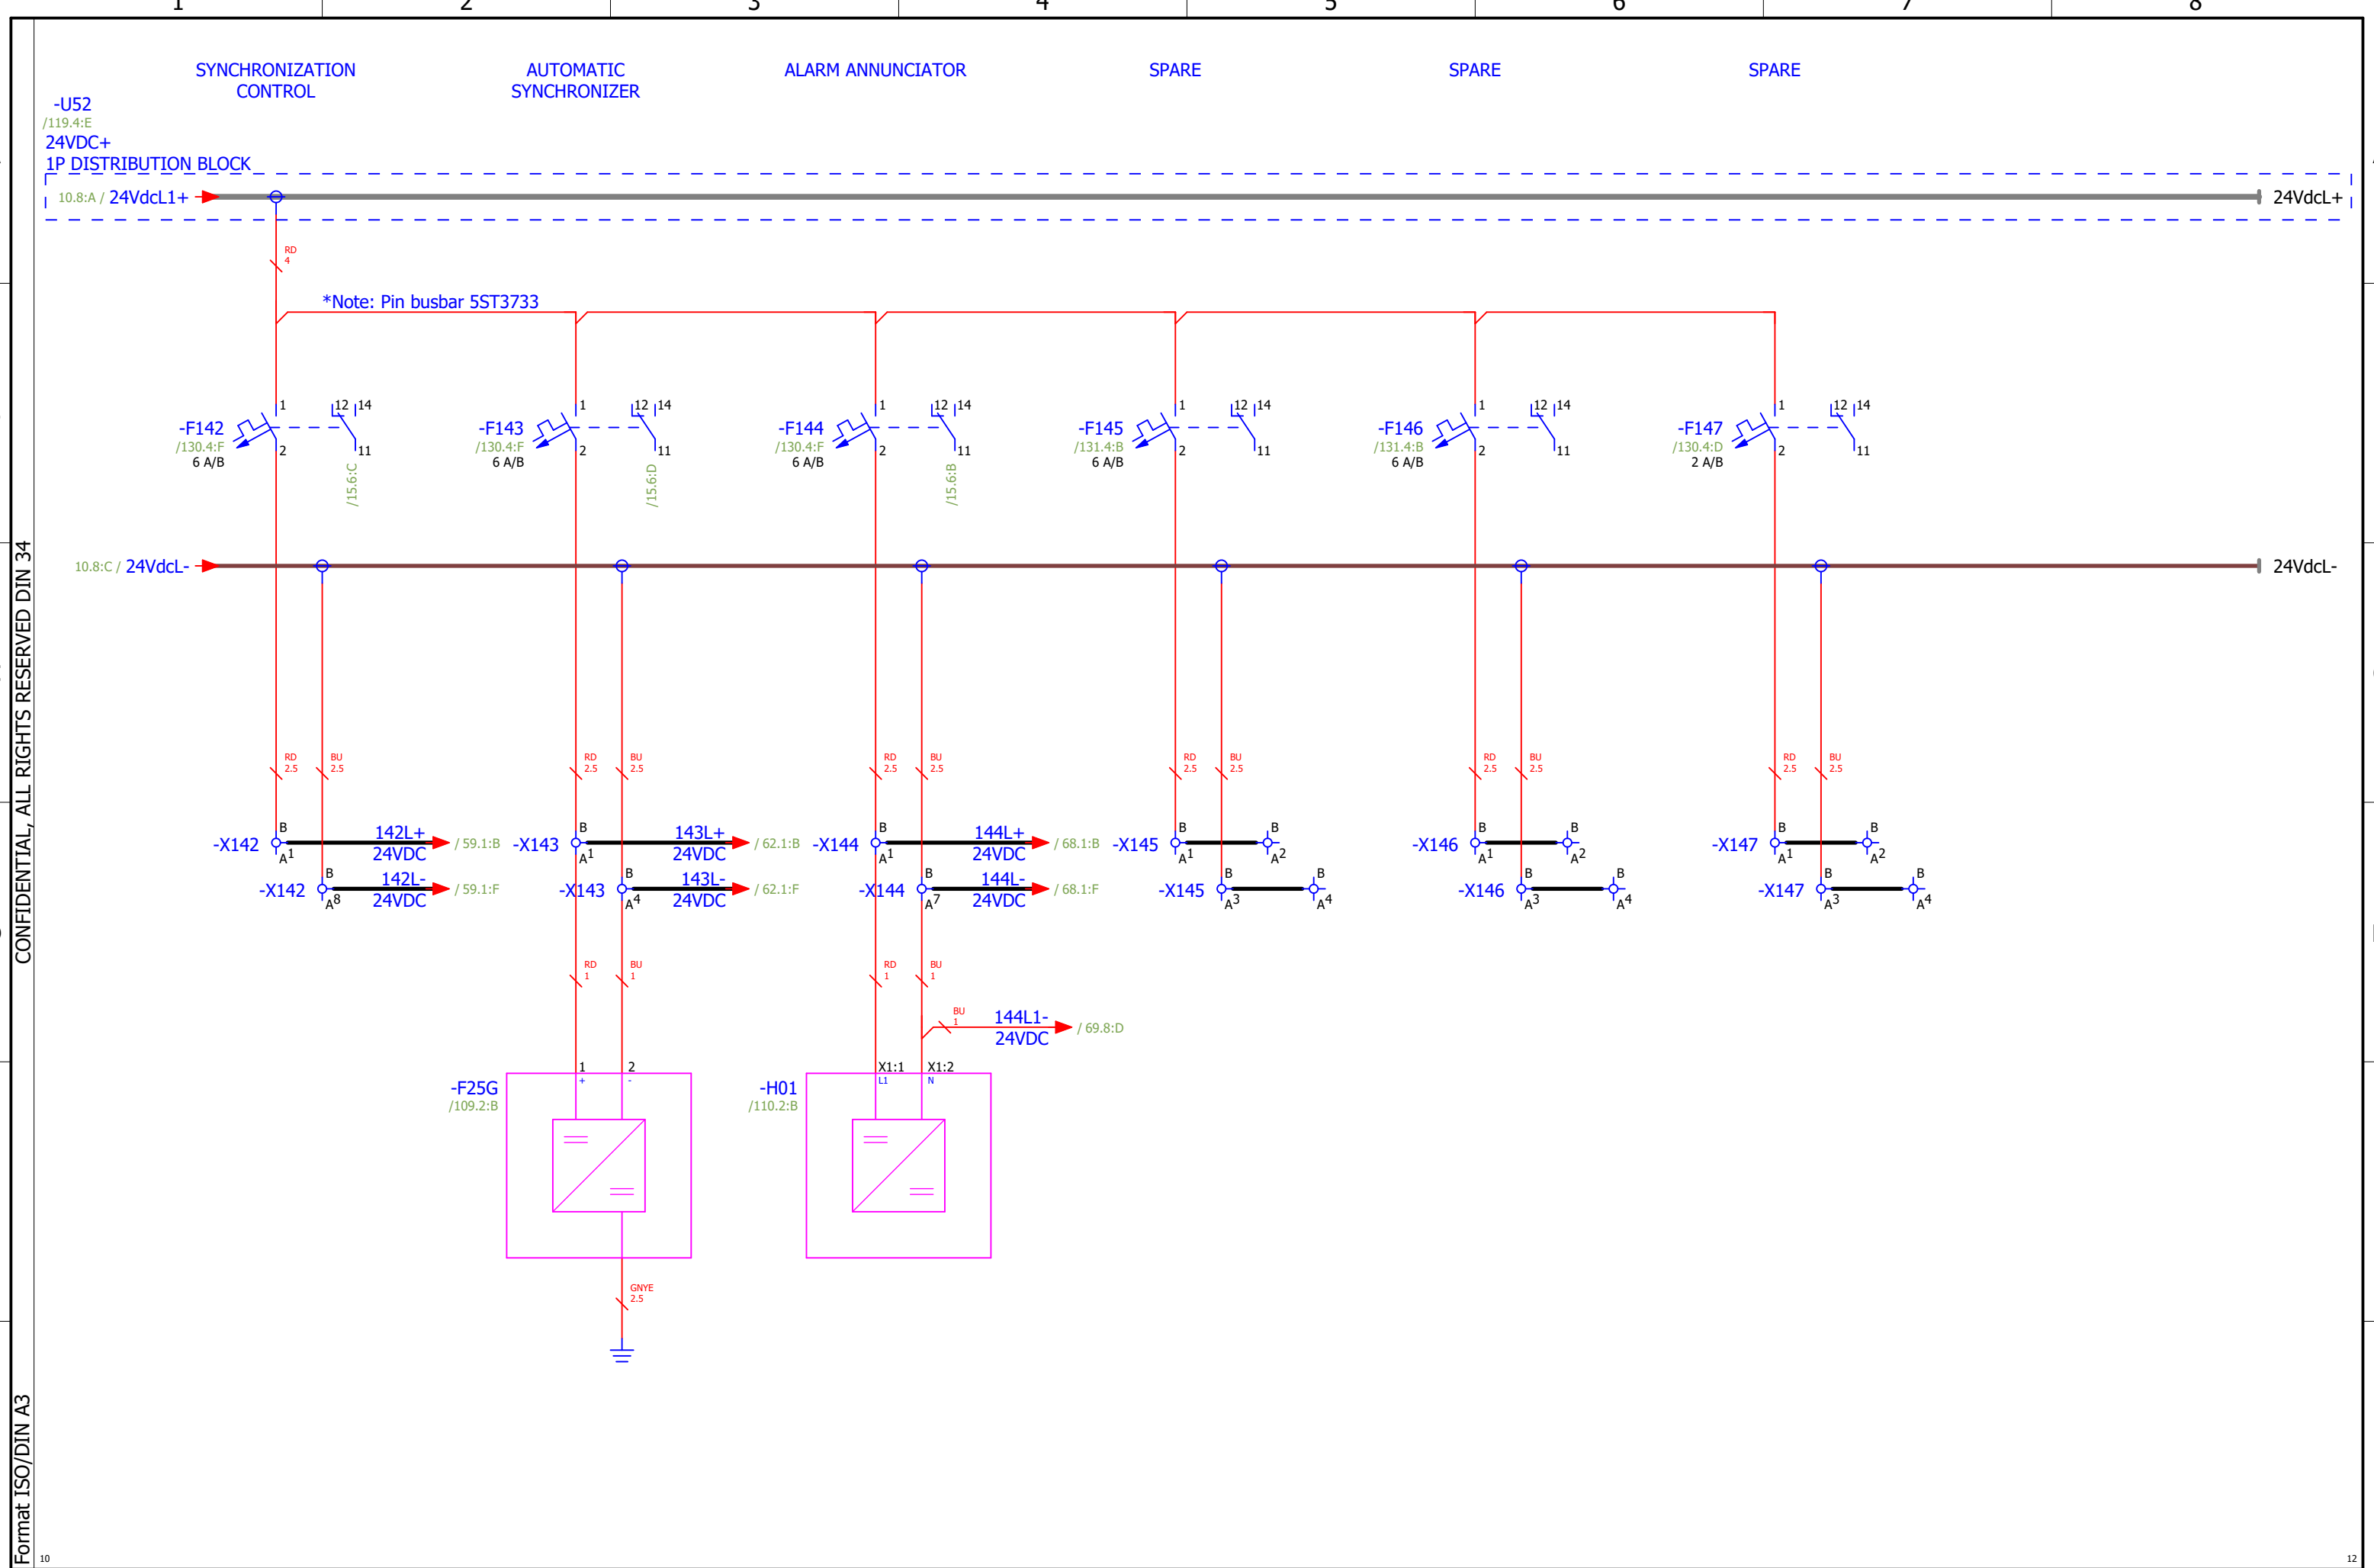

Approved by Contractor			Reconstruction and Modernisation of HPP Perucica - Phase II		SINTAKSA A Voith Company	Unit KA1 control cubicle circuit diagrams	DRAWING No.: PERU-01-19-170-31-001	REV No.: 02	= UACJA10GH100 + UACJA10
Approved by Designer	Grga Kolić	01.10.2026.			Sintaksa - A Voith Company Ulica Domovinskog rata 104C, 21 000 Split, Hrvatska	DC DISTRIBUTION 24VDC	Designer No.:	SALES No.:	PAGE 11
Checked by	Antonio Aleksić	01.10.2026.							PAGE 11 / 156
Drawn by	Tamara Trogrlić	01.10.2026.	PROJECT NAME	EMPLOYER	DESIGNER				


CONFIDENTIAL, ALL RIGHTS RESERVED DIN 34

Format ISO/DIN A3

11


13

Approved by Contractor			Reconstruction and Modernisation of HPP Perucica - Phase II		 A Voith Company Sintaksa - A Voith Company Ulica Domovinskog rata 104C, 21 000 Split, Hrvatska	Unit KA1 control cubicle circuit diagrams PLC CONFIGURATION	DRAWING No.: PERU-01-19-170-31-001	REV No.: 02	= UACJA10GH100 + UACJA10
Approved by Designer	Grga Kolić	01.10.2026.					Designer No.:	SALES No.:	PAGE 12
Checked by	Antonio Aleksić	01.10.2026.							
Drawn by	Tamara Trogrlić	01.10.2026.							PAGE 12 / 156

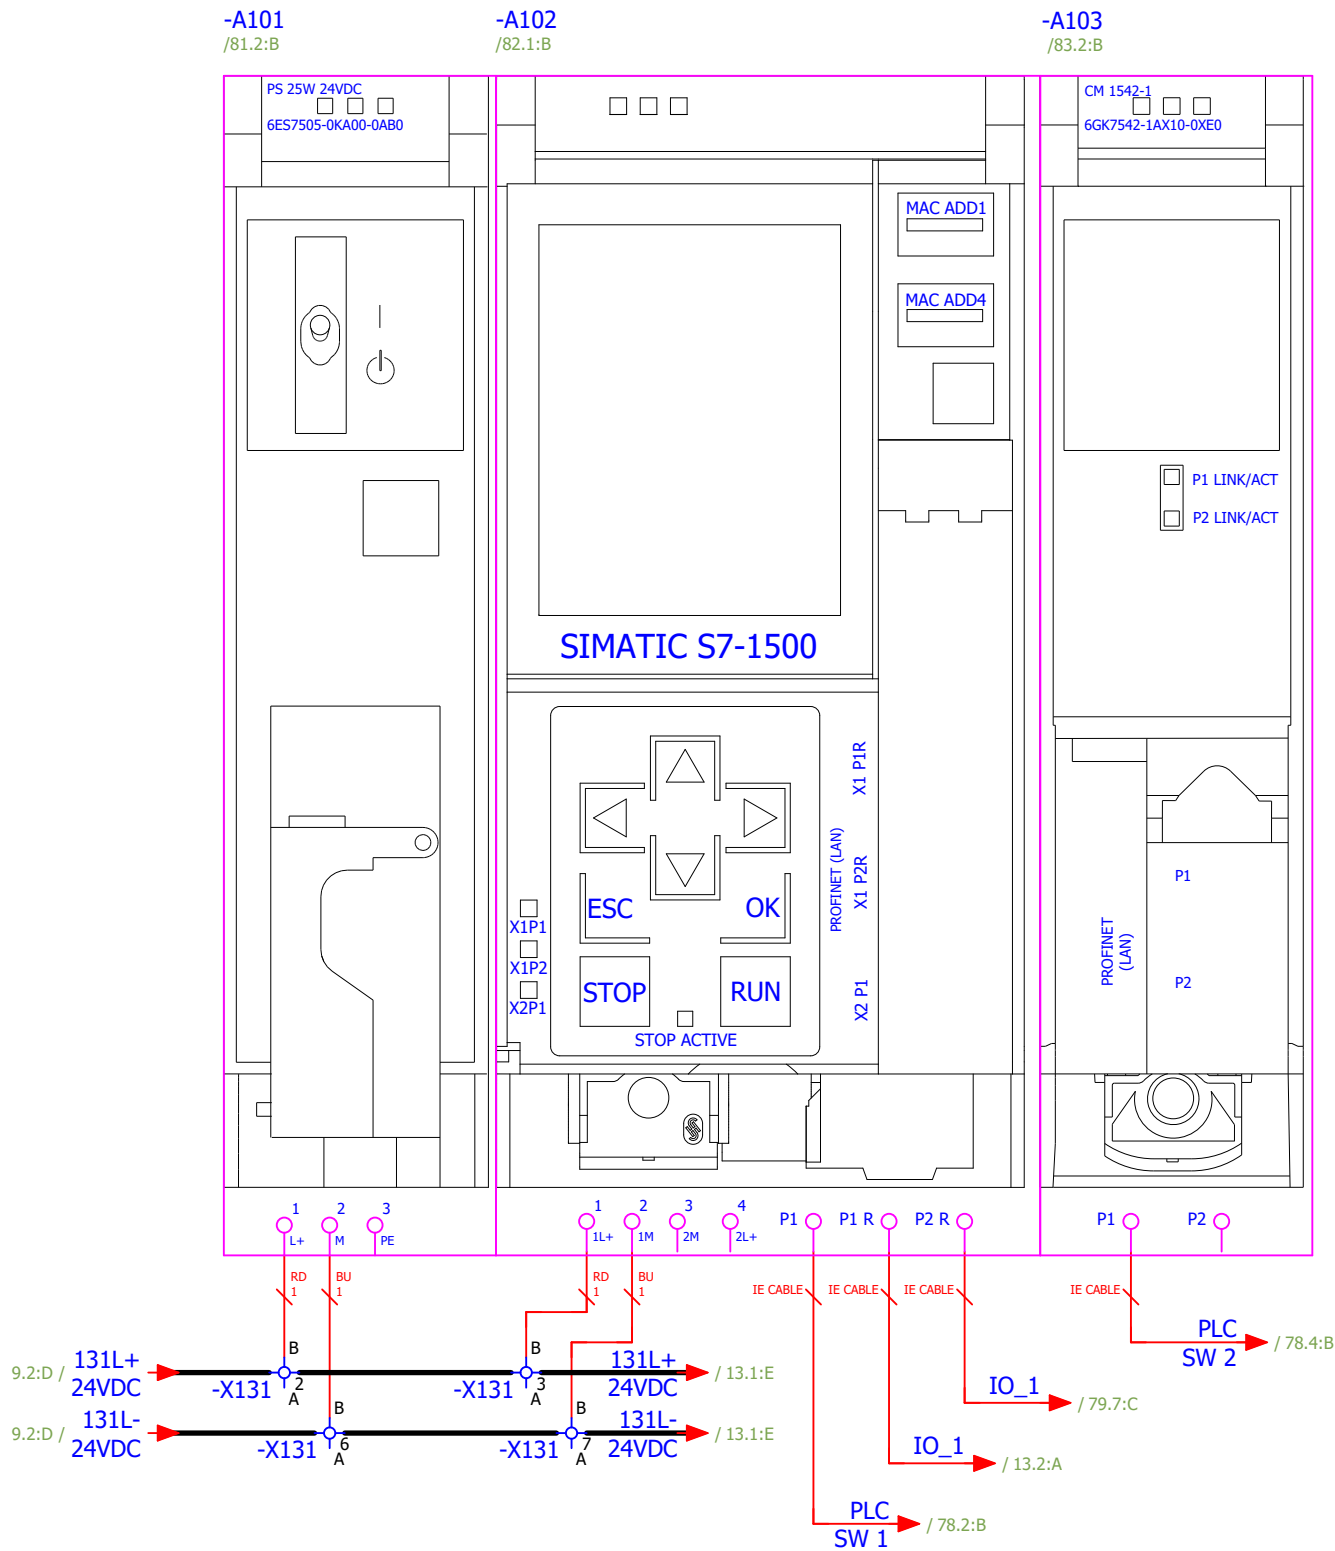

CONFIDENTIAL, ALL RIGHTS RESERVED DIN 34

Format ISO/DIN A3

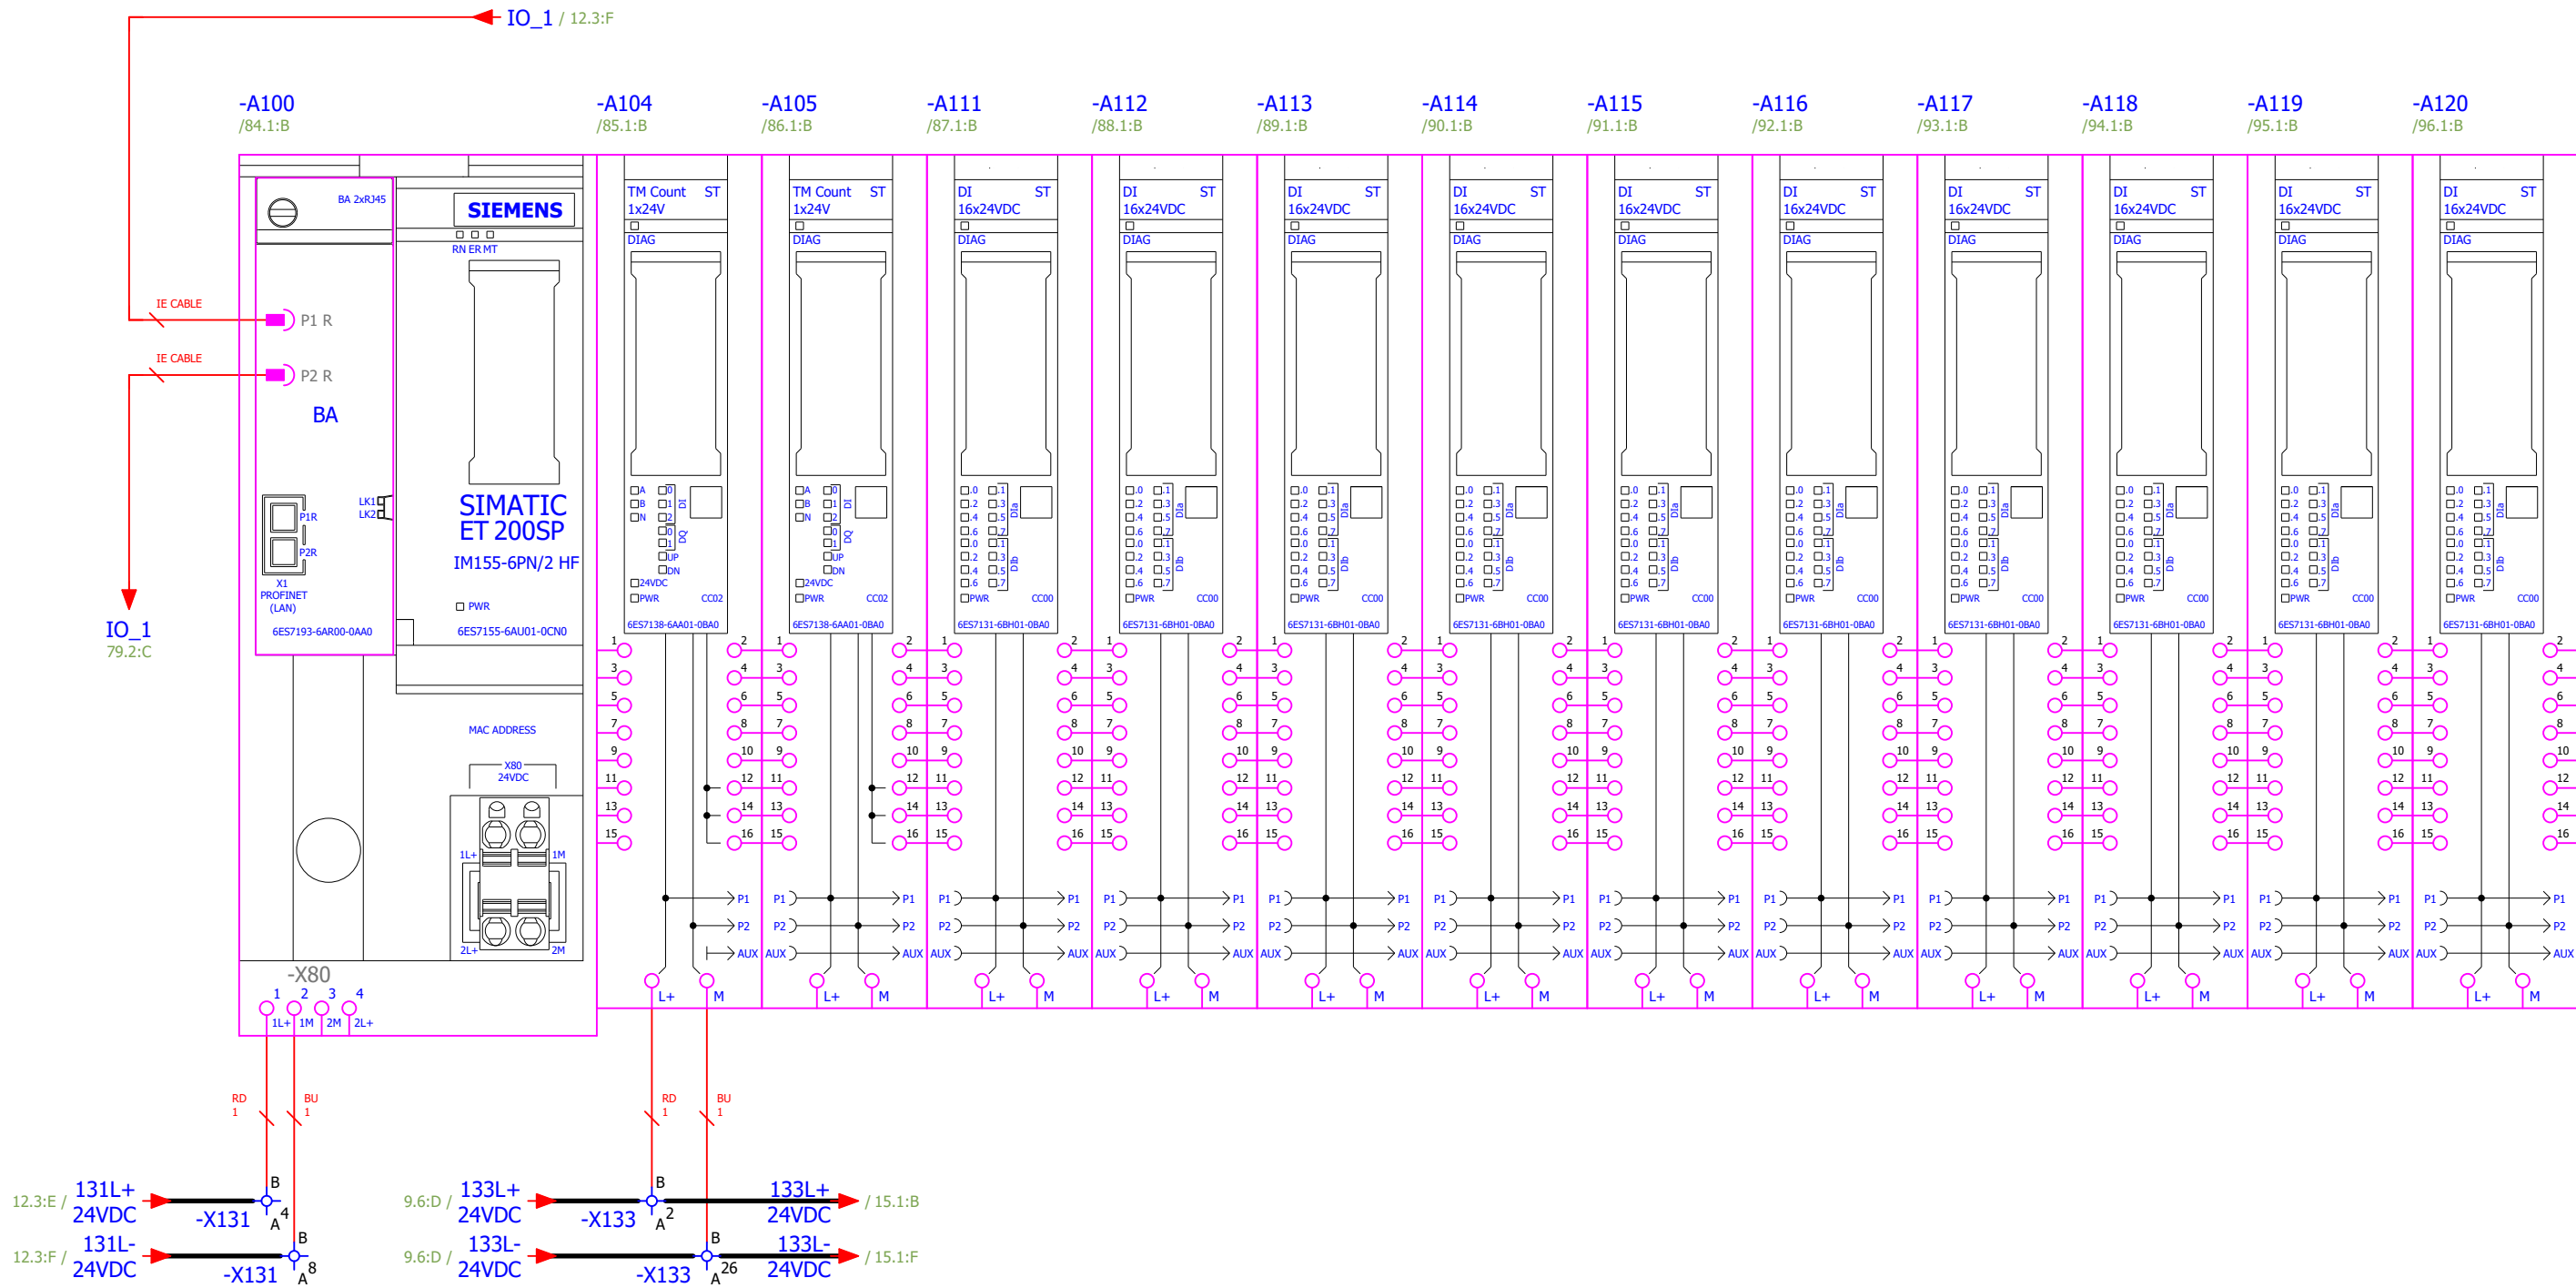


Approved by Contractor			Reconstruction and Modernisation of HPP Perucica - Phase II			Unit KA1 control cubicle circuit diagrams	DRAWING No.: PERU-01-19-170-31-001	REV No.: 02	= UACJA10GH100
Approved by Designer	Grga Kolić	01.10.2026.			Sintaksa - A Voith Company	PLC CONFIGURATION	Designer No.:	SALES No.:	+ UACJA10
Checked by	Antonio Aleksić	01.10.2026.			Ulica Domovinskog rata 104C, 21 000 Split, Hrvatska				PAGE 13
Drawn by	Tamara Trogrlić	01.10.2026.	PROJECT NAME	EMPLOYER	DESIGNER				PAGE 13 / 156

13



1	2	3	4	5	6	7	8
---	---	---	---	---	---	---	---

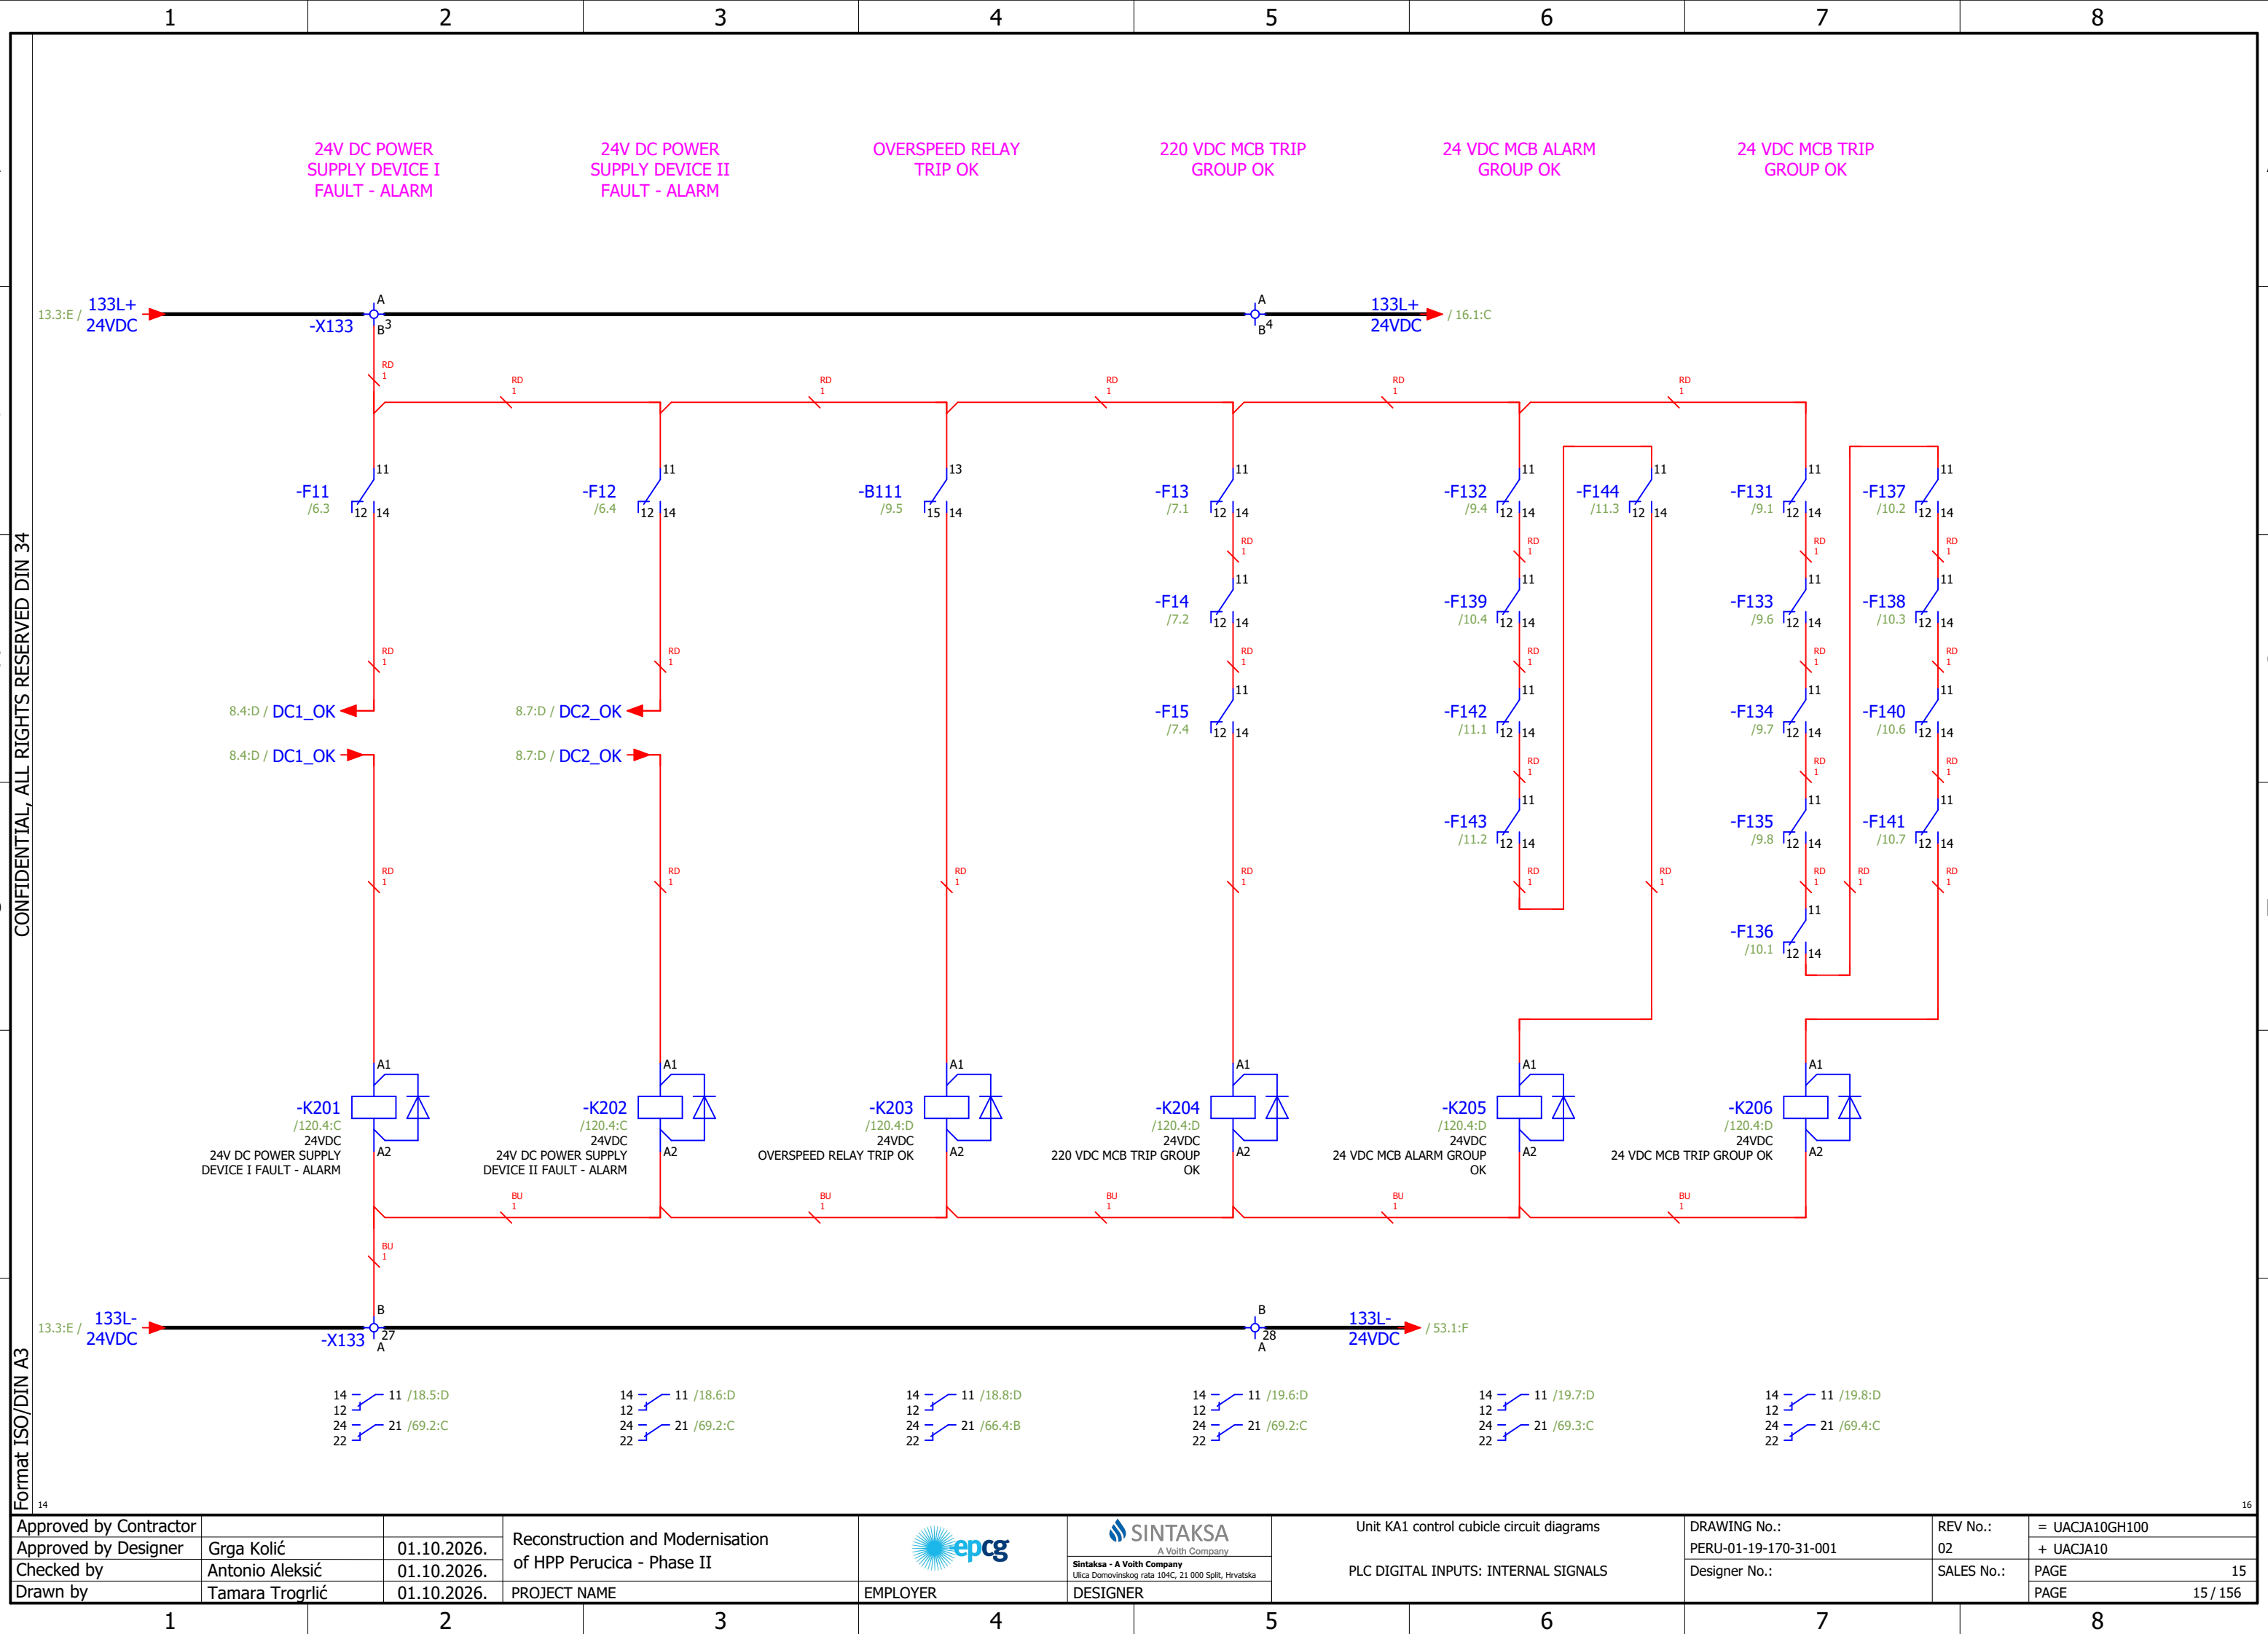

FC 15



1	2	3	4	5	6	7	8
---	---	---	---	---	---	---	---

CONFIDENTIAL, ALL RIGHTS RESERVED DIN 34
Format ISO/DIN A3

16

F


E

D

C

B

A

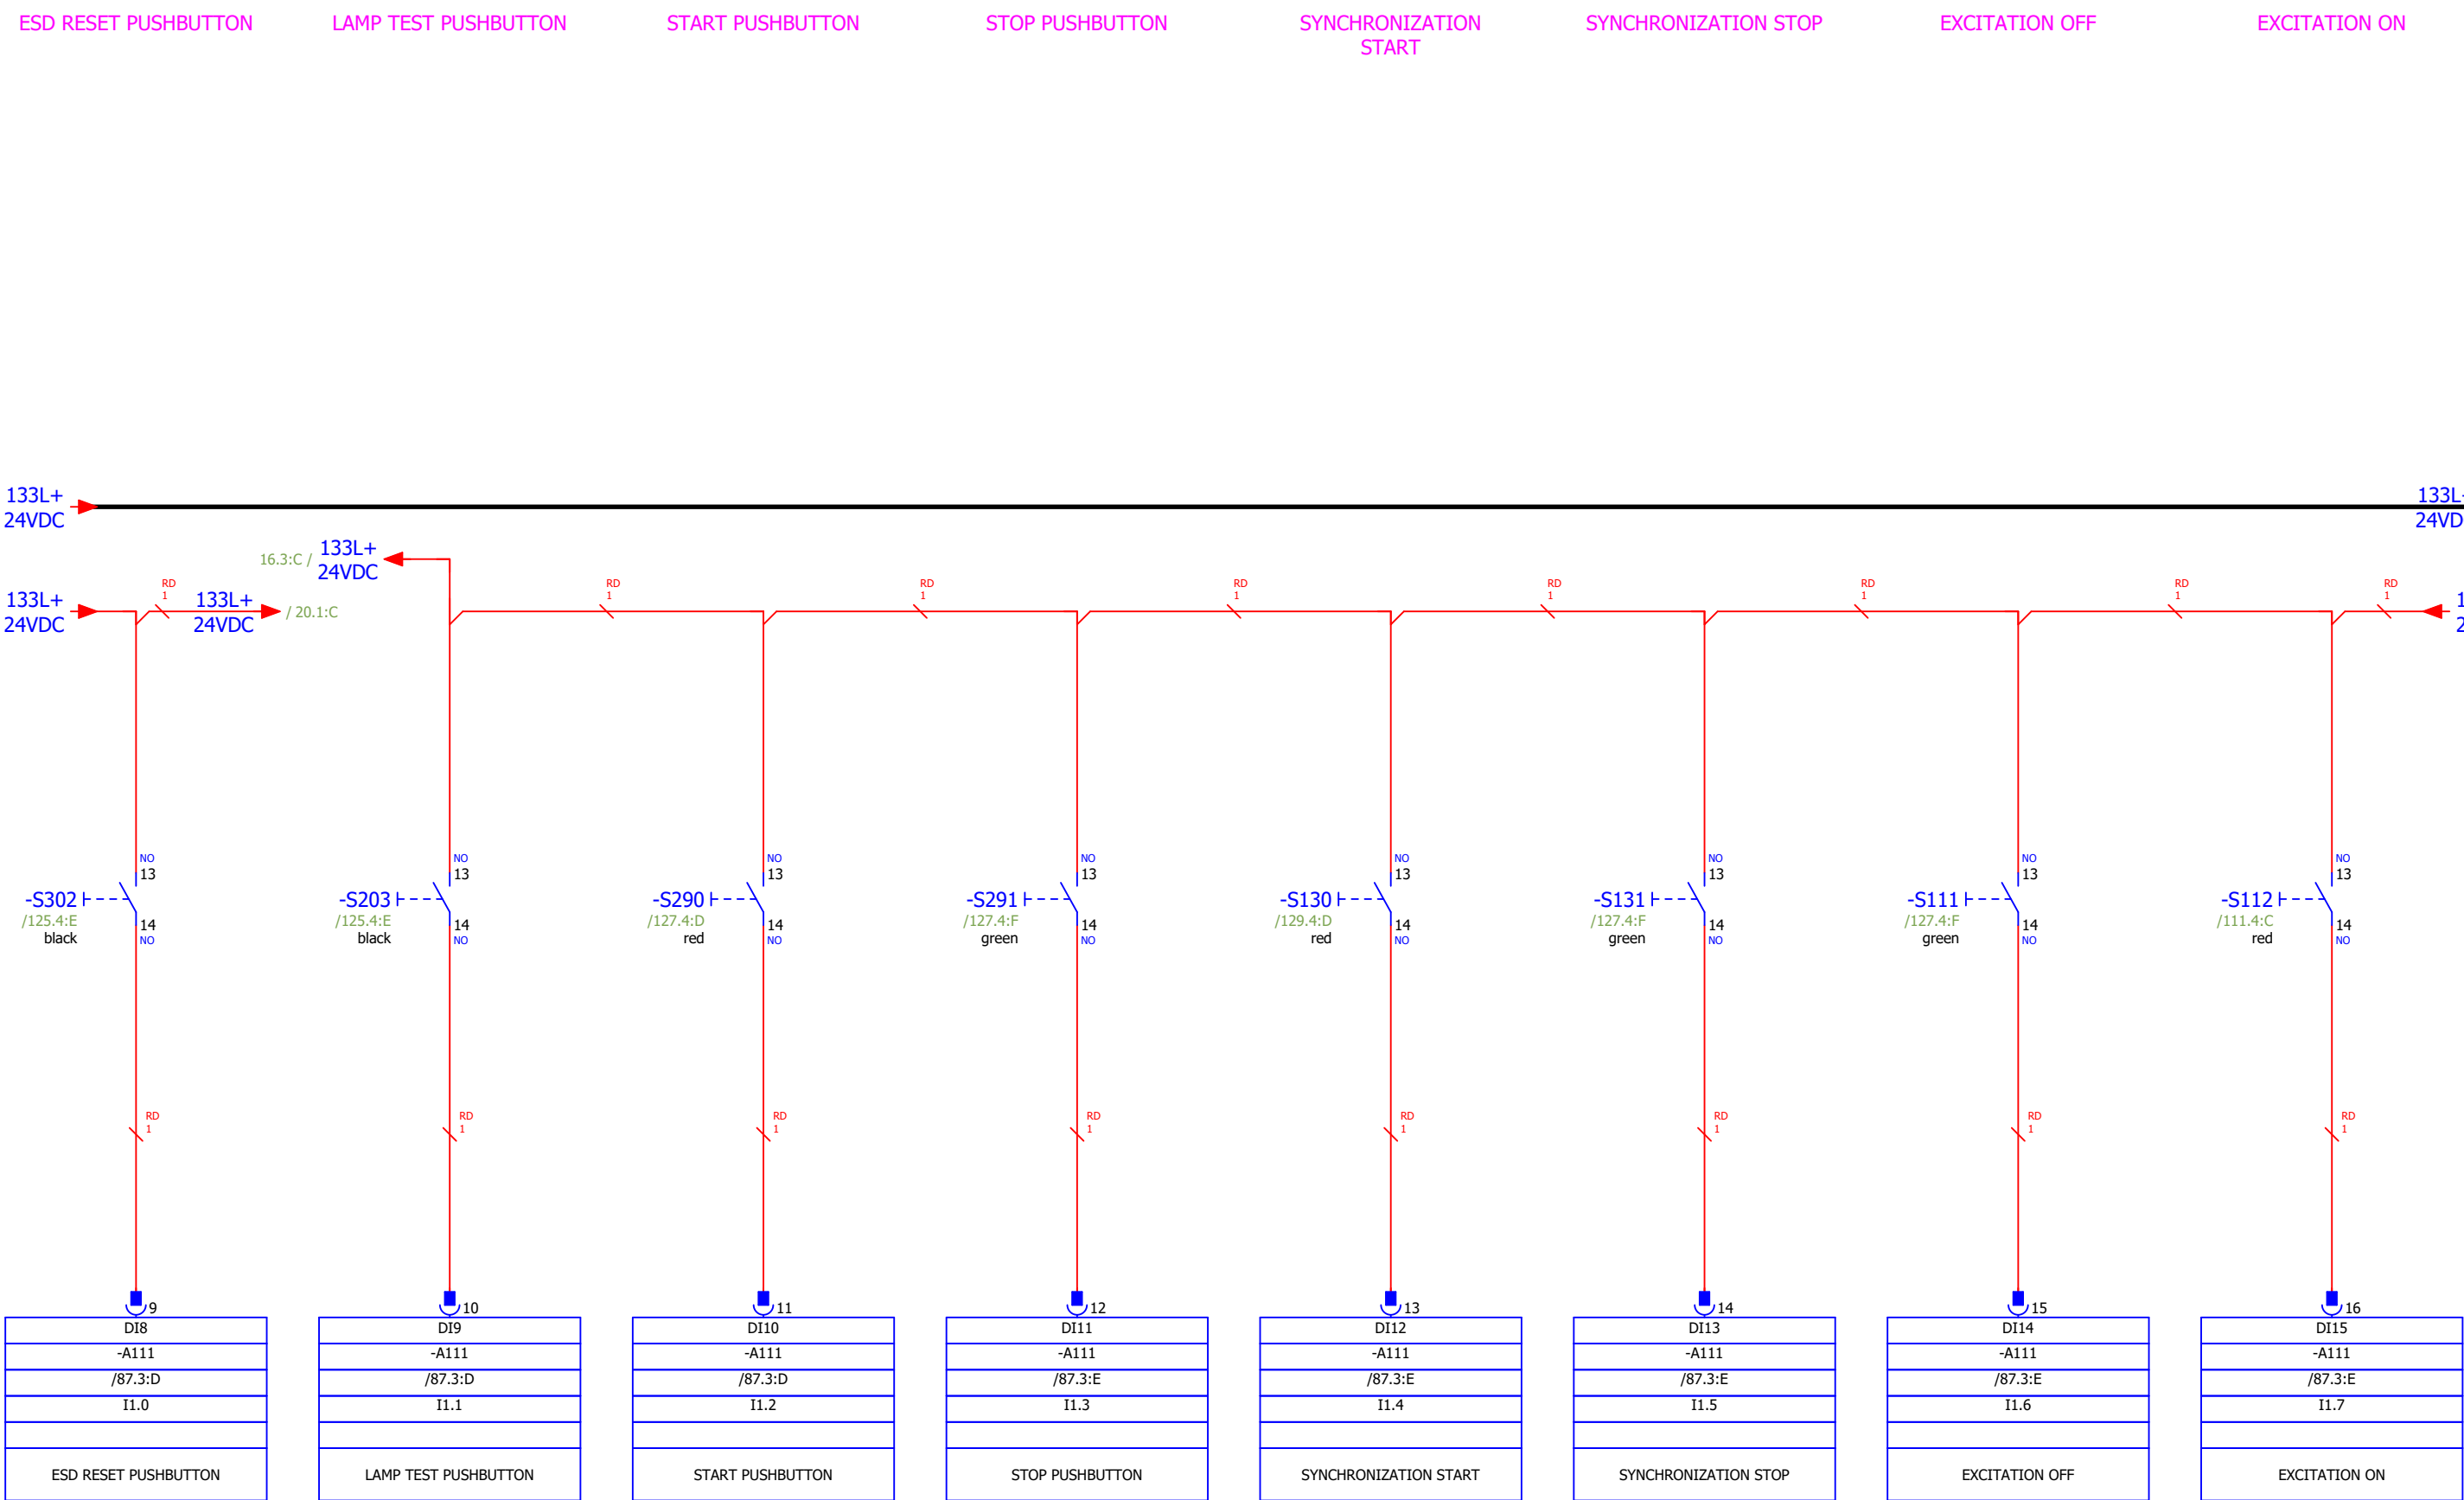

41 42

18

F

E


D

C

B

A

Approved by Contractor			Reconstruction and Modernisation of HPP Perucica - Phase II		 A Voith Company Sintaksa - A Voith Company Ulica Domovinskog rata 104C, 21 000 Split, Hrvatska	Unit KA1 control cubicle circuit diagrams DIGITAL INPUTS: 1.0 - 1.7	DRAWING No.: PERU-01-19-170-31-001	REV No.: 02	= UACJA10GH100 + UACJA10
Approved by Designer	Grga Kolić	01.10.2026.					Designer No.:	SALES No.:	PAGE 17
Checked by	Antonio Aleksić	01.10.2026.							
Drawn by	Tamara Trogrlić	01.10.2026.							PAGE 17 / 156

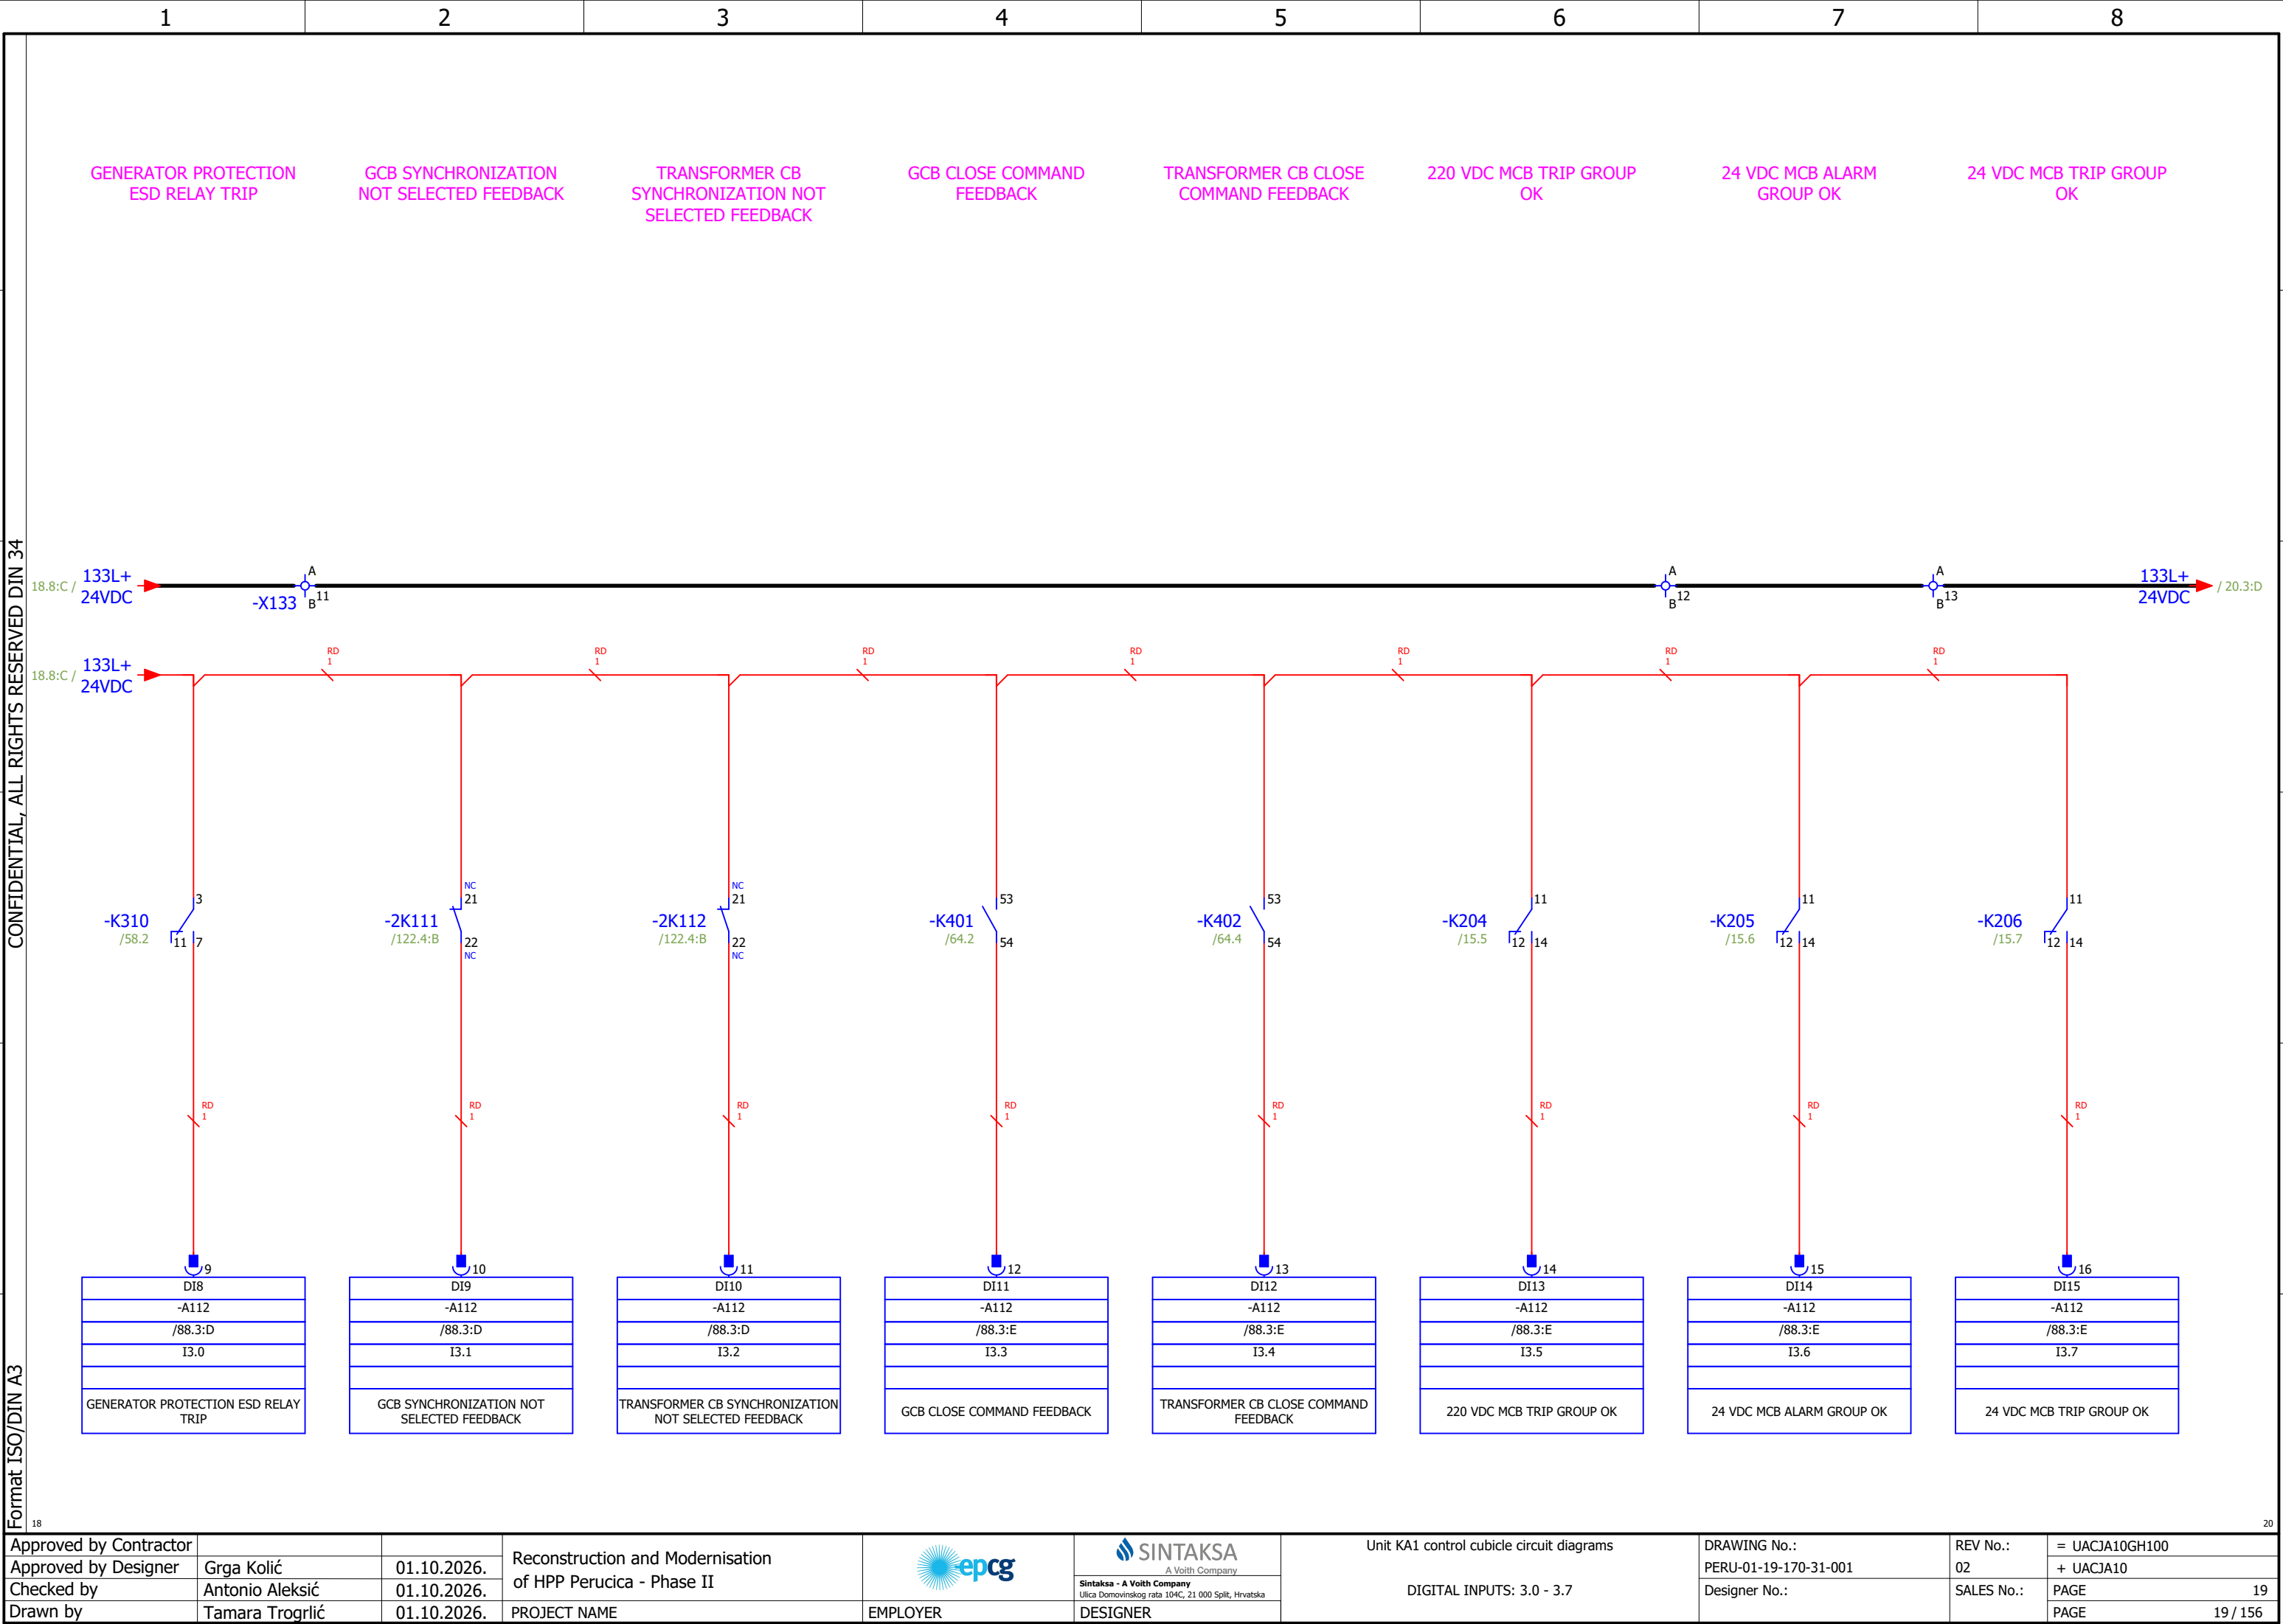

CONFIDENTIAL, ALL RIGHTS RESERVED DIN 34

Format ISO/DIN A3

AUTOMATIC CONTROL

SPARE

AC VOLTAGE NOT OK


EXCITATION AC MCB NOT OK

SPARE (GENERATOR LIGHTING/ HEATER AC MCB NOT OK)


UNIT CONTROL AC MCB NOT OK

SPARE (GENERATOR DRAINAGE AC MCB NOT OK)


SPARE 1 AC MCB NOT OK

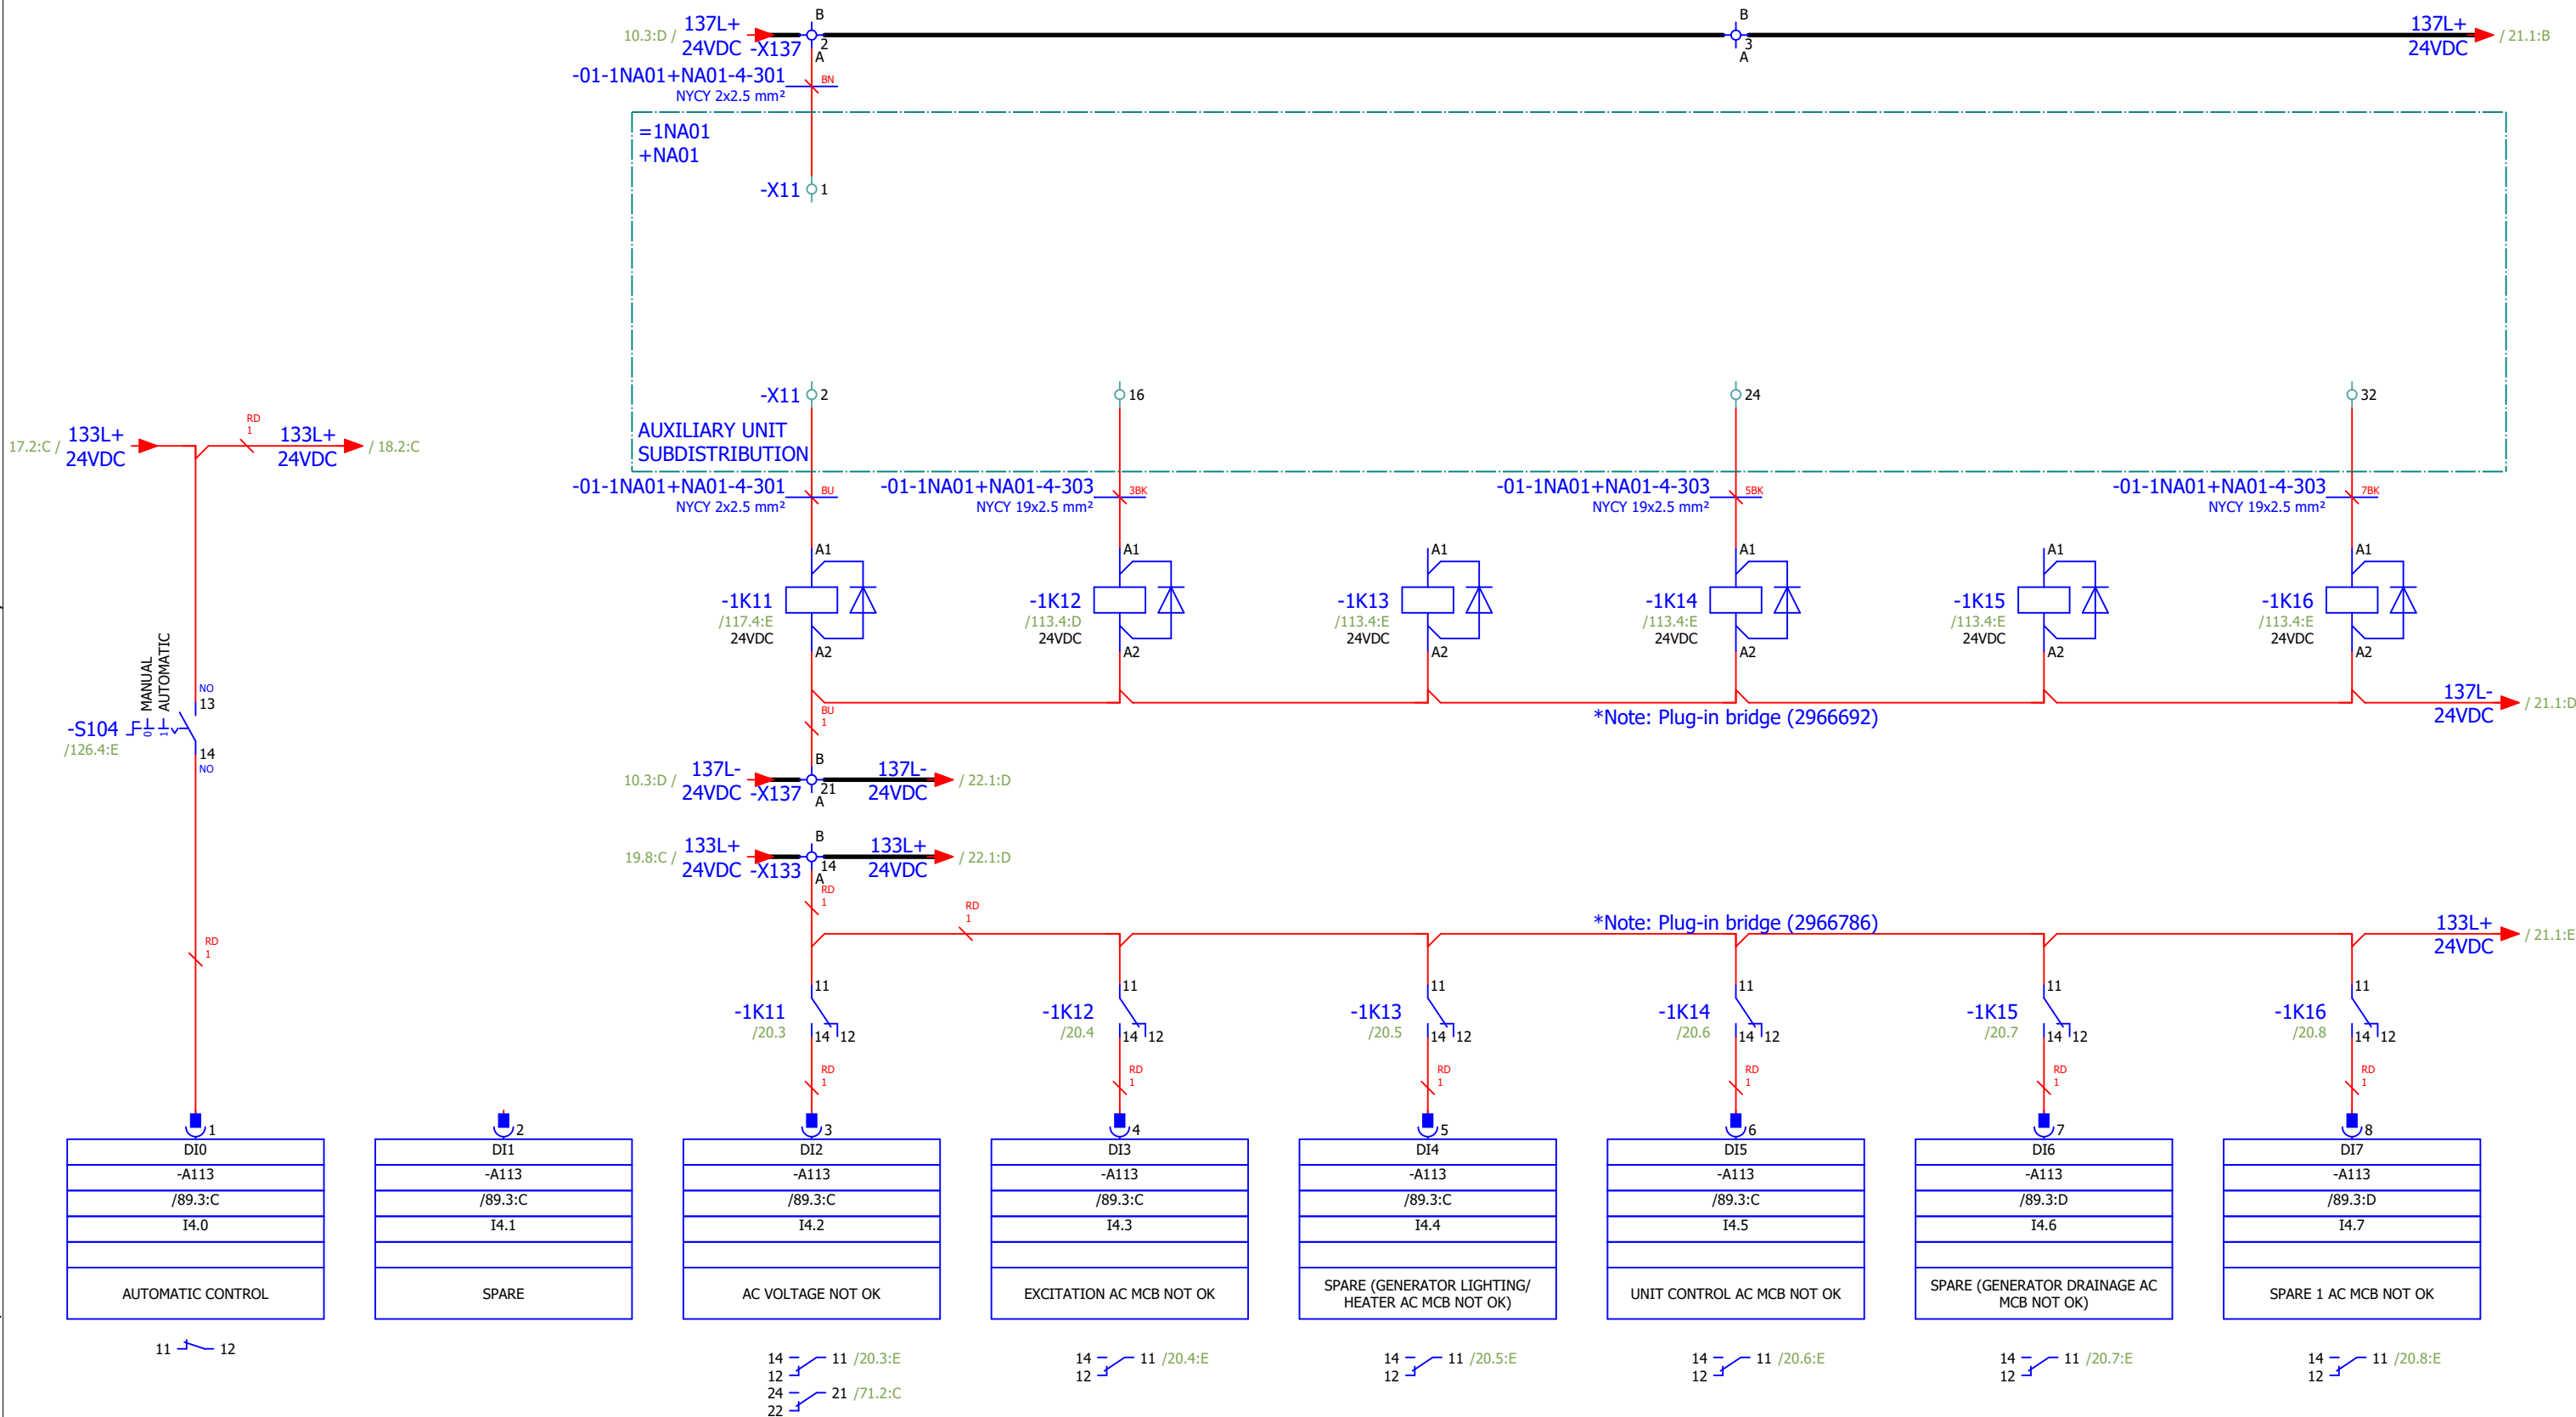

Approved by Contractor			Reconstruction and Modernisation of HPP Perucica - Phase II		 A Voith Company Sintaksa - A Voith Company Ulica Domovinskog rata 104C, 21 000 Split, Hrvatska	Unit KA1 control cubicle circuit diagrams DIGITAL INPUTS: 4.0 - 4.7		DRAWING No.: PERU-01-19-170-31-001	REV No.: 02	= UACJA10GH100
Approved by Designer	Grga Kolić	01.10.2026.						Designer No.:	SALES No.:	+ UACJA10
Checked by	Antonio Aleksić	01.10.2026.								PAGE 20
Drawn by	Tamara Trogrlić	01.10.2026.								PAGE 20 / 156

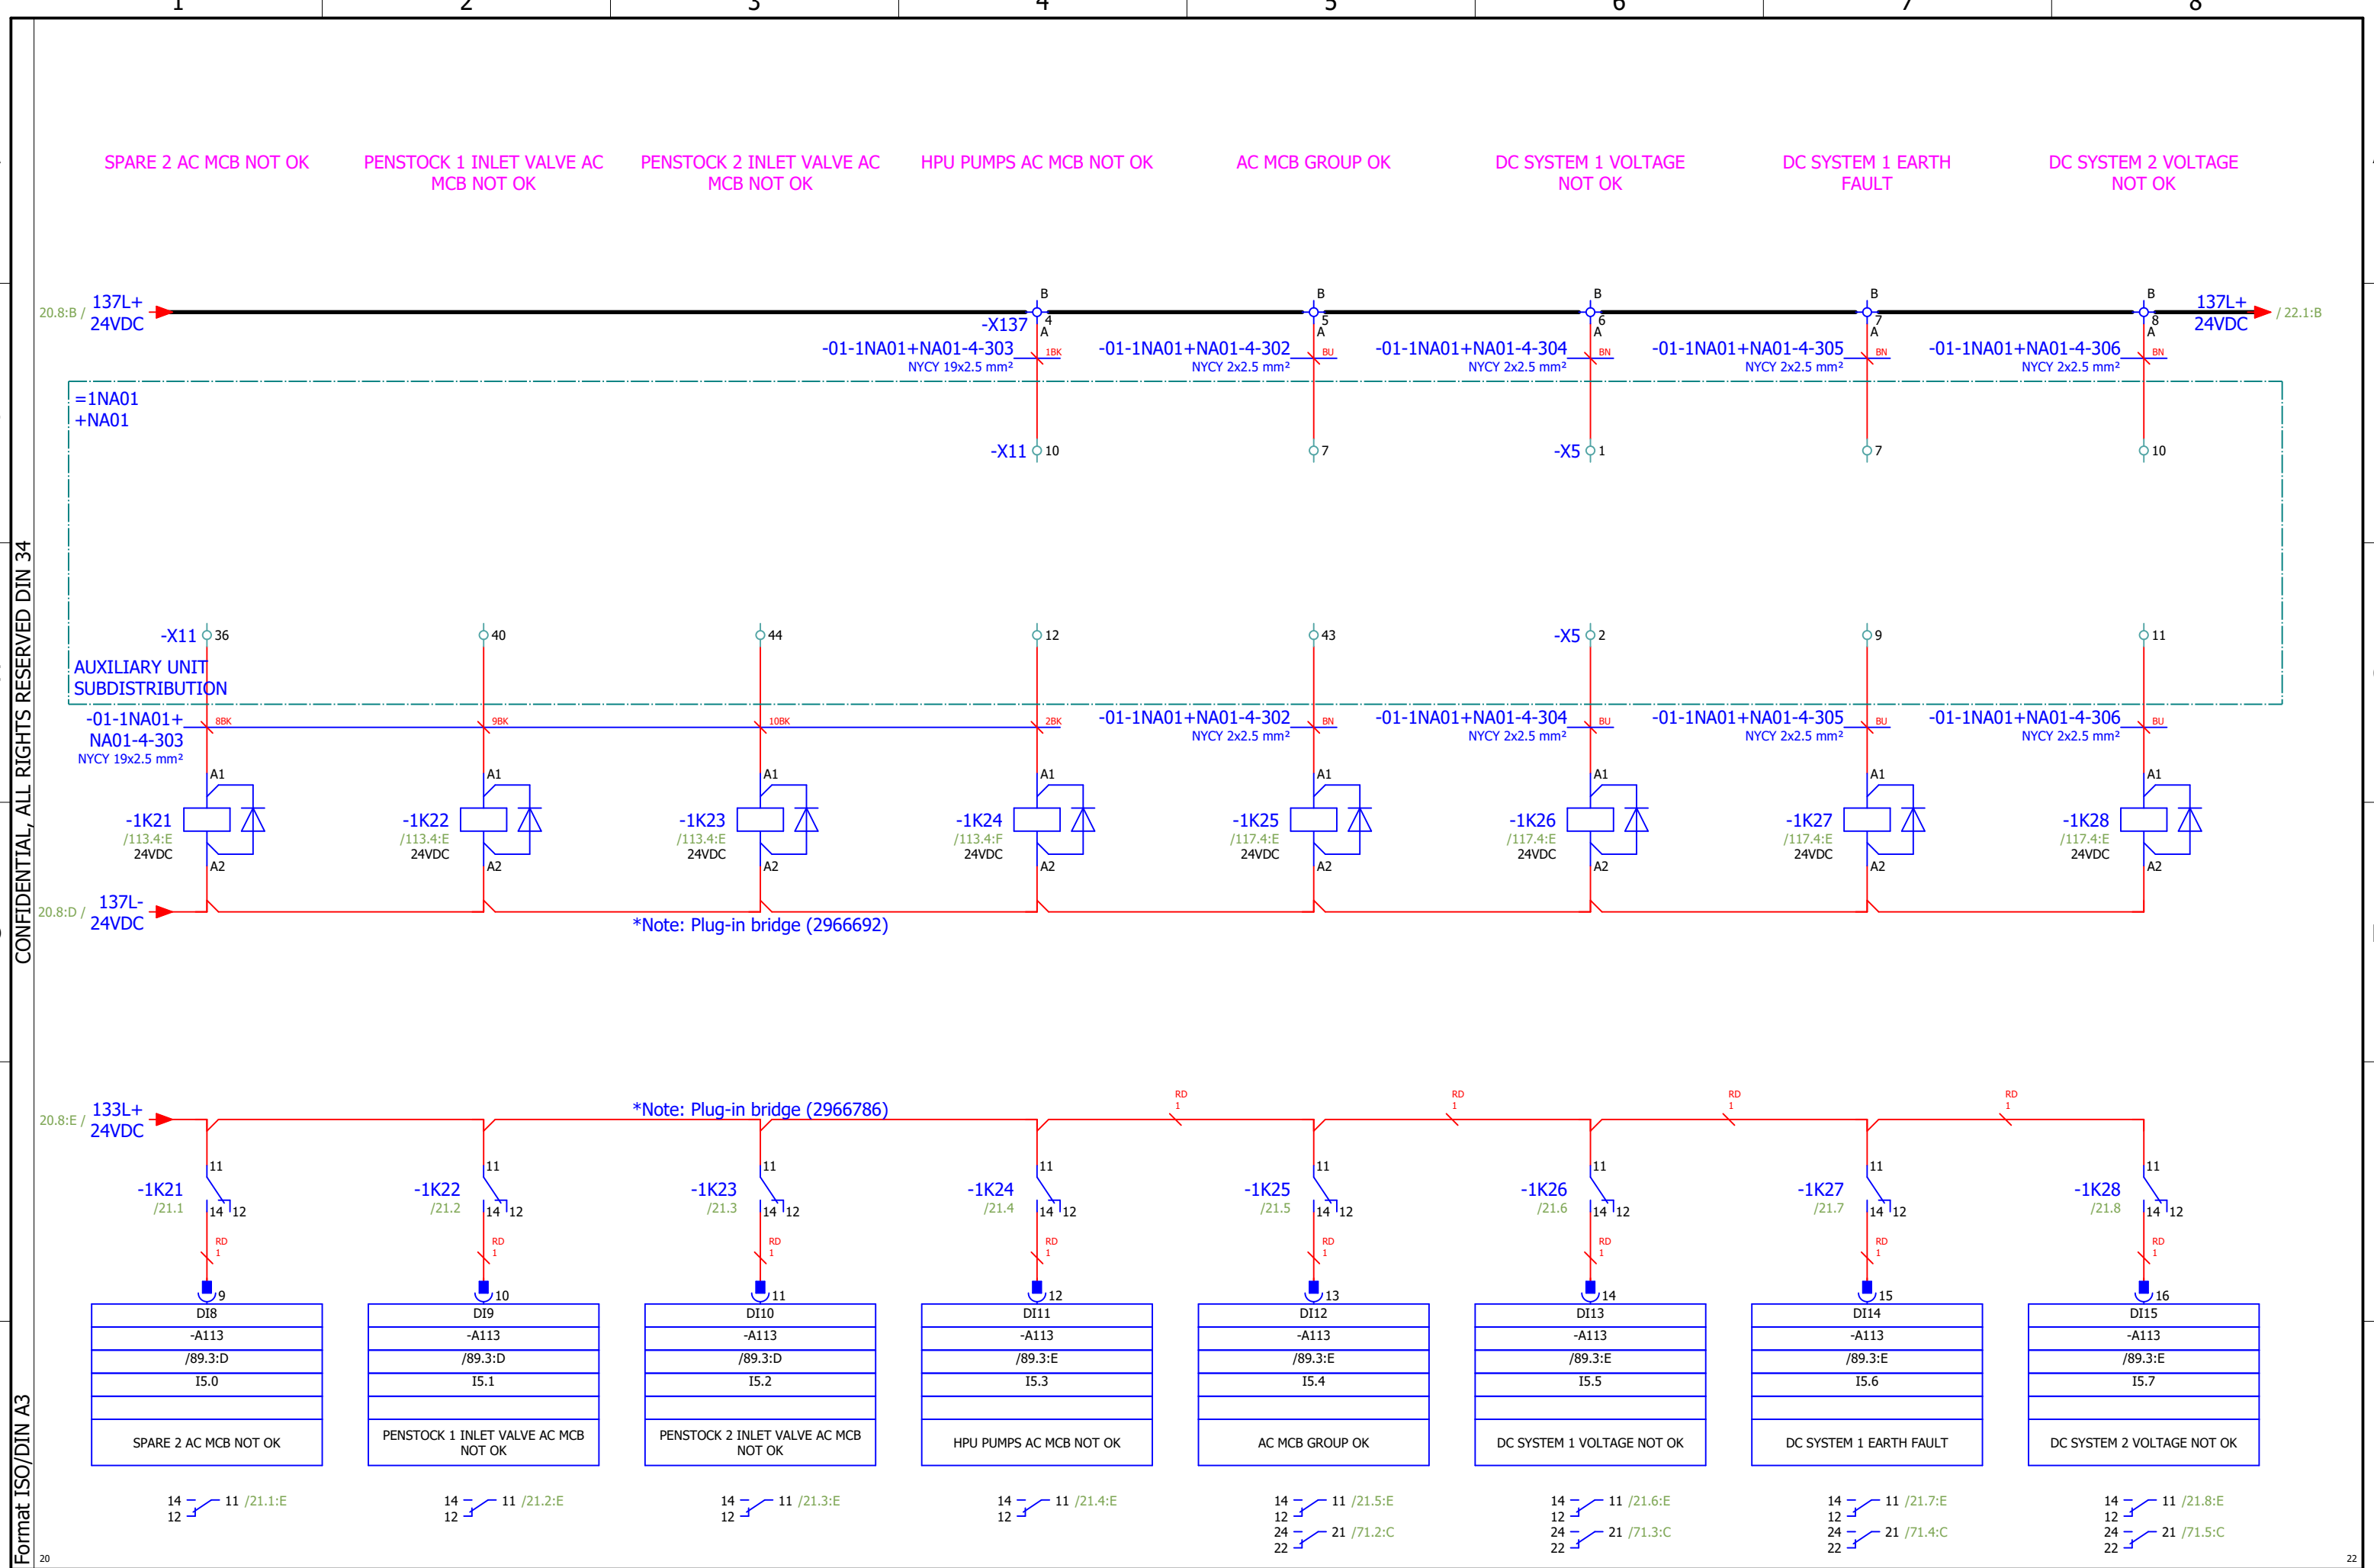

Approved by Contractor			Reconstruction and Modernisation of HPP Perucica - Phase II		SINTAKSA A Voith Company	Unit KA1 control cubicle circuit diagrams	DRAWING No.: PERU-01-19-170-31-001	REV No.: 02	= UACJA10GH100
Approved by Designer	Grga Kolić	01.10.2026.			Sintaksa - A Voith Company Ulica Domovinskog rata 104C, 21 000 Split, Hrvatska	DIGITAL INPUTS: 5.0 - 5.7	Designer No.:	SALES No.:	+ UACJA10
Checked by	Antonio Aleksić	01.10.2026.							PAGE 21
Drawn by	Tamara Trogrlić	01.10.2026.	PROJECT NAME	EMPLOYER	DESIGNER				PAGE 21 / 156

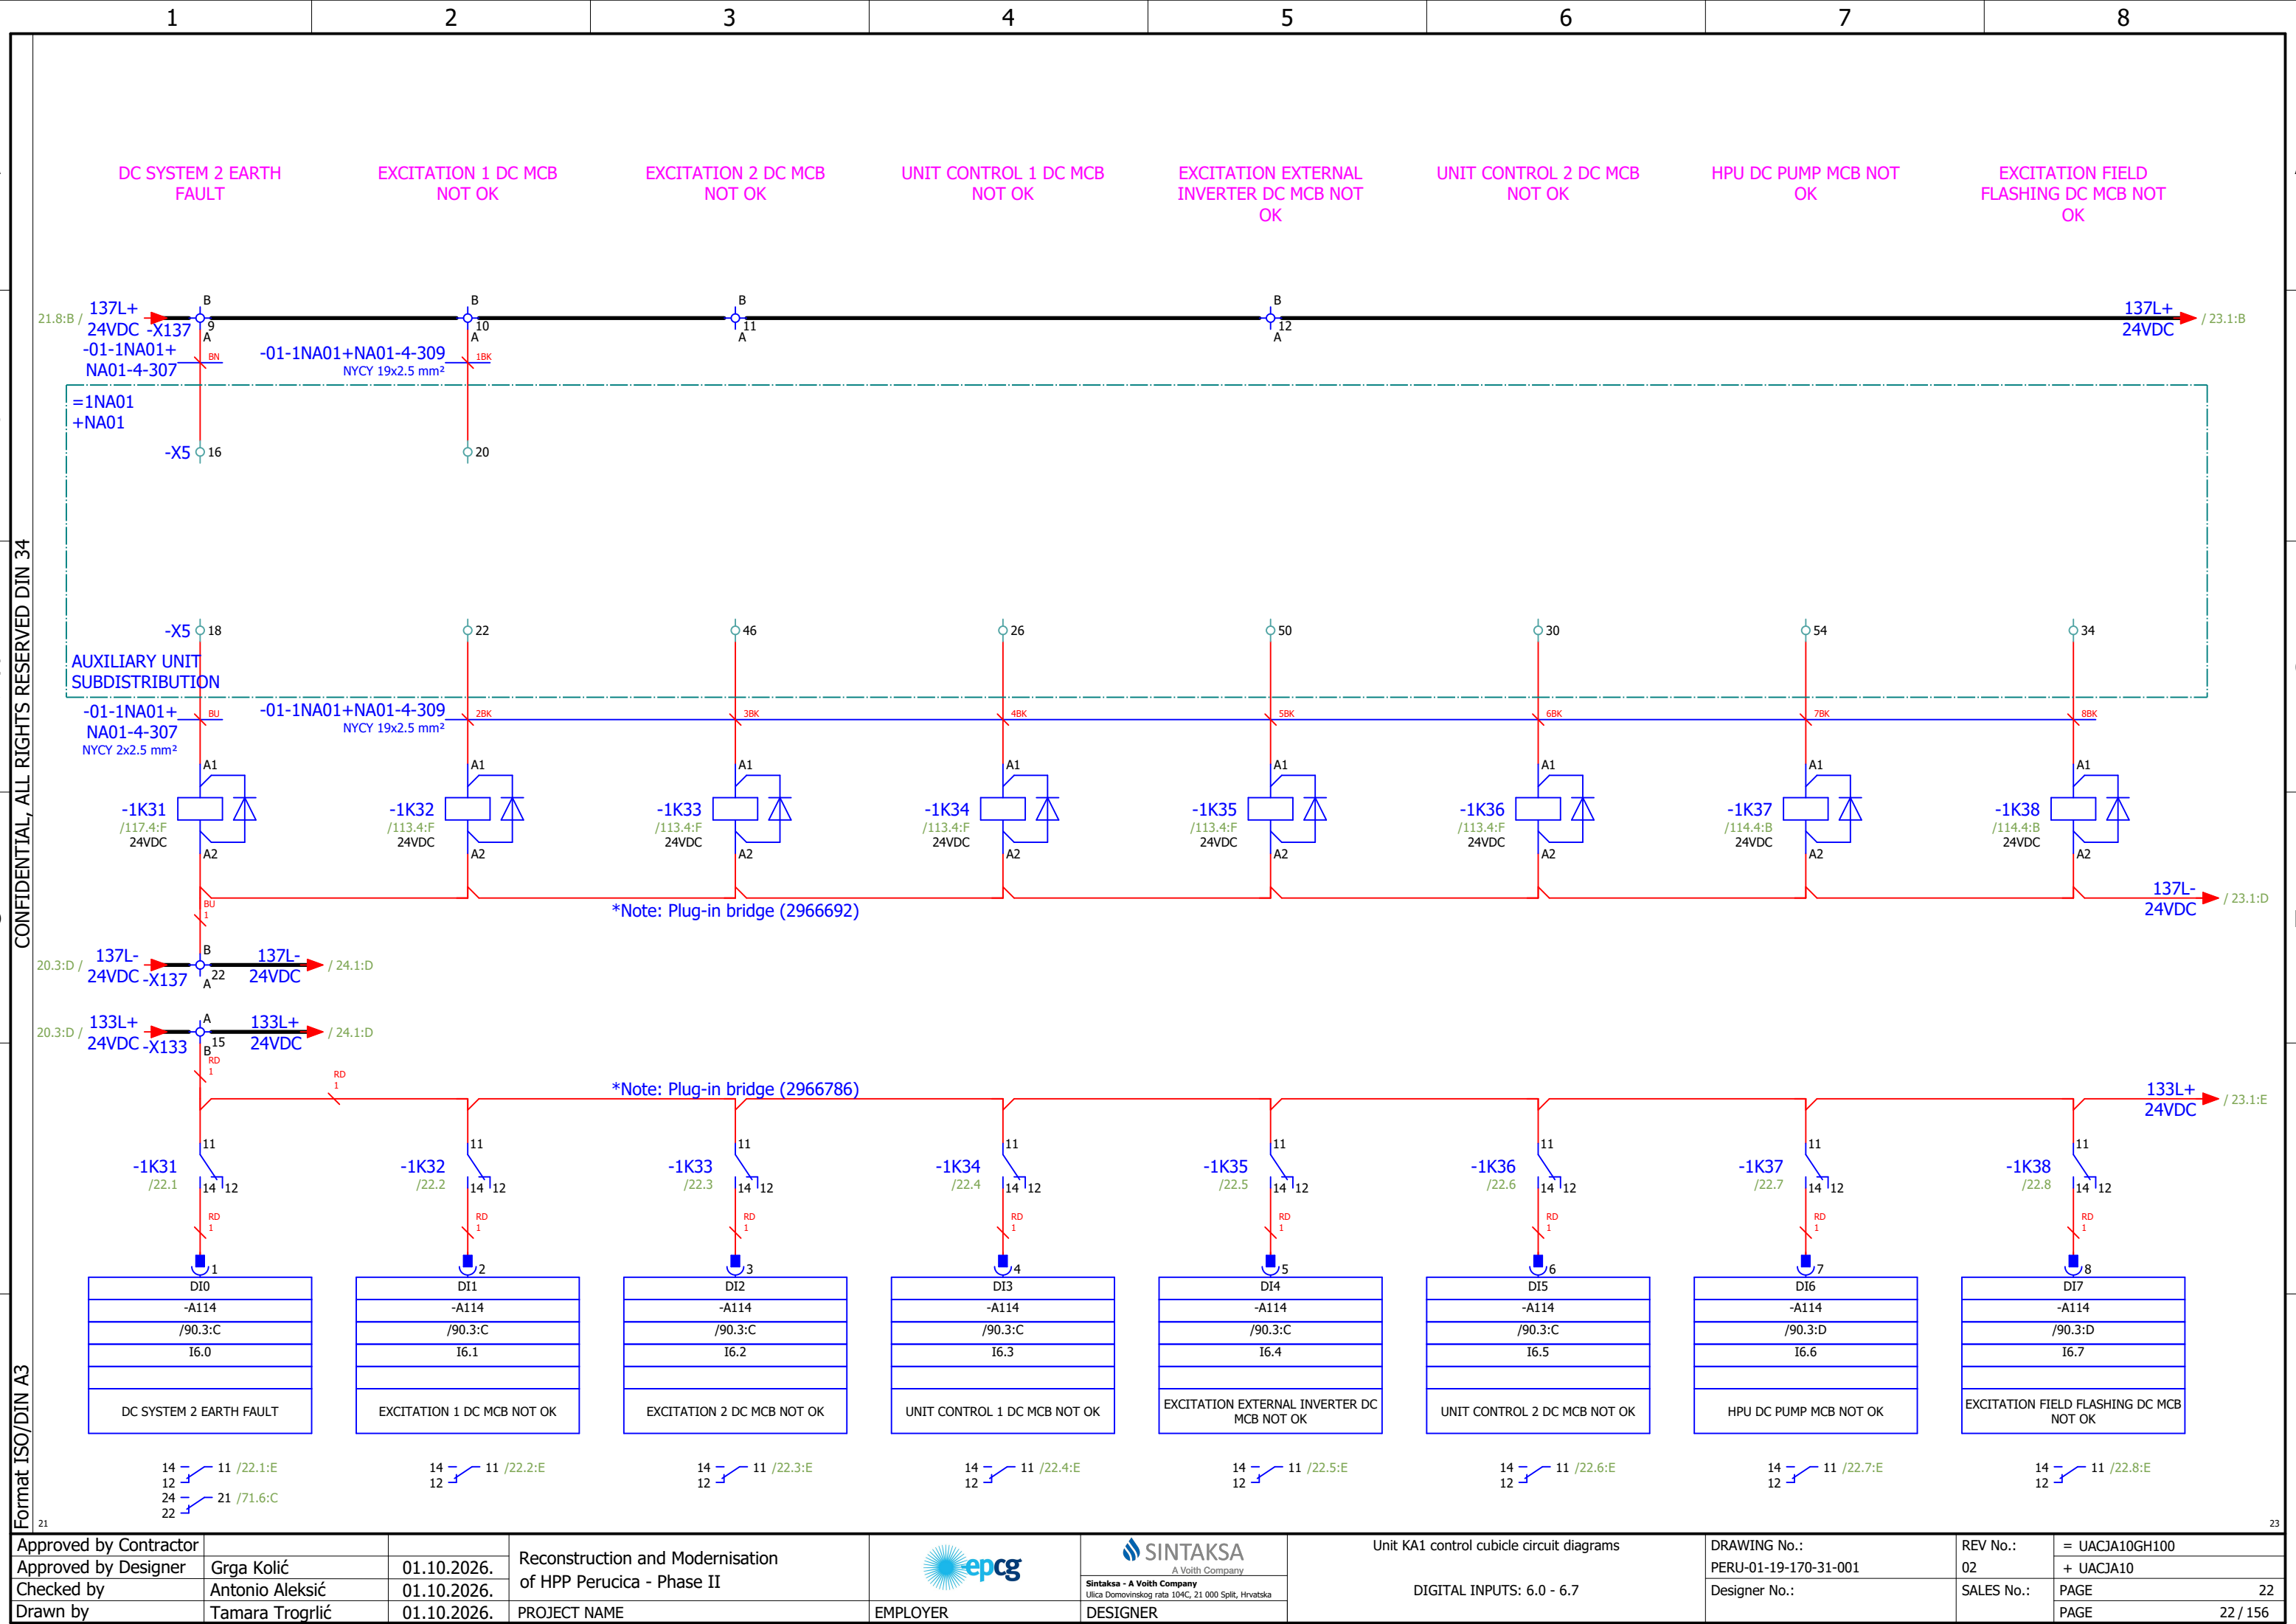

Approved by Contractor			Reconstruction and Modernisation of HPP Perucica - Phase II		 A Voith Company	Unit KA1 control cubicle circuit diagrams	DRAWING No.: PERU-01-19-170-31-001	REV No.: 02	= UACJA10GH100
Approved by Designer	Grga Kolić	01.10.2026.			Sintaksa - A Voith Company Ulica Domovinskog rata 104C, 21 000 Split, Hrvatska	DIGITAL INPUTS: 6.0 - 6.7	Designer No.:	SALES No.:	+ UACJA10
Checked by	Antonio Aleksić	01.10.2026.							PAGE 22
Drawn by	Tamara Trogrlić	01.10.2026.	PROJECT NAME	EMPLOYER	DESIGNER				PAGE 22 / 156



1	2	3	4	5	6	7	8
---	---	---	---	---	---	---	---

CONFIDENTIAL, ALL RIGHTS RESERVED DIN 34

Format ISO/DIN A3

23

25

Approved by Contractor			Reconstruction and Modernisation of HPP Perucica - Phase II		 A Voith Company	Unit KA1 control cubicle circuit diagrams	DRAWING No.: PERU-01-19-170-31-001	REV No.: 02	= UACJA10GH100
Approved by Designer	Grga Kolić	01.10.2026.			Sintaksa - A Voith Company Ulica Domovinskog rata 104C, 21 000 Split, Hrvatska	DIGITAL INPUTS: 8.0 - 8.7	Designer No.:	SALES No.:	+ UACJA10
Checked by	Antonio Aleksić	01.10.2026.							PAGE 24
Drawn by	Tamara Trogrlić	01.10.2026.	PROJECT NAME	EMPLOYER	DESIGNER				PAGE 24 / 156

A

B

C

D

E

F

A


B


C

D

E

F

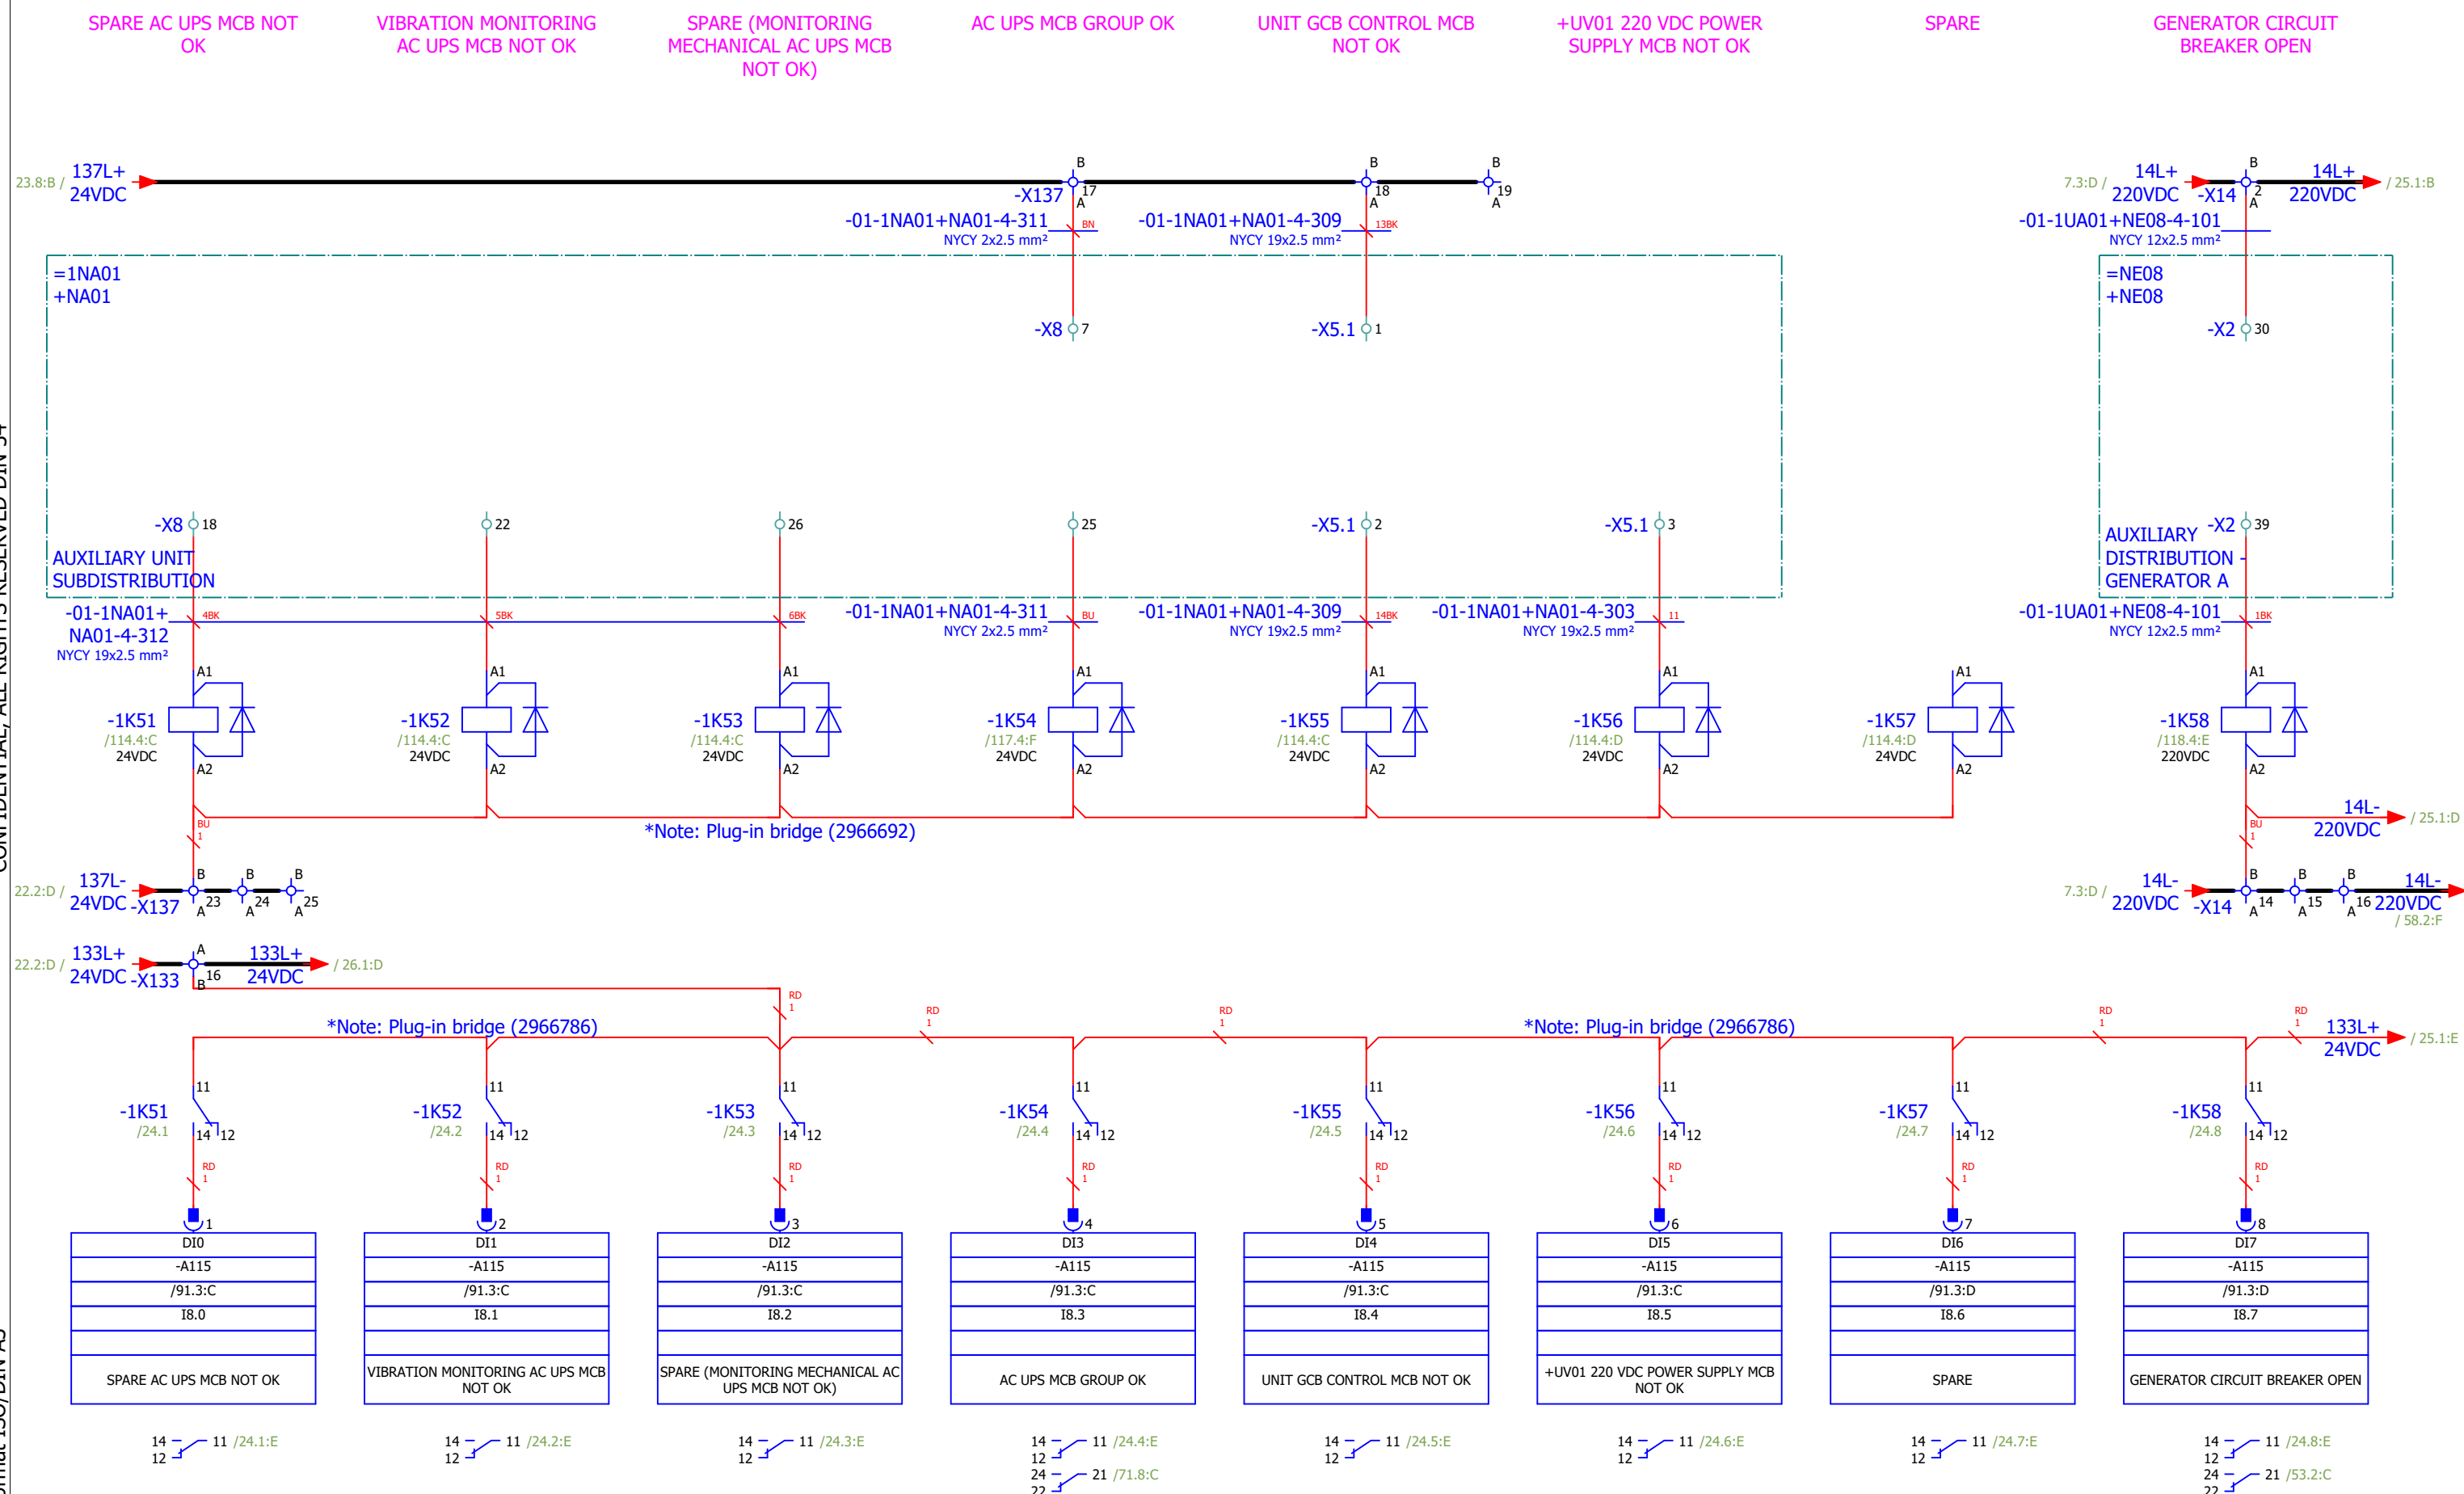


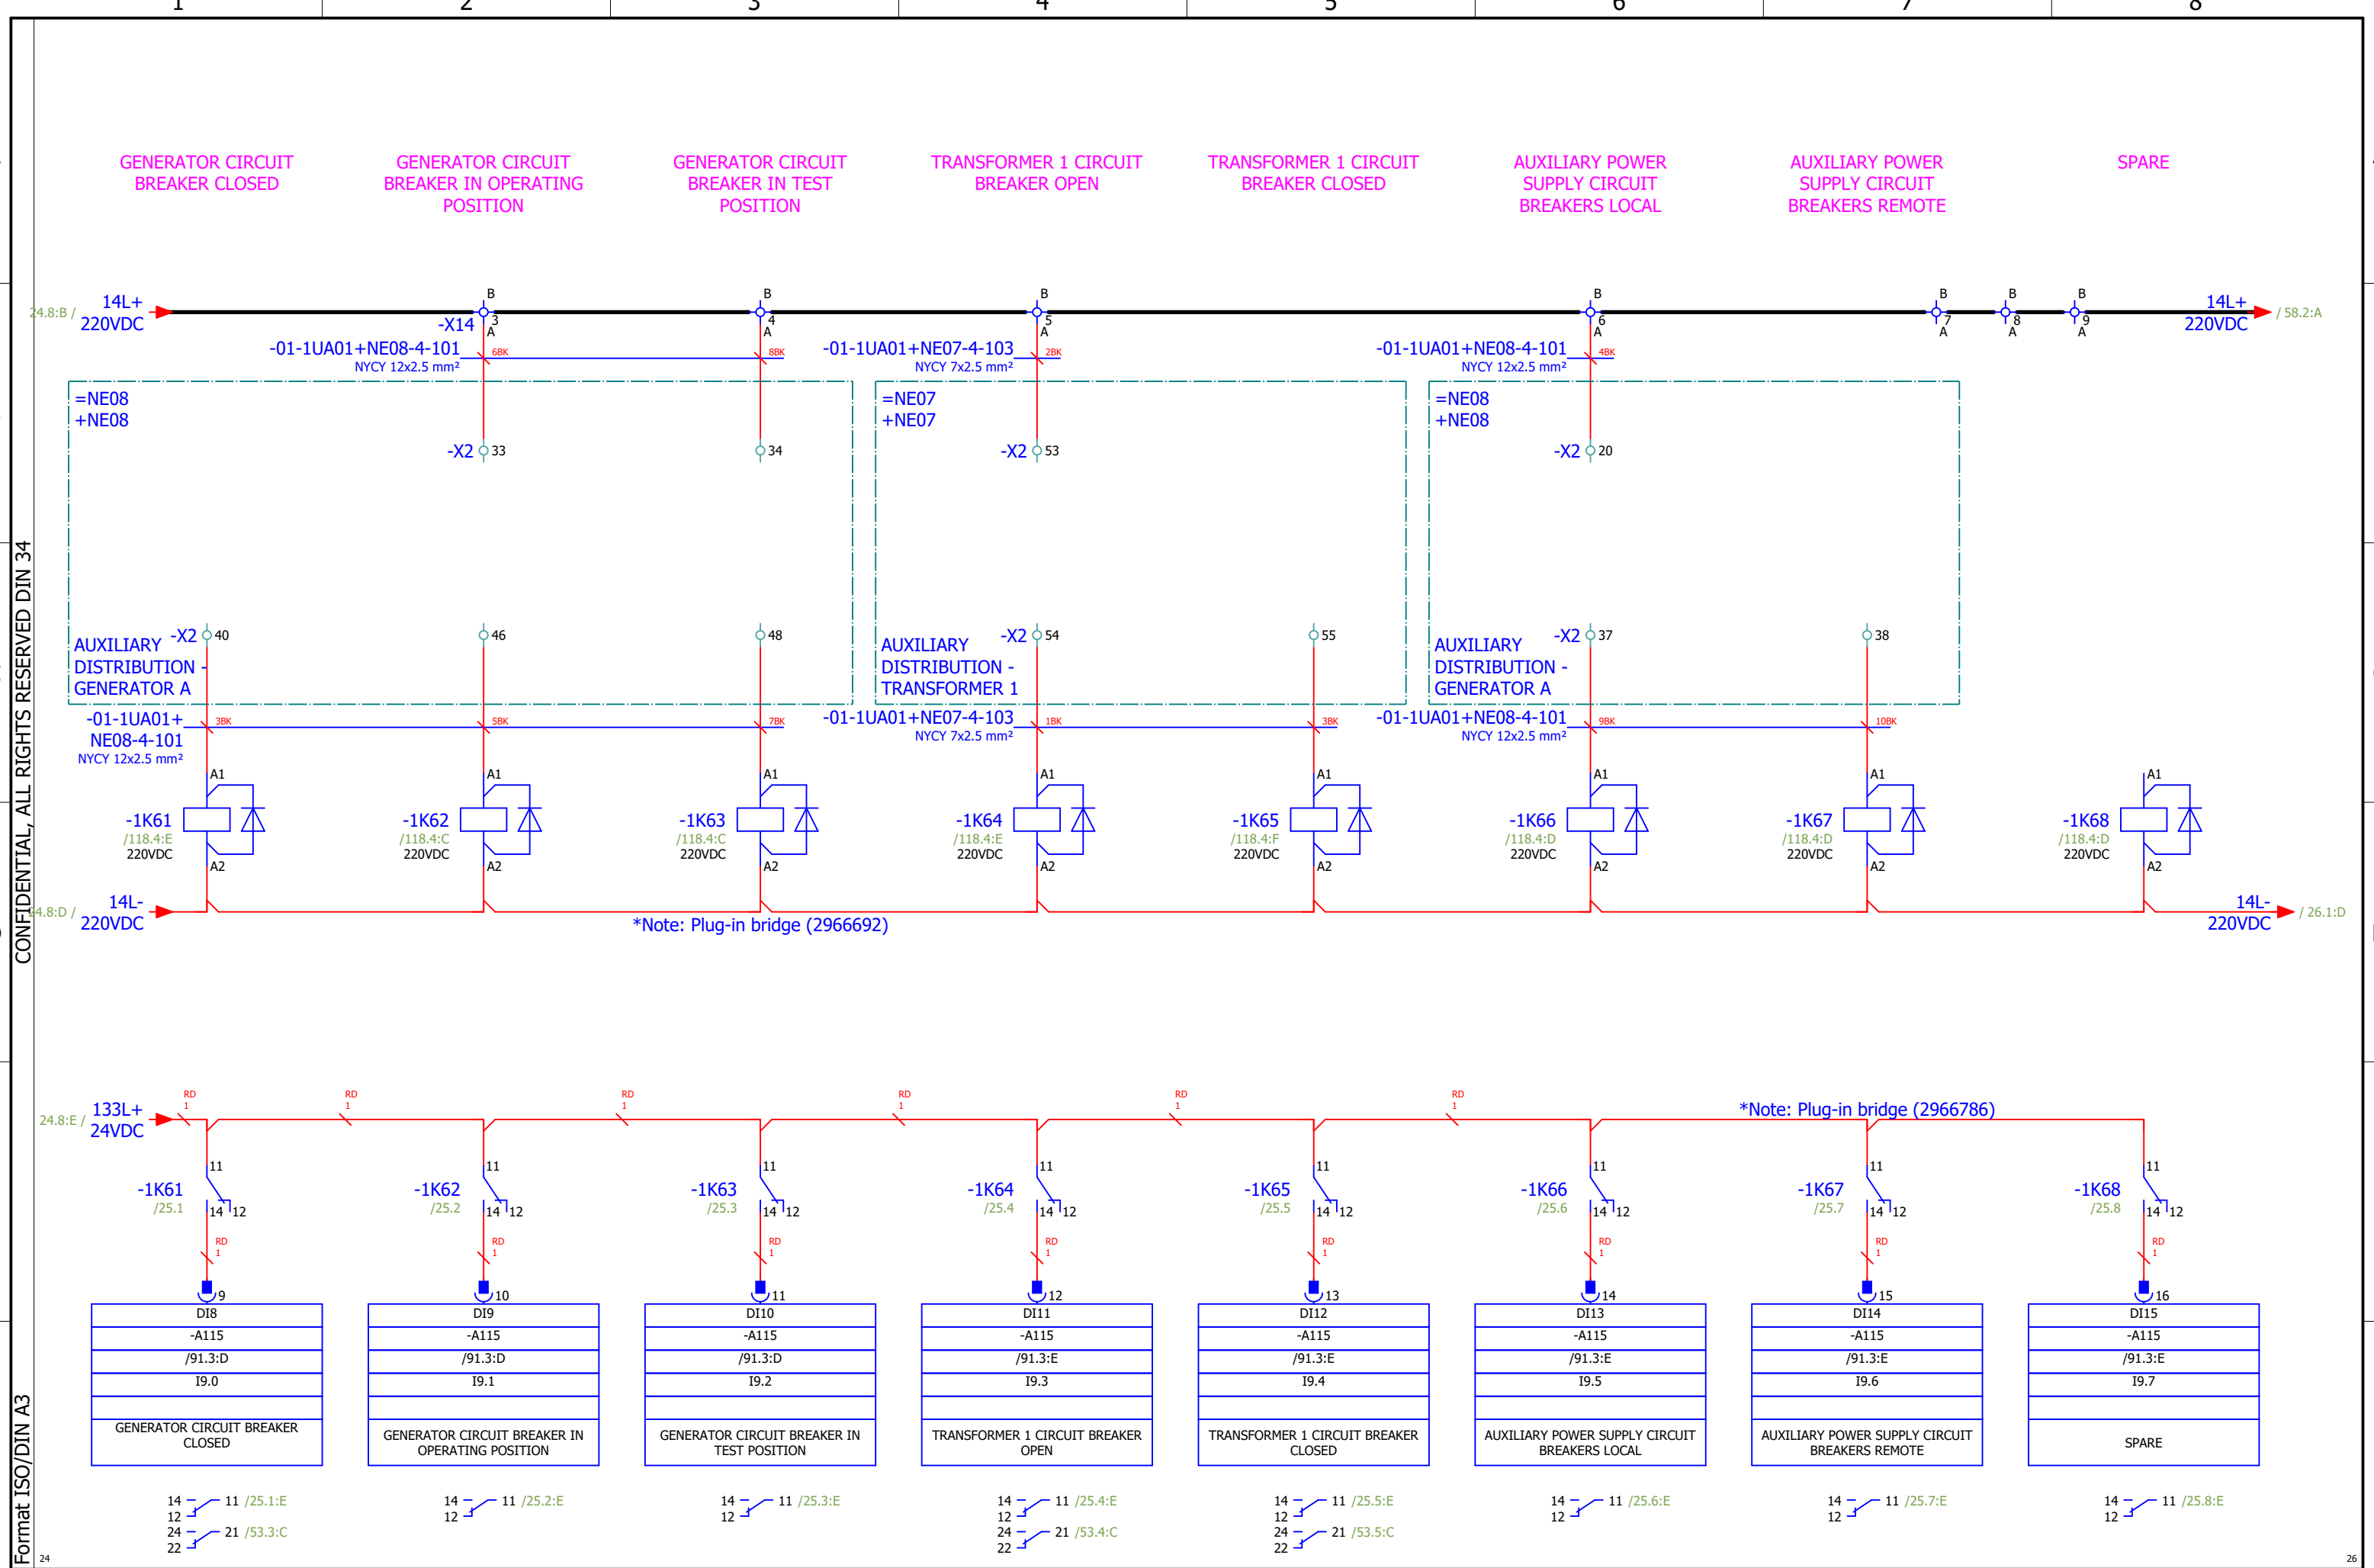


Approved by Contractor			Reconstruction and Modernisation of HPP Perucica - Phase II		SINTAKSA A Voith Company	Unit KA1 control cubicle circuit diagrams	DRAWING No.: PERU-01-19-170-31-001	REV No.: 02	= UACJA10GH100
Approved by Designer	Grga Kolić	01.10.2026.			Sintaksa - A Voith Company Ulica Domovinskog rata 104C, 21 000 Split, Hrvatska	DIGITAL INPUTS: 9.0 - 9.7	Designer No.:	SALES No.:	+ UACJA10
Checked by	Antonio Aleksić	01.10.2026.							PAGE 25
Drawn by	Tamara Trogrlić	01.10.2026.	PROJECT NAME	EMPLOYER	DESIGNER				PAGE 25 / 156

CONFIDENTIAL, ALL RIGHTS RESERVED DIN 34

Format ISO/DIN A3

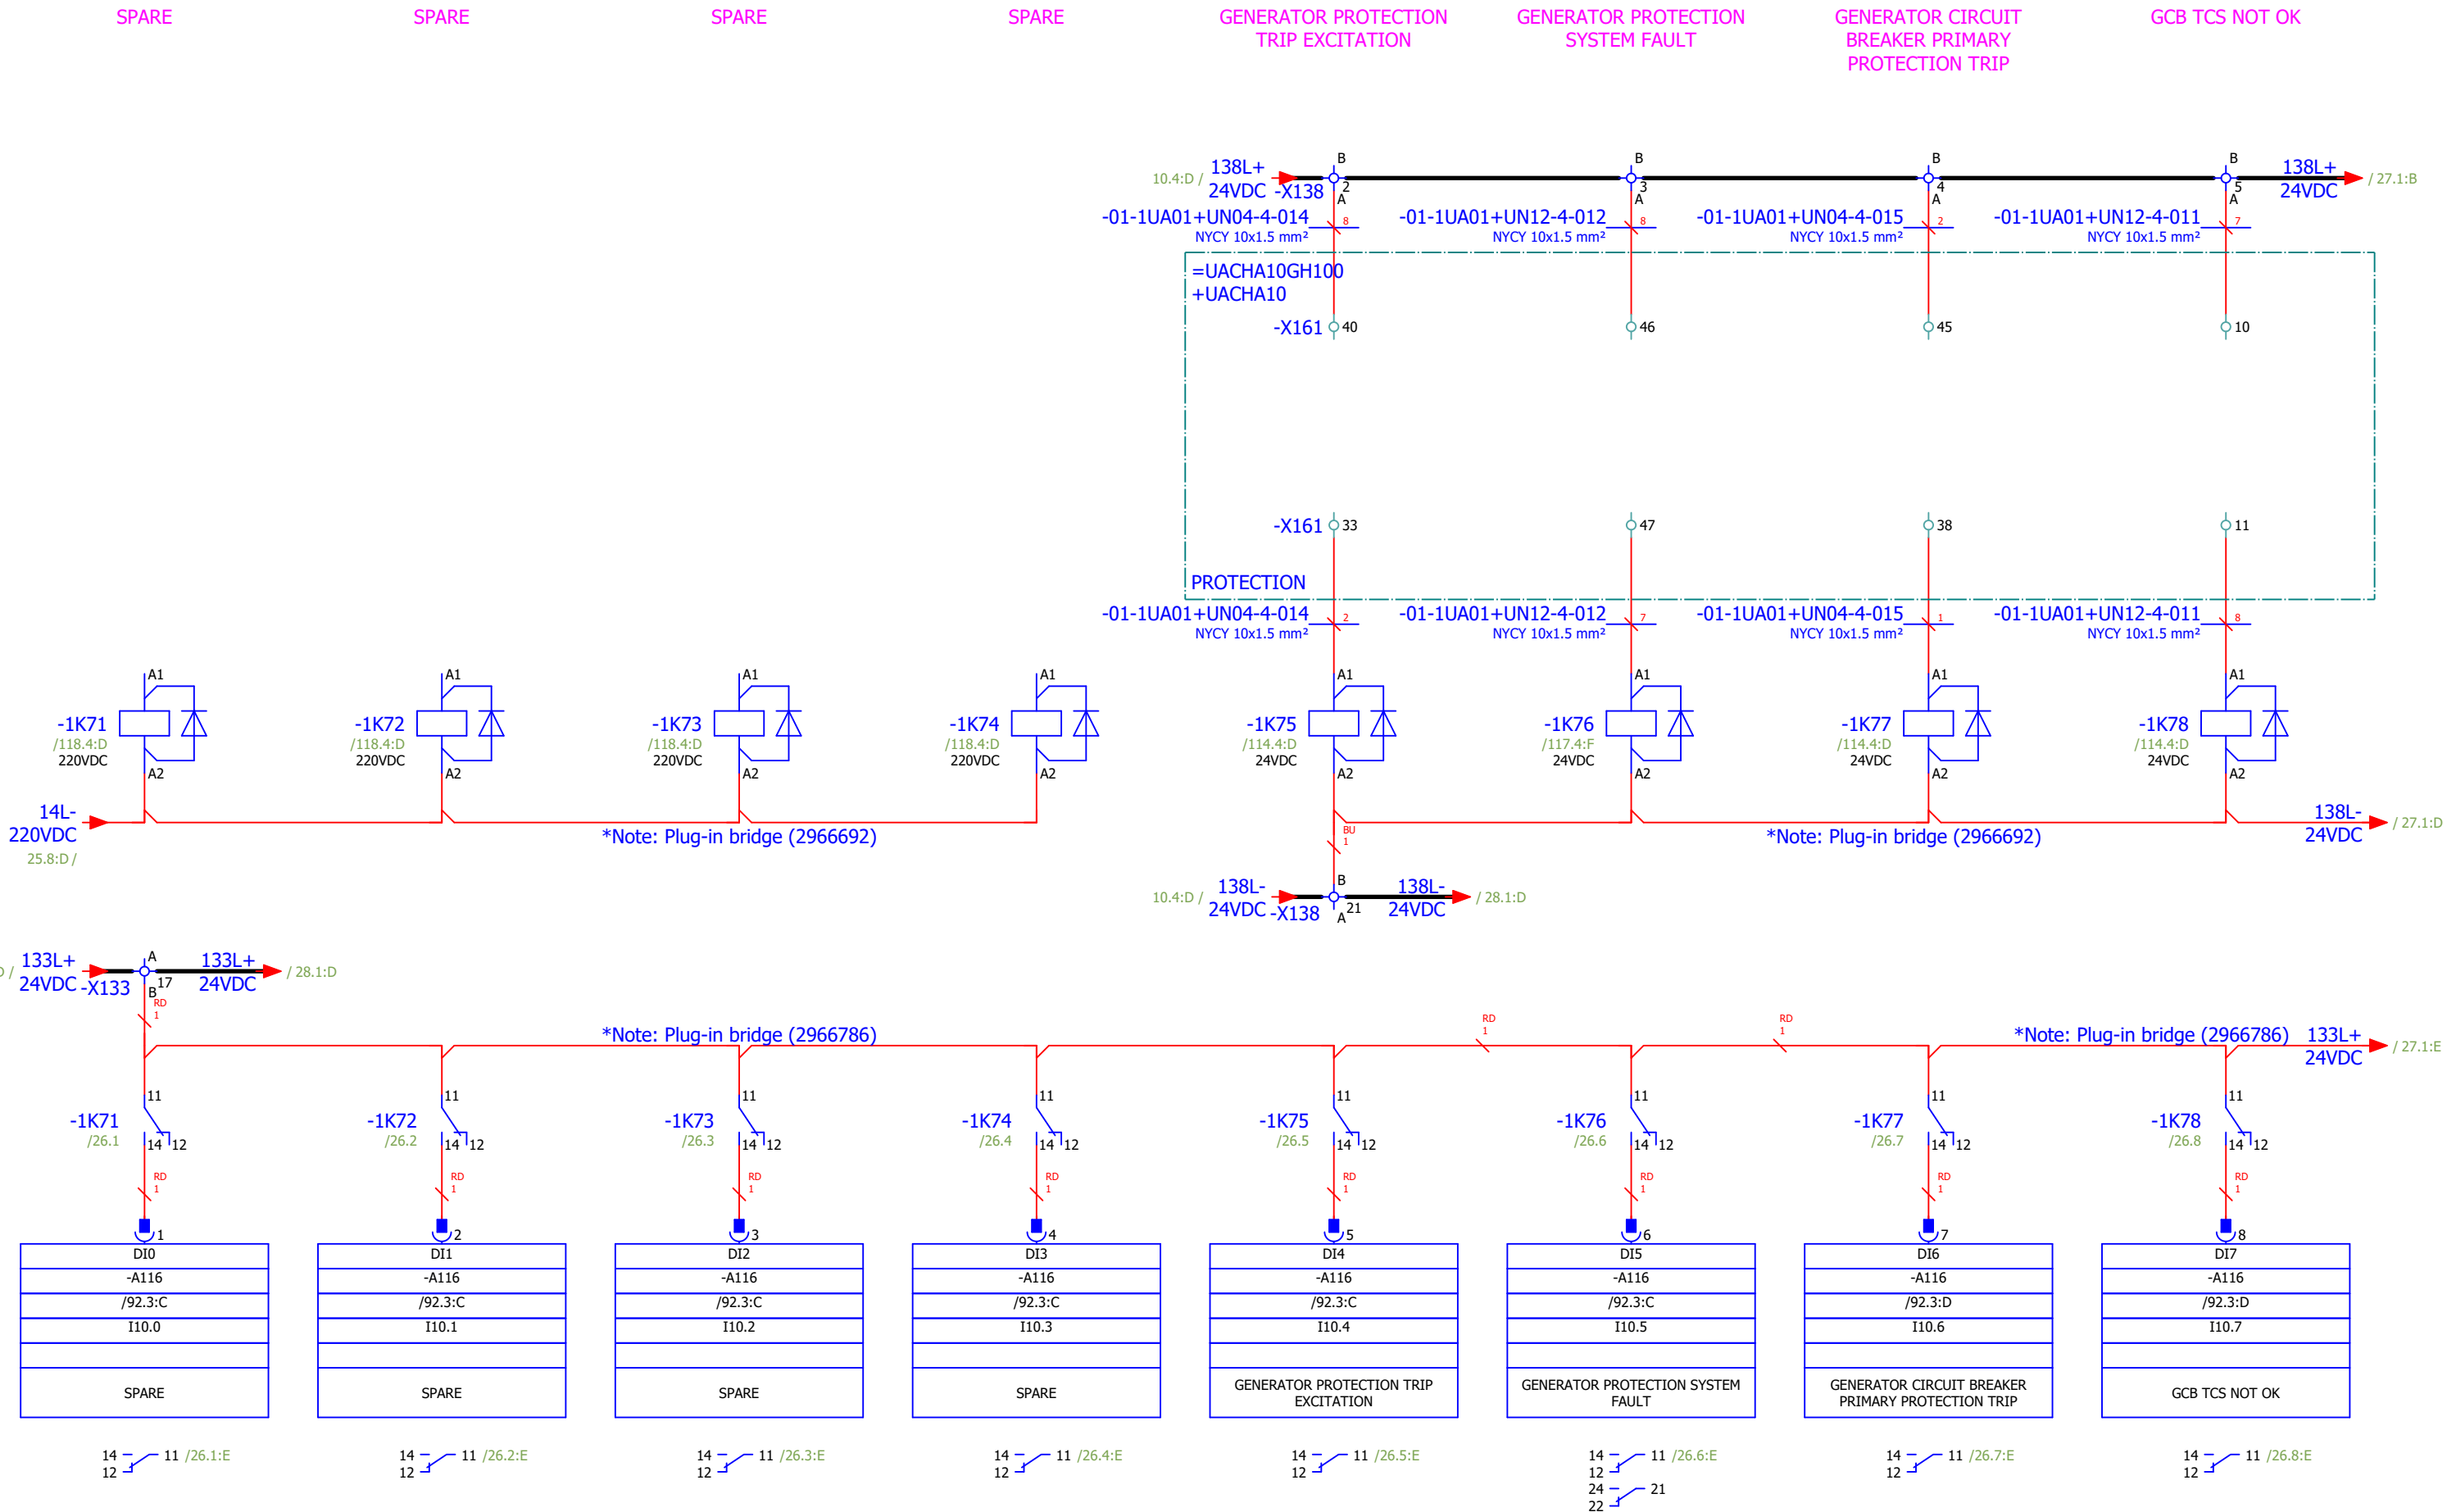

Approved by Contractor			Reconstruction and Modernisation of HPP Perucica - Phase II		SINTAKSA A Voith Company	Unit KA1 control cubicle circuit diagrams	DRAWING No.: PERU-01-19-170-31-001	REV No.: 02	= UACJA10GH100
Approved by Designer	Grga Kolić	01.10.2026.			Sintaksa - A Voith Company Ulica Domovinskog rata 104C, 21 000 Split, Hrvatska	DIGITAL INPUTS: 10.0 - 10.7	Designer No.:	SALES No.:	+ UACJA10
Checked by	Antonio Aleksić	01.10.2026.							PAGE 26
Drawn by	Tamara Trogrlić	01.10.2026.	PROJECT NAME	EMPLOYER	DESIGNER				PAGE 26 / 156

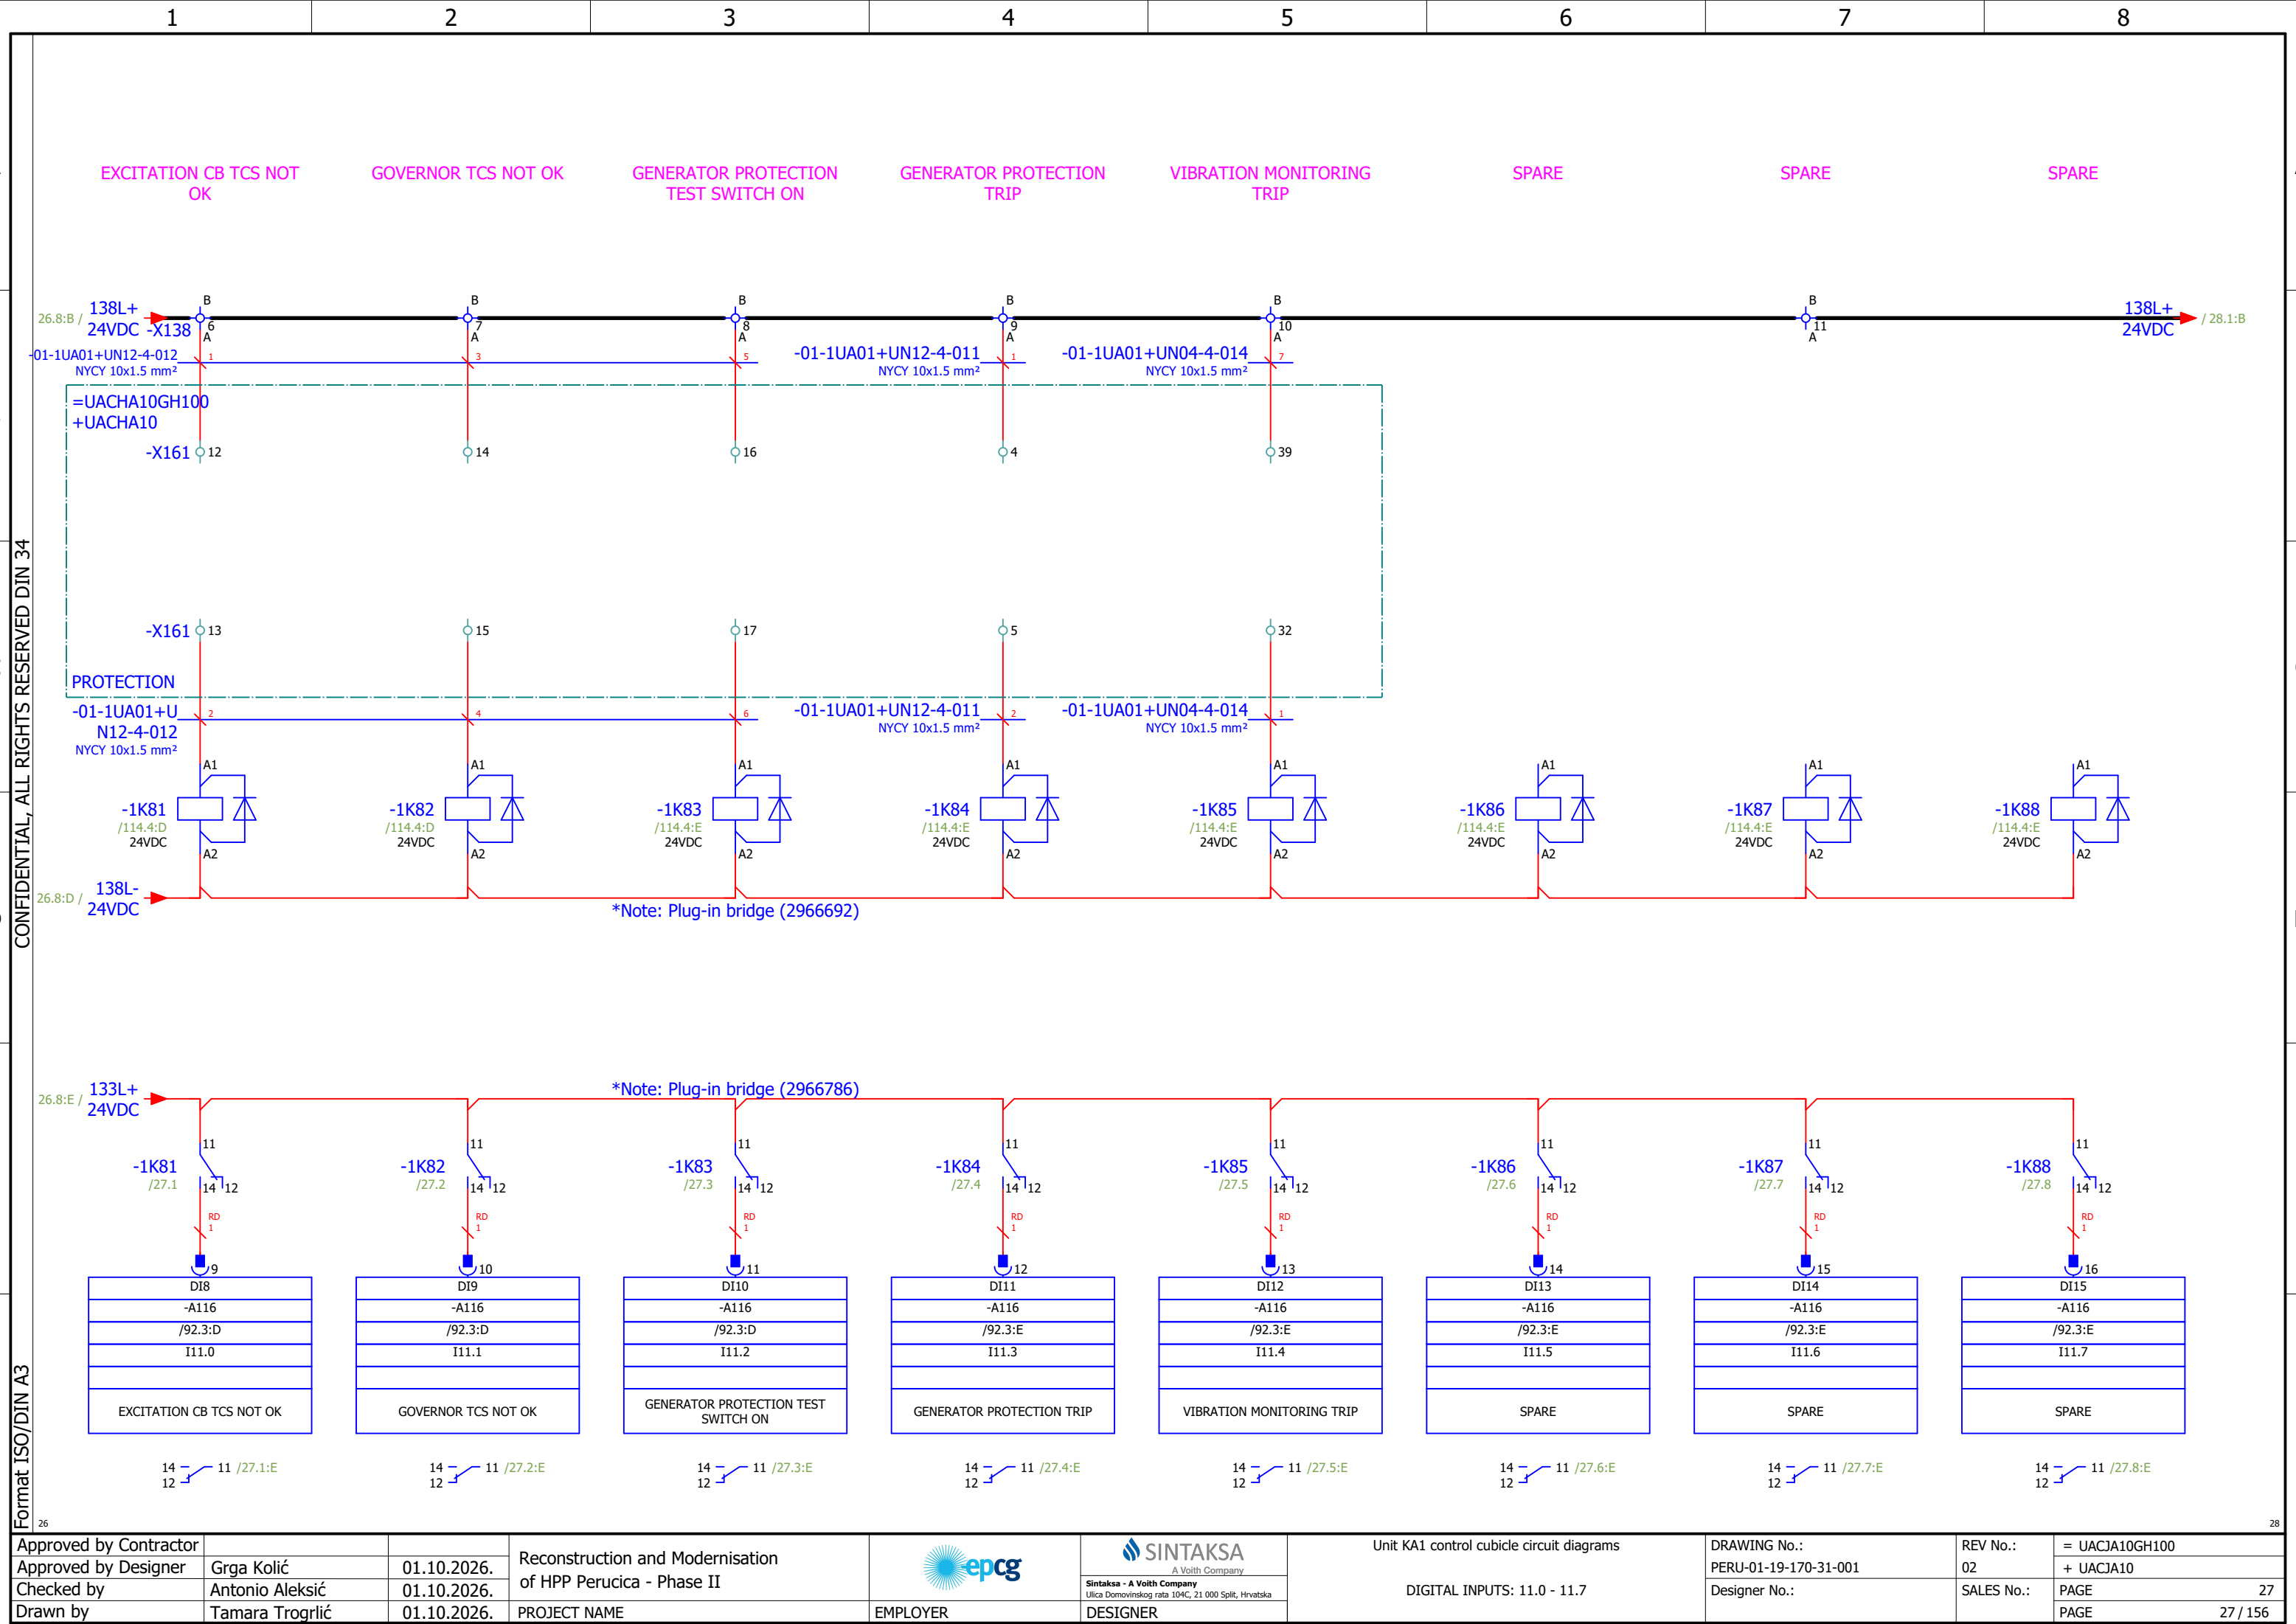

Approved by Contractor			Reconstruction and Modernisation of HPP Perucica - Phase II		 A Voith Company Sintaksa - A Voith Company Ulica Domovinskog rata 104C, 21 000 Split, Hrvatska	Unit KA1 control cubicle circuit diagrams DIGITAL INPUTS: 11.0 - 11.7	DRAWING No.: PERU-01-19-170-31-001	REV No.: 02	= UACJA10GH100 + UACJA10
Approved by Designer	Grga Kolić	01.10.2026.					Designer No.:	SALES No.:	PAGE 27
Checked by	Antonio Aleksić	01.10.2026.							
Drawn by	Tamara Trogrlić	01.10.2026.							PAGE 27 / 156


CONFIDENTIAL, ALL RIGHTS RESERVED DIN 34

Format ISO/DIN A3

27

29

Approved by Contractor			Reconstruction and Modernisation of HPP Perucica - Phase II		 A Voith Company Sintaksa - A Voith Company Ulica Domovinskog rata 104C, 21 000 Split, Hrvatska	Unit KA1 control cubicle circuit diagrams DIGITAL INPUTS: 12.0 - 12.7	DRAWING No.: PERU-01-19-170-31-001	REV No.: 02	= UACJA10GH100
Approved by Designer	Grga Kolić	01.10.2026.					Designer No.:	SALES No.:	+ UACJA10
Checked by	Antonio Aleksić	01.10.2026.							PAGE 28
Drawn by	Tamara Trogrlić	01.10.2026.							PAGE 28 / 156

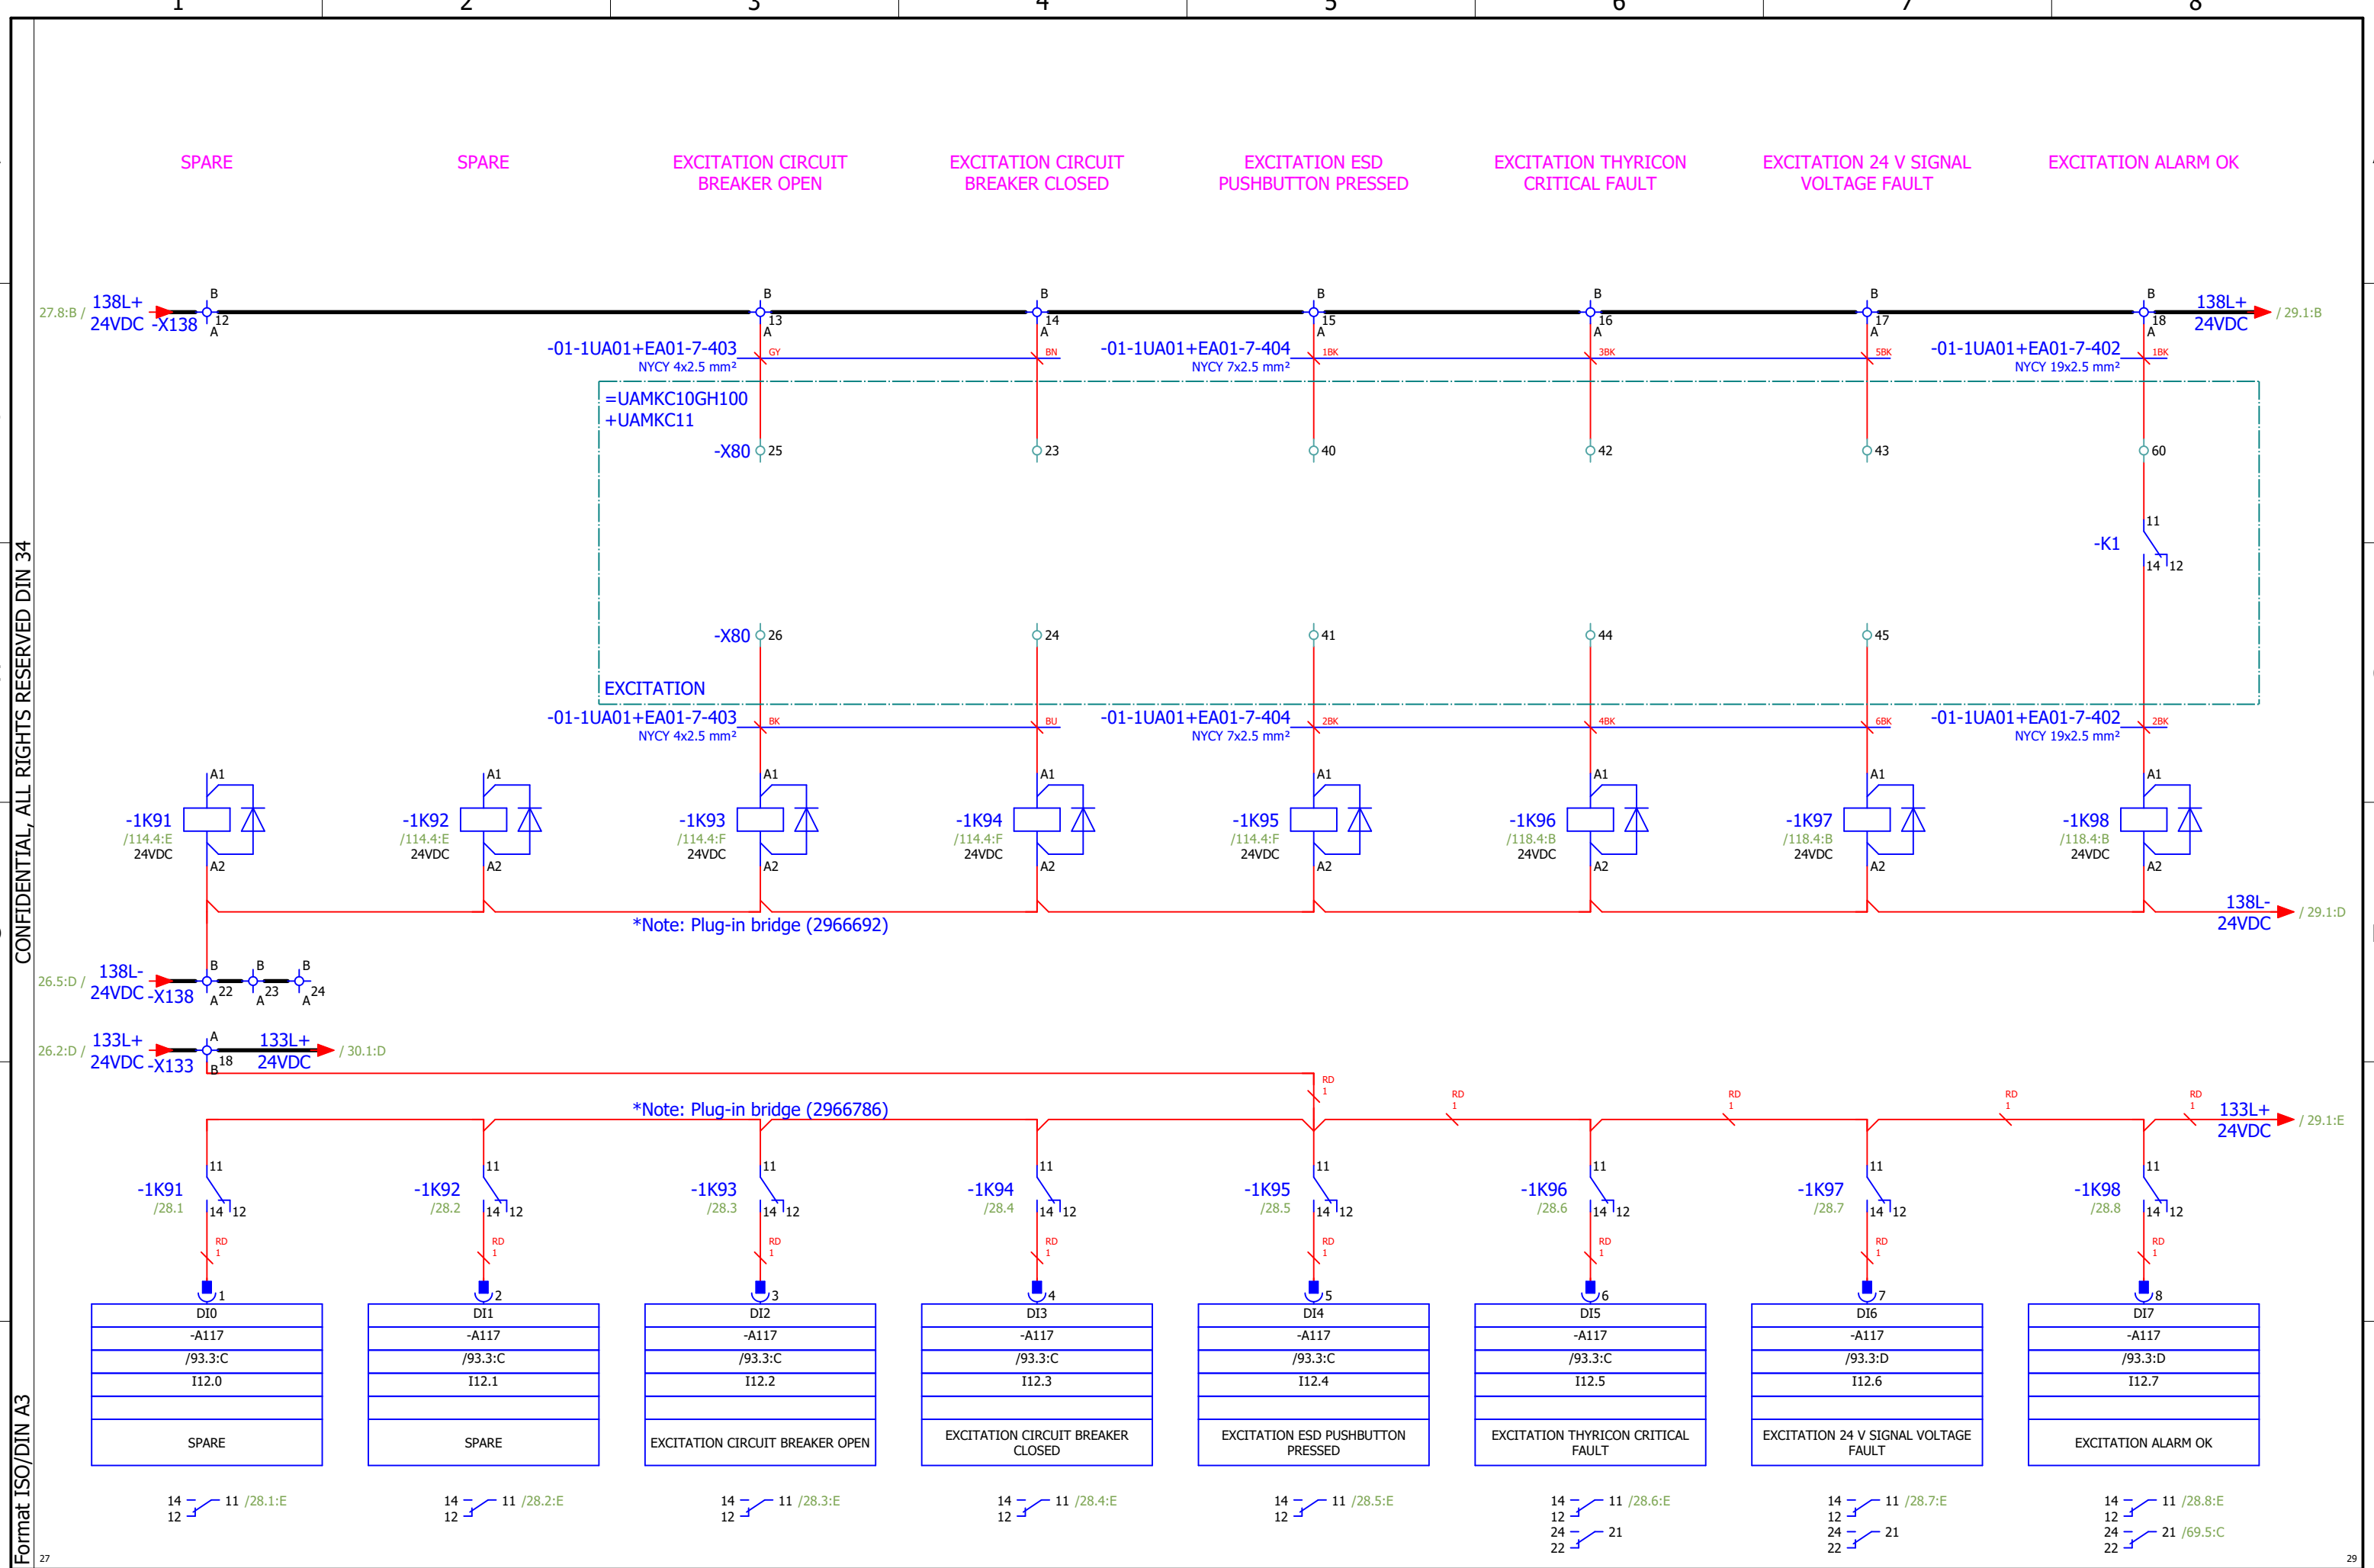


CONFIDENTIAL, ALL RIGHTS RESERVED DIN 34

Format ISO/DIN A3

28

Approved by Contractor			Reconstruction and Modernisation of HPP Perucica - Phase II		 A Voith Company Sintaksa - A Voith Company Ulica Domovinskog rata 104C, 21 000 Split, Hrvatska	Unit KA1 control cubicle circuit diagrams DIGITAL INPUTS: 13.0 - 13.7	DRAWING No.: PERU-01-19-170-31-001	REV No.: 02	= UACJA10GH100
Approved by Designer	Grga Kolić	01.10.2026.					Designer No.:	SALES No.:	+ UACJA10
Checked by	Antonio Aleksić	01.10.2026.							PAGE 29
Drawn by	Tamara Trogrlić	01.10.2026.							PAGE 29 / 156

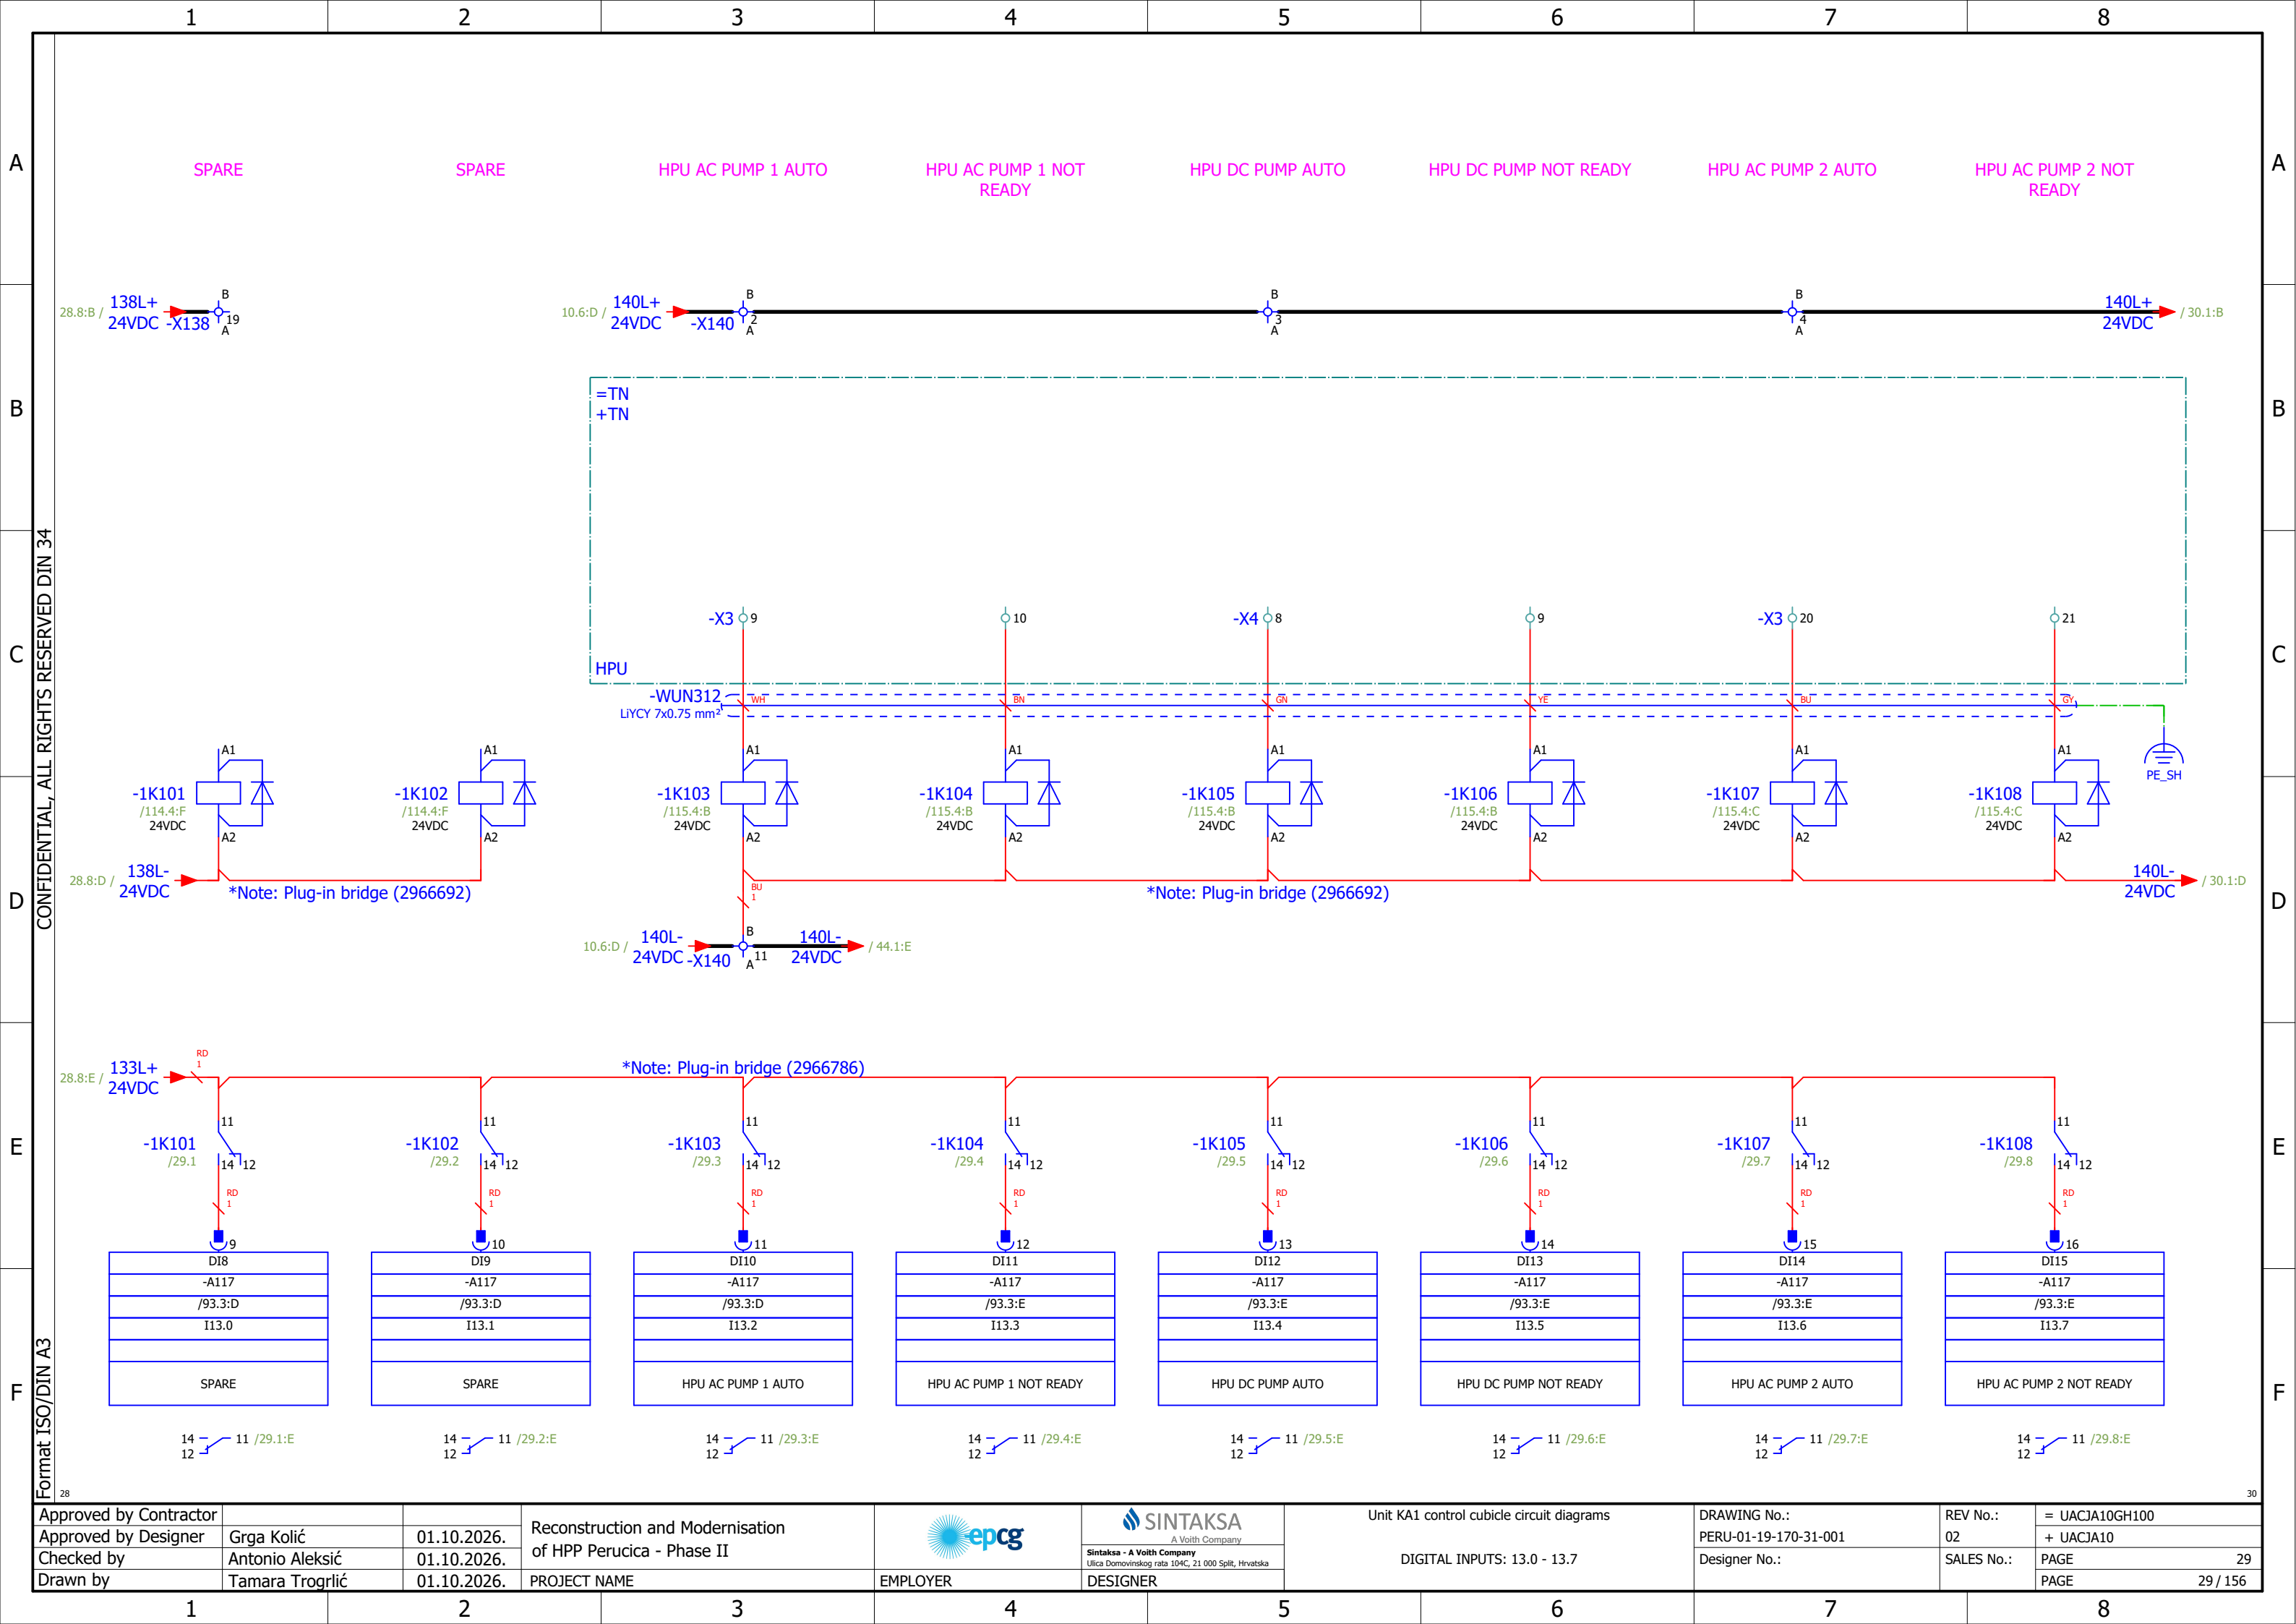

A

1

B

1

C

1

D

1

E


1

F

1

CONFIDENTIAL, ALL RIGHTS RESERVED DIN 34

Format ISO/DIN A3

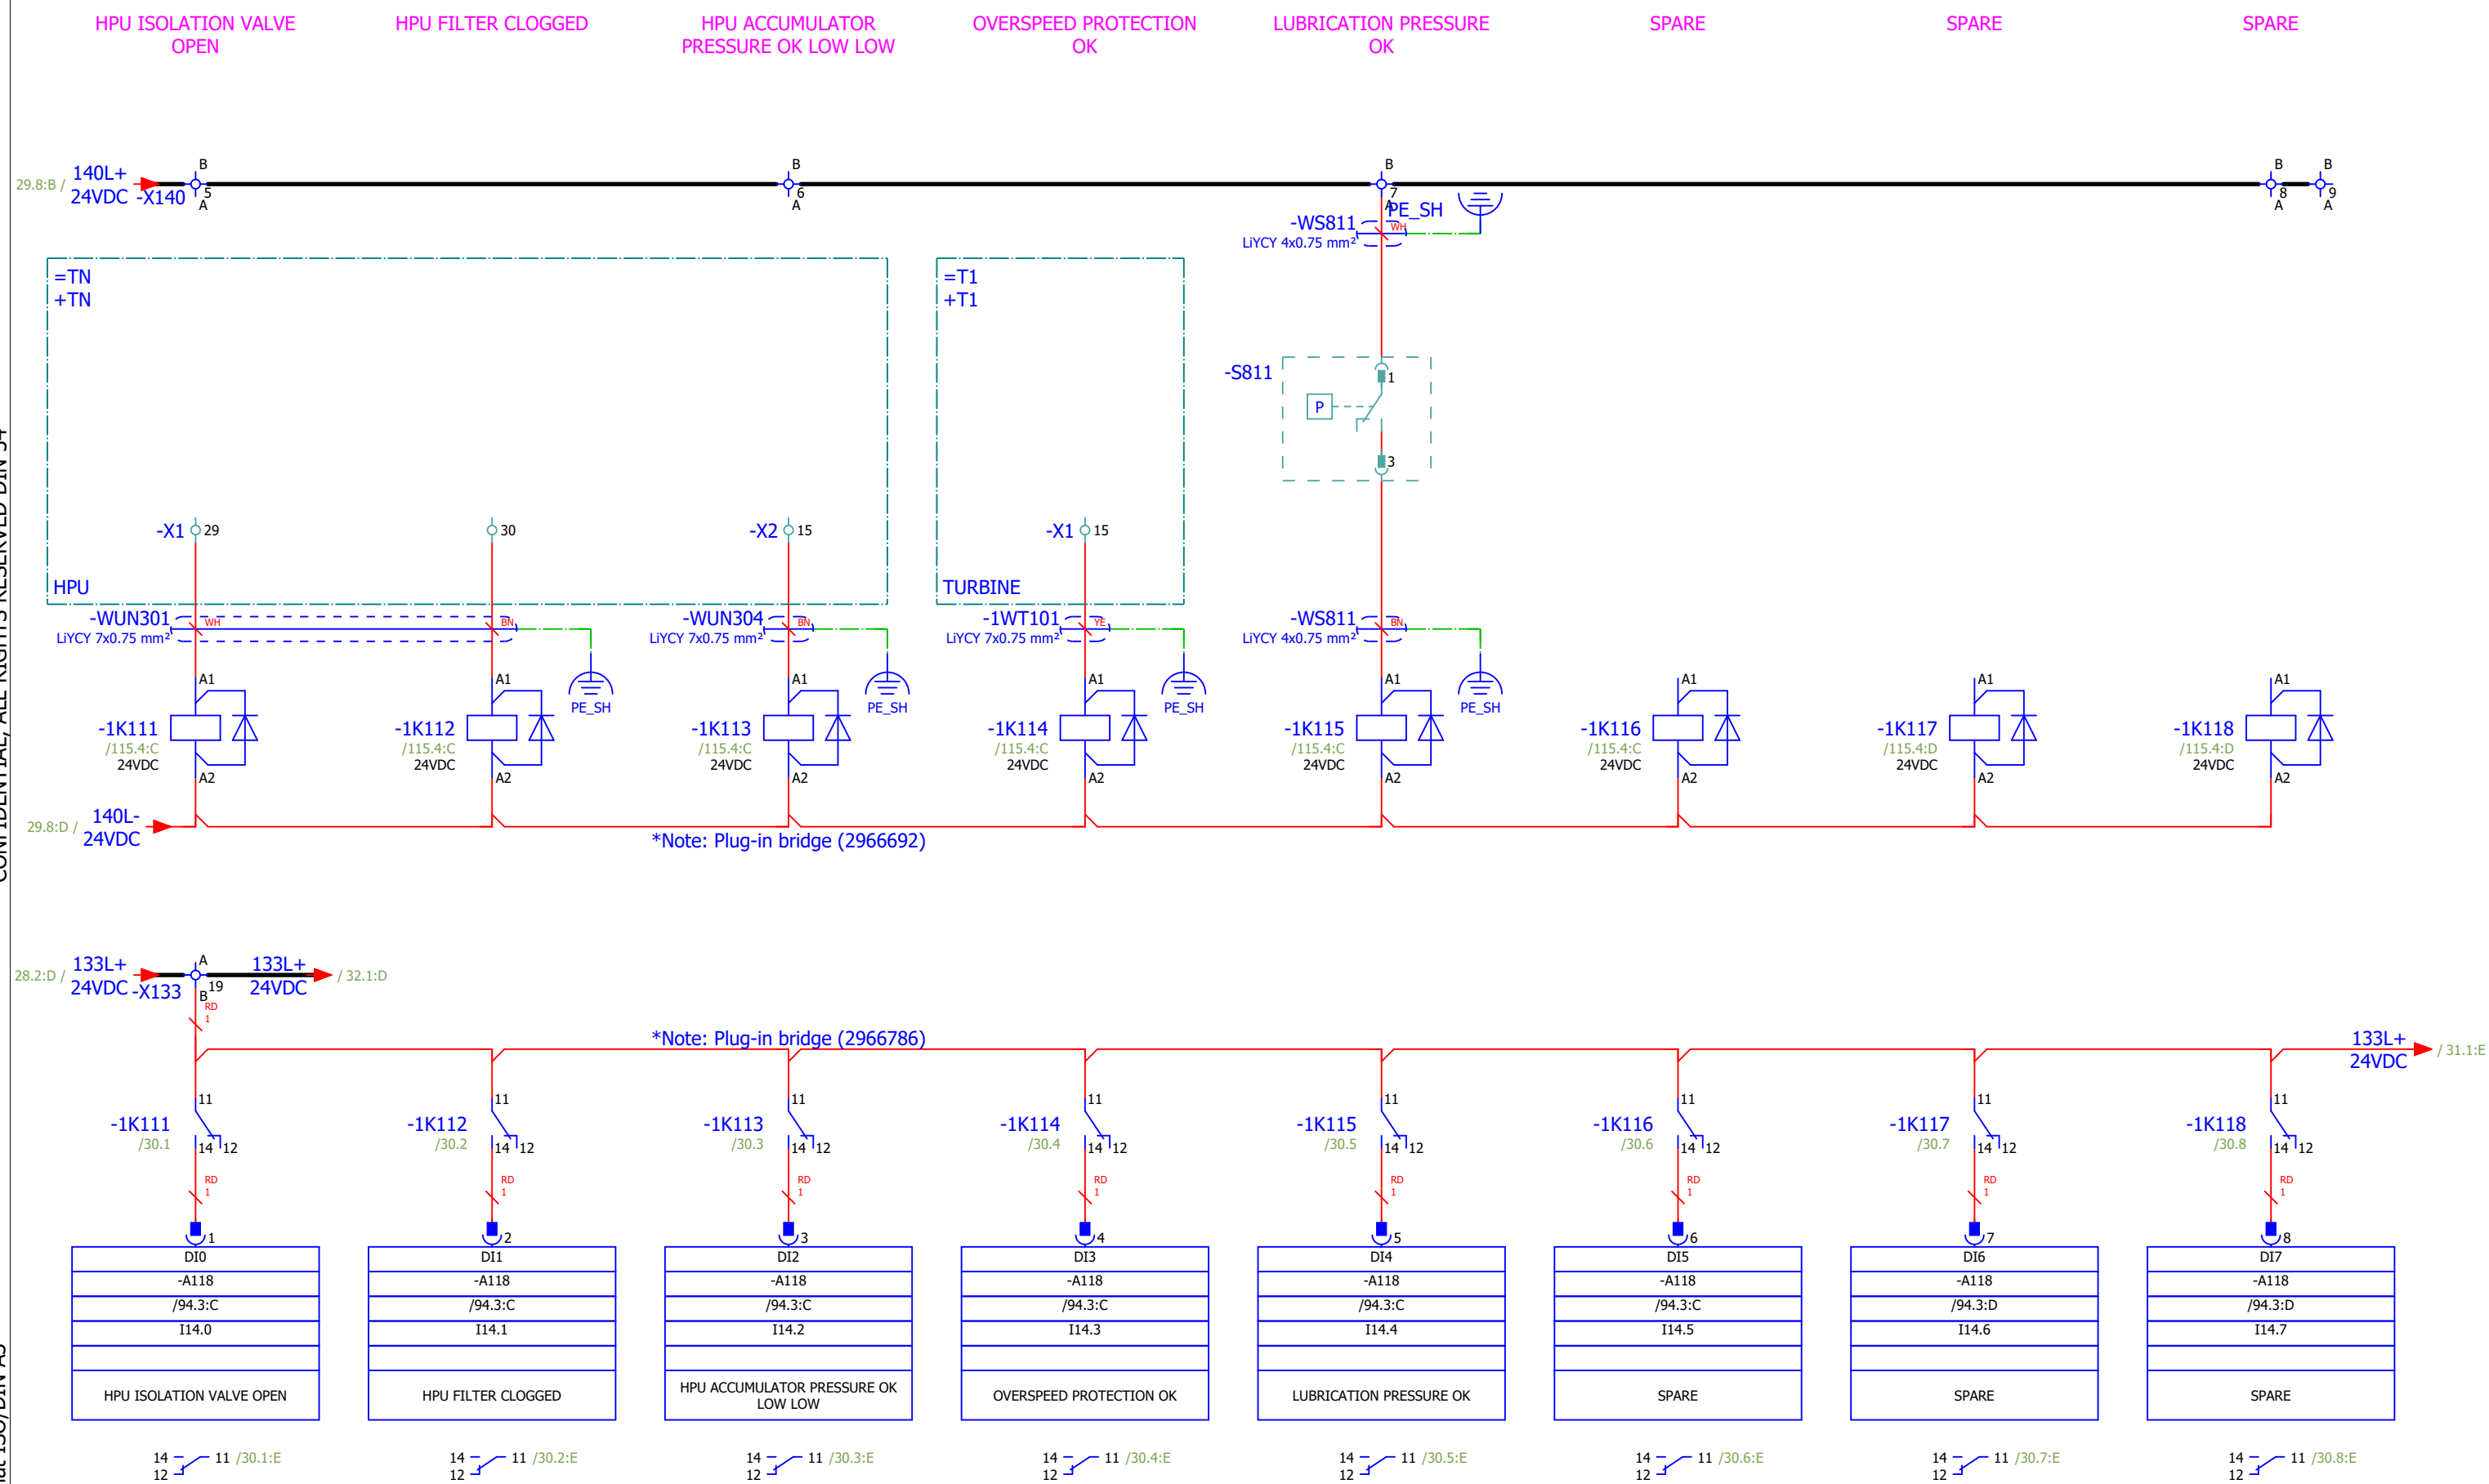

Approved by Contractor			Reconstruction and Modernisation of HPP Perucica - Phase II		 A Voith Company	Unit KA1 control cubicle circuit diagrams	DRAWING No.: PERU-01-19-170-31-001	REV No.: 02	= UACJA10GH100 + UACJA10
Approved by Designer	Grga Kolić	01.10.2026.							
Checked by	Antonio Aleksić	01.10.2026.							
Drawn by	Tamara Trogrlić	01.10.2026.	PROJECT NAME	EMPLOYER	DESIGNER	DIGITAL INPUTS: 14.0 - 14.7	Designer No.:	SALES No.:	PAGE 30 / 156


CONFIDENTIAL, ALL RIGHTS RESERVED DIN 34

Format ISO/DIN A3

30

32

Approved by Contractor			Reconstruction and Modernisation of HPP Perucica - Phase II		 A Voith Company Sintaksa - A Voith Company Ulica Domovinskog rata 104C, 21 000 Split, Hrvatska	Unit KA1 control cubicle circuit diagrams DIGITAL INPUTS: 15.0 - 15.7	DRAWING No.: PERU-01-19-170-31-001	REV No.: 02	= UACJA10GH100
Approved by Designer	Grga Kolić	01.10.2026.					Designer No.:	SALES No.:	+ UACJA10
Checked by	Antonio Aleksić	01.10.2026.							PAGE 31
Drawn by	Tamara Trogrlić	01.10.2026.							PAGE 31 / 156

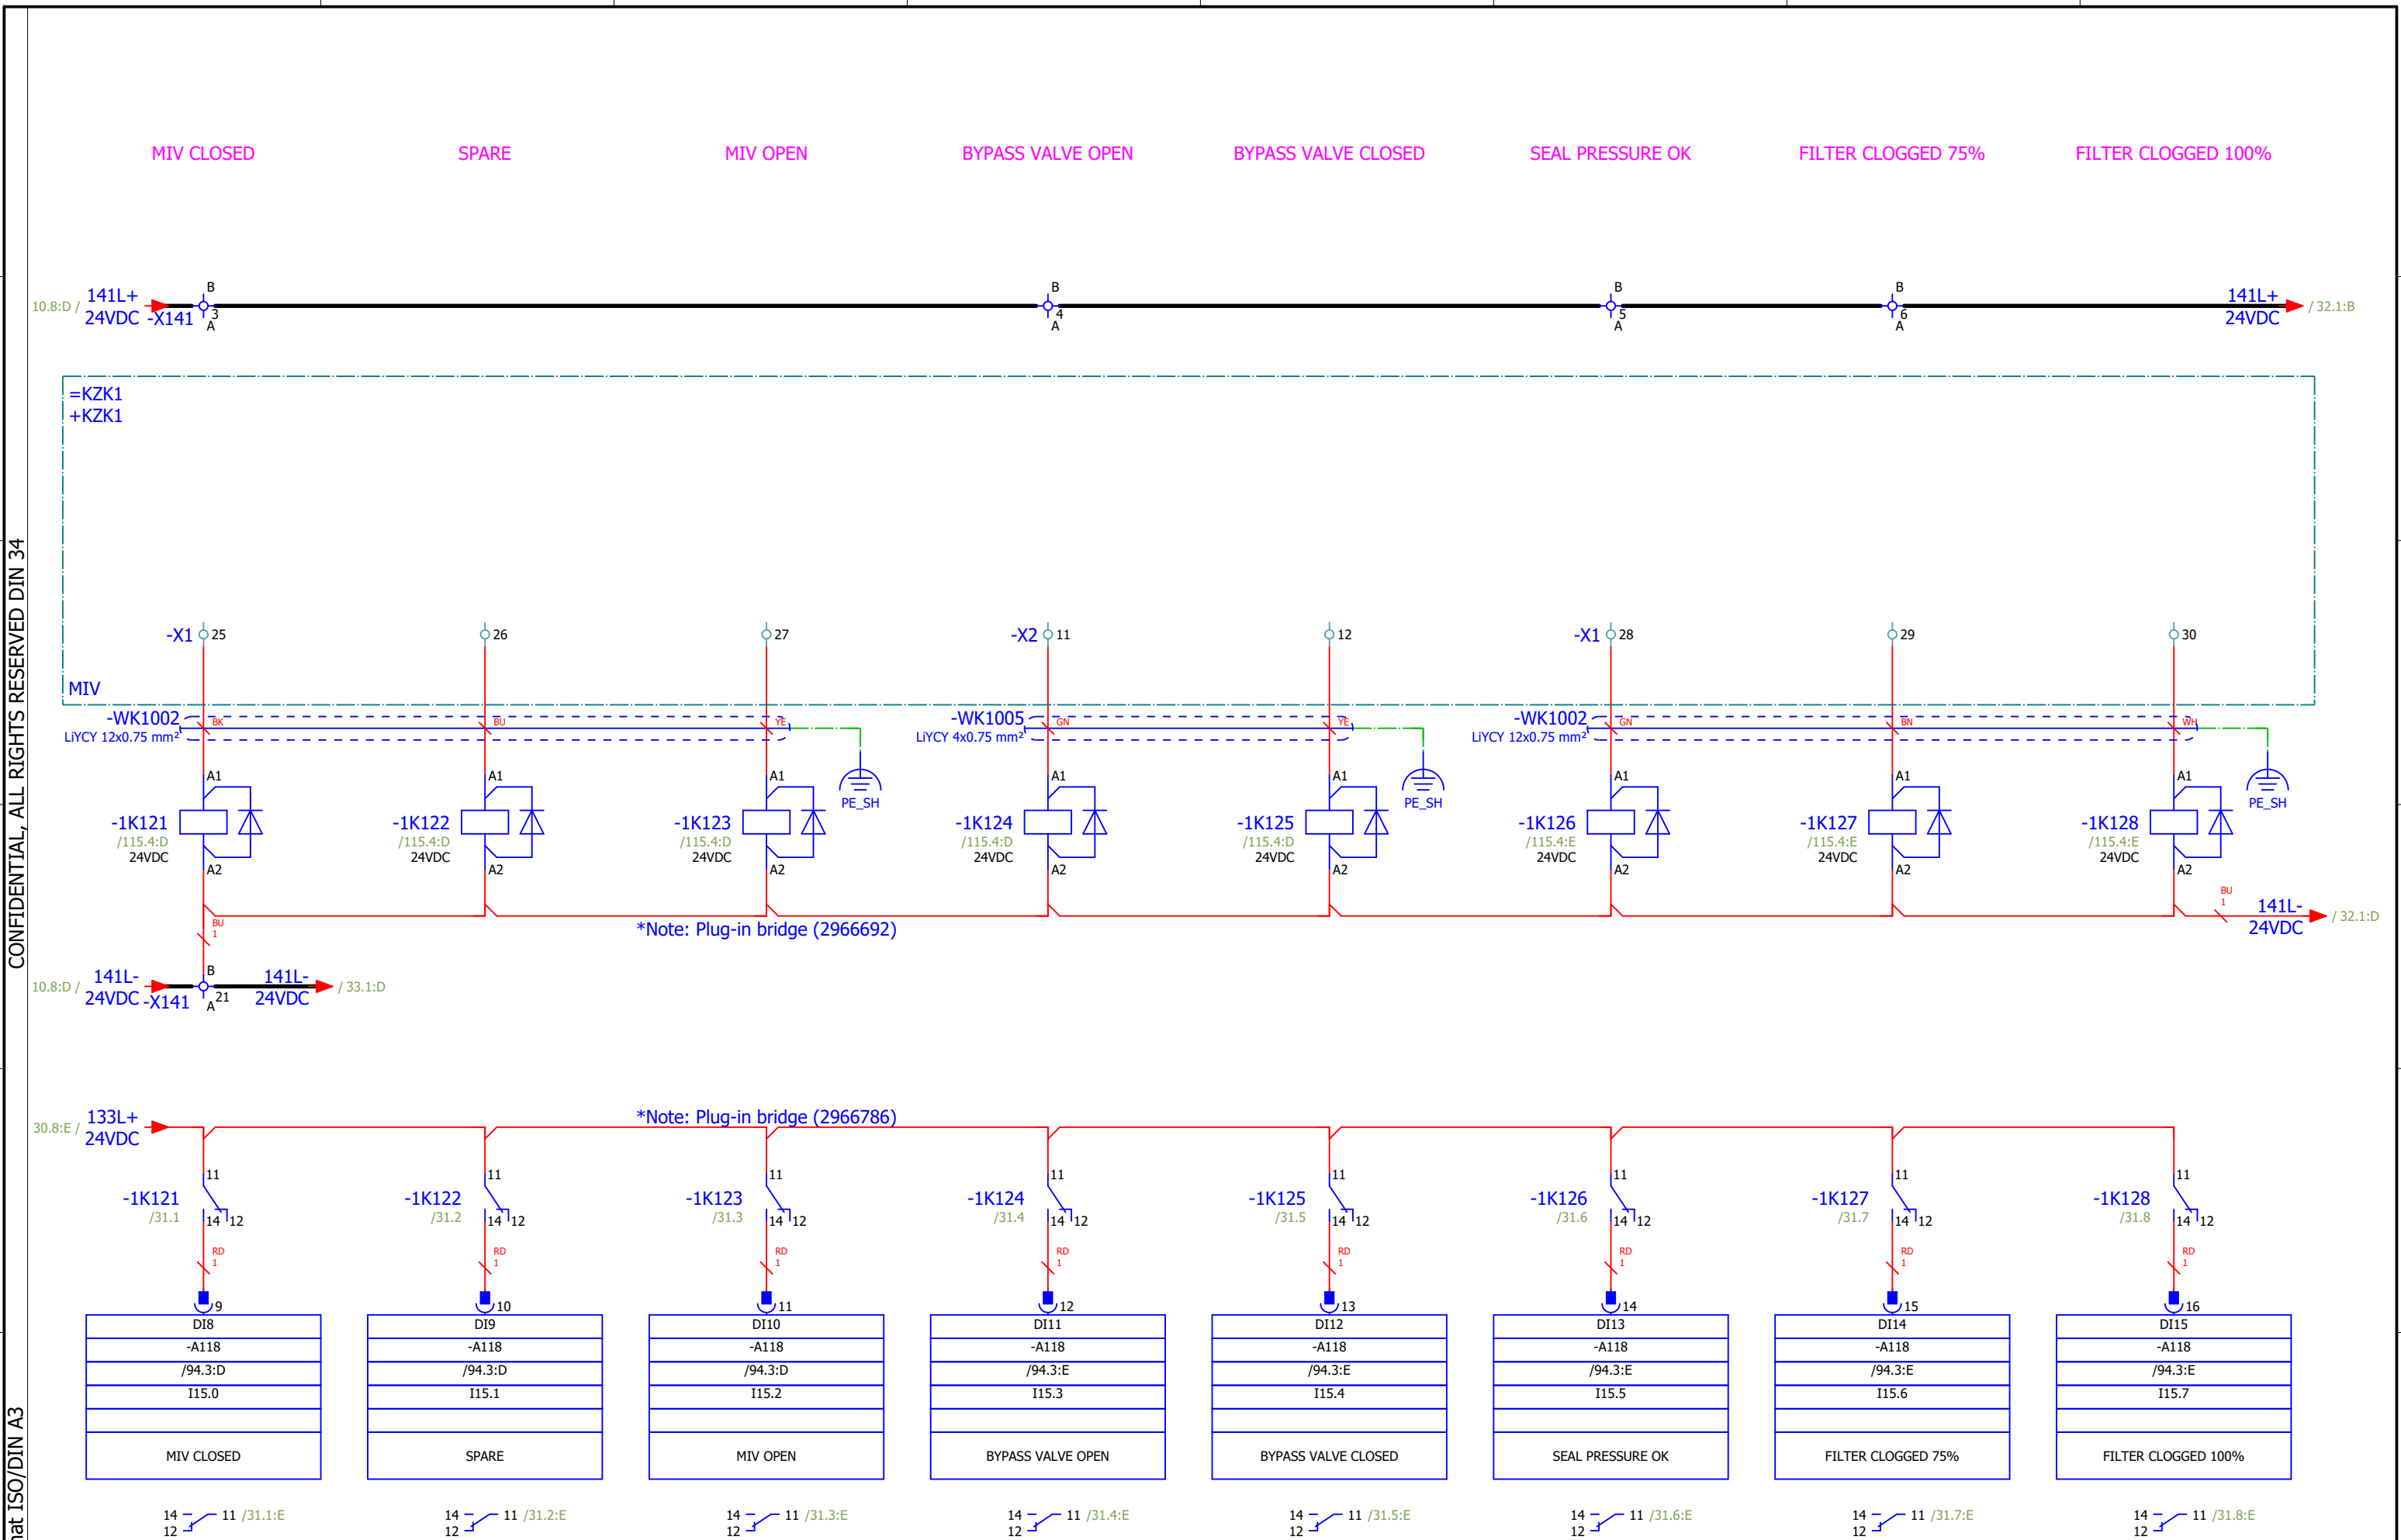


CONFIDENTIAL, ALL RIGHTS RESERVED DIN 34

Format ISO/DIN A3

31

33

Approved by Contractor			Reconstruction and Modernisation of HPP Perucica - Phase II		 A Voith Company Sintaksa - A Voith Company Ulica Domovinskog rata 104C, 21 000 Split, Hrvatska	Unit KA1 control cubicle circuit diagrams DIGITAL INPUTS: 16.0 - 16.7	DRAWING No.: PERU-01-19-170-31-001	REV No.: 02	= UACJA10GH100
Approved by Designer	Grga Kolić	01.10.2026.					Designer No.:	SALES No.:	+ UACJA10
Checked by	Antonio Aleksić	01.10.2026.							PAGE 32
Drawn by	Tamara Trogrlić	01.10.2026.							PAGE 32 / 156

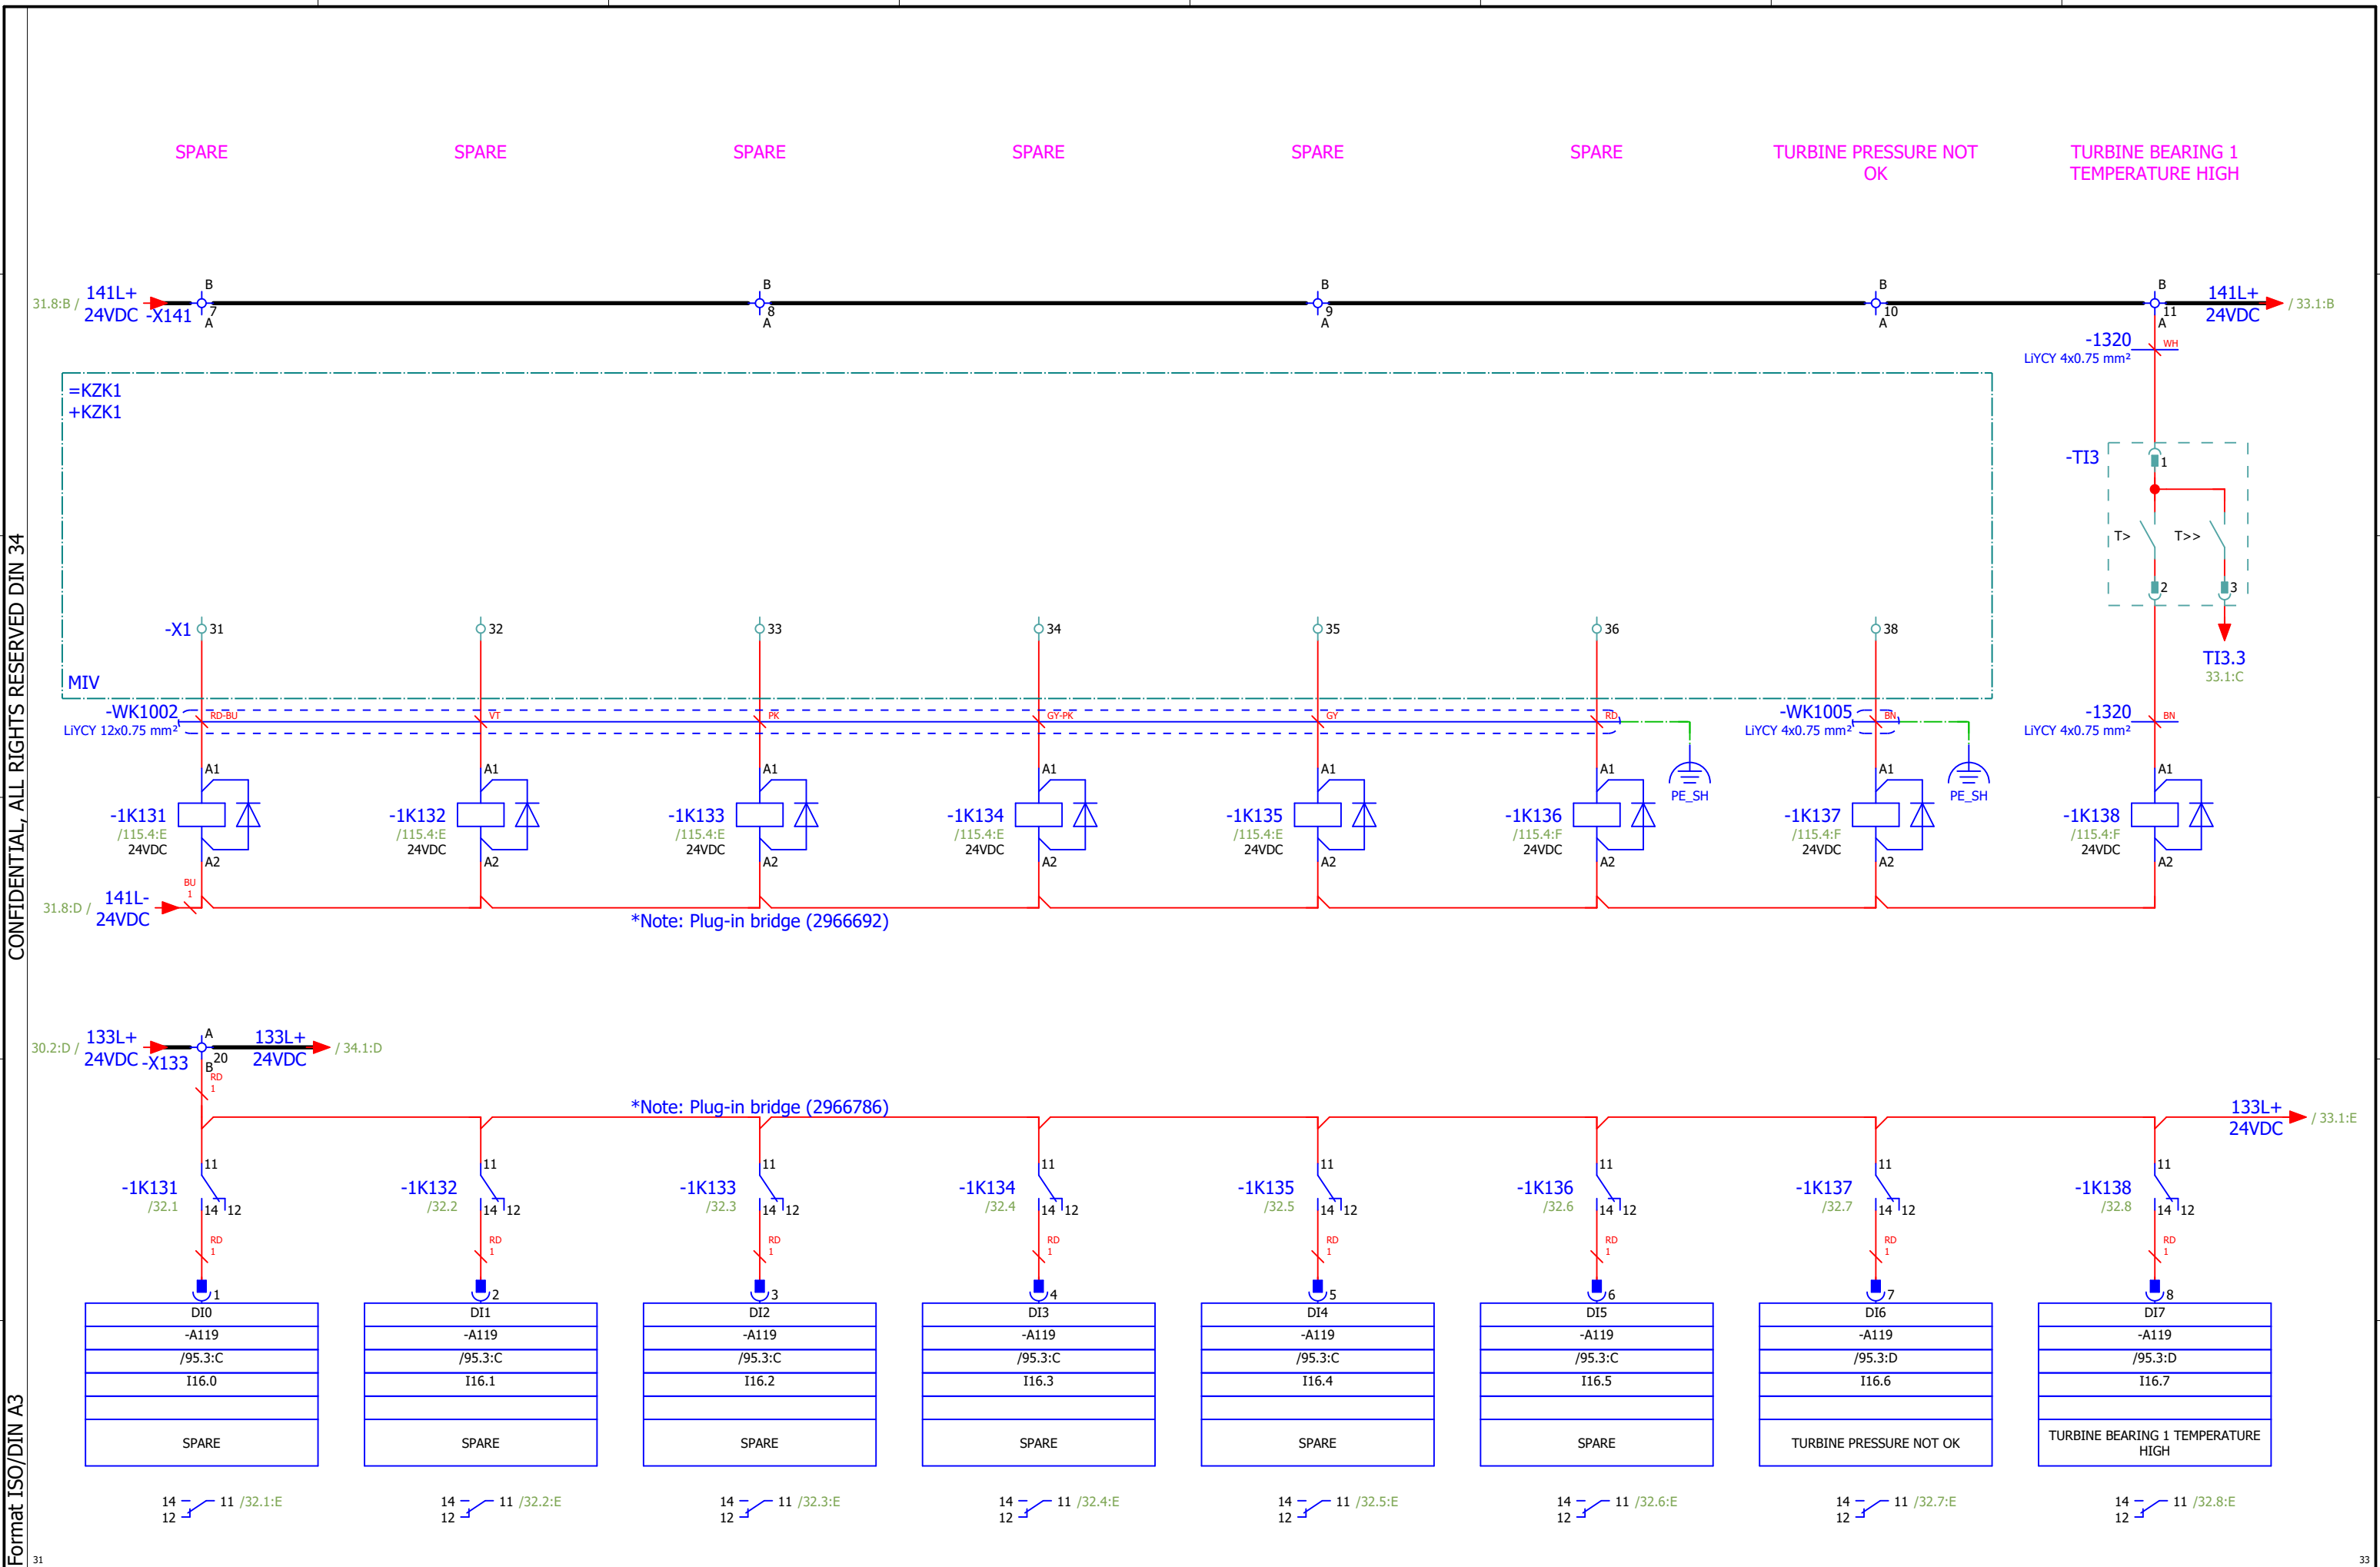


CONFIDENTIAL, ALL RIGHTS RESERVED DIN 34

Format ISO/DIN A3

32


34

Approved by Contractor			Reconstruction and Modernisation of HPP Perucica - Phase II		 A Voith Company Sintaksa - A Voith Company Ulica Domovinskog rata 104C, 21 000 Split, Hrvatska	Unit KA1 control cubicle circuit diagrams DIGITAL INPUTS: 17.0 - 17.7	DRAWING No.: PERU-01-19-170-31-001	REV No.: 02	= UACJA10GH100
Approved by Designer	Grga Kolić	01.10.2026.					Designer No.:	SALES No.:	+ UACJA10
Checked by	Antonio Aleksić	01.10.2026.							PAGE 33
Drawn by	Tamara Trogrlić	01.10.2026.							PAGE 33 / 156

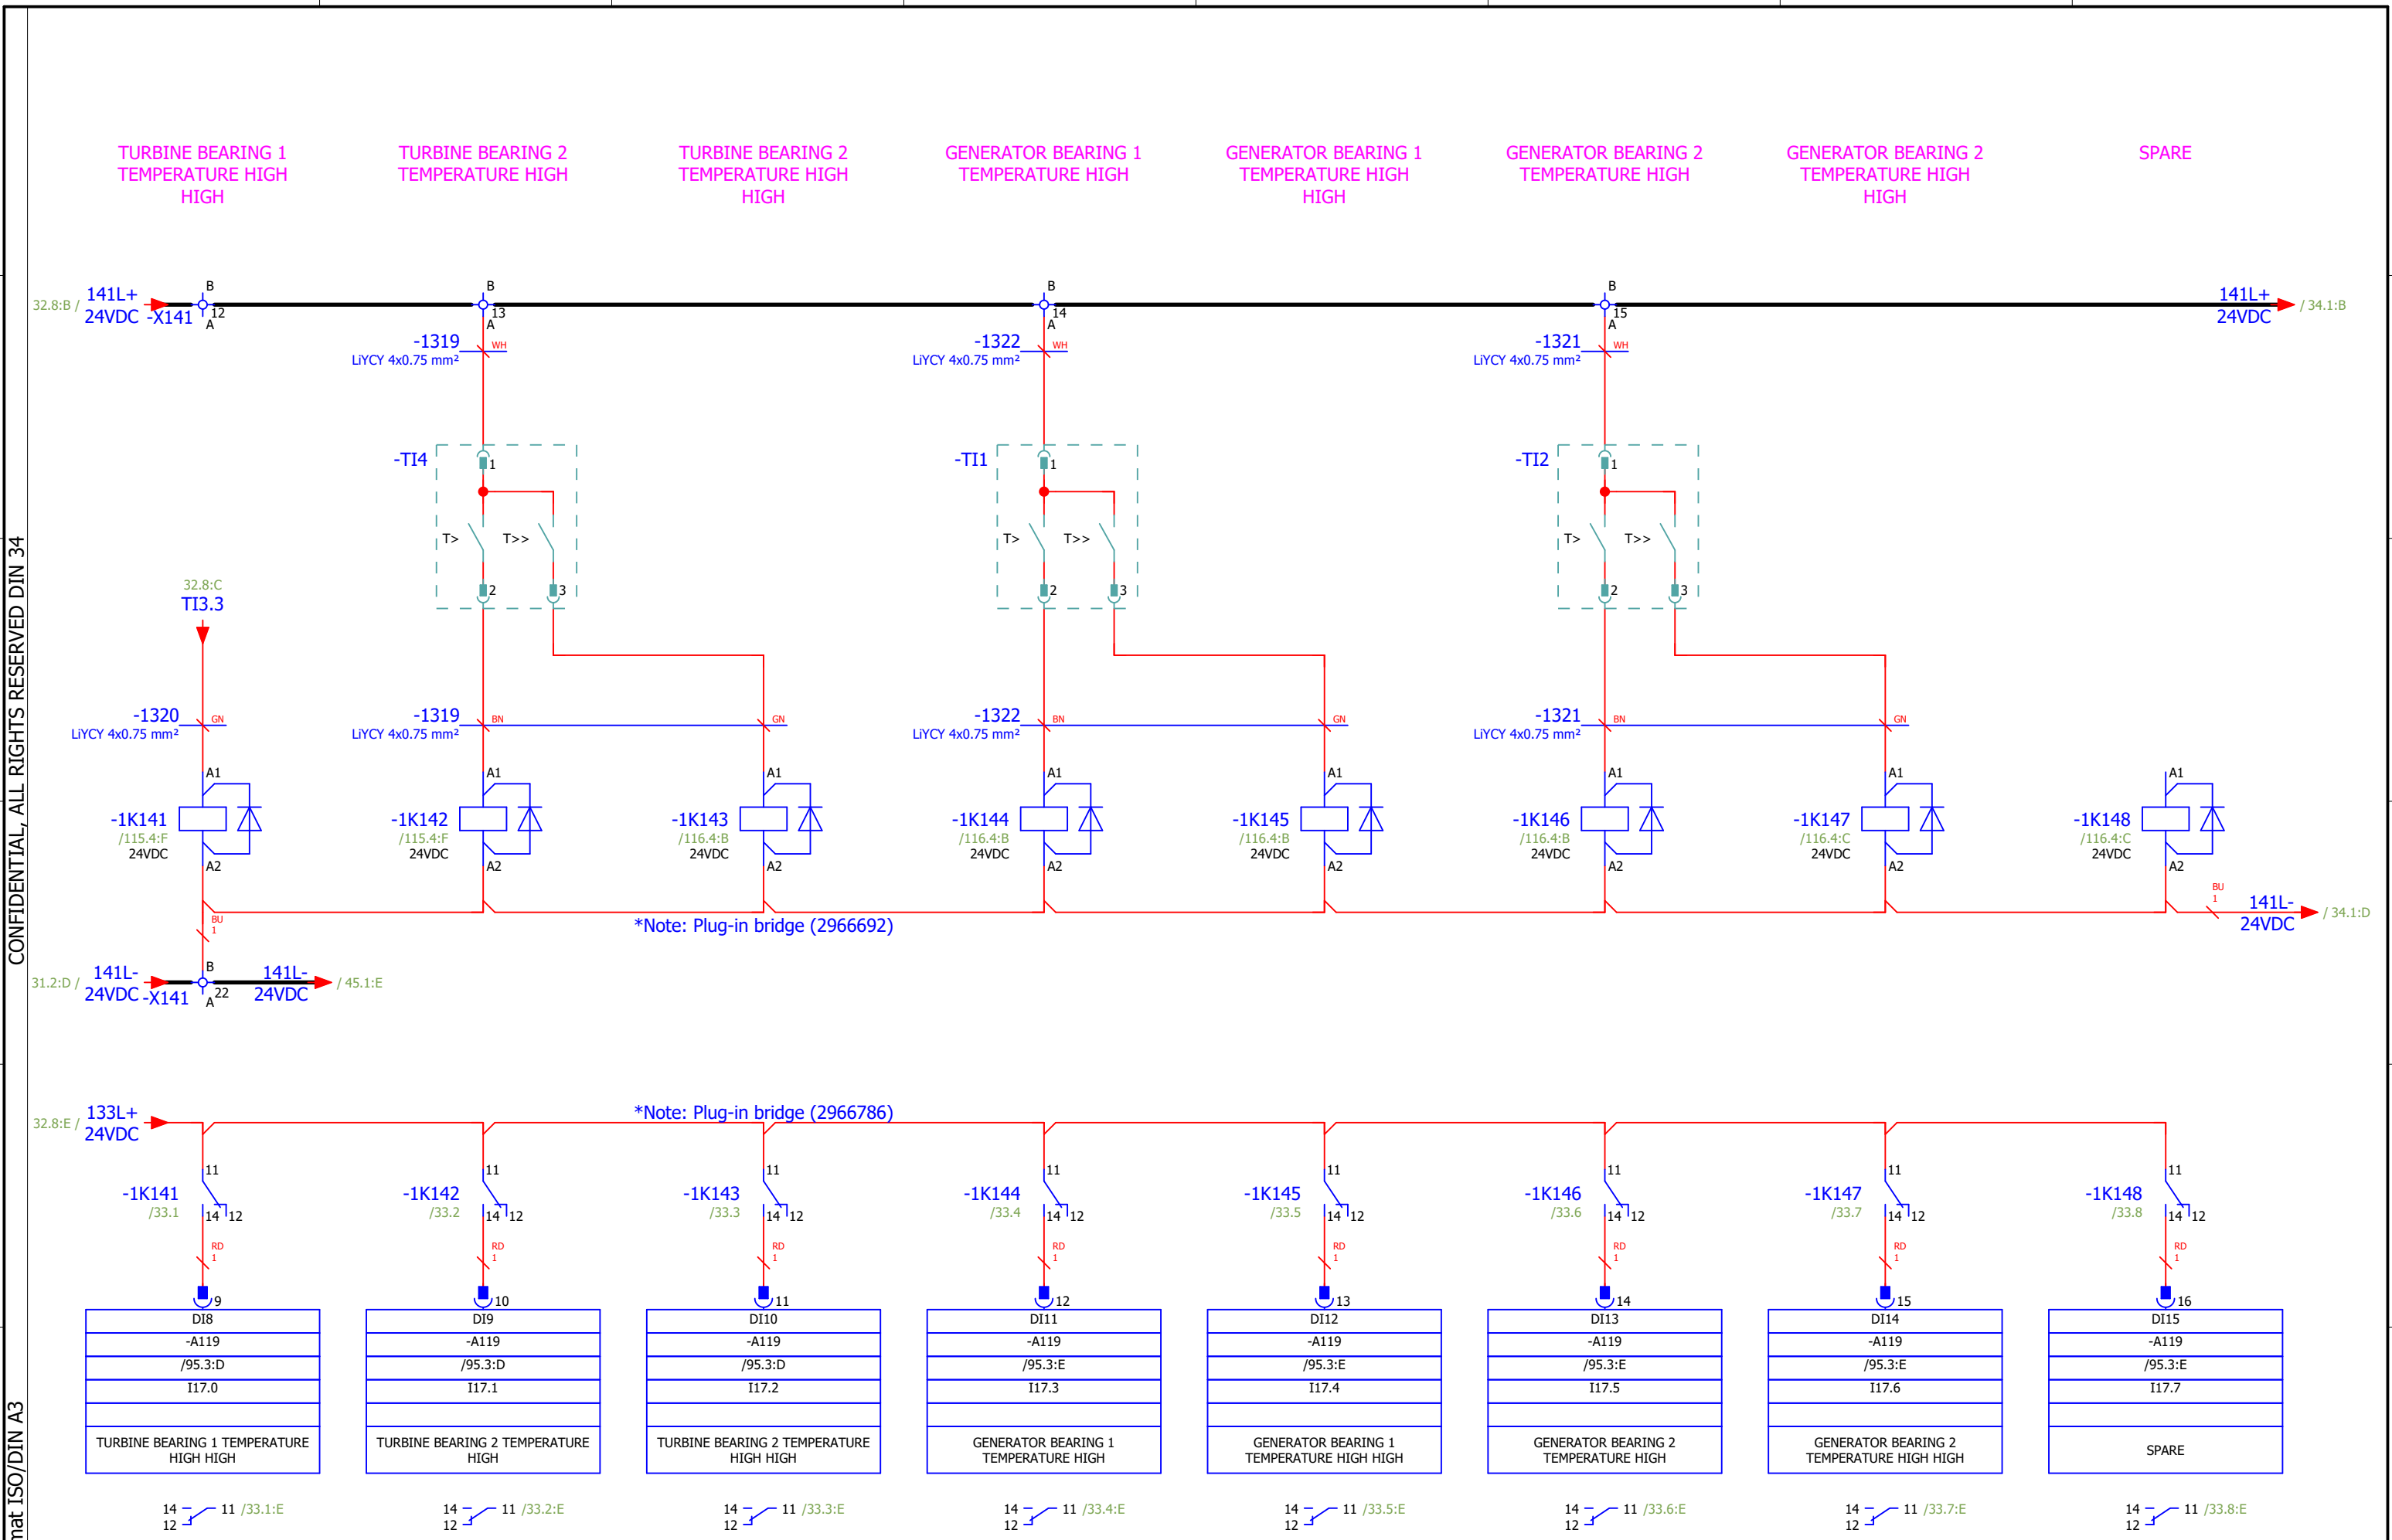

CONFIDENTIAL, ALL RIGHTS RESERVED DIN 34

Format ISO/DIN A3

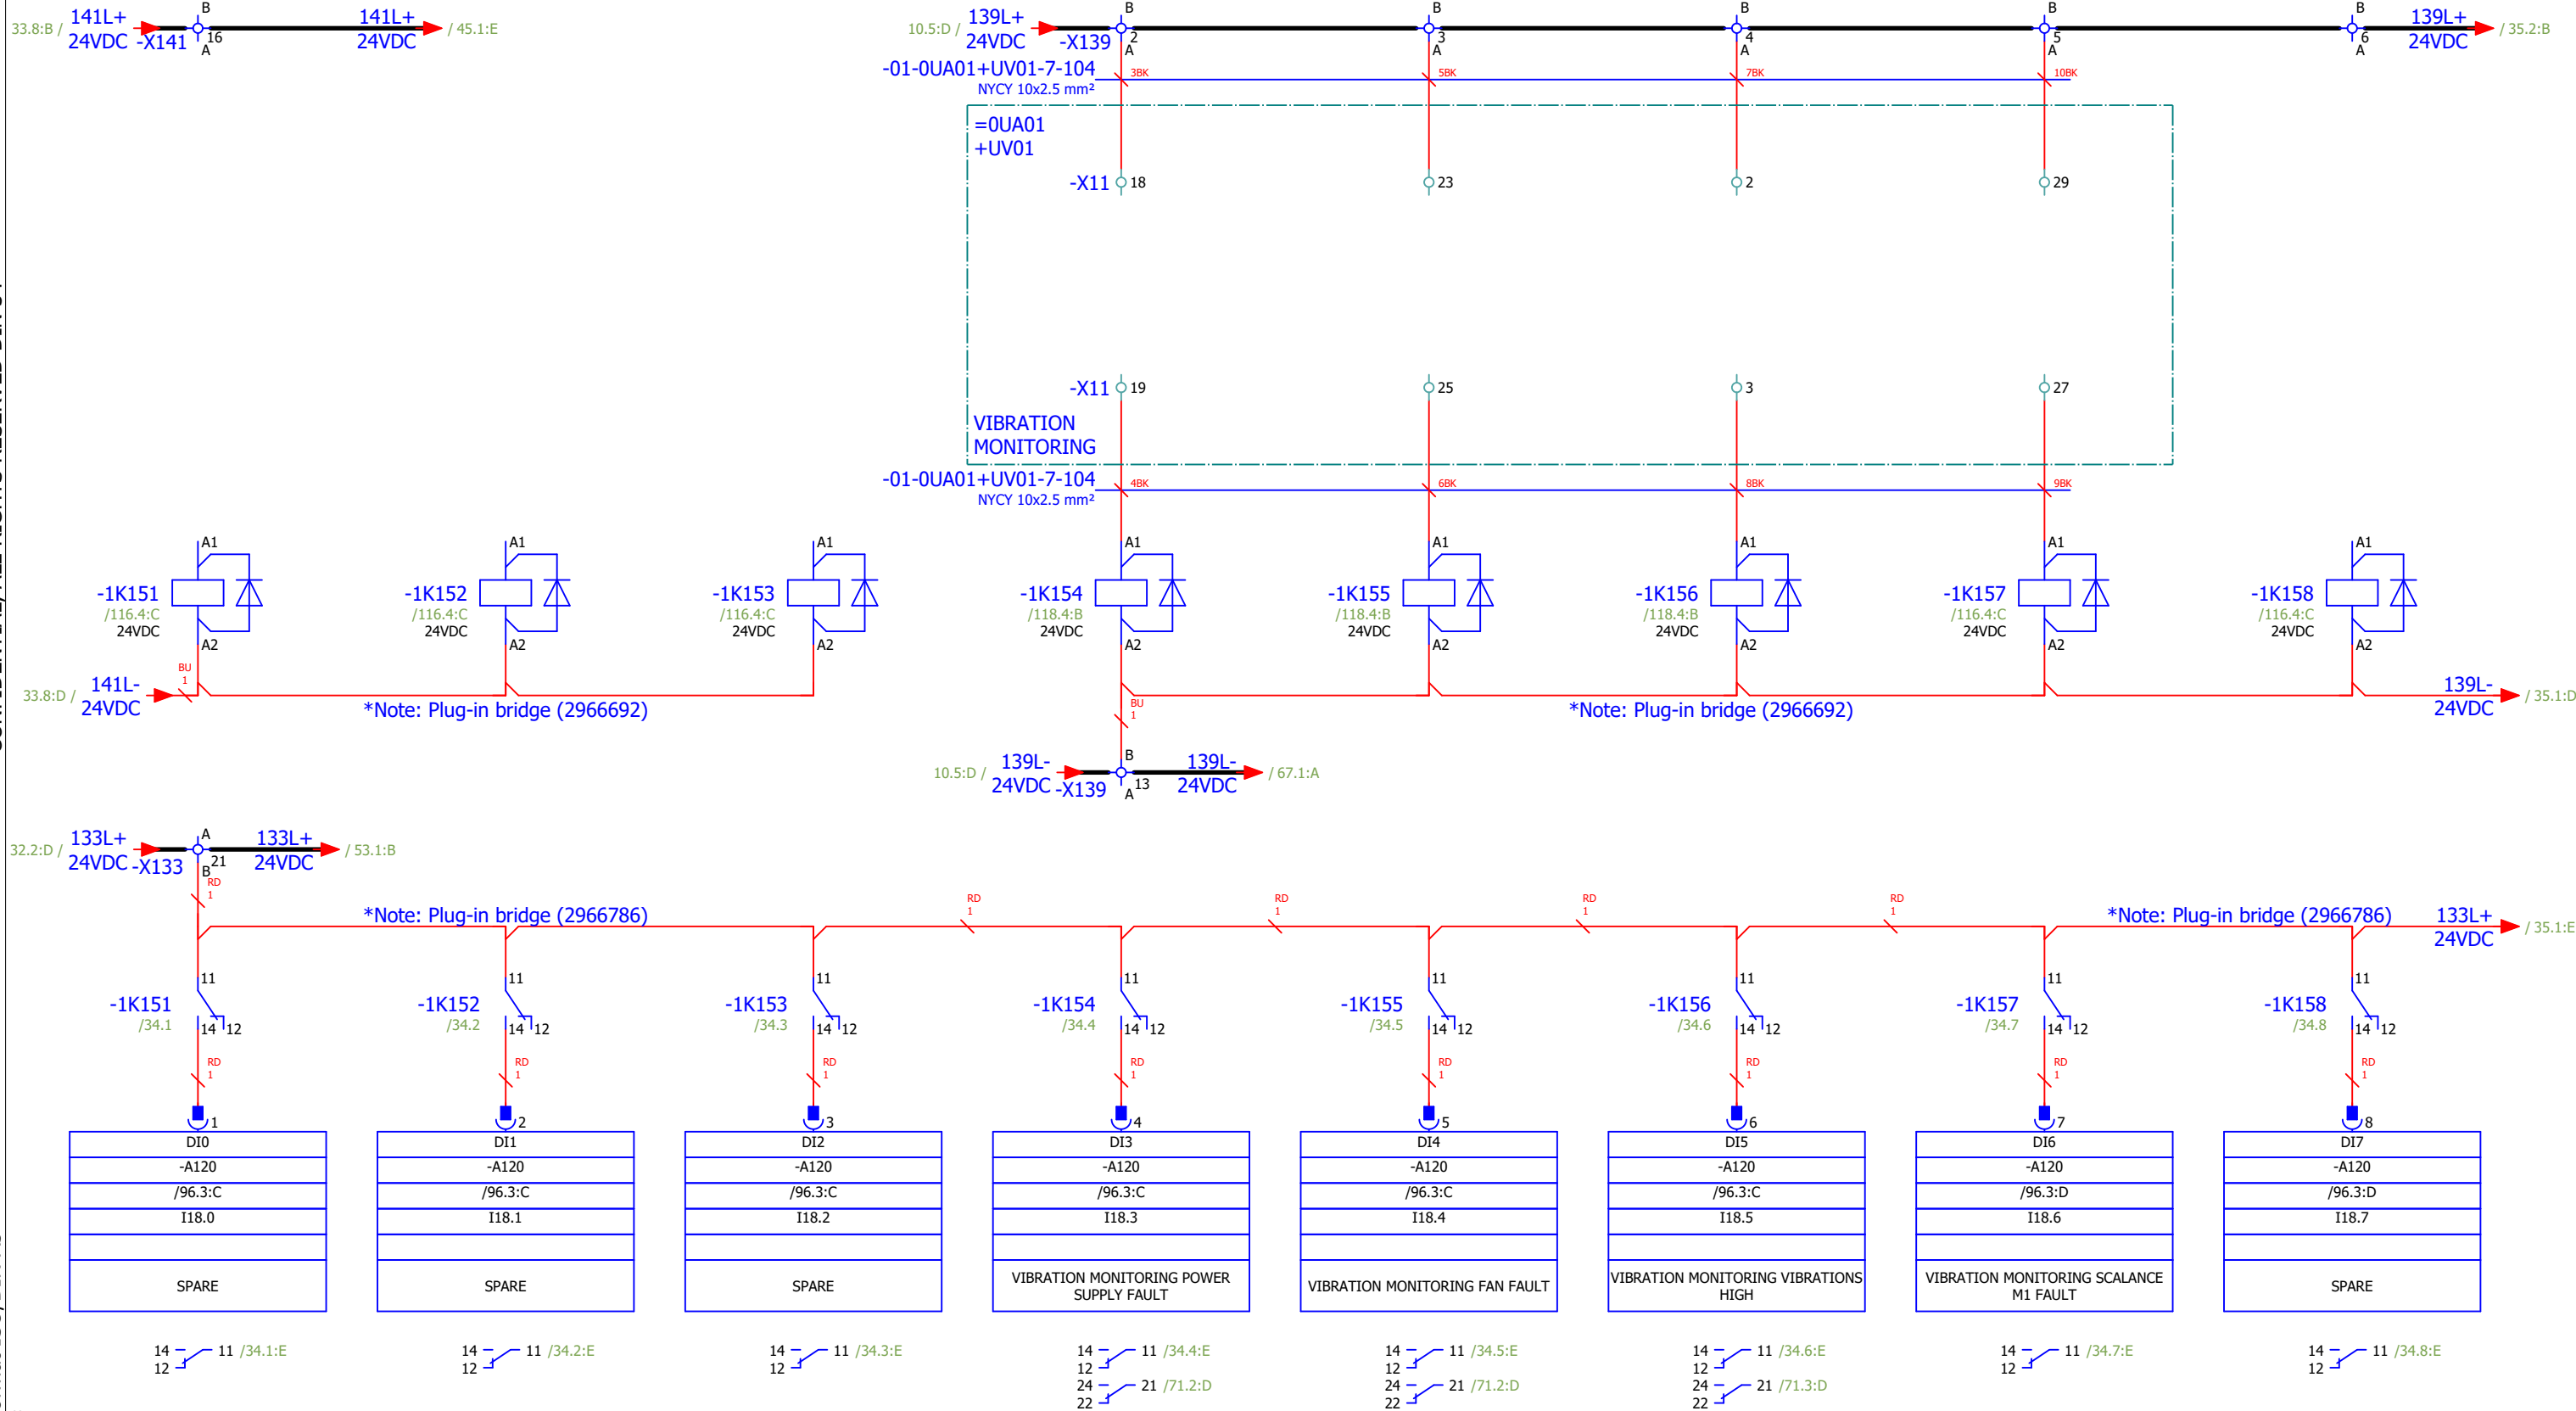

Approved by Contractor			Reconstruction and Modernisation of HPP Perucica - Phase II		SINTAKSA A Voith Company	Unit KA1 control cubicle circuit diagrams	DRAWING No.: PERU-01-19-170-31-001	REV No.: 02	= UACJA10GH100
Approved by Designer	Grga Kolić	01.10.2026.			Sintaksa - A Voith Company Ulica Domovinskog rata 104C, 21 000 Split, Hrvatska	DIGITAL INPUTS: 18.0 - 18.7	Designer No.:	SALES No.:	+ UACJA10
Checked by	Antonio Aleksić	01.10.2026.							PAGE 34
Drawn by	Tamara Trogrlić	01.10.2026.	PROJECT NAME	EMPLOYER	DESIGNER				PAGE 34 / 156

34



1	2	3	4	5	6	7	8
---	---	---	---	---	---	---	---


CONFIDENTIAL, ALL RIGHTS RESERVED DIN 34

Format ISO/DIN A3

35

37

Approved by Contractor			Reconstruction and Modernisation of HPP Perucica - Phase II		 A Voith Company Sintaksa - A Voith Company Ulica Domovinskog rata 104C, 21 000 Split, Hrvatska	Unit KA1 control cubicle circuit diagrams DIGITAL OUTPUTS: 0.0 - 0.7	DRAWING No.: PERU-01-19-170-31-001	REV No.: 02	= UACJA10GH100 + UACJA10
Approved by Designer	Grga Kolić	01.10.2026.					Designer No.:	SALES No.:	PAGE 36
Checked by	Antonio Aleksić	01.10.2026.	PROJECT NAME	EMPLOYER	DESIGNER				PAGE 36 / 156
Drawn by	Tamara Trogrlić	01.10.2026.							

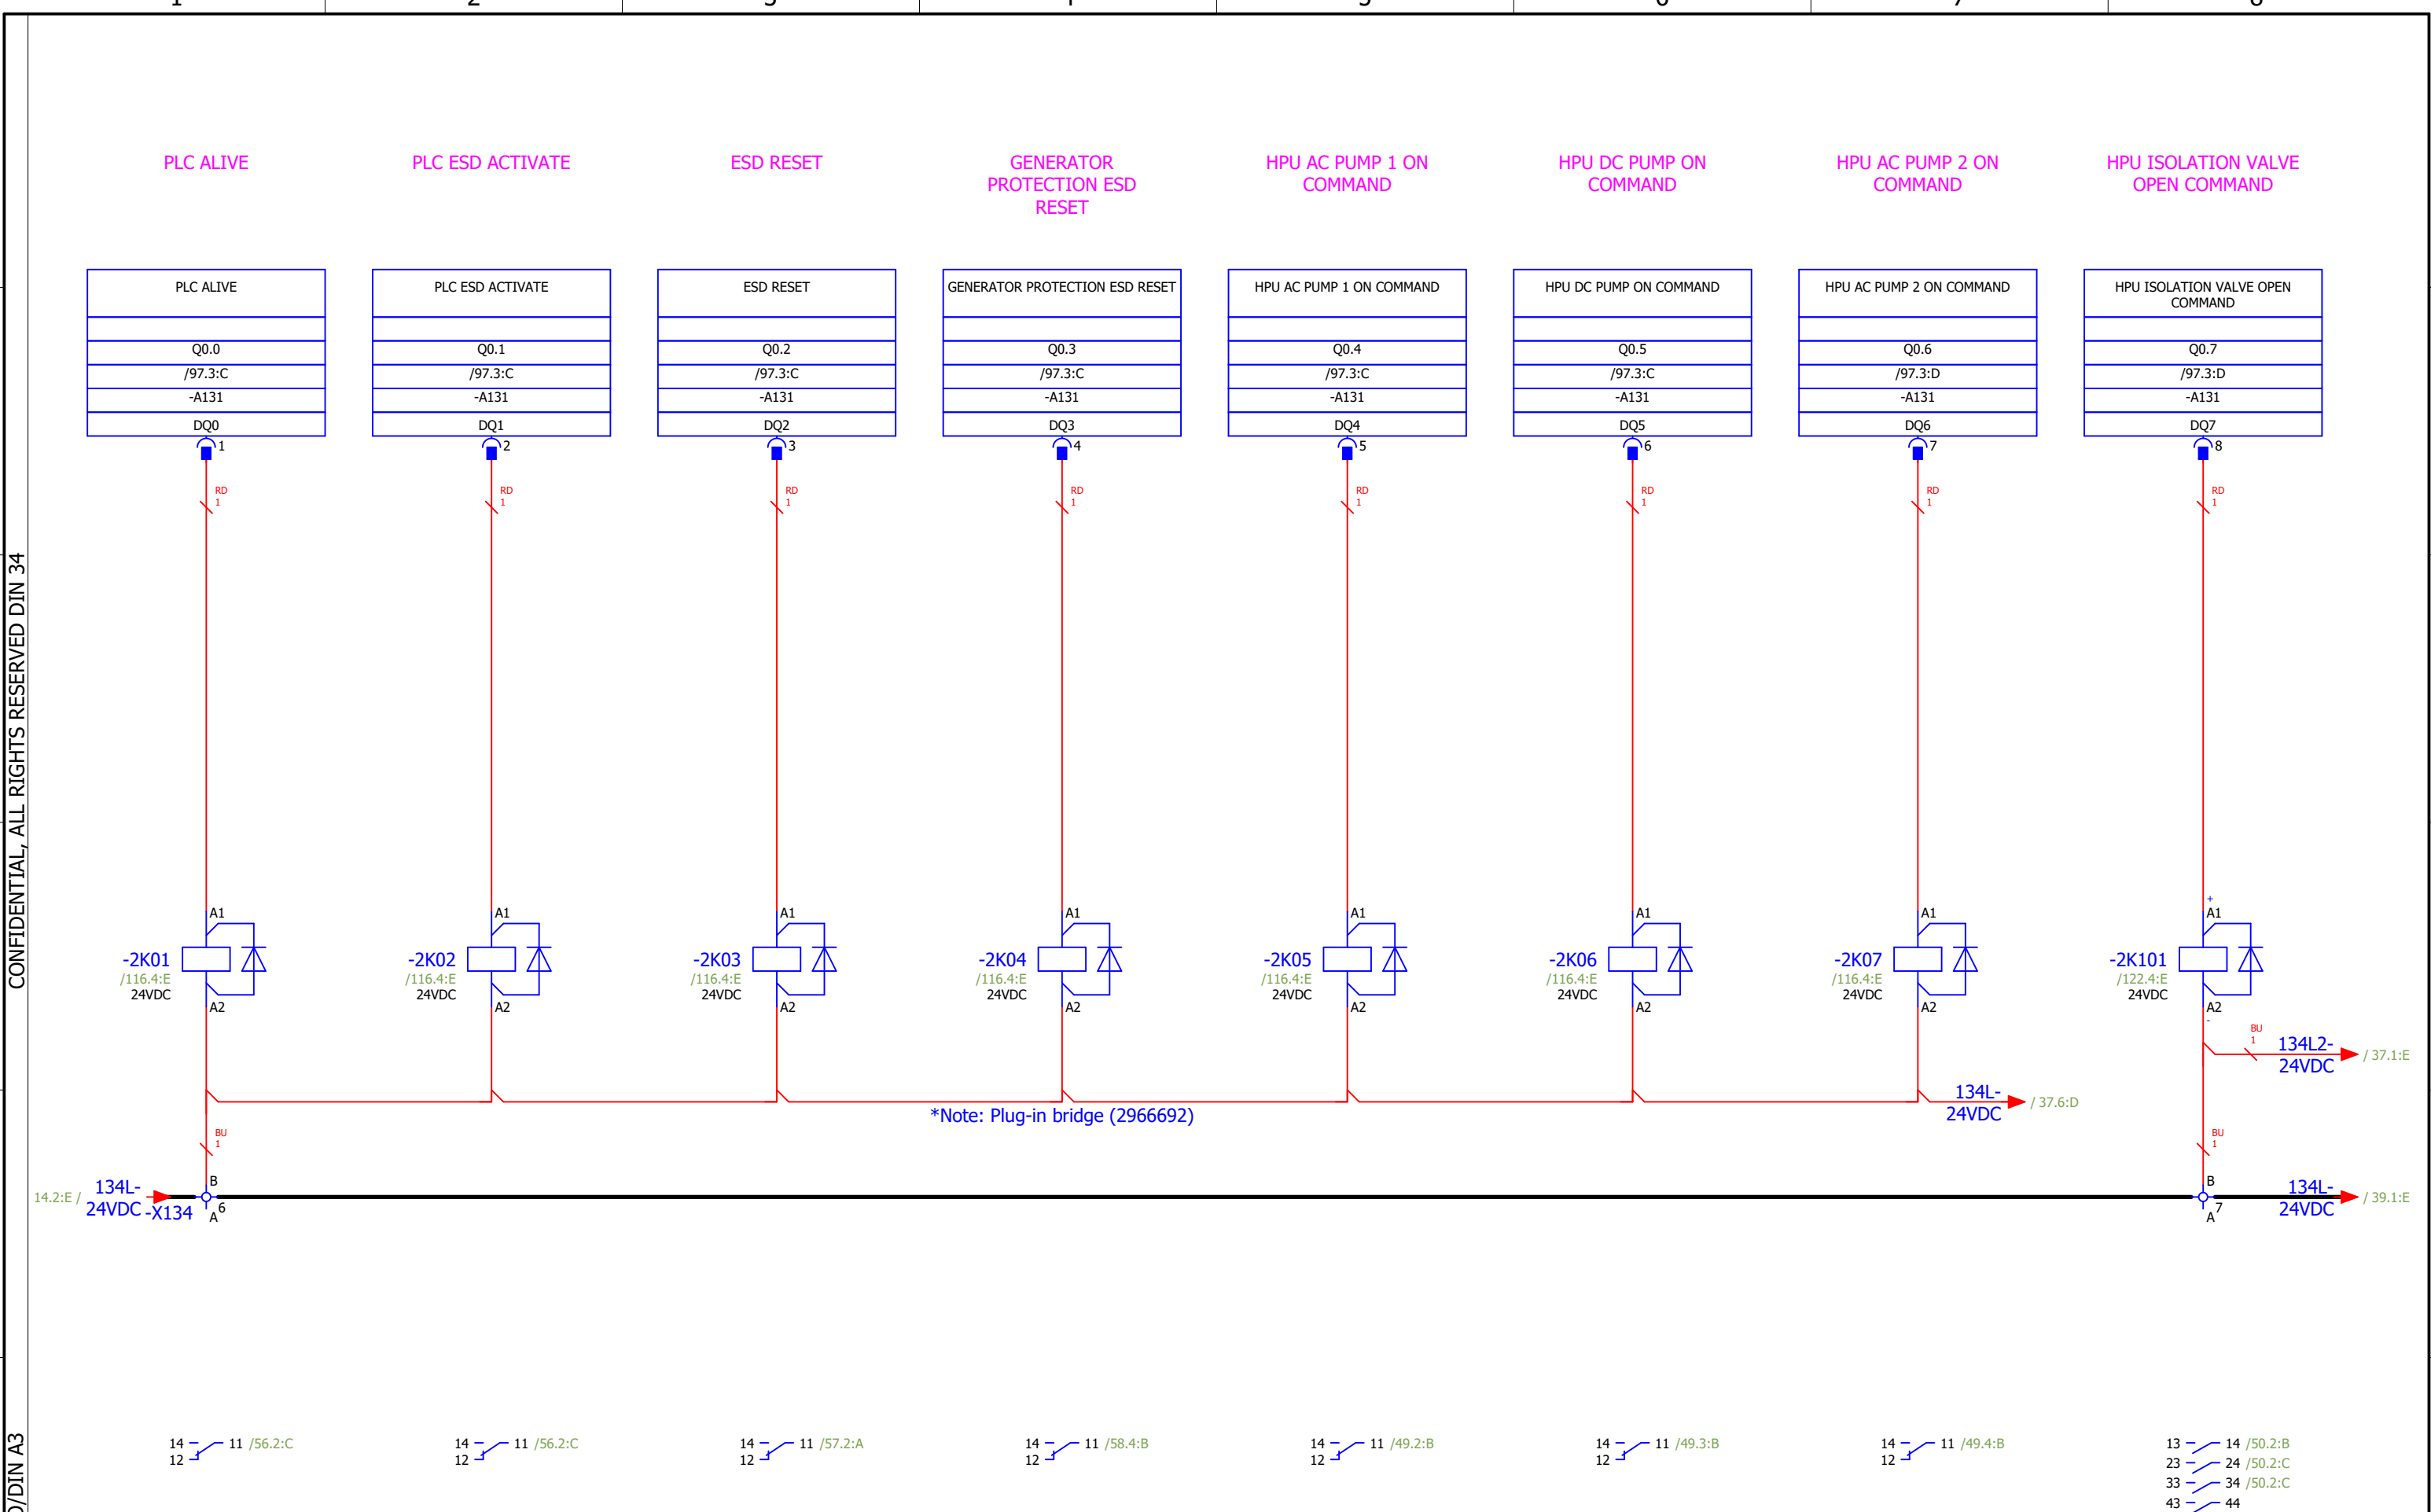

CONFIDENTIAL, ALL RIGHTS RESERVED DIN 34

Format ISO/DIN A3

36

38

Approved by Contractor			Reconstruction and Modernisation of HPP Perucica - Phase II		 A Voith Company Sintaksa - A Voith Company Ulica Domovinskog rata 104C, 21 000 Split, Hrvatska	Unit KA1 control cubicle circuit diagrams DIGITAL OUTPUTS: 1.0 - 1.7	DRAWING No.: PERU-01-19-170-31-001	REV No.: 02	= UACJA10GH100
Approved by Designer	Grga Kolić	01.10.2026.					Designer No.:	SALES No.:	+ UACJA10
Checked by	Antonio Aleksić	01.10.2026.							PAGE 37
Drawn by	Tamara Trogrlić	01.10.2026.							PAGE 37 / 156

HPU ISOLATION VALVE
CLOSE COMMAND

HPU LOAD VALVE ON
COMMAND

NOZZLE OPEN
COMMAND

NOZZLE CLOSE
COMMAND

ACTIVATE ESD VALVE

BYPASS VALVE OPEN
COMMAND

BYPASS VALVE CLOSE
COMMAND

MIV OPEN COMMAND

HPU ISOLATION VALVE CLOSE COMMAND
Q1.0
/97.3:D
-A131
DQ8

HPU LOAD VALVE ON COMMAND
Q1.1
/97.3:D
-A131
DQ9

NOZZLE OPEN COMMAND
Q1.2
/97.3:D
-A131
DQ10


NOZZLE CLOSE COMMAND
Q1.3
/97.3:E
-A131
DQ11

ACTIVATE ESD VALVE
Q1.4
/97.3:E
-A131
DQ12

BYPASS VALVE OPEN COMMAND
Q1.5
/97.3:E
-A131
DQ13

BYPASS VALVE CLOSE COMMAND
Q1.6
/97.3:E
-A131
DQ14

MIV OPEN COMMAND
Q1.7
/97.3:E
-A131
DQ15

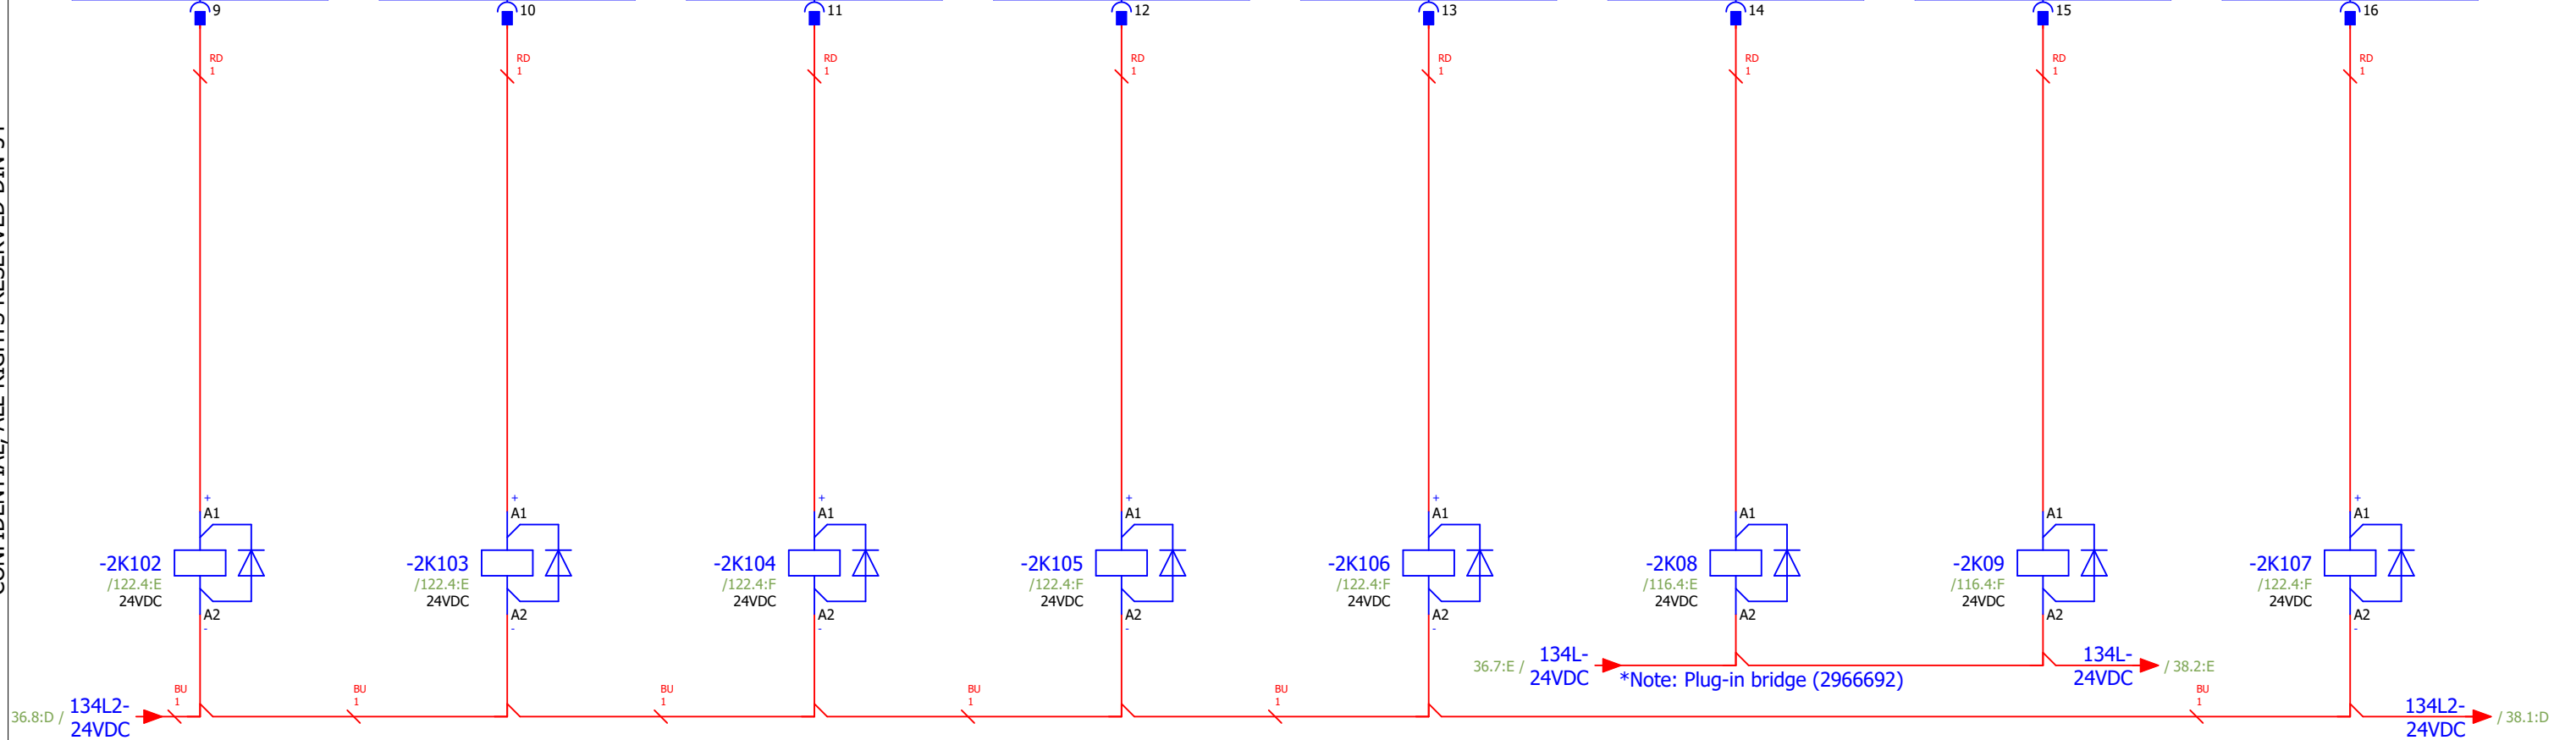

13 — 14 /50.3:B
23 — 24 /50.3:C
33 — 34 /50.3:C
43 — 44

13 — 14 /50.4:B
23 — 24 /50.4:C
33 — 34 /50.4:C
43 — 44

13 — 14 /50.5:B
23 — 24 /50.5:C
33 — 34 /50.5:C
43 — 44

13 — 14 /50.6:B
23 — 24 /50.6:C
33 — 34 /50.6:C
43 — 44

13 — 14 /51.3:B
23 — 24 /51.3:C
33 — 34 /51.3:C
43 — 44

14 — 11 /52.7:B
12 —

14 — 11 /52.8:B
12 —

13 — 14 /52.4:B
23 — 24 /52.4:C
33 — 34 /52.4:C
43 — 44

CONFIDENTIAL, ALL RIGHTS RESERVED DIN 34

Format ISO/DIN A3

37

Approved by Contractor			Reconstruction and Modernisation of HPP Perucica - Phase II		 A Voith Company Sintaksa - A Voith Company Ulica Domovinskog rata 104C, 21 000 Split, Hrvatska	Unit KA1 control cubicle circuit diagrams DIGITAL OUTPUTS: 2.0 - 2.7	DRAWING No.: PERU-01-19-170-31-001	REV No.: 02	= UACJA10GH100
Approved by Designer	Grga Kolić	01.10.2026.					Designer No.:	SALES No.:	+ UACJA10
Checked by	Antonio Aleksić	01.10.2026.							PAGE 38
Drawn by	Tamara Trogrlić	01.10.2026.							PAGE 38 / 156

1	2	3	4	5	6	7	8
---	---	---	---	---	---	---	---

A

B

C

D

E

F

A

B

C

D

E

F

SEAL VALVE OPEN
COMMAND

LUBRICATION PUMP ON
COMMAND

GENERATOR CIRCUIT
BREAKER OPEN
COMMAND

SPARE

SYNCHRONIZATION RUN

AUTOMATIC
SYNCHRONIZER ON
COMMAND

GCB SYNCHRONIZATION
SELECTED

TRANSFORMER CB
SYNCHRONIZATION
SELECTED

SEAL VALVE OPEN COMMAND
Q2.0
/98.3:C
-A132
DQ0

LUBRICATION PUMP ON COMMAND
Q2.1
/98.3:C
-A132
DQ1

GENERATOR CIRCUIT BREAKER OPEN COMMAND
Q2.2
/98.3:C
-A132
DQ2


SPARE
Q2.3
/98.3:C
-A132
DQ3

SYNCHRONIZATION RUN
Q2.4
/98.3:C
-A132
DQ4

AUTOMATIC SYNCHRONIZER ON COMMAND
Q2.5
/98.3:C
-A132
DQ5

GCB SYNCHRONIZATION SELECTED
Q2.6
/98.3:D
-A132
DQ6

TRANSFORMER CB SYNCHRONIZATION SELECTED
Q2.7
/98.3:D
-A132
DQ7

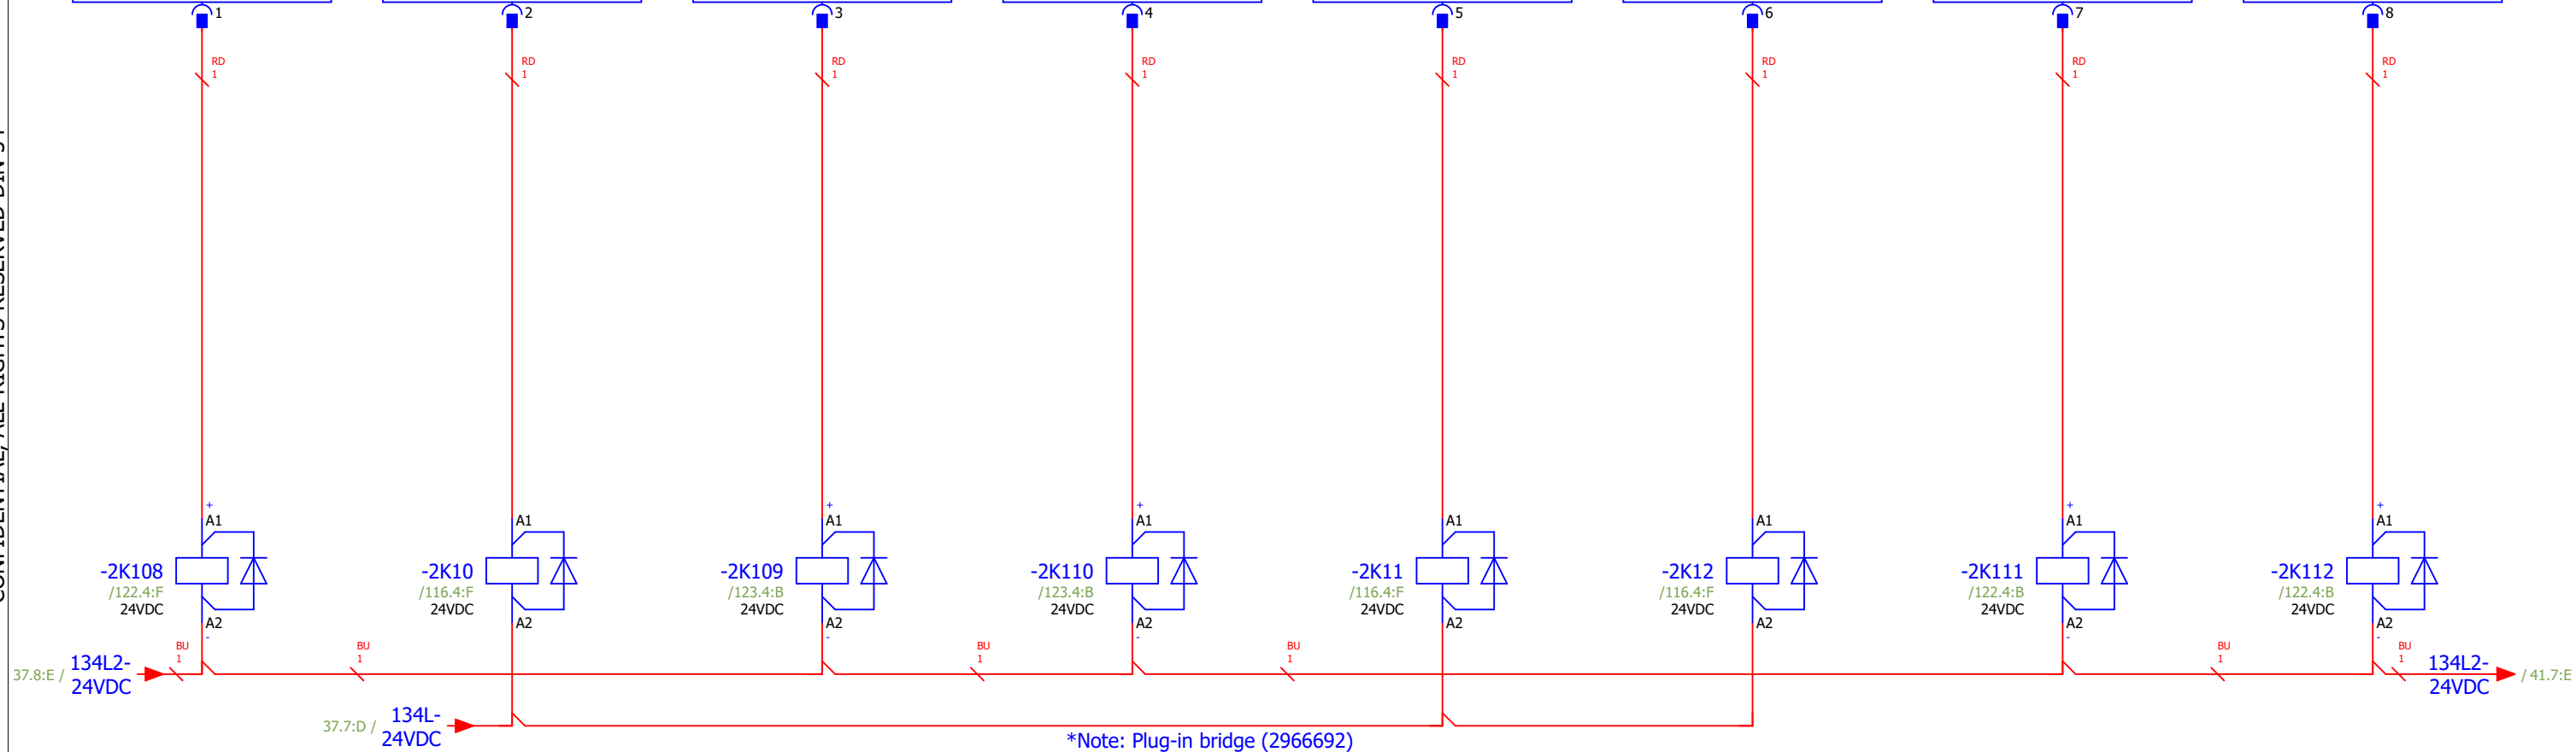

13 - 14 /52.6:B
23 - 24 /52.6:C
33 - 34 /52.6:C
43 - 44

14 - 11 /49.6:B
12 -

13 - 14 /54.3:B
23 - 24 /54.3:B
33 - 34 /54.3:C
43 - 44

13 - 14
23 - 24
33 - 34
43 - 44

14 - 11 /59.7:B
12 -

14 - 11 /62.2:B
12 -

13 - 14 /62.3:B
21 - 22 /19.2:D
33 - 34 /64.2:D
43 - 44 /59.5:B

13 - 14 /62.4:B
21 - 22 /19.3:D
33 - 34 /64.4:D
43 - 44 /59.6:B

37

39

CONFIDENTIAL, ALL RIGHTS RESERVED DIN 34

Format ISO/DIN A3

38

40

Approved by Contractor			Reconstruction and Modernisation of HPP Perucica - Phase II		 A Voith Company Sintaksa - A Voith Company Ulica Domovinskog rata 104C, 21 000 Split, Hrvatska	Unit KA1 control cubicle circuit diagrams DIGITAL OUTPUTS: 3.0 -3.7	DRAWING No.: PERU-01-19-170-31-001	REV No.: 02	= UACJA10GH100 + UACJA10
Approved by Designer	Grga Kolić	01.10.2026.					Designer No.:	SALES No.:	PAGE 39
Checked by	Antonio Aleksić	01.10.2026.							
Drawn by	Tamara Trogrlić	01.10.2026.							PAGE 39 / 156
1	2	3	4	5	6	7	8		

1 2 3 4 5 6 7 8

F

F

E

E

D

D

C

C

B

B

A

A

F

F

E

E

D

D

C

C

B

B

A

A

F

F

E

E

D

D

C

C

B

B

A

A

F

F

E

E

D

D

C

C

B

B

A

A

F

F

E

E

D

D

C

C

B

B

A

A

F

F

E

E

D

D

C

C

B

B

A

A

F

F

E

E

D

D

C

C

B

B

A

A

F

F

E

E

D

D

C

C

B

B

A

A

F

F

E

E

D

D

C

C

B

B

A

A

F

F

E

E

D

D

C

C

B

B

A

A

F

F

E

E

D

D

C

C

B

B

A

A

F

F

E

E

D

D

C

C

B

B

A

A

F

F

E

E

D

D

C

C

B

B

A

A

F

F

E

E

D

D

C

C

B

B

A

A

F

F

E

E

D

D

C

C

B

B

A

A

F

F

E

E

D

D

C

C

B

B

A

A

F

F


A


A


F

F


E

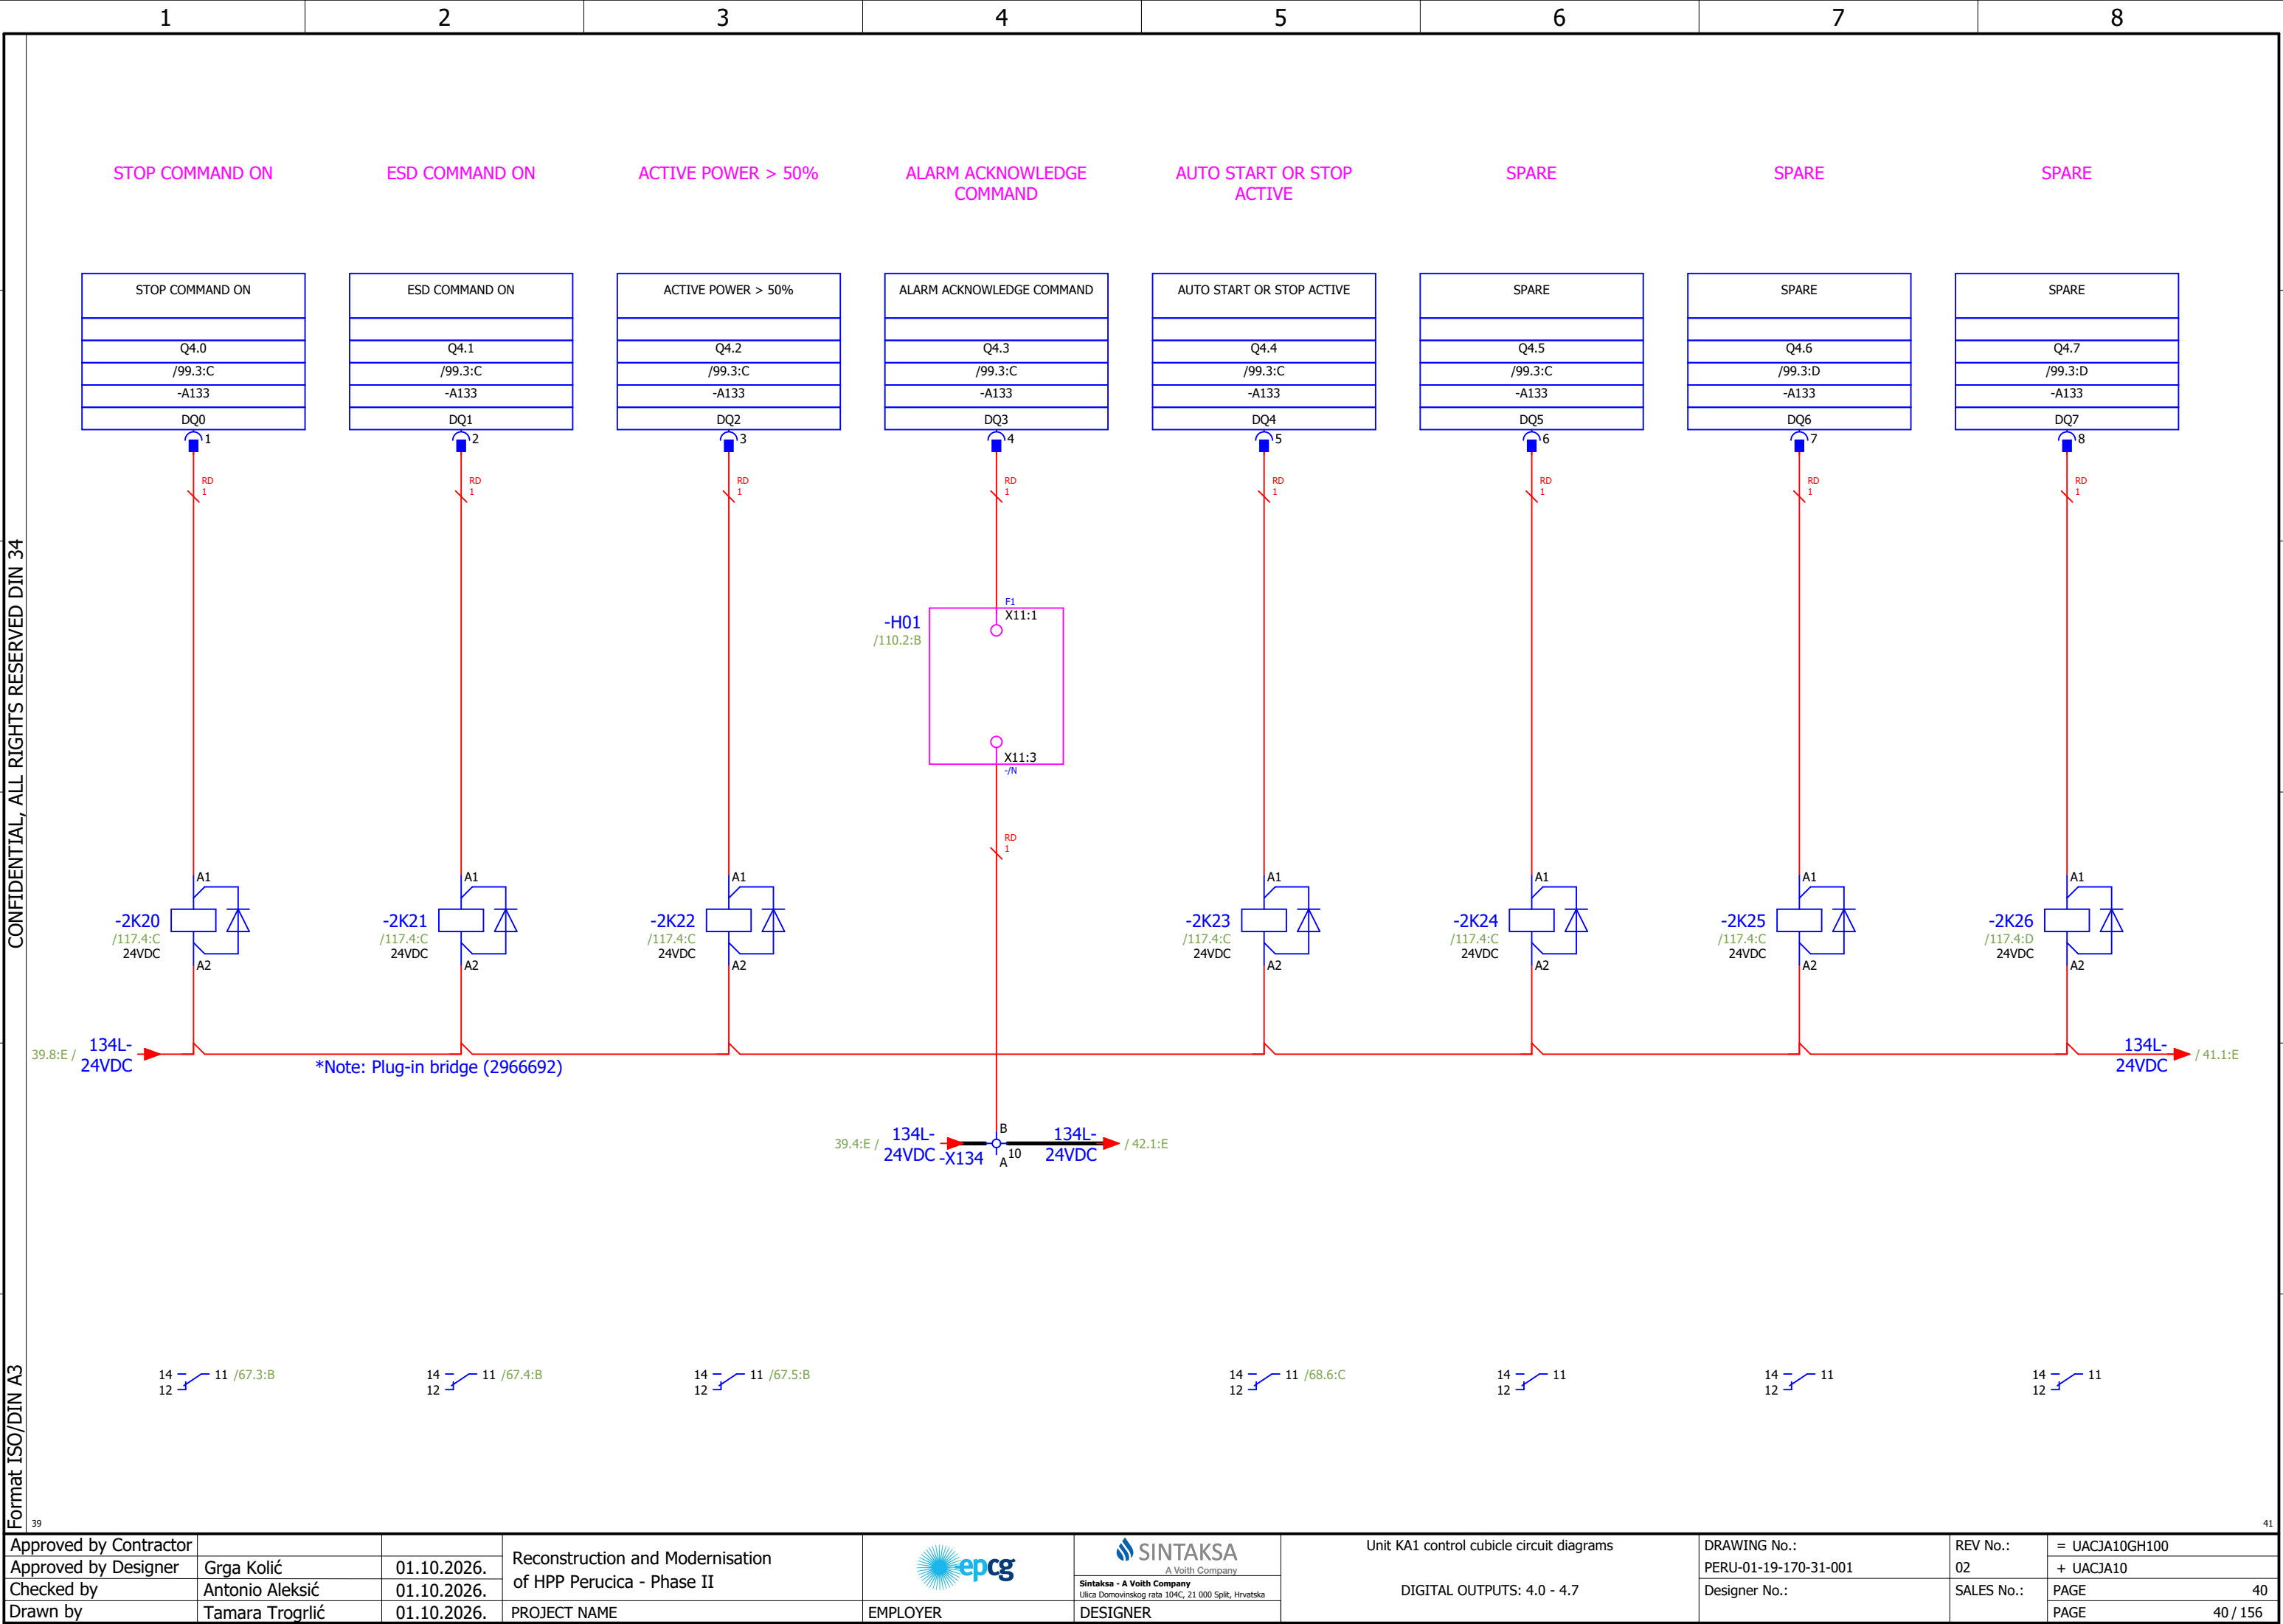

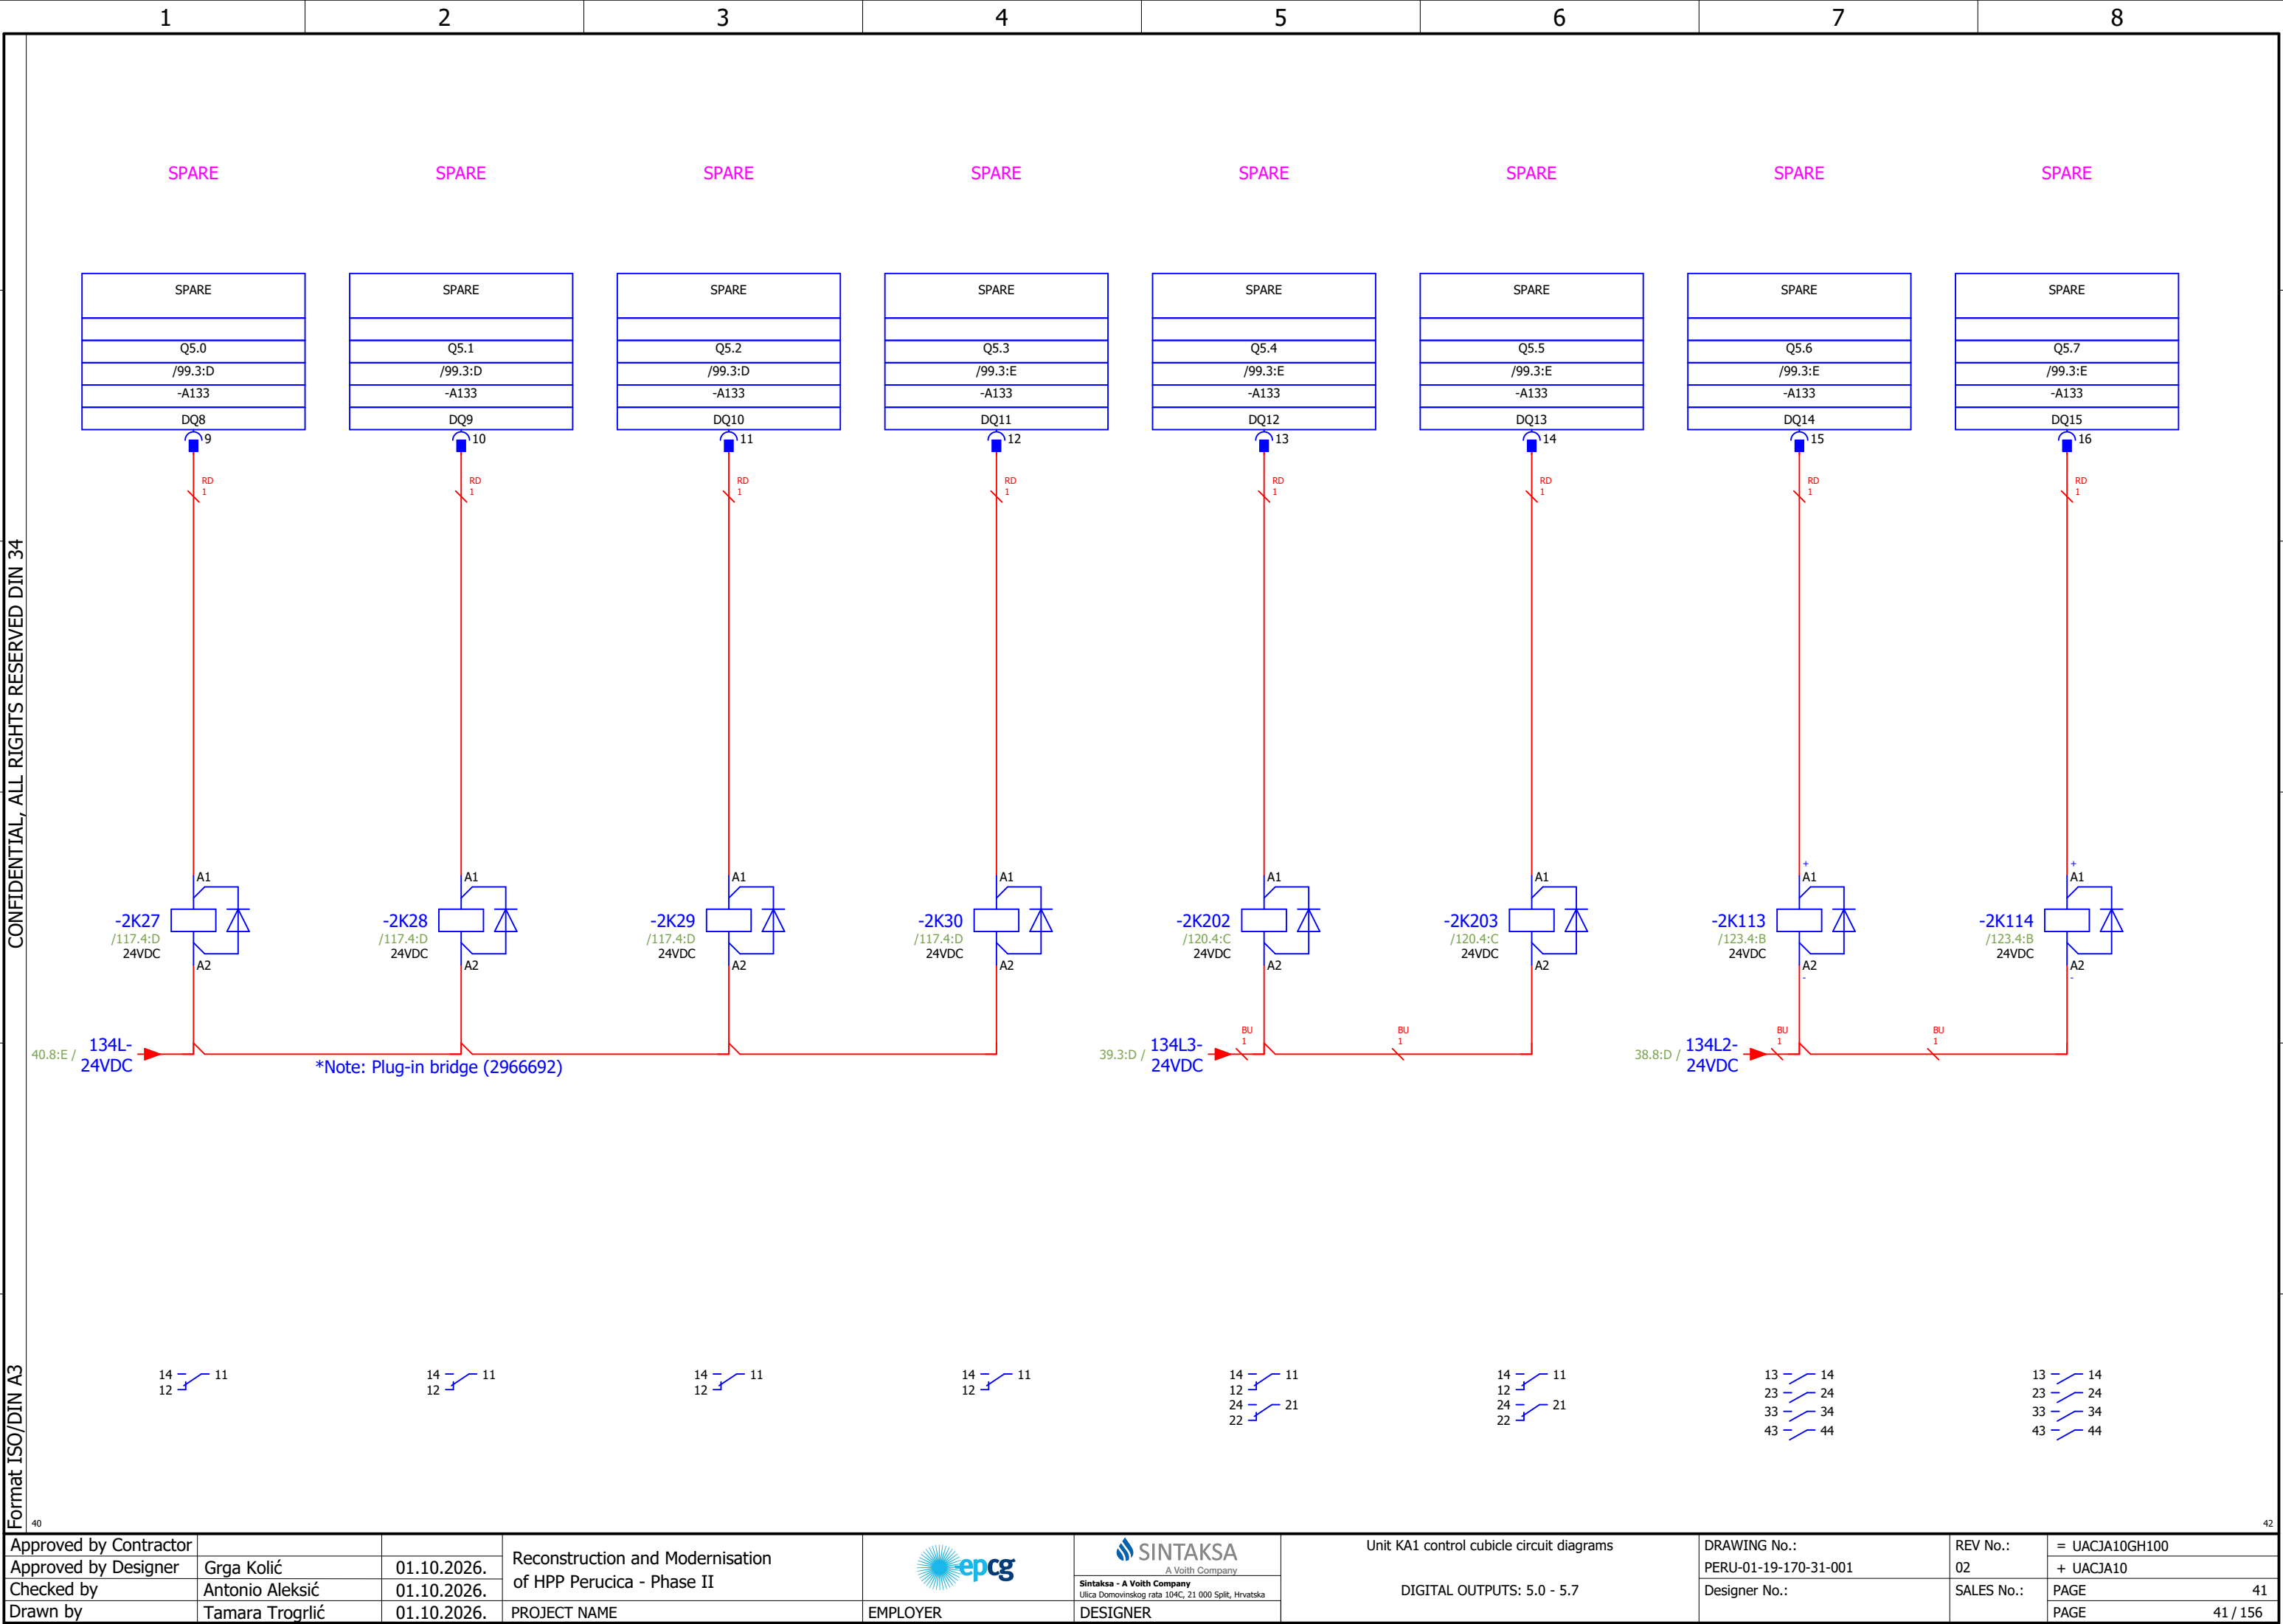

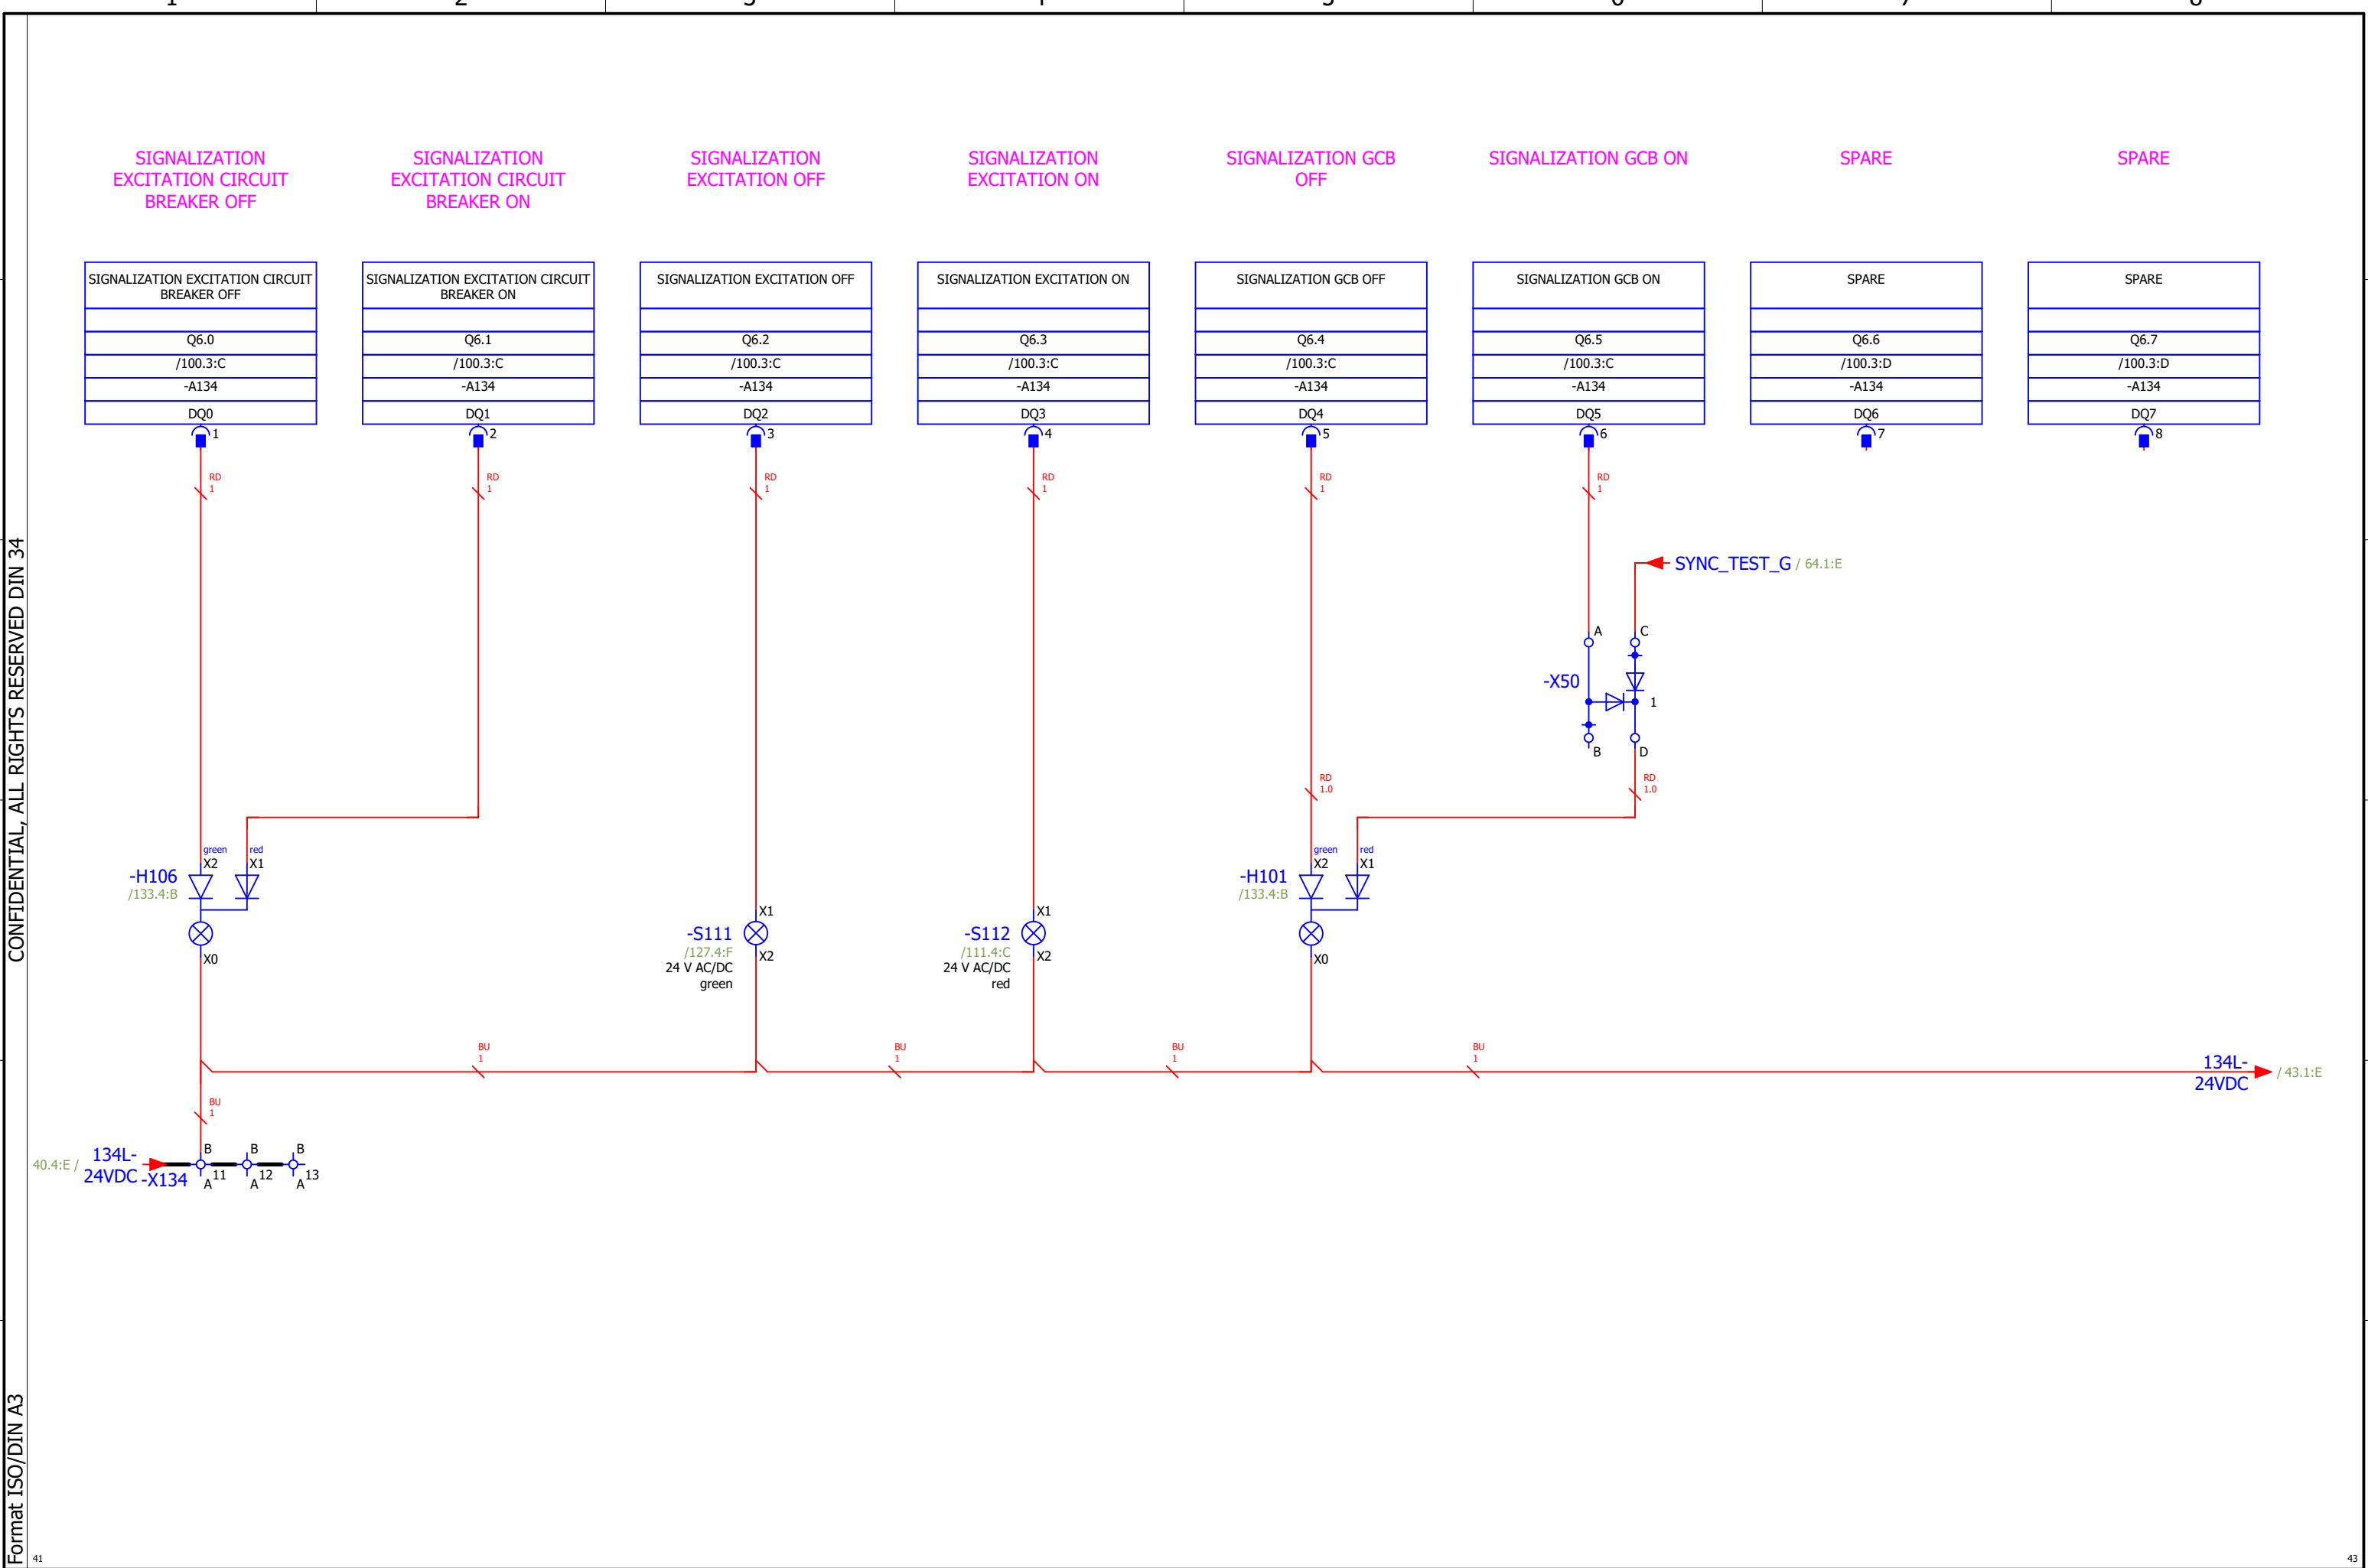


Approved by Contractor			Reconstruction and Modernisation of HPP Perucica - Phase II		 A Voith Company Sintaksa - A Voith Company Ulica Domovinskog rata 104C, 21 000 Split, Hrvatska	Unit KA1 control cubicle circuit diagrams DIGITAL OUTPUTS: 6.0 - 6.7	DRAWING No.: PERU-01-19-170-31-001	REV No.: 02	= UACJA10GH100 + UACJA10
Approved by Designer	Grga Kolić	01.10.2026.					Designer No.:	SALES No.:	PAGE 42
Checked by	Antonio Aleksić	01.10.2026.							
Drawn by	Tamara Trogrlić	01.10.2026.							PAGE 42 / 156

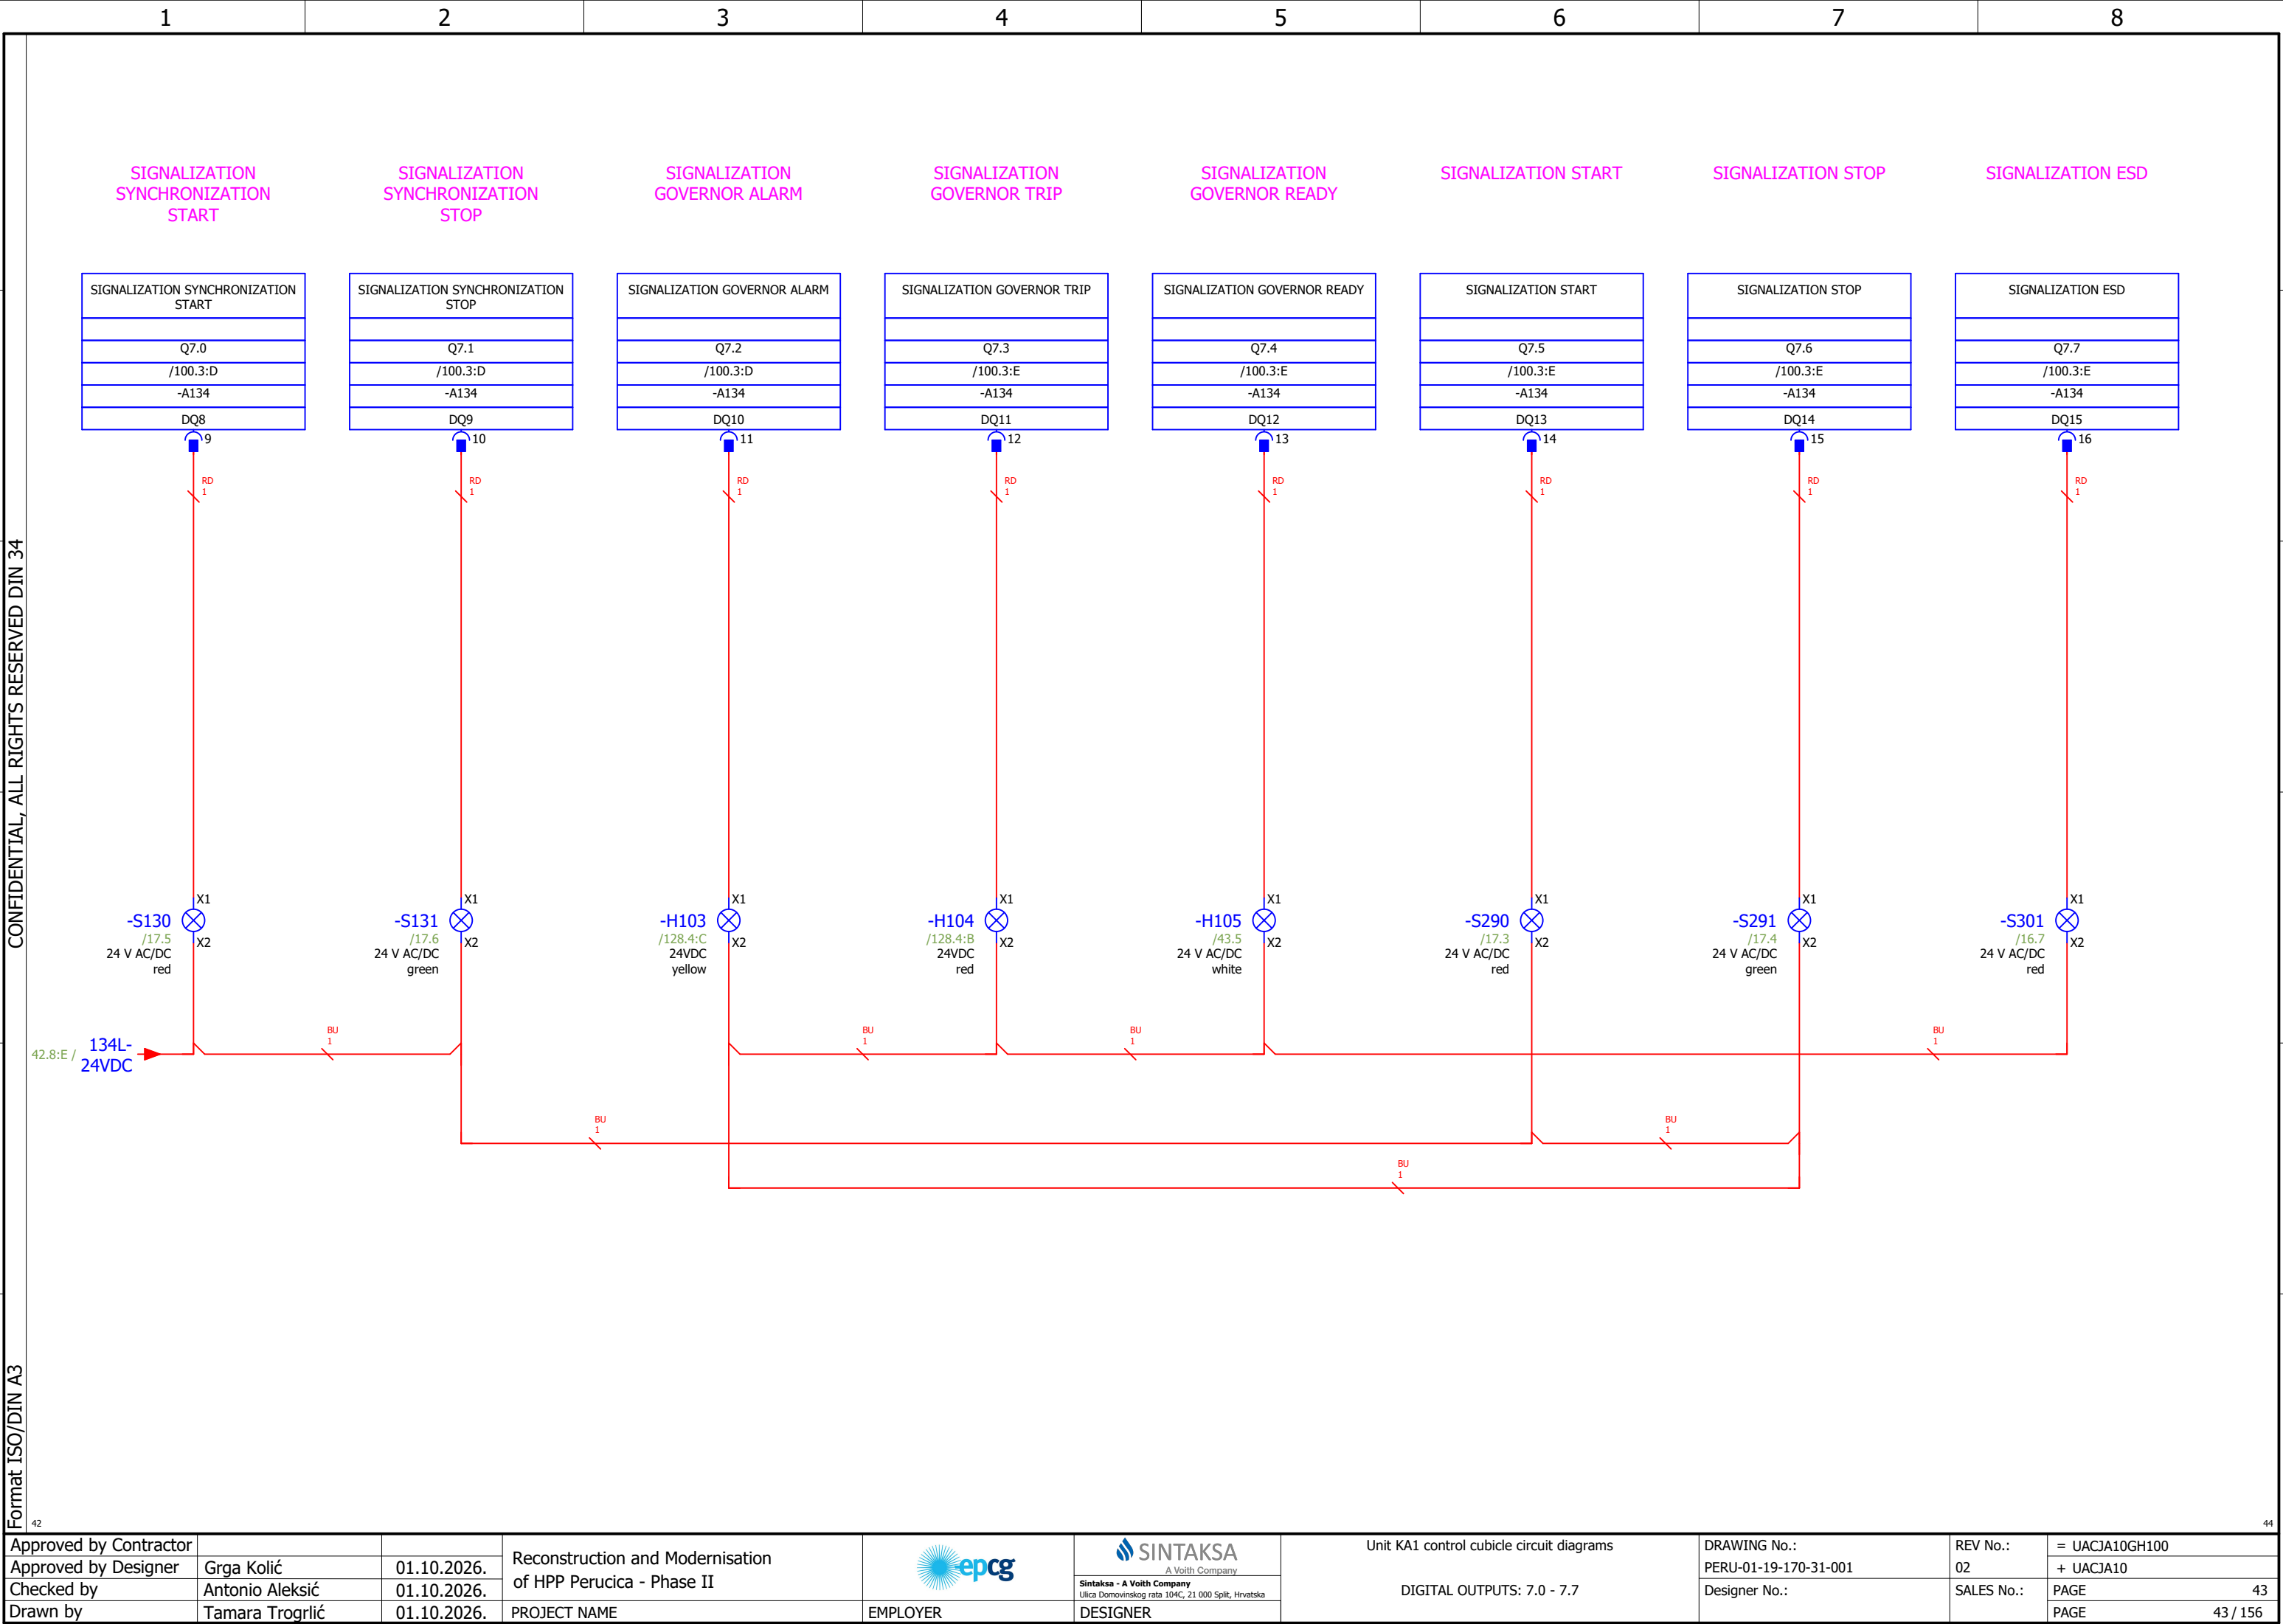

CONFIDENTIAL, ALL RIGHTS RESERVED DIN 34

Format ISO/DIN A3

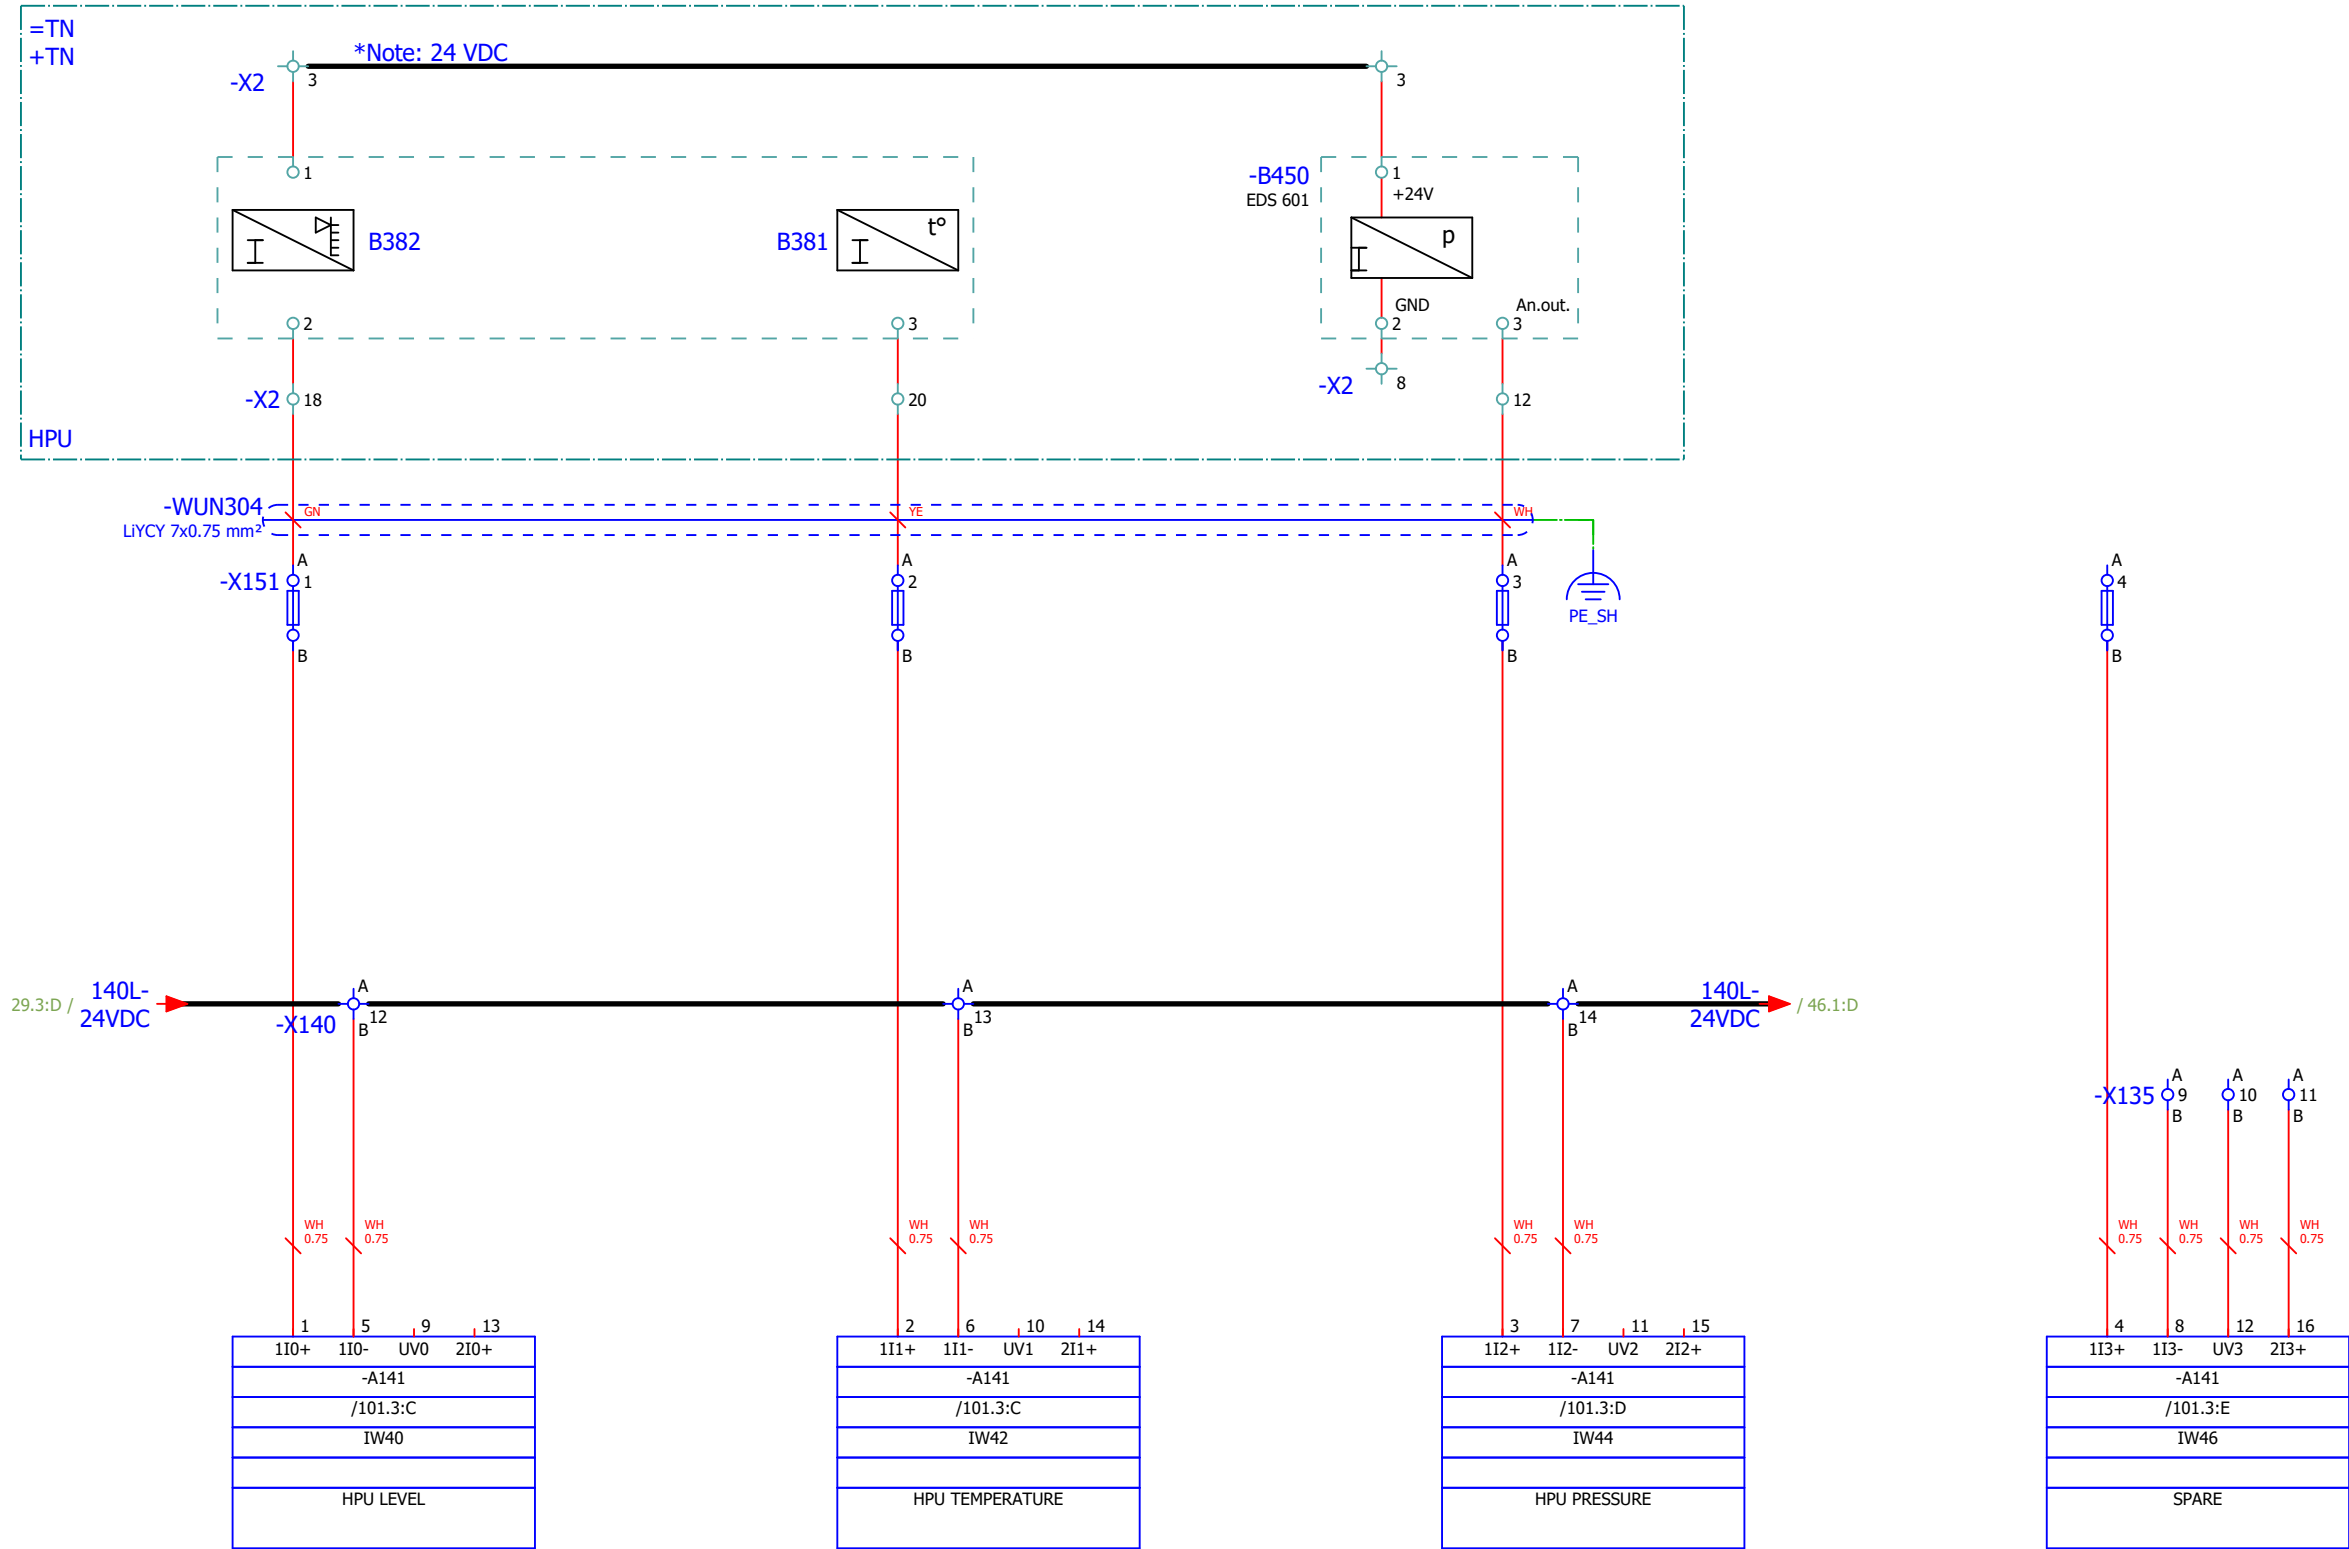

Approved by Contractor			Reconstruction and Modernisation of HPP Perucica - Phase II		 A Voith Company Sintaksa - A Voith Company Ulica Domovinskog rata 104C, 21 000 Split, Hrvatska	Unit KA1 control cubicle circuit diagrams ANALOG INPUTS: 1 - 4	DRAWING No.: PERU-01-19-170-31-001	REV No.: 02	= UACJA10GH100 + UACJA10
Approved by Designer	Grga Kolić	01.10.2026.					Designer No.:	SALES No.:	PAGE 44
Checked by	Antonio Aleksić	01.10.2026.							
Drawn by	Tamara Trogrlić	01.10.2026.							PAGE 44 / 156


CONFIDENTIAL, ALL RIGHTS RESERVED DIN 34

Format ISO/DIN A3

44

46

Approved by Contractor			Reconstruction and Modernisation of HPP Perucica - Phase II		 A Voith Company Sintaksa - A Voith Company Ulica Domovinskog rata 104C, 21 000 Split, Hrvatska	Unit KA1 control cubicle circuit diagrams ANALOG INPUTS: 5 - 8	DRAWING No.: PERU-01-19-170-31-001	REV No.: 02	= UACJA10GH100 + UACJA10
Approved by Designer	Grga Kolić	01.10.2026.					Designer No.:	SALES No.:	PAGE 45
Checked by	Antonio Aleksić	01.10.2026.							
Drawn by	Tamara Trogrlić	01.10.2026.							PAGE 45 / 156

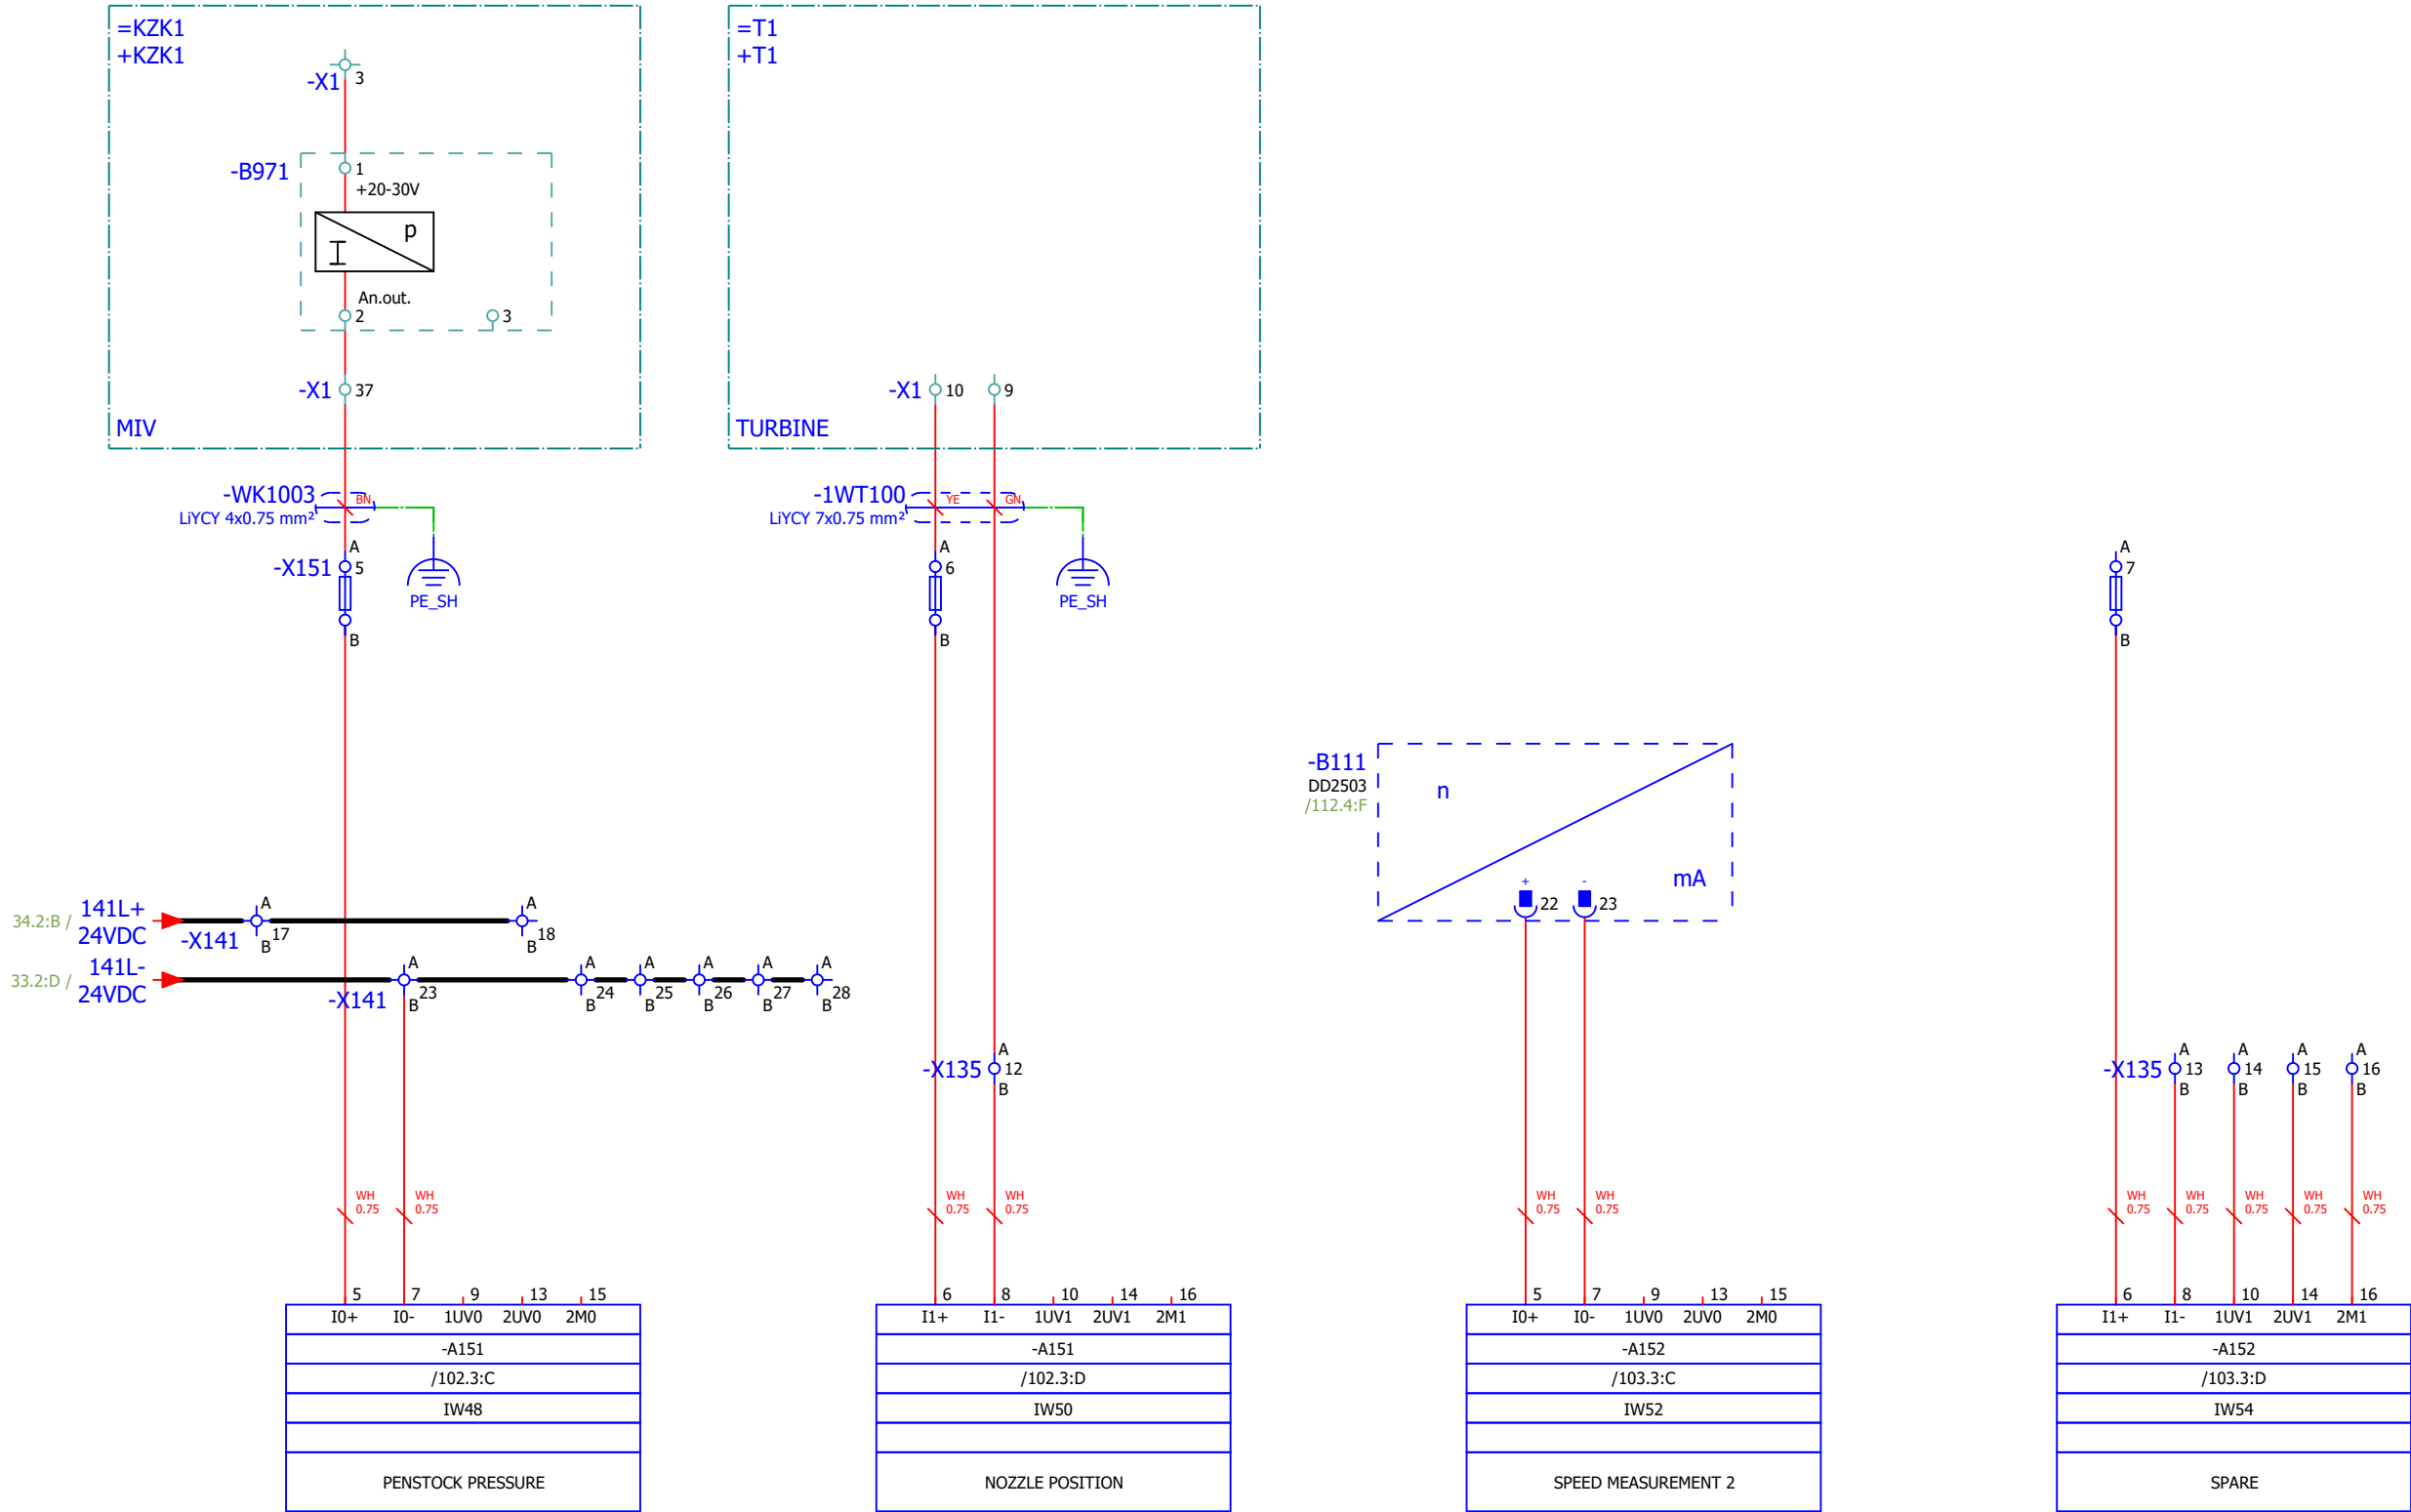

CONFIDENTIAL, ALL RIGHTS RESERVED DIN 34

Format ISO/DIN A3

Approved by Contractor			Reconstruction and Modernisation of HPP Perucica - Phase II		 A Voith Company Sintaksa - A Voith Company Ulica Domovinskog rata 104C, 21 000 Split, Hrvatska	Unit KA1 control cubicle circuit diagrams ANALOG OUTPUTS: 1 - 2	DRAWING No.: PERU-01-19-170-31-001	REV No.: 02	= UACJA10GH100 + UACJA10
Approved by Designer	Grga Kolić	01.10.2026.					Designer No.:	SALES No.:	PAGE 46
Checked by	Antonio Aleksić	01.10.2026.							
Drawn by	Tamara Trogrlić	01.10.2026.							PAGE 46 / 156

1	2	3	4	5	6	7	8
---	---	---	---	---	---	---	---

A

B

C

D

E

F

A

B

C

D

E

F

PROPORTIONAL VALVE
COMMAND

TURBINE SPEED

PROPORTIONAL VALVE COMMAND			
QW40			
/104.3:C			
-A161			
Q0+	Q0-	S0+	S0-
1	5	9	13

TURBINE SPEED			
QW42			
/104.3:C			
-A161			
Q1+	Q1-	S1+	S1-
2	6	10	14

-P1
/113.4:C
0-200%

%

44.5:E / 140L-
24VDC -X140

8.8:A / PE

-X61

PE_SH

-WUN302
LIYCY 4x0.75 mm²

=TN
+TN
HPU

-X1

39 40 41 42 PE

-Y111

+24V DC
0VDC
REF 0V

A B C D E F PE
+ 10V -
4-20mA POZ

CONFIDENTIAL, ALL RIGHTS RESERVED DIN 34

Format ISO/DIN A3

46

48

Approved by Contractor			Reconstruction and Modernisation of HPP Perucica - Phase II		 A Voith Company Sintaksa - A Voith Company Ulica Domovinskog rata 104C, 21 000 Split, Hrvatska	Unit KA1 control cubicle circuit diagrams ANALOG OUTPUTS: 3 - 4	DRAWING No.: PERU-01-19-170-31-001	REV No.: 02	= UACJA10GH100 + UACJA10
Approved by Designer	Grga Kolić	01.10.2026.					Designer No.:	SALES No.:	PAGE 47
Checked by	Antonio Aleksić	01.10.2026.							PAGE 47 / 156
Drawn by	Tamara Trogrlić	01.10.2026.	PROJECT NAME	EMPLOYER	DESIGNER				

CONFIDENTIAL, ALL RIGHTS RESERVED DIN 34
Format ISO/DIN A3

47

Approved by Contractor			Reconstruction and Modernisation of HPP Perucica - Phase II		 A Voith Company Sintaksa - A Voith Company Ulica Domovinskog rata 104C, 21 000 Split, Hrvatska	Unit KA1 control cubicle circuit diagrams SPEED MEASUREMENT	DRAWING No.: PERU-01-19-170-31-001		REV No.: 02	= UACJA10GH100 + UACJA10	
Approved by Designer	Grga Kolić	01.10.2026.					Designer No.:		SALES No.:	PAGE	48
Checked by	Antonio Aleksić	01.10.2026.								PAGE	48 / 156
Drawn by	Tamara Trogrlić	01.10.2026.									

12345678

A

B

C

D

E

F

A

B

C

D




E

F


SPEED
MEASUREMENT 1

SPEED
MEASUREMENT 3


SPEED
MEASUREMENT 2

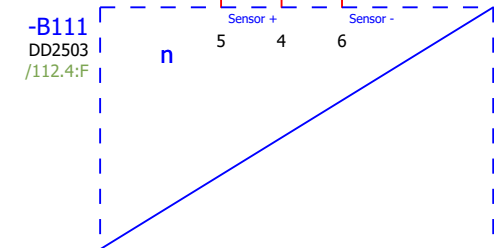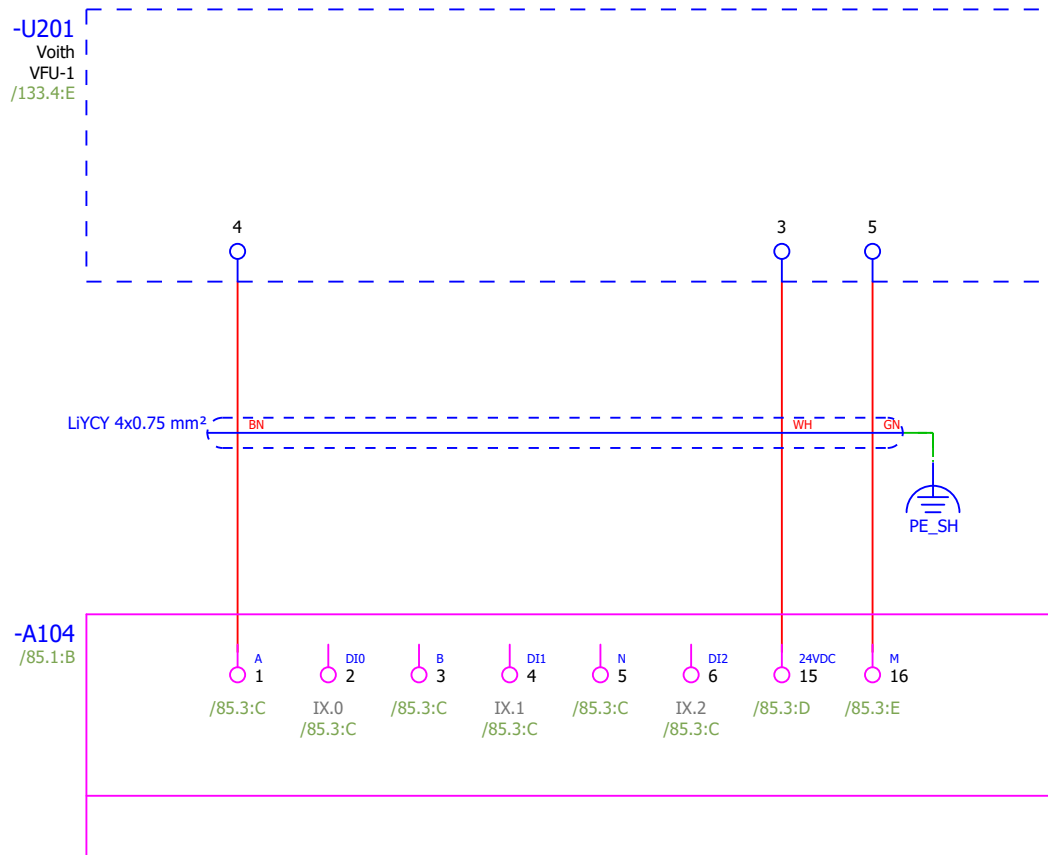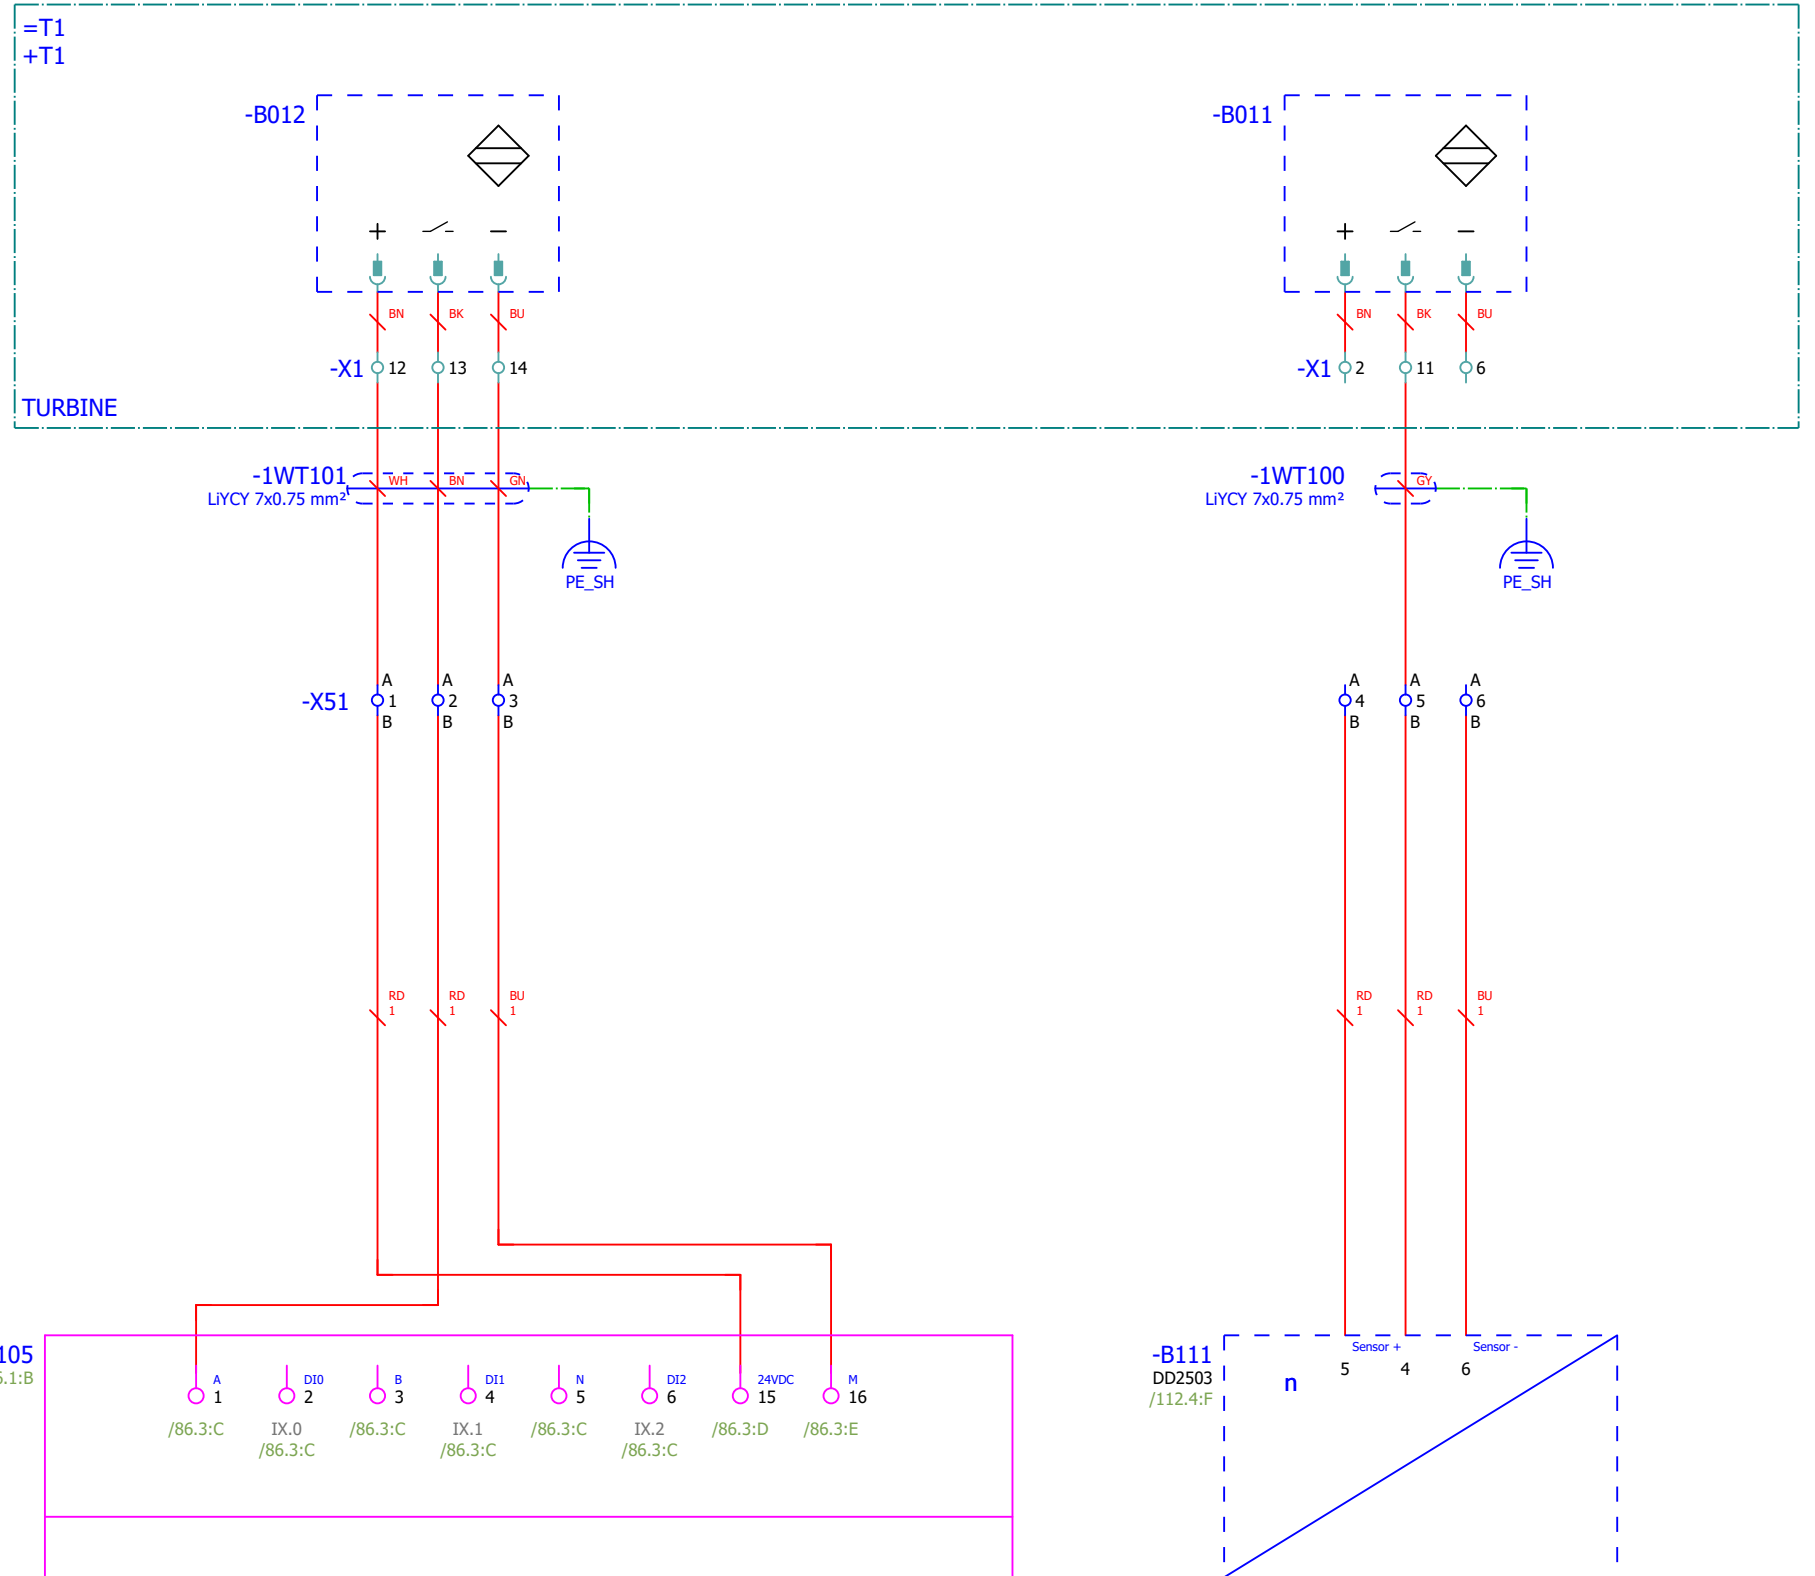


Format ISO/DIN A3

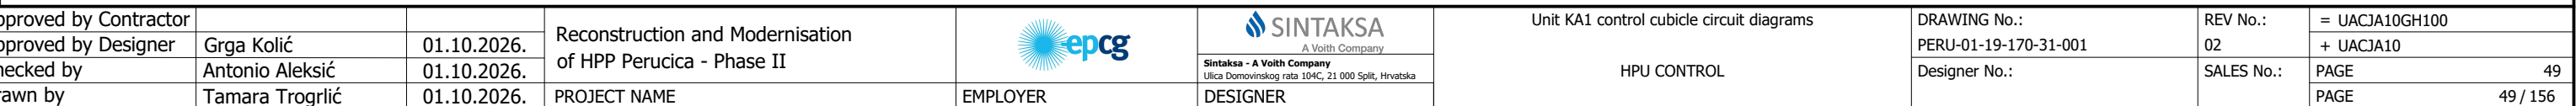

CONFIDENTIAL, ALL RIGHTS RESERVED DIN 34
Format ISO/DIN A3

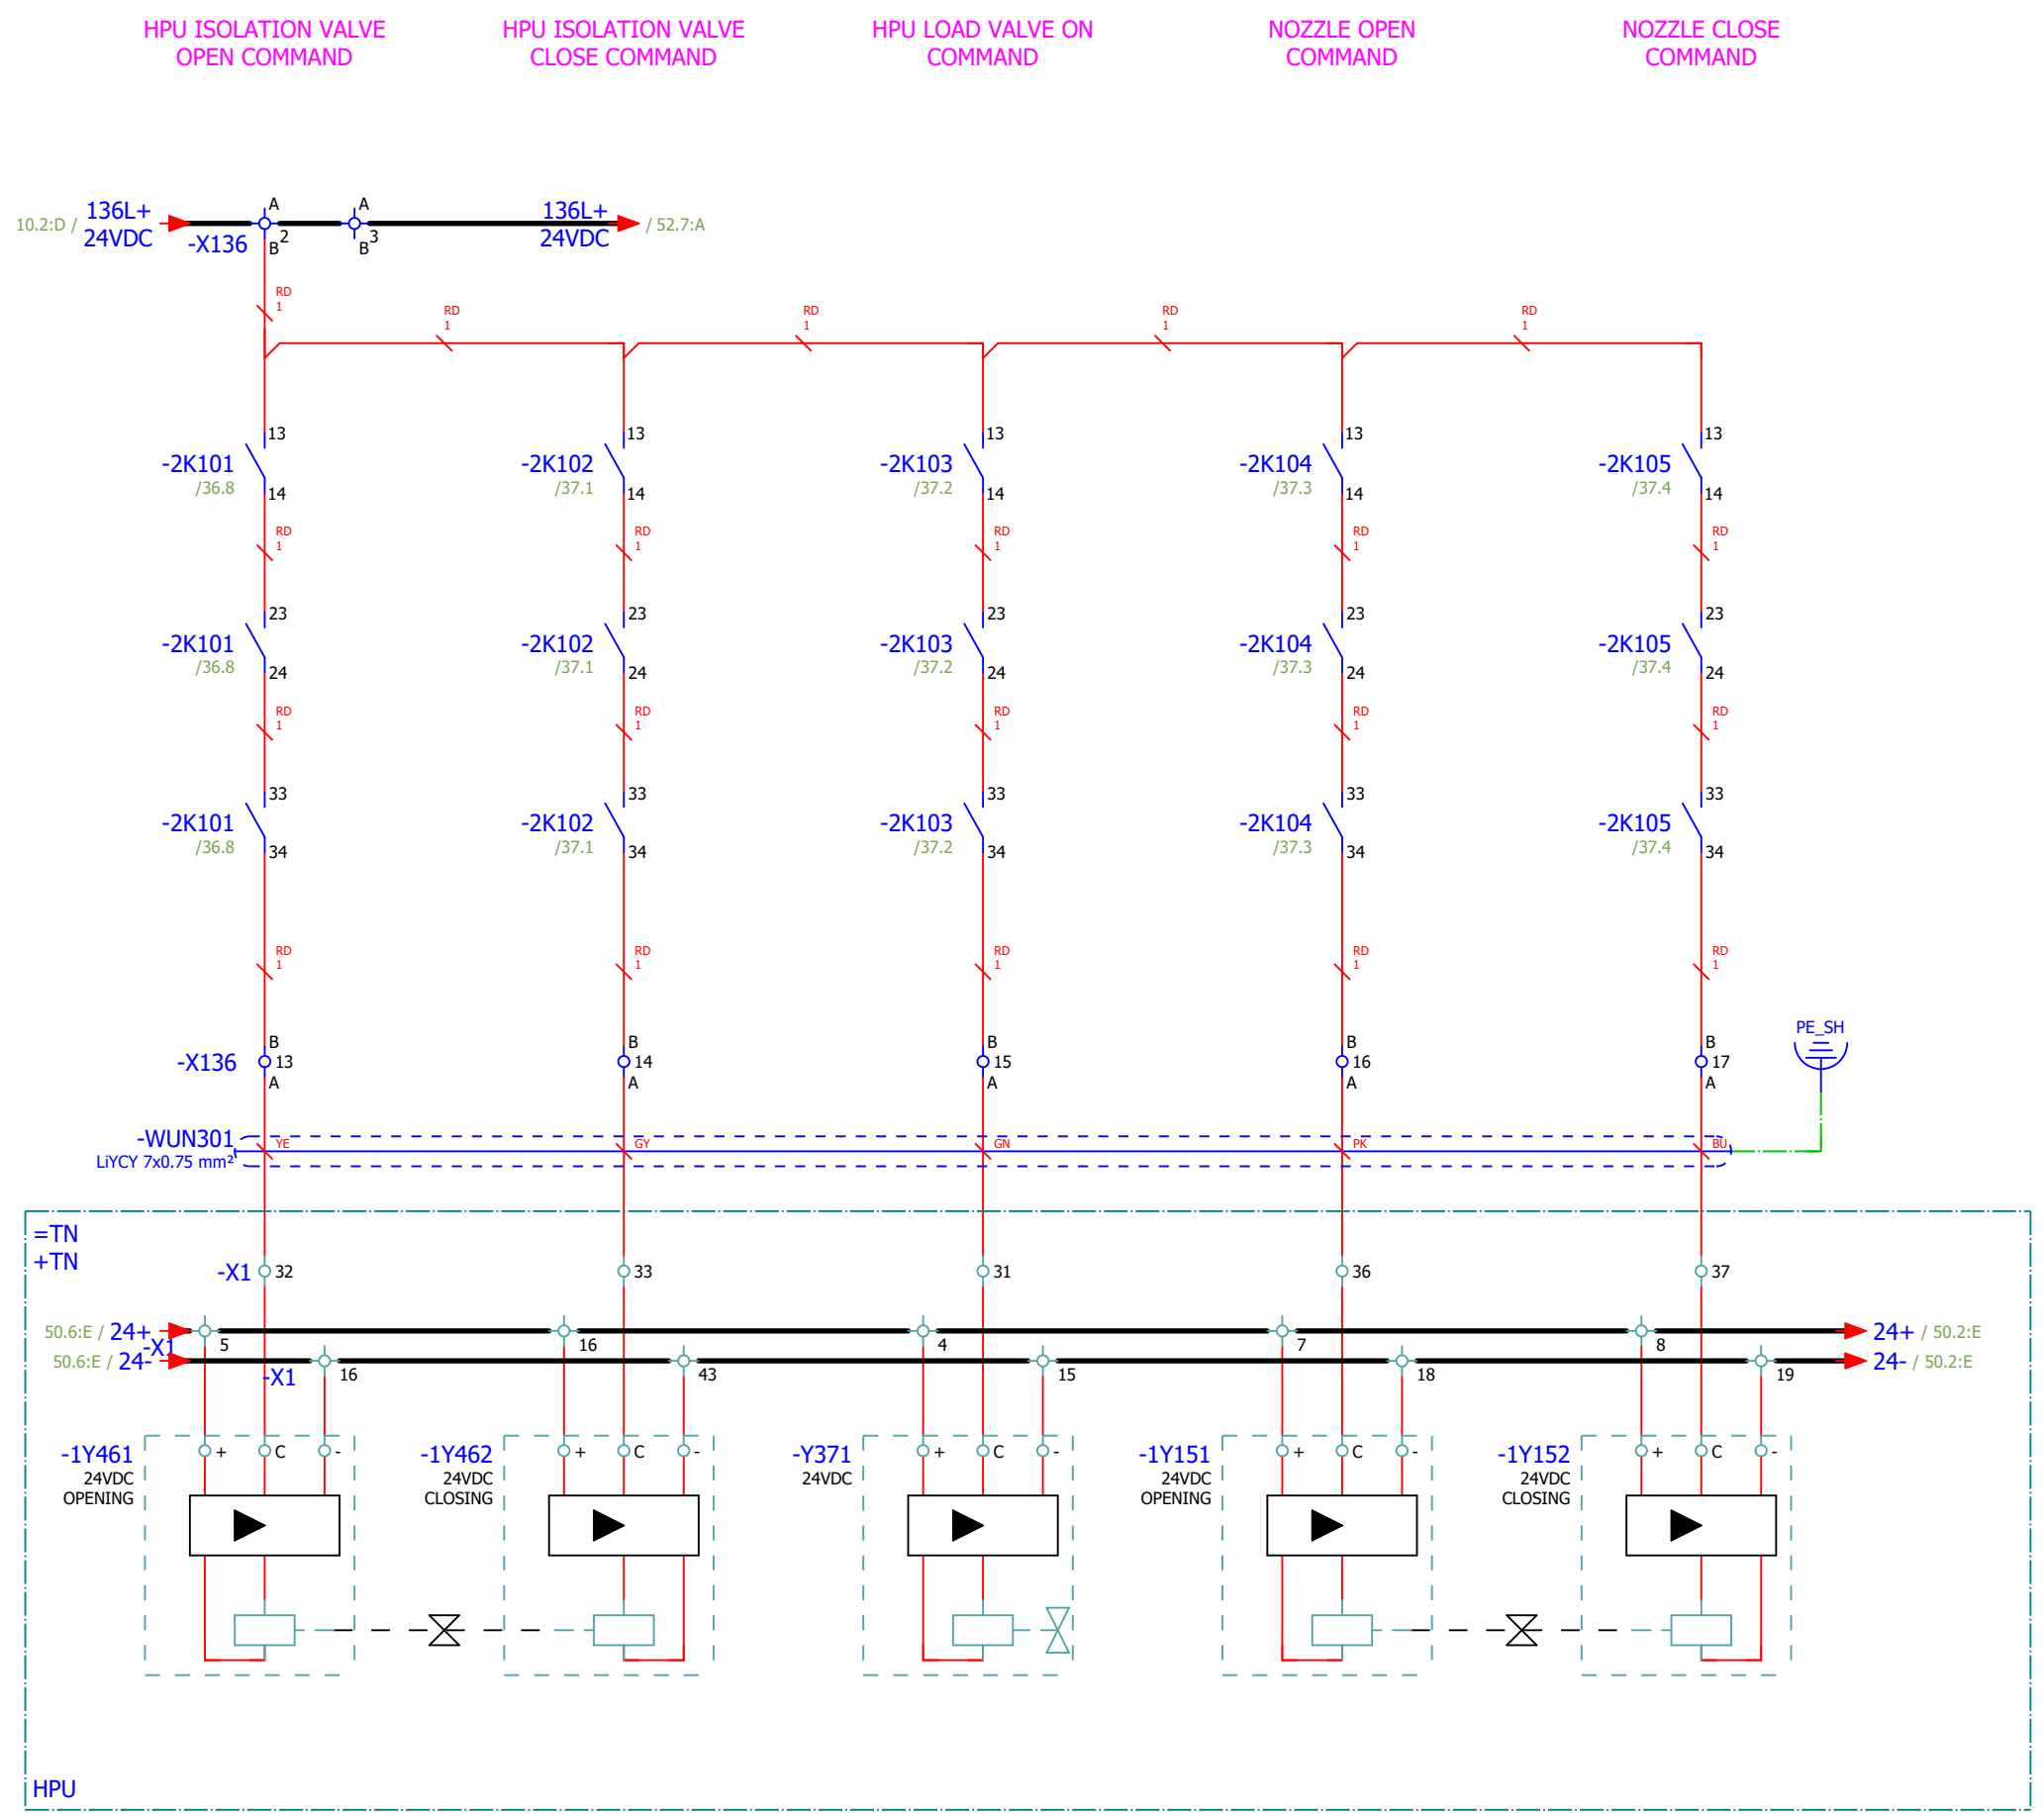

Approved by Contractor			Reconstruction and Modernisation of HPP Perucica - Phase II		 A Voith Company Sintaksa - A Voith Company Ulica Domovinskog rata 104C, 21 000 Split, Hrvatska	Unit KA1 control cubicle circuit diagrams HPU CONTROL	DRAWING No.:	REV No.:	= UACJA10GH100
Approved by Designer	Grga Kolić	01.10.2026.					PERU-01-19-170-31-001	02	+ UACJA10
Checked by	Antonio Aleksić	01.10.2026.					Designer No.:	SALES No.:	PAGE 50
Drawn by	Tamara Trogrlić	01.10.2026.							PAGE 50 / 156

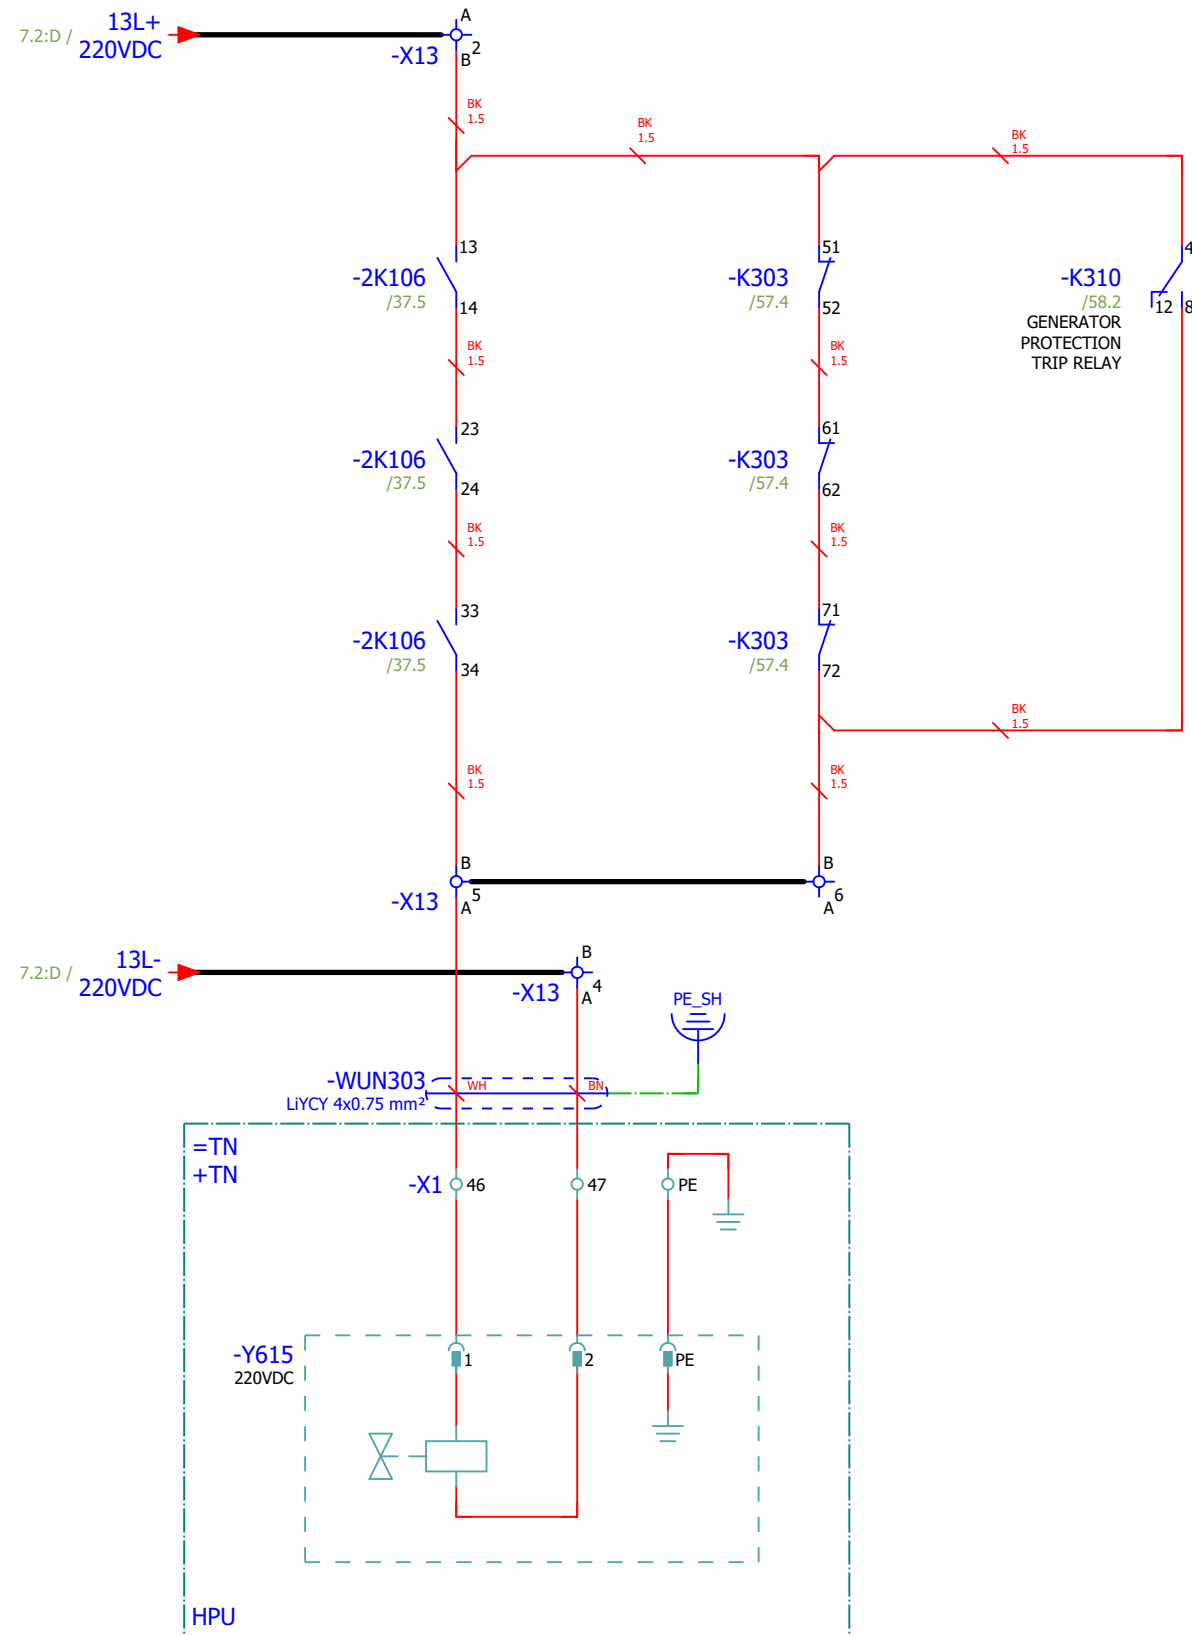

CONFIDENTIAL, ALL RIGHTS RESERVED DIN 34
Format ISO/DIN A3

51

Approved by Contractor			Reconstruction and Modernisation of HPP Perucica - Phase II		 A Voith Company Sintaksa - A Voith Company Ulica Domovinskog rata 104C, 21 000 Split, Hrvatska	Unit KA1 control cubicle circuit diagrams MIV CONTROL 24VDC	DRAWING No.: PERU-01-19-170-31-001	REV No.: 02	= UACJA10GH100 + UACJA10
Approved by Designer	Grga Kolić	01.10.2026.					Designer No.:	SALES No.:	PAGE 52
Checked by	Antonio Aleksić	01.10.2026.							
Drawn by	Tamara Trogrlić	01.10.2026.							PAGE 52 / 156

12345678

A

B

C

D

E

F

A

B

C

D

E

F

BYPASS VALVE OPEN
COMMAND


BYPASS VALVE CLOSE
COMMAND

MIV OPEN COMMAND

SEAL VALVE OPEN
COMMAND

BYPASS VALVE OPEN
COMMAND

BYPASS VALVE CLOSE
COMMAND

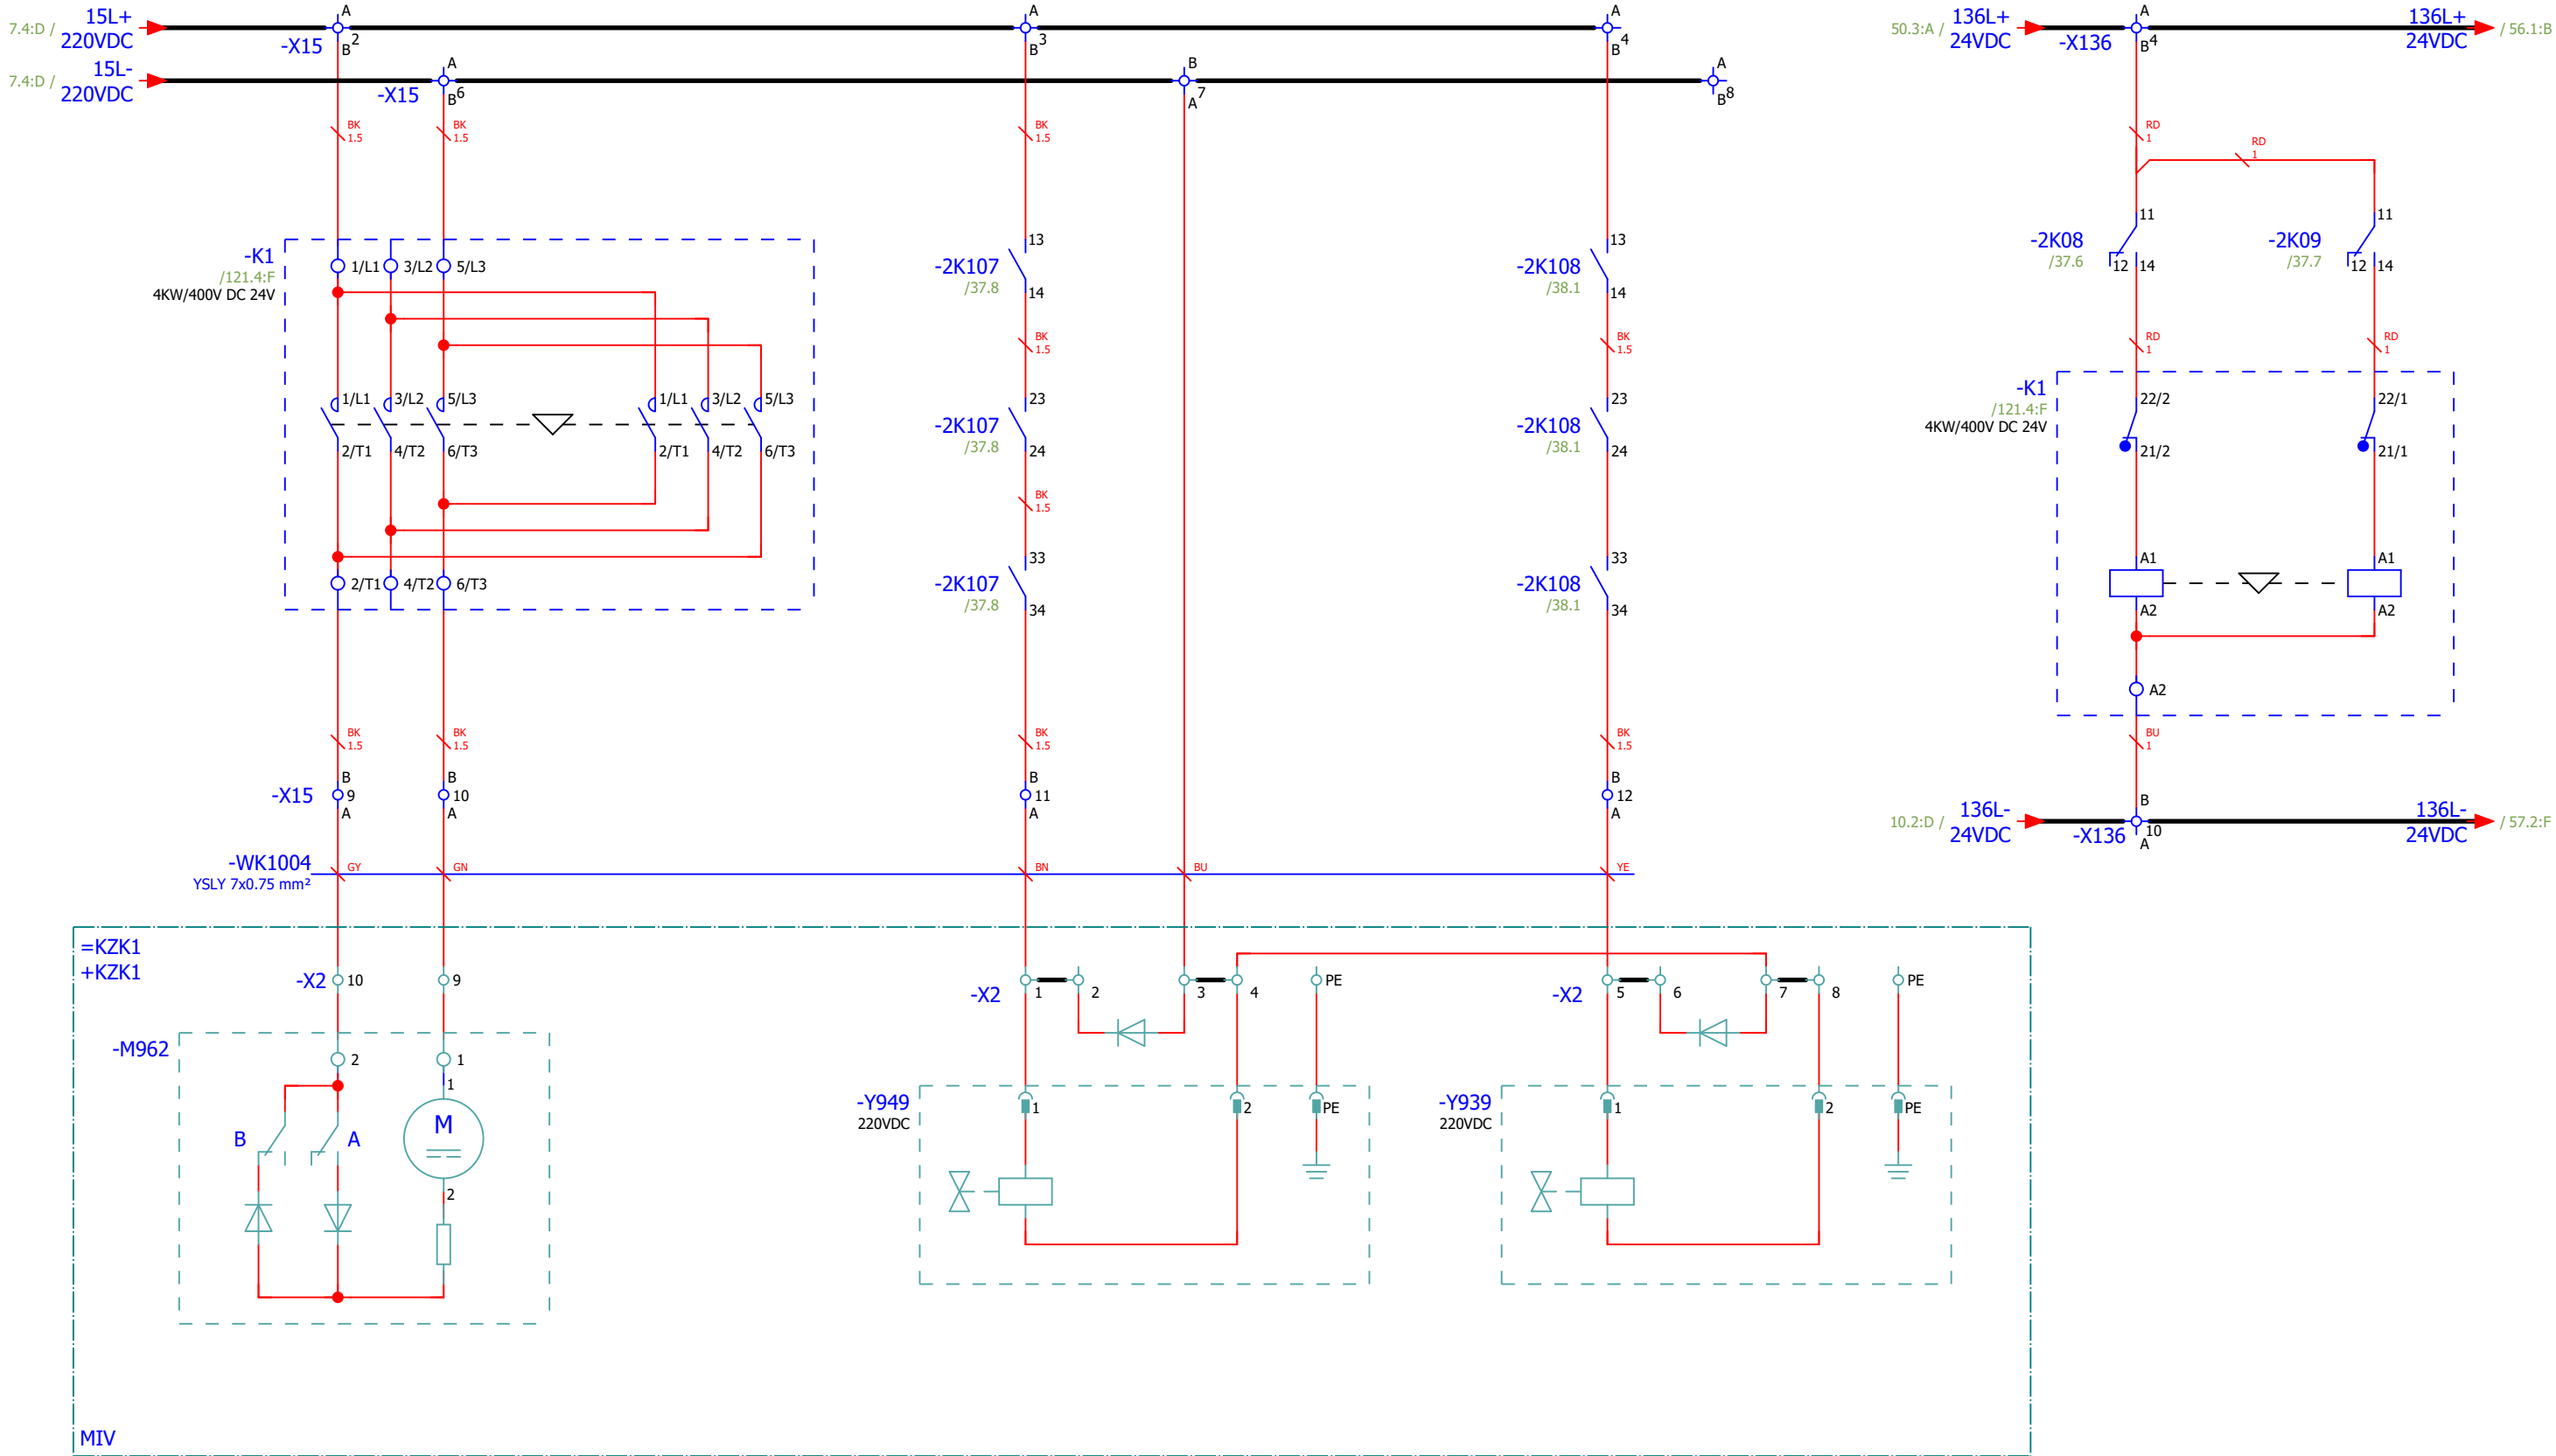

53

CONFIDENTIAL, ALL RIGHTS RESERVED DIN 34

Format ISO/DIN A3

52

1

2

3

4

5

6

7

8

54

Approved by Contractor			Reconstruction and Modernisation of HPP Perucica - Phase II		 A Voith Company Sintaksa - A Voith Company Ulica Domovinskog rata 104C, 21 000 Split, Hrvatska	Unit KA1 control cubicle circuit diagrams LOCAL CONTROL	DRAWING No.: PERU-01-19-170-31-001	REV No.: 02	= UACJA10GH100 + UACJA10
Approved by Designer	Grga Kolić	01.10.2026.					Designer No.:	SALES No.:	PAGE 53
Checked by	Antonio Aleksić	01.10.2026.							
Drawn by	Tamara Trogrlić	01.10.2026.							PAGE 53 / 156

1

2

3

4

5

6

7

8

1

2

3

4

5

6

7

8

1

2

3

4

5

6

7

8

1

2

3

4

5

6

7

8

1

2

3

4

5

6

7

8

1

2

3

4

5

6

7

8

1

2

3

4

5

6

7

8

1

2

3

4

5

6

7

8

1

2

3

4

5

6

7

8

1

2

3

4

5

6

7

8

1

2

3

4

5

6

7

8

1

2

3

4

5

6

7

8

1

2

3

4

5

6

7

8

1

2

3

4

5

6

7

8

1

2

3

4

5

6

7

8

1

2

3

4

5

6

7

8

1

2

3

4

5

6

7

8

1

2

3

4

5

6

7

8

1

2

3

4

5

6

7

8

1

2

3

4

5

6

7

8

1

2

3

4

5

6

7

8

1

2

3

4

5

6

7

8

1

2

3

4

5

6

7

8

1

2

3

4

5

6

7

8

1

2

3

4

5

6

7

8

1

2

3

4

5

6

7

8

1

2

3

4

5

6

7

8

1

2

3

4

5

6

7

8

1

2

3

4

5

6

7

8

1

2

3

4

5

6

7

8

1

2

3

4

5

6

7

8

1

2

3

4

5

6

7

8

1

2

3

4

5

6

7

8

1

2

3

4

5

6

7

8

1

2

3

4

5

6

7

8

1

2

3

4

5

6

7

8

1

2

3

4

5

6

7

8

1

2

3

4

5

6

7

8

1

2

3

4

5

6

7

8

1

2

3

4

5

6

7

8

1

2

3

4

5

6

7

8

1

2

3

4

5

6

7

8

1

2

3

4

5

6

7

8

1

CONFIDENTIAL, ALL RIGHTS RESERVED DIN 34

Format ISO/DIN A3

53

Approved by Contractor			Reconstruction and Modernisation of HPP Perucica - Phase II		 A Voith Company Sintaksa - A Voith Company Ulica Domovinskog rata 104C, 21 000 Split, Hrvatska	Unit KA1 control cubicle circuit diagrams CB CONTROL	DRAWING No.: PERU-01-19-170-31-001	REV No.: 02	= UACJA10GH100
Approved by Designer	Grga Kolić	01.10.2026.					Designer No.:	SALES No.:	+ UACJA10
Checked by	Antonio Aleksić	01.10.2026.							PAGE 54
Drawn by	Tamara Trogrlić	01.10.2026.							PAGE 54 / 156

12345678

A

B

C

D

E

F

A



B

C

D

E

F

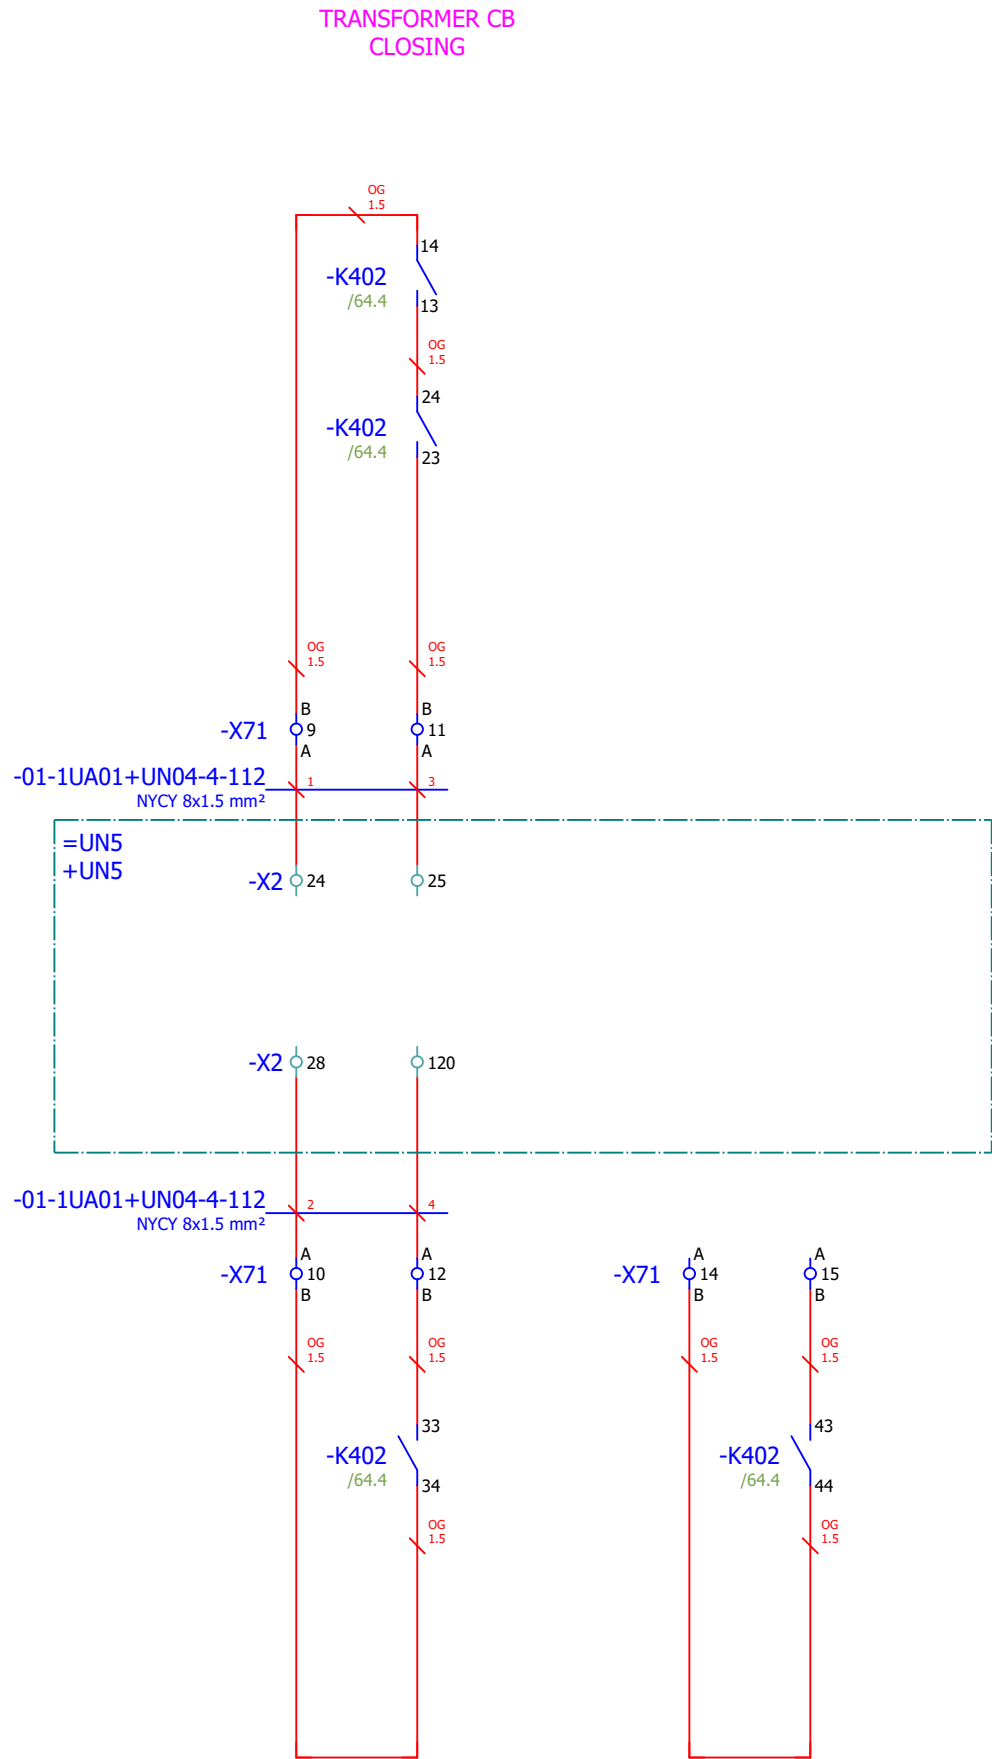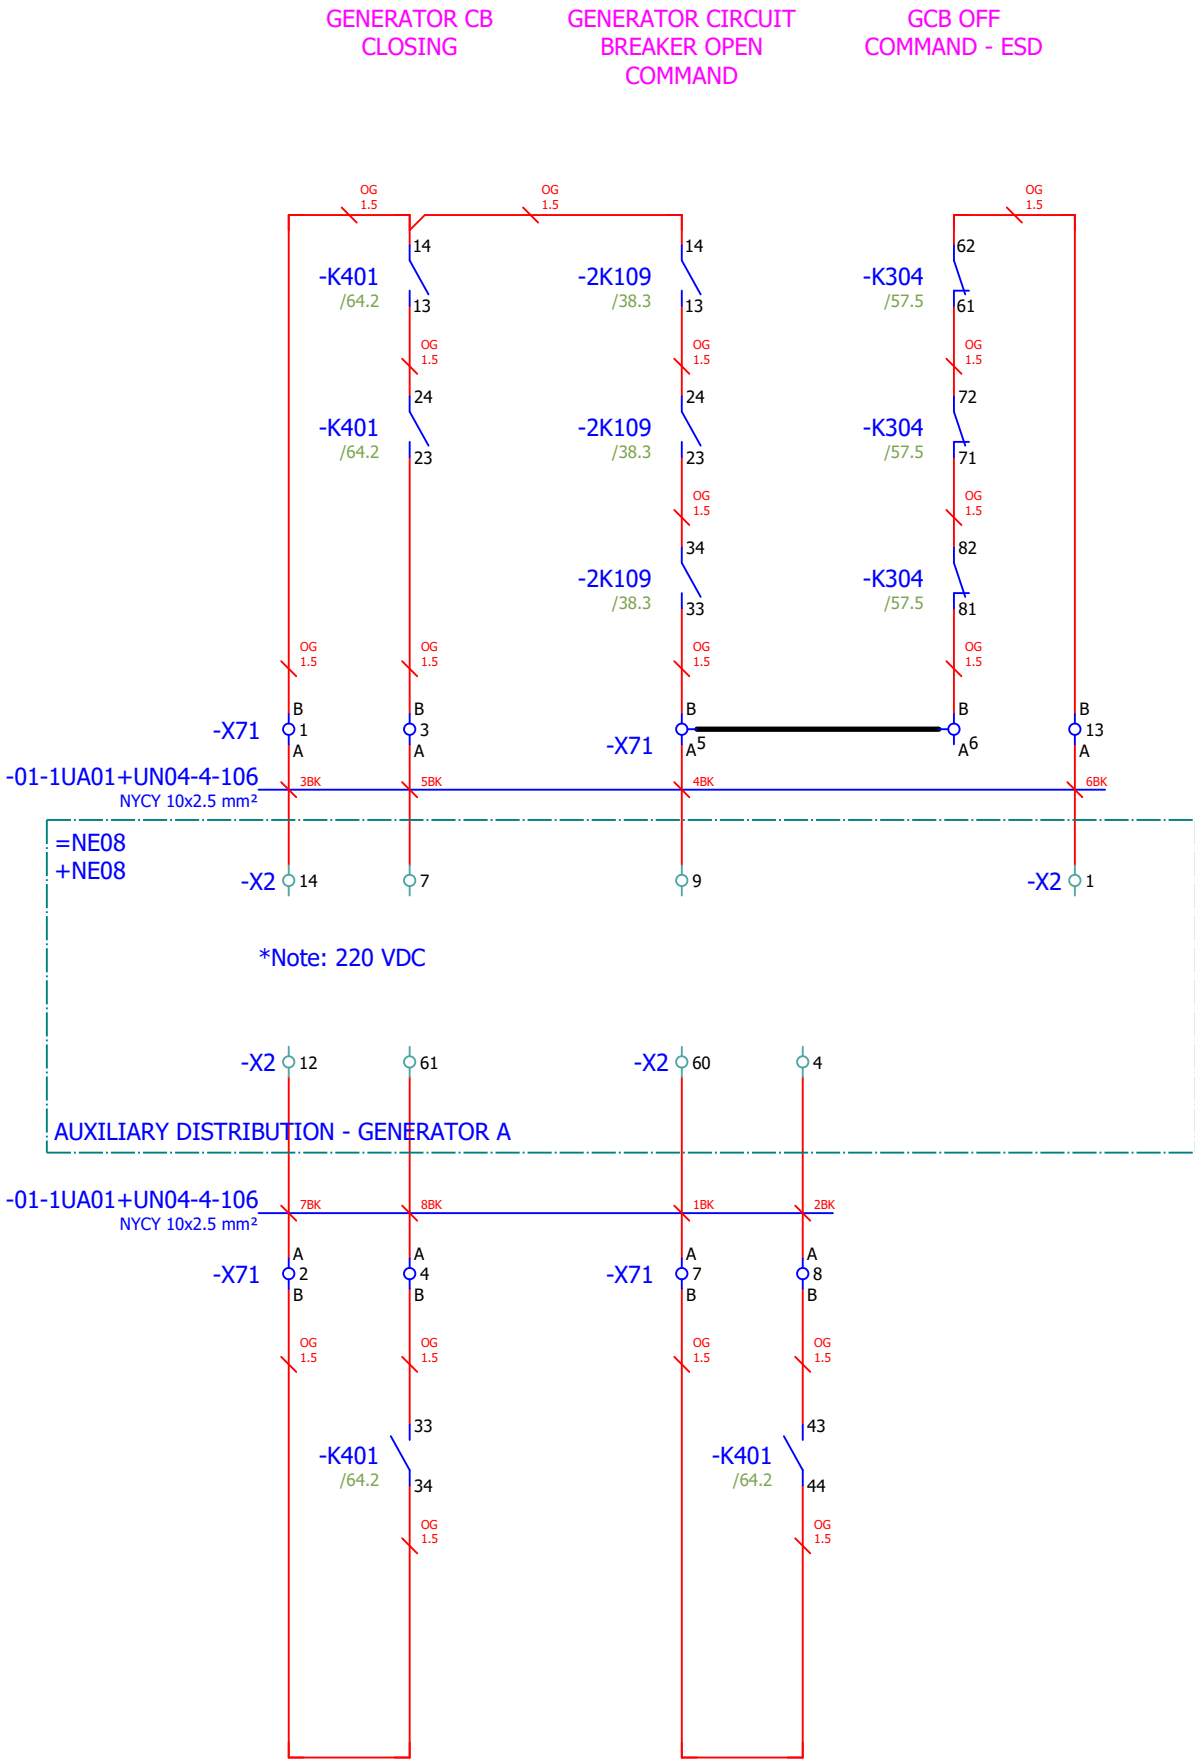


CONFIDENTIAL, ALL RIGHTS RESERVED DIN 34

Format ISO/DIN A3


54

Approved by Contractor			Reconstruction and Modernisation of HPP Perucica - Phase II		 A Voith Company Sintaksa - A Voith Company Ulica Domovinskog rata 104C, 21 000 Split, Hrvatska	Unit KA1 control cubicle circuit diagrams EXCITATION CB TRIP COMMAND	DRAWING No.: PERU-01-19-170-31-001		REV No.: 02	= UACJA10GH100 + UACJA10	
Approved by Designer	Grga Kolić	01.10.2026.					Designer No.:		SALES No.:	PAGE	55
Checked by	Antonio Aleksić	01.10.2026.								PAGE	55 / 156
Drawn by	Tamara Trogrlić	01.10.2026.									

1	2	3	4	5	6	7	8
---	---	---	---	---	---	---	---

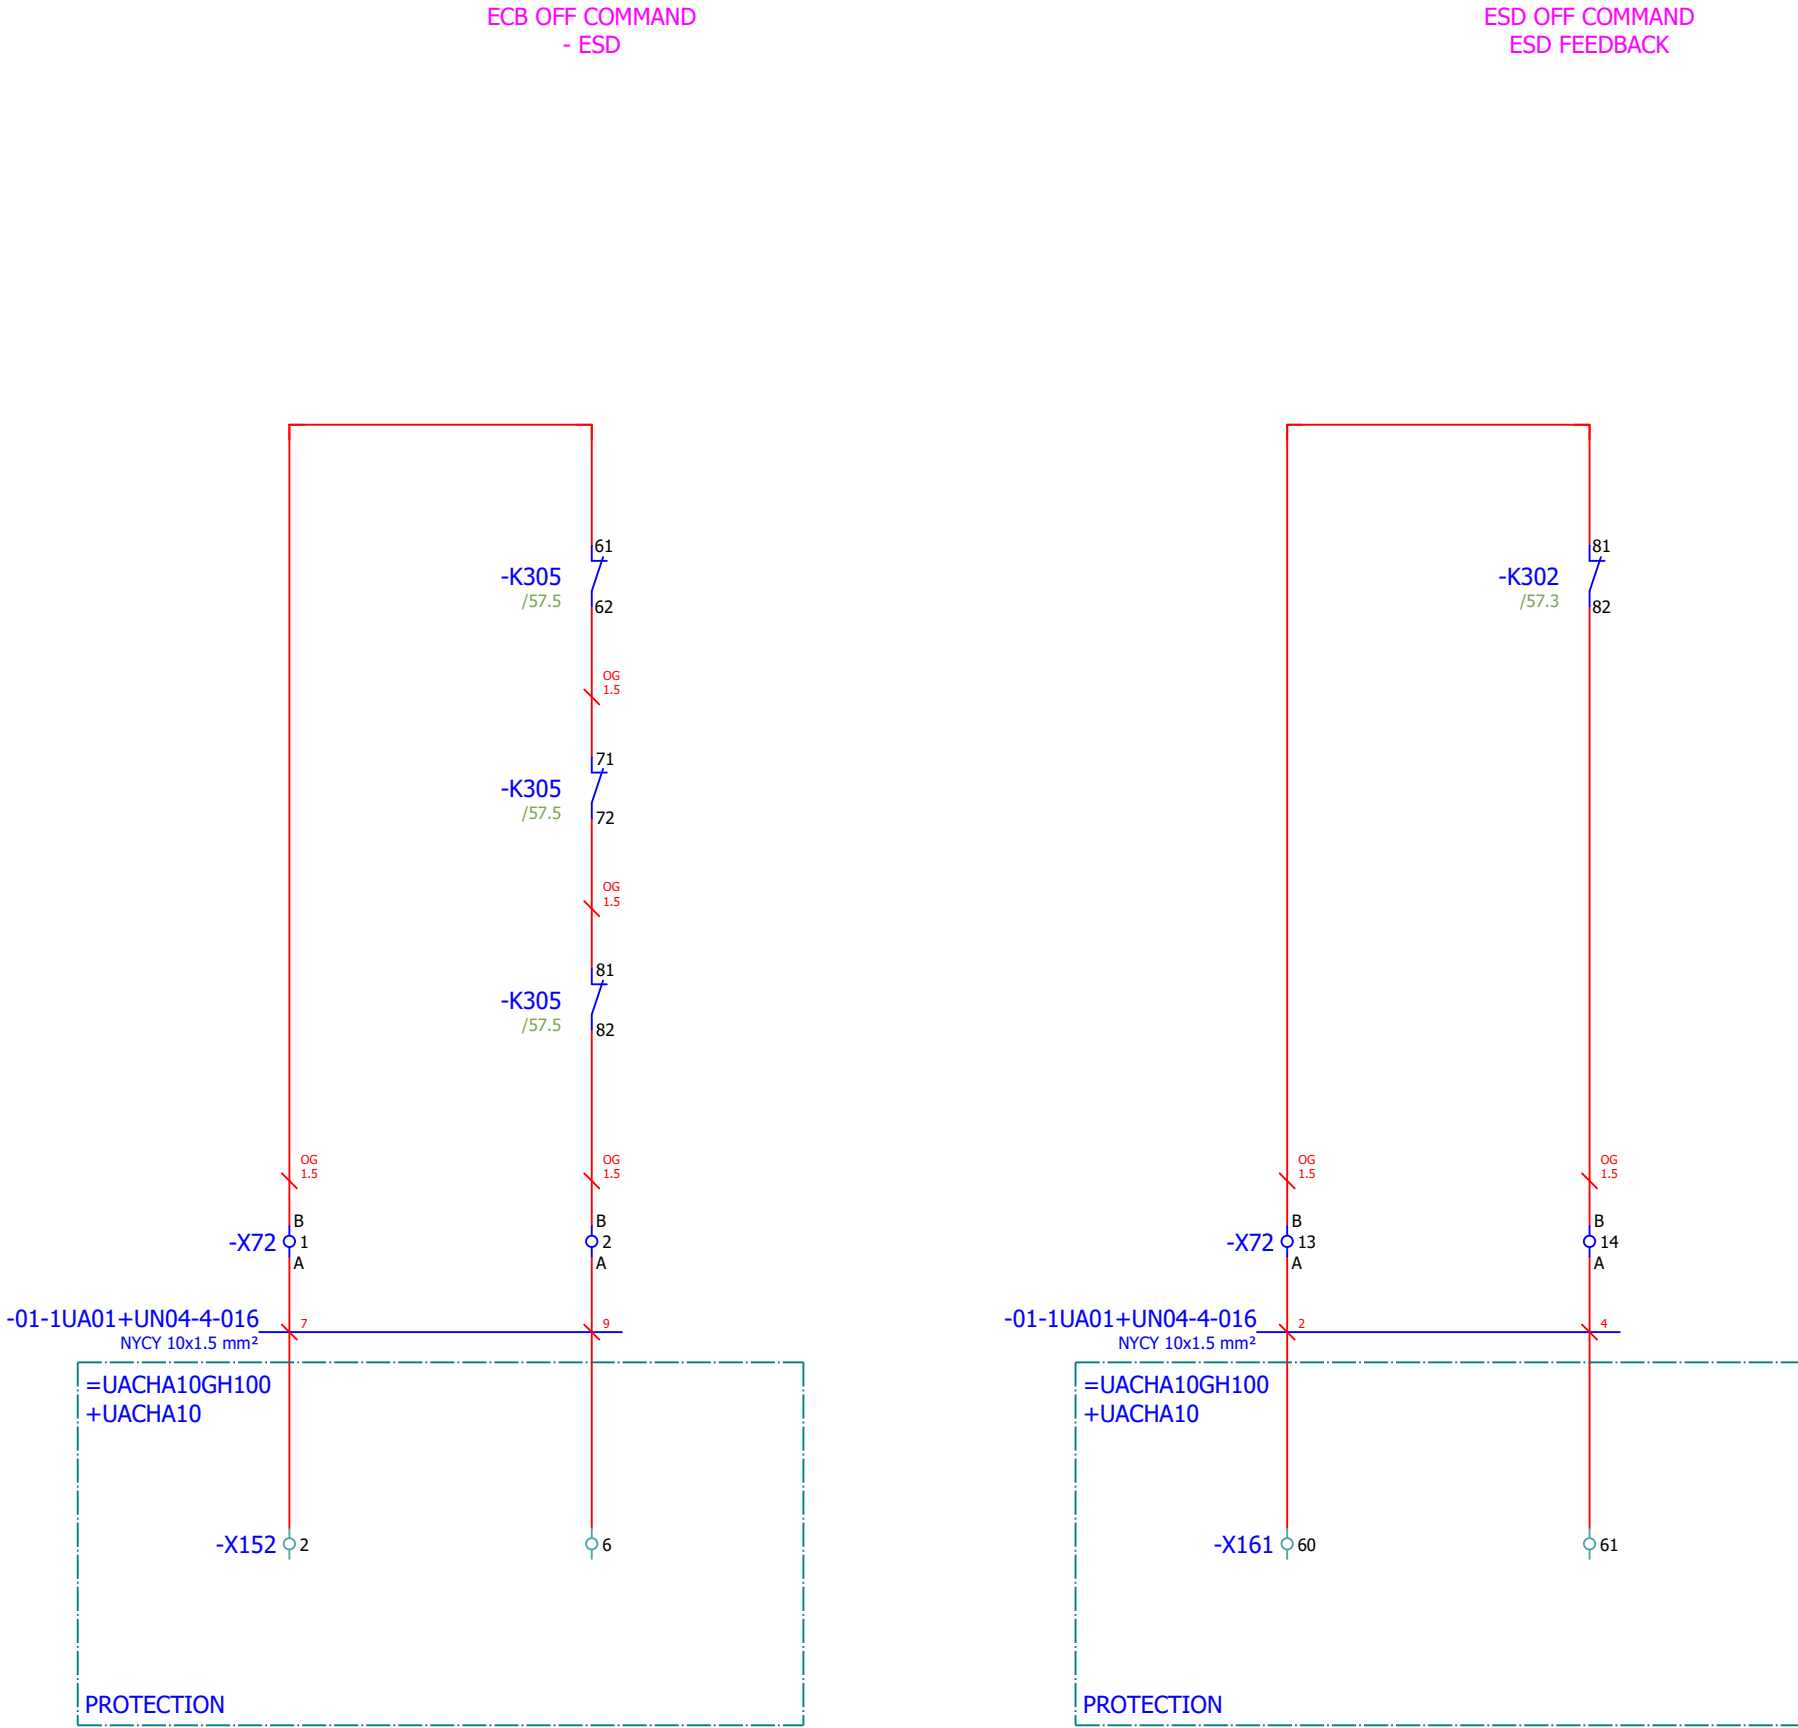

56

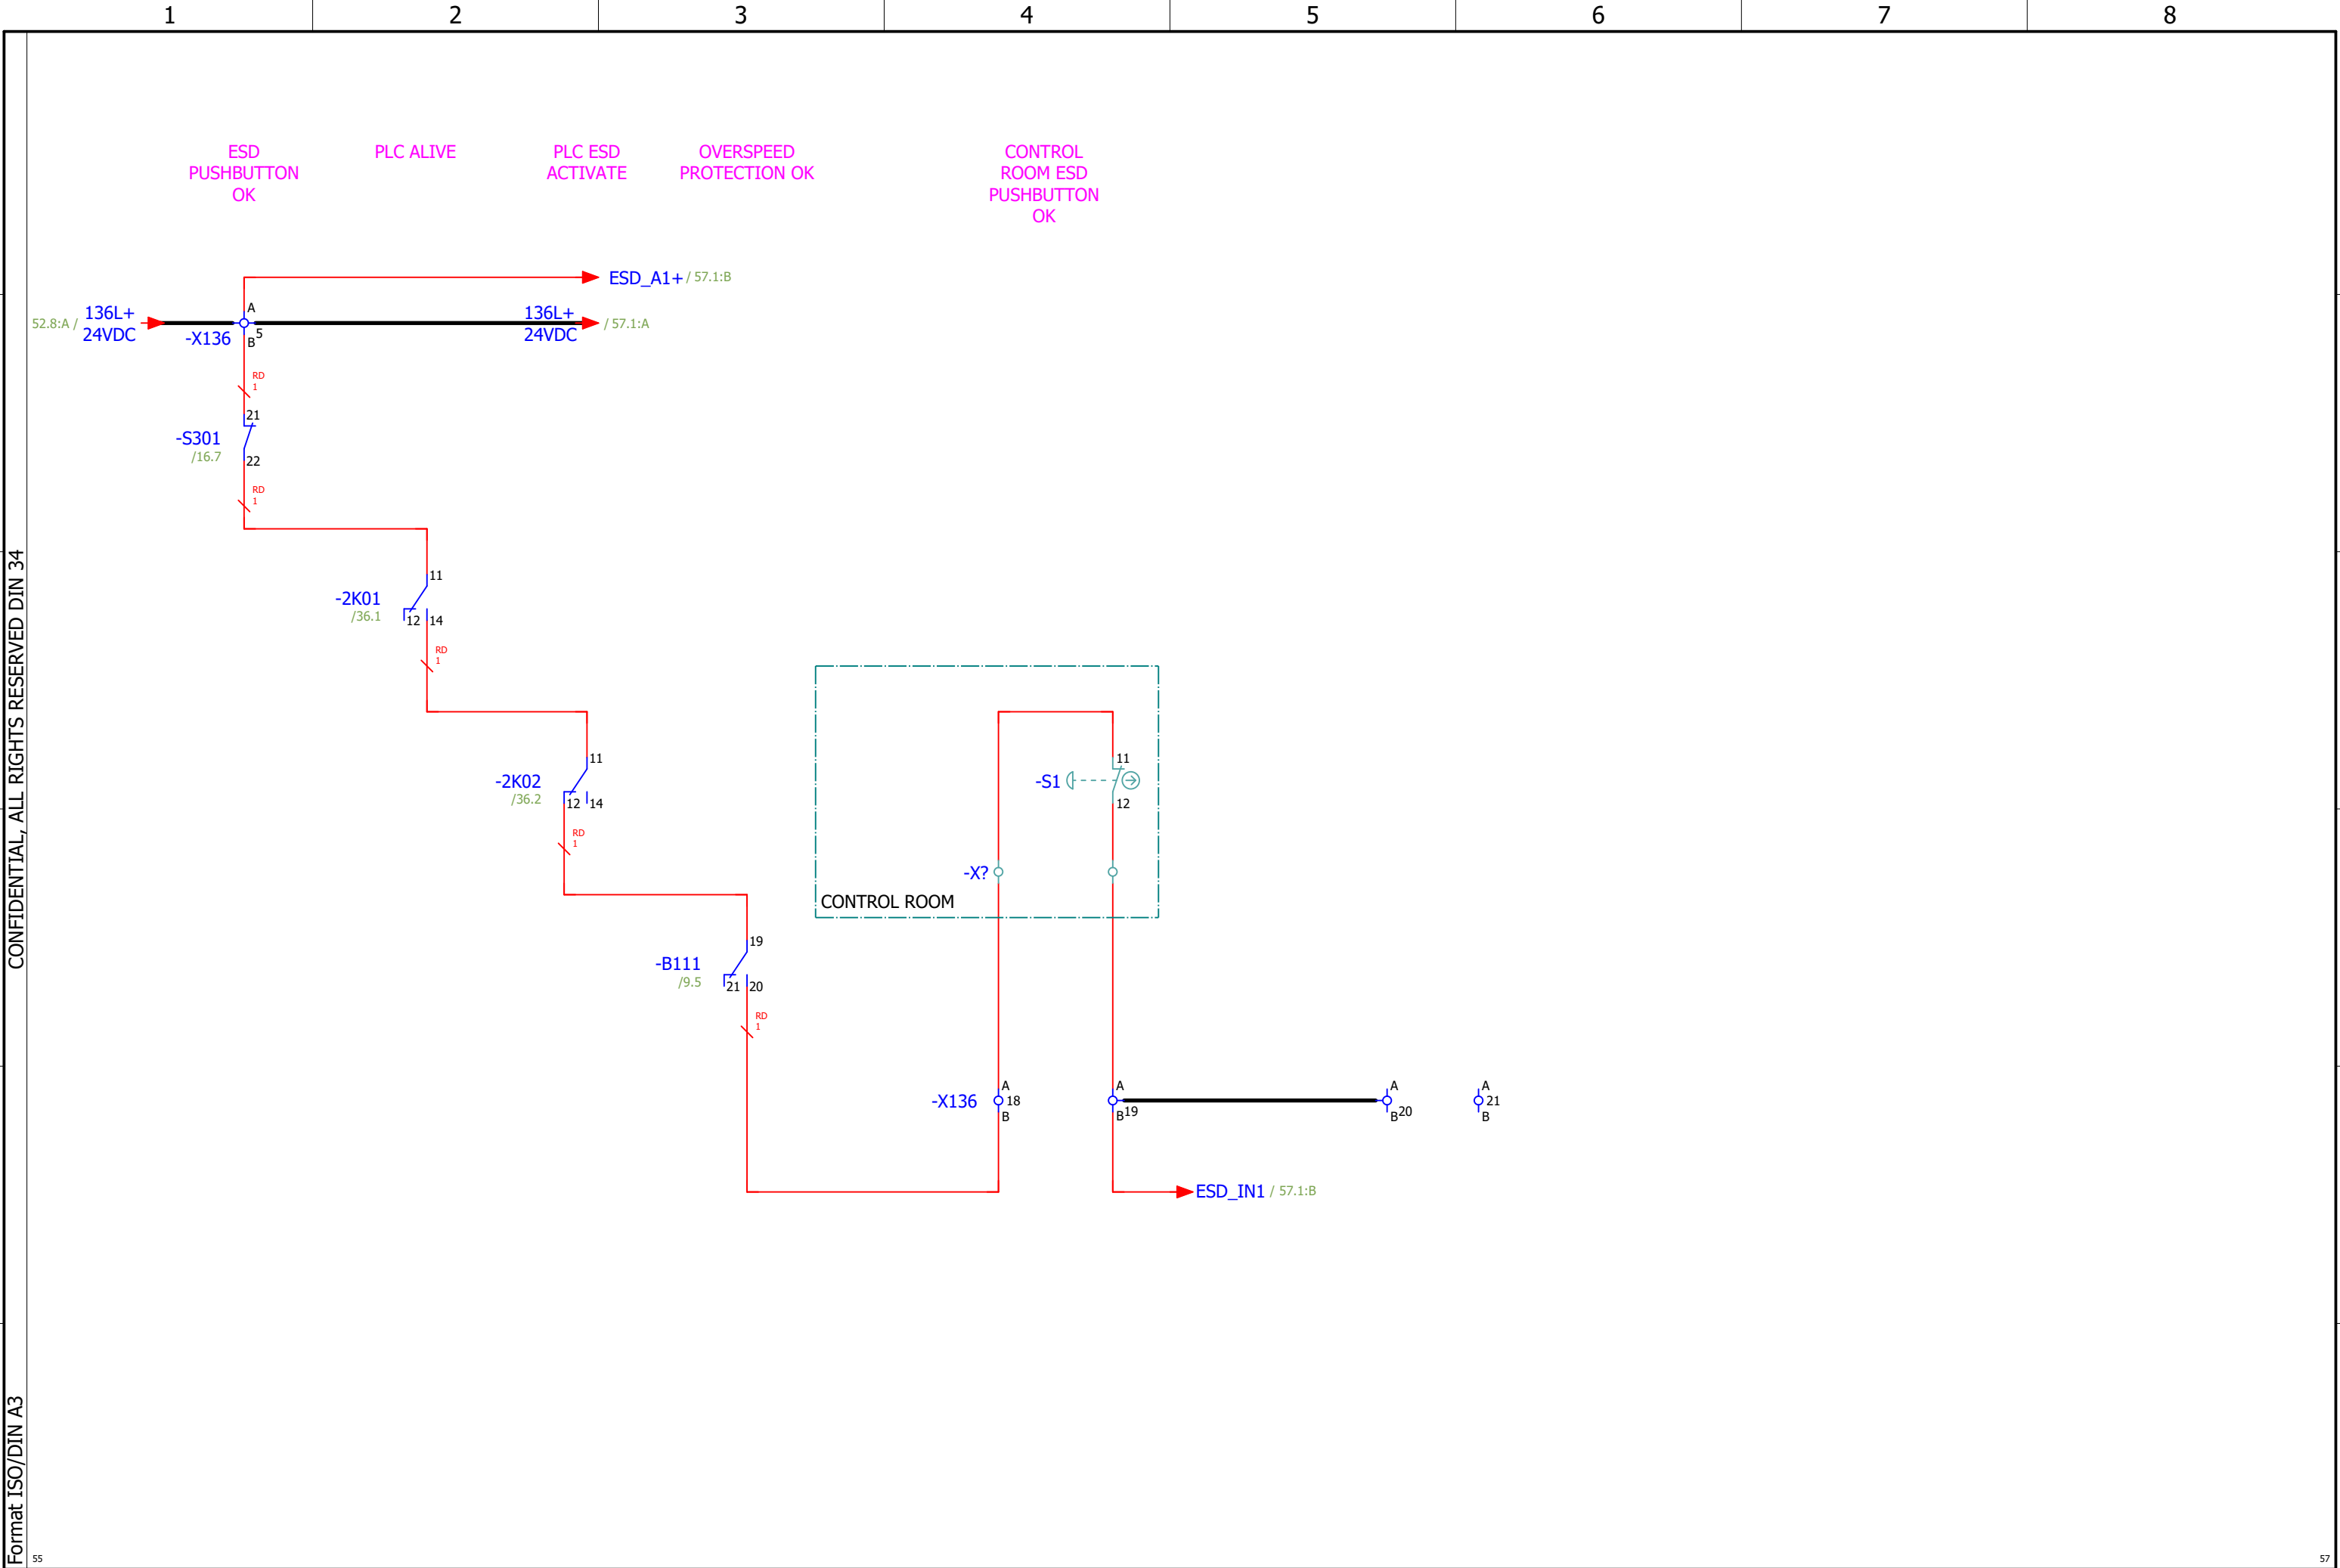

Approved by Contractor			Reconstruction and Modernisation of HPP Perucica - Phase II		 A Voith Company Sintaksa - A Voith Company Ulica Domovinskog rata 104C, 21 000 Split, Hrvatska	Unit KA1 control cubicle circuit diagrams EMERGENCY SHUTDOWN	DRAWING No.: PERU-01-19-170-31-001	REV No.: 02	= UACJA10GH100 + UACJA10
Approved by Designer	Grga Kolić	01.10.2026.					Designer No.:	SALES No.:	PAGE 56
Checked by	Antonio Aleksić	01.10.2026.							
Drawn by	Tamara Trogrlić	01.10.2026.							PAGE 56 / 156
1	2	3	4	5	6	7	8		


CONFIDENTIAL, ALL RIGHTS RESERVED DIN 34

Format ISO/DIN A3

56

Approved by Contractor			Reconstruction and Modernisation of HPP Perucica - Phase II		 A Voith Company Sintaksa - A Voith Company Ulica Domovinskog rata 104C, 21 000 Split, Hrvatska	Unit KA1 control cubicle circuit diagrams EMERGENCY SHUTDOWN	DRAWING No.: PERU-01-19-170-31-001	REV No.: 02	= UACJA10GH100 + UACJA10
Approved by Designer	Grga Kolić	01.10.2026.					Designer No.:	SALES No.:	PAGE 57
Checked by	Antonio Aleksić	01.10.2026.							PAGE 57 / 156
Drawn by	Tamara Trogrlić	01.10.2026.							


1	2	3	4	5	6	7	8
---	---	---	---	---	---	---	---

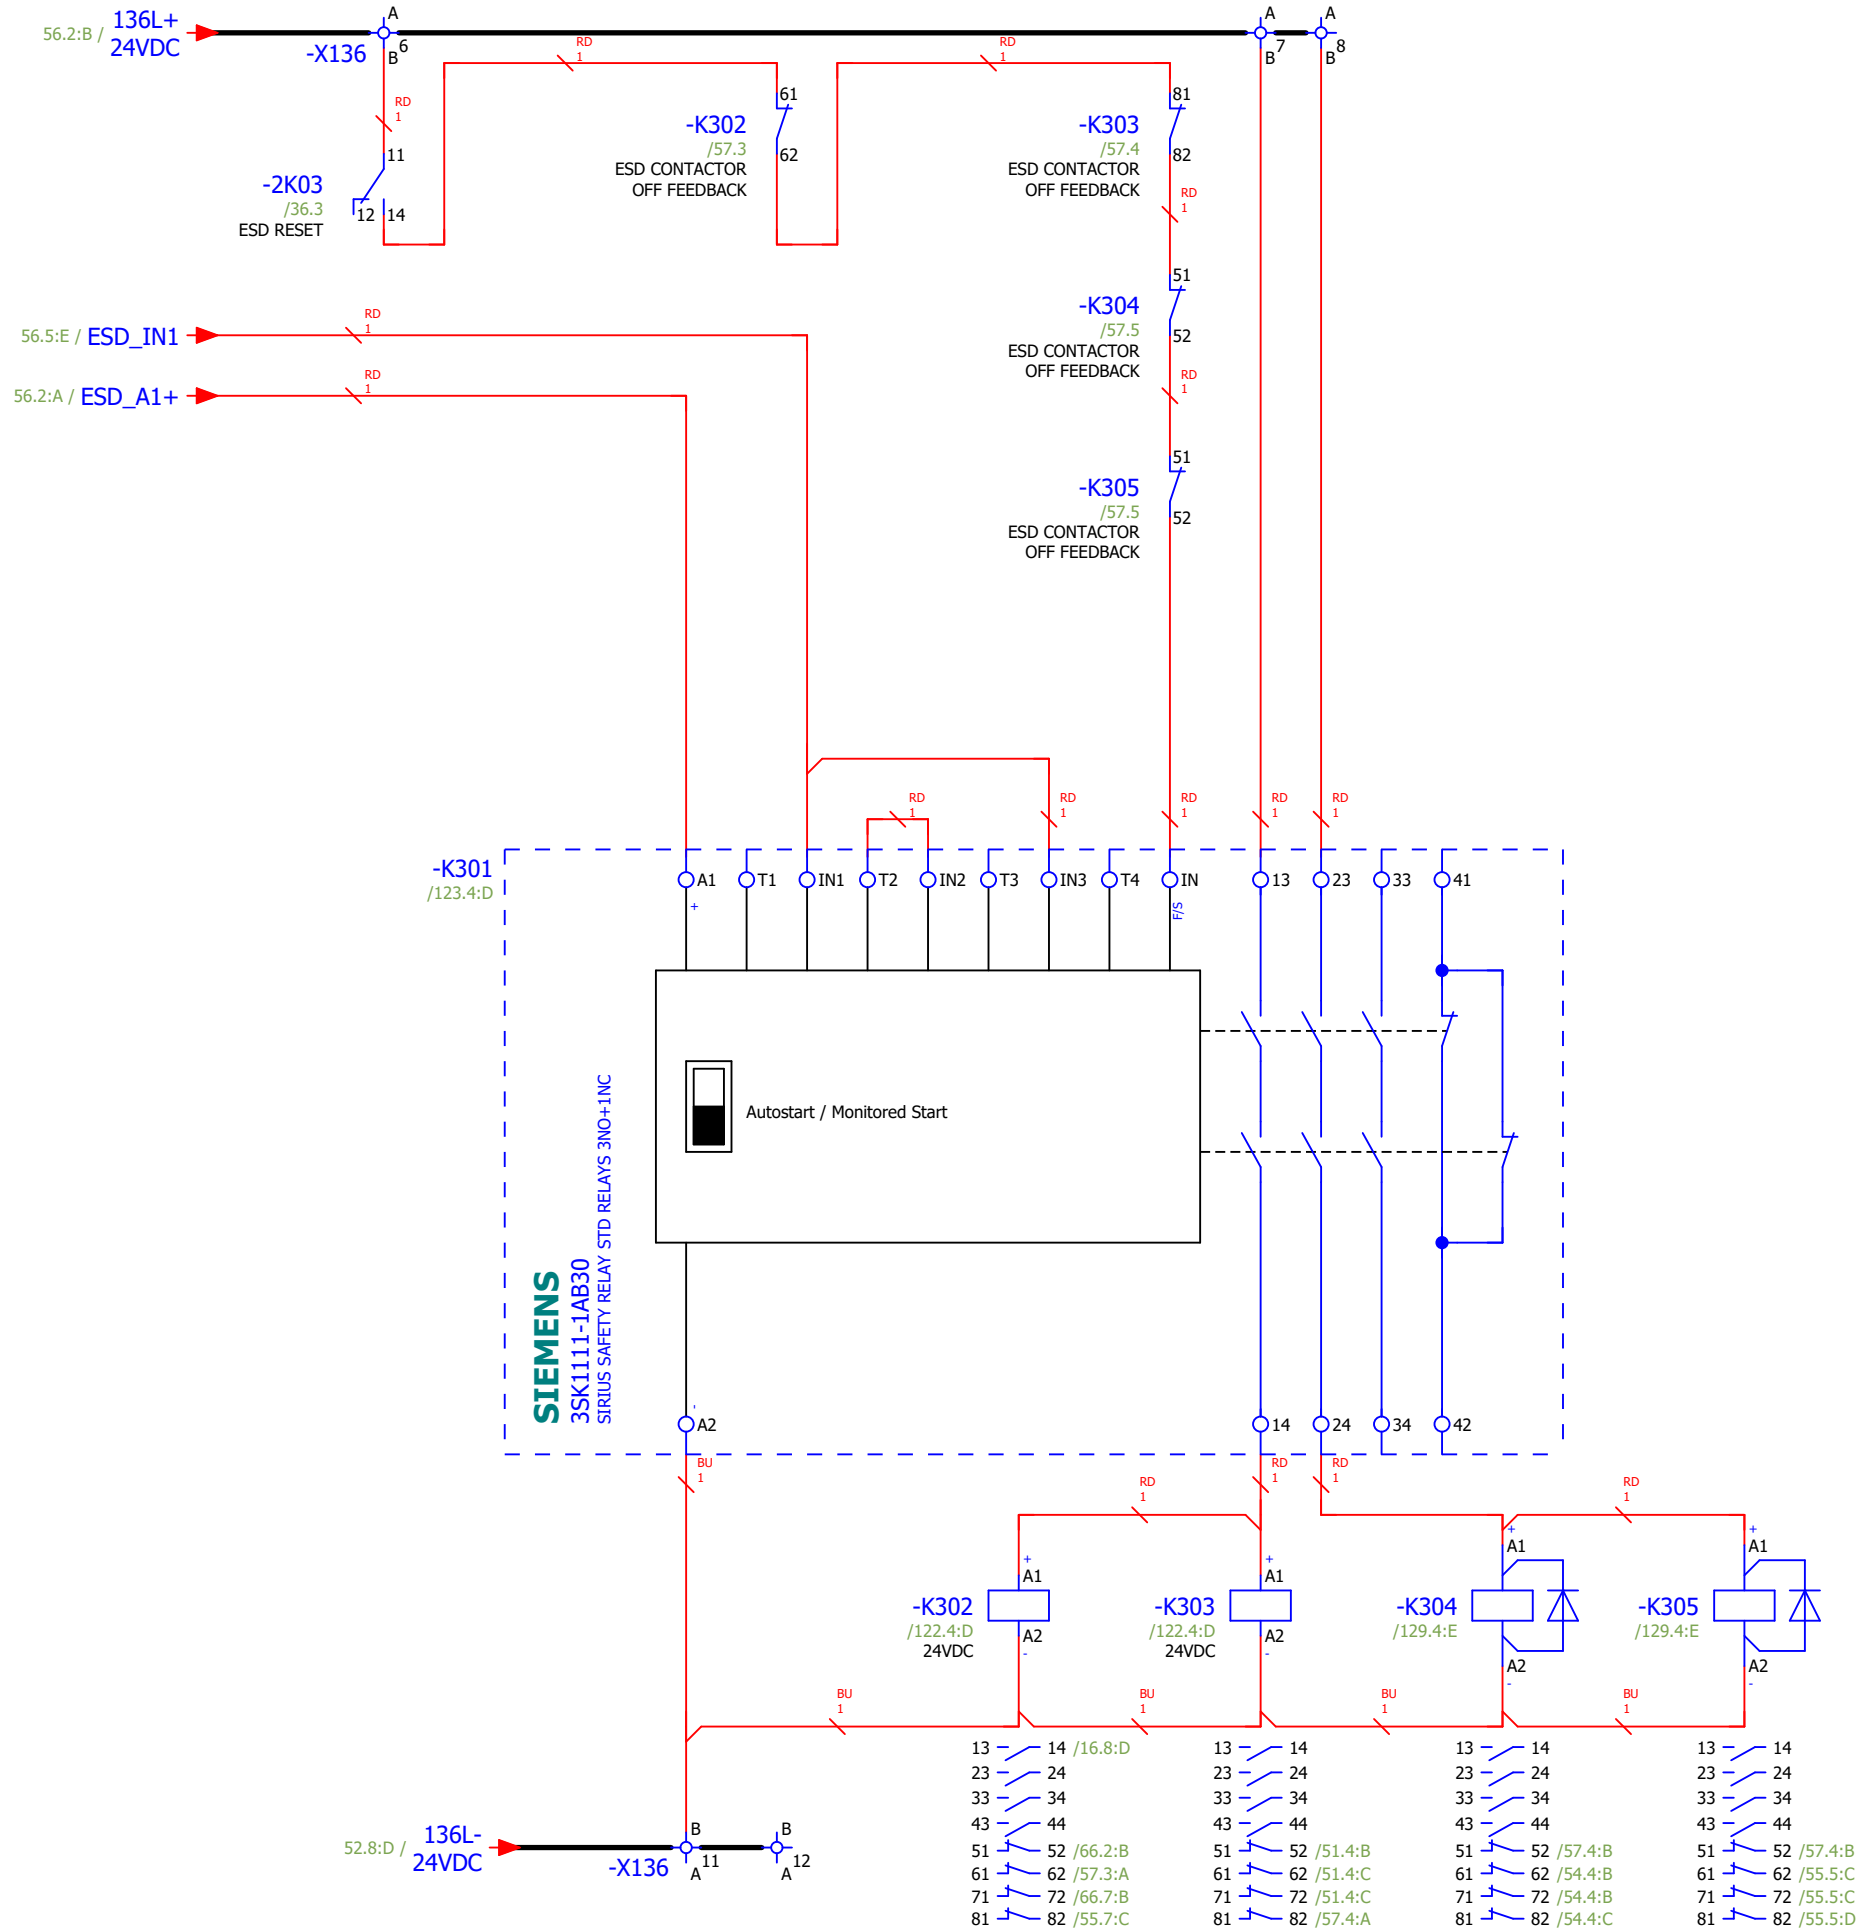

58

CONFIDENTIAL, ALL RIGHTS RESERVED DIN 34


Format ISO/DIN A3

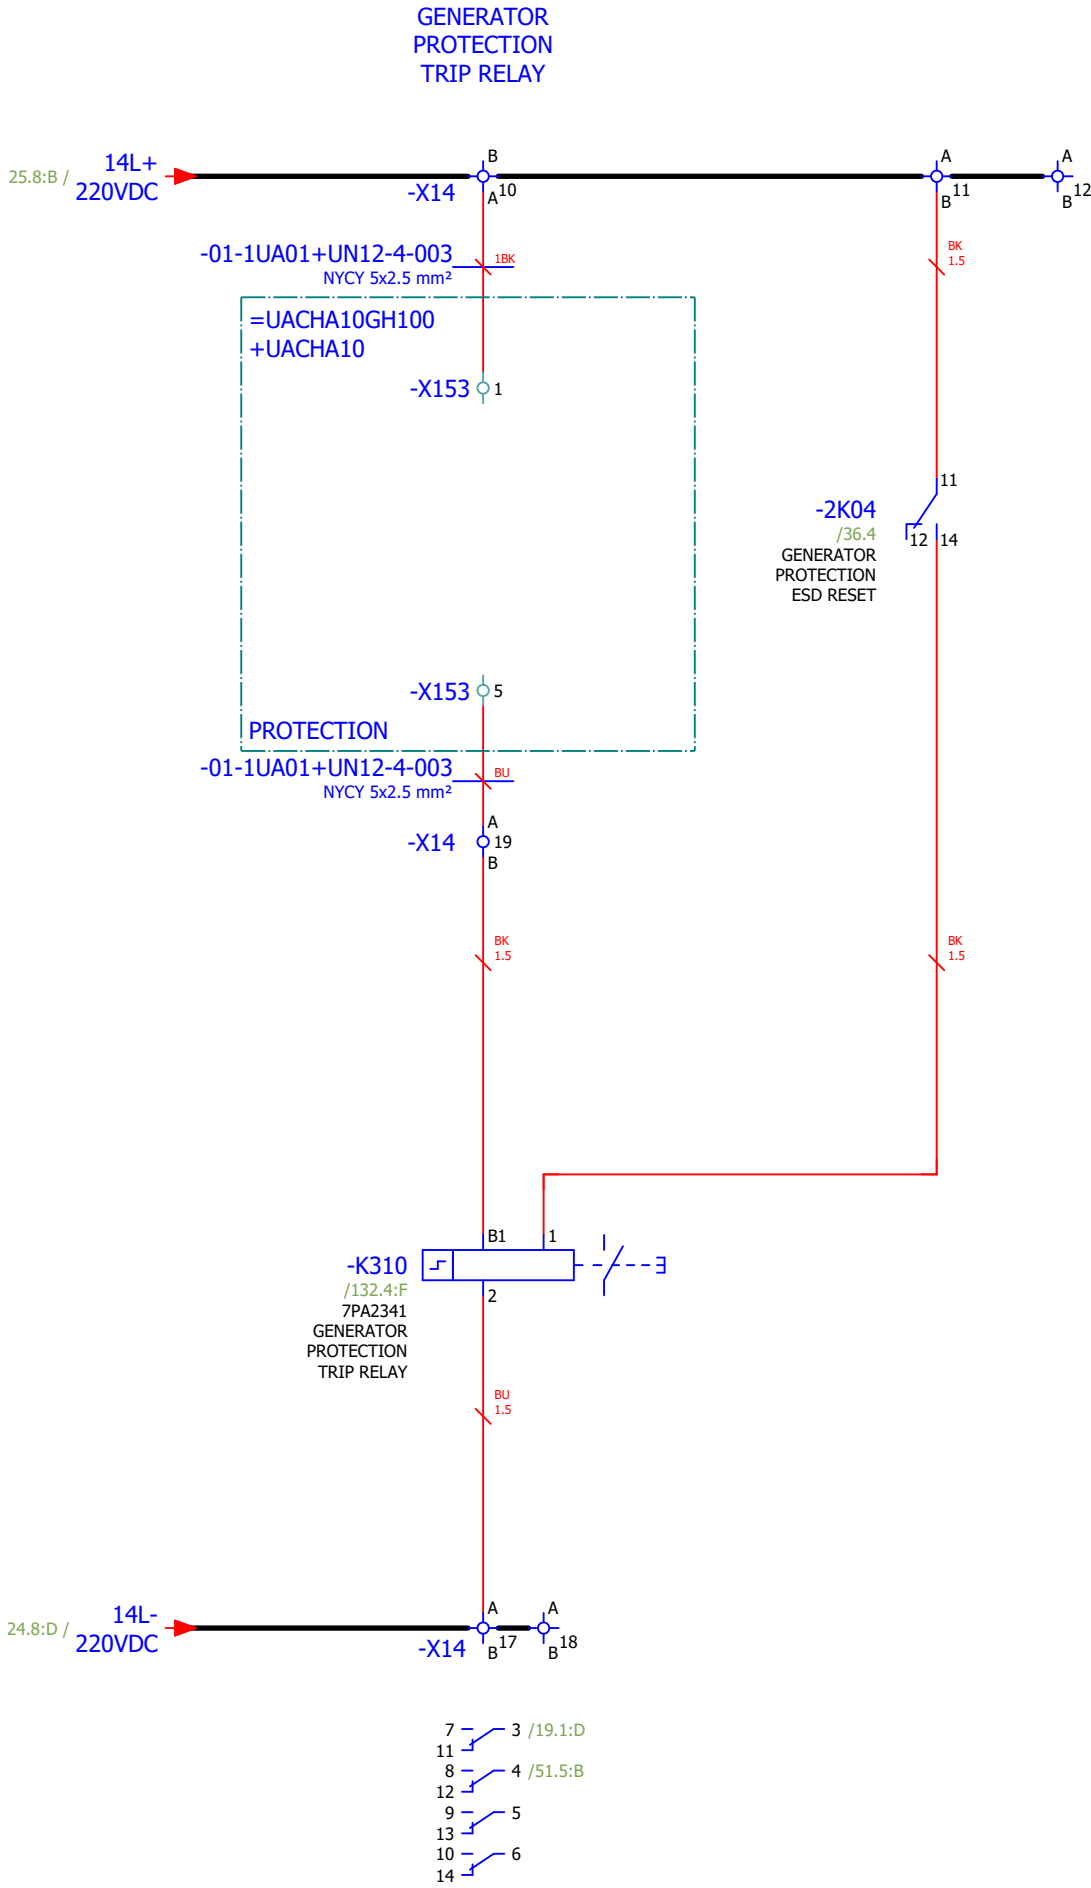

Approved by Contractor			Reconstruction and Modernisation of HPP Perucica - Phase II		 A Voith Company Sintaksa - A Voith Company Ulica Domovinskog rata 104C, 21 000 Split, Hrvatska	Unit KA1 control cubicle circuit diagrams GENERATOR PROTECTION ESD	DRAWING No.: PERU-01-19-170-31-001	REV No.: 02	= UACJA10GH100 + UACJA10
Approved by Designer	Grga Kolić	01.10.2026.					Designer No.:	SALES No.:	PAGE 58
Checked by	Antonio Aleksić	01.10.2026.							
Drawn by	Tamara Trogrlić	01.10.2026.							PAGE 58 / 156

Format ISO/DIN A3
58
CONFIDENTIAL, ALL RIGHTS RESERVED DIN 34

Approved by Contractor			Reconstruction and Modernisation of HPP Perucica - Phase II		 A Voith Company Sintaksa - A Voith Company Ulica Domovinskog rata 104C, 21 000 Split, Hrvatska	Unit KA1 control cubicle circuit diagrams SYNCHRONIZATION CONTROL	DRAWING No.: PERU-01-19-170-31-001	REV No.: 02	= UACJA10GH100 + UACJA10
Approved by Designer	Grga Kolić	01.10.2026.					Designer No.:	SALES No.:	PAGE 59
Checked by	Antonio Aleksić	01.10.2026.							
Drawn by	Tamara Trogrlić	01.10.2026.							PAGE 59 / 156

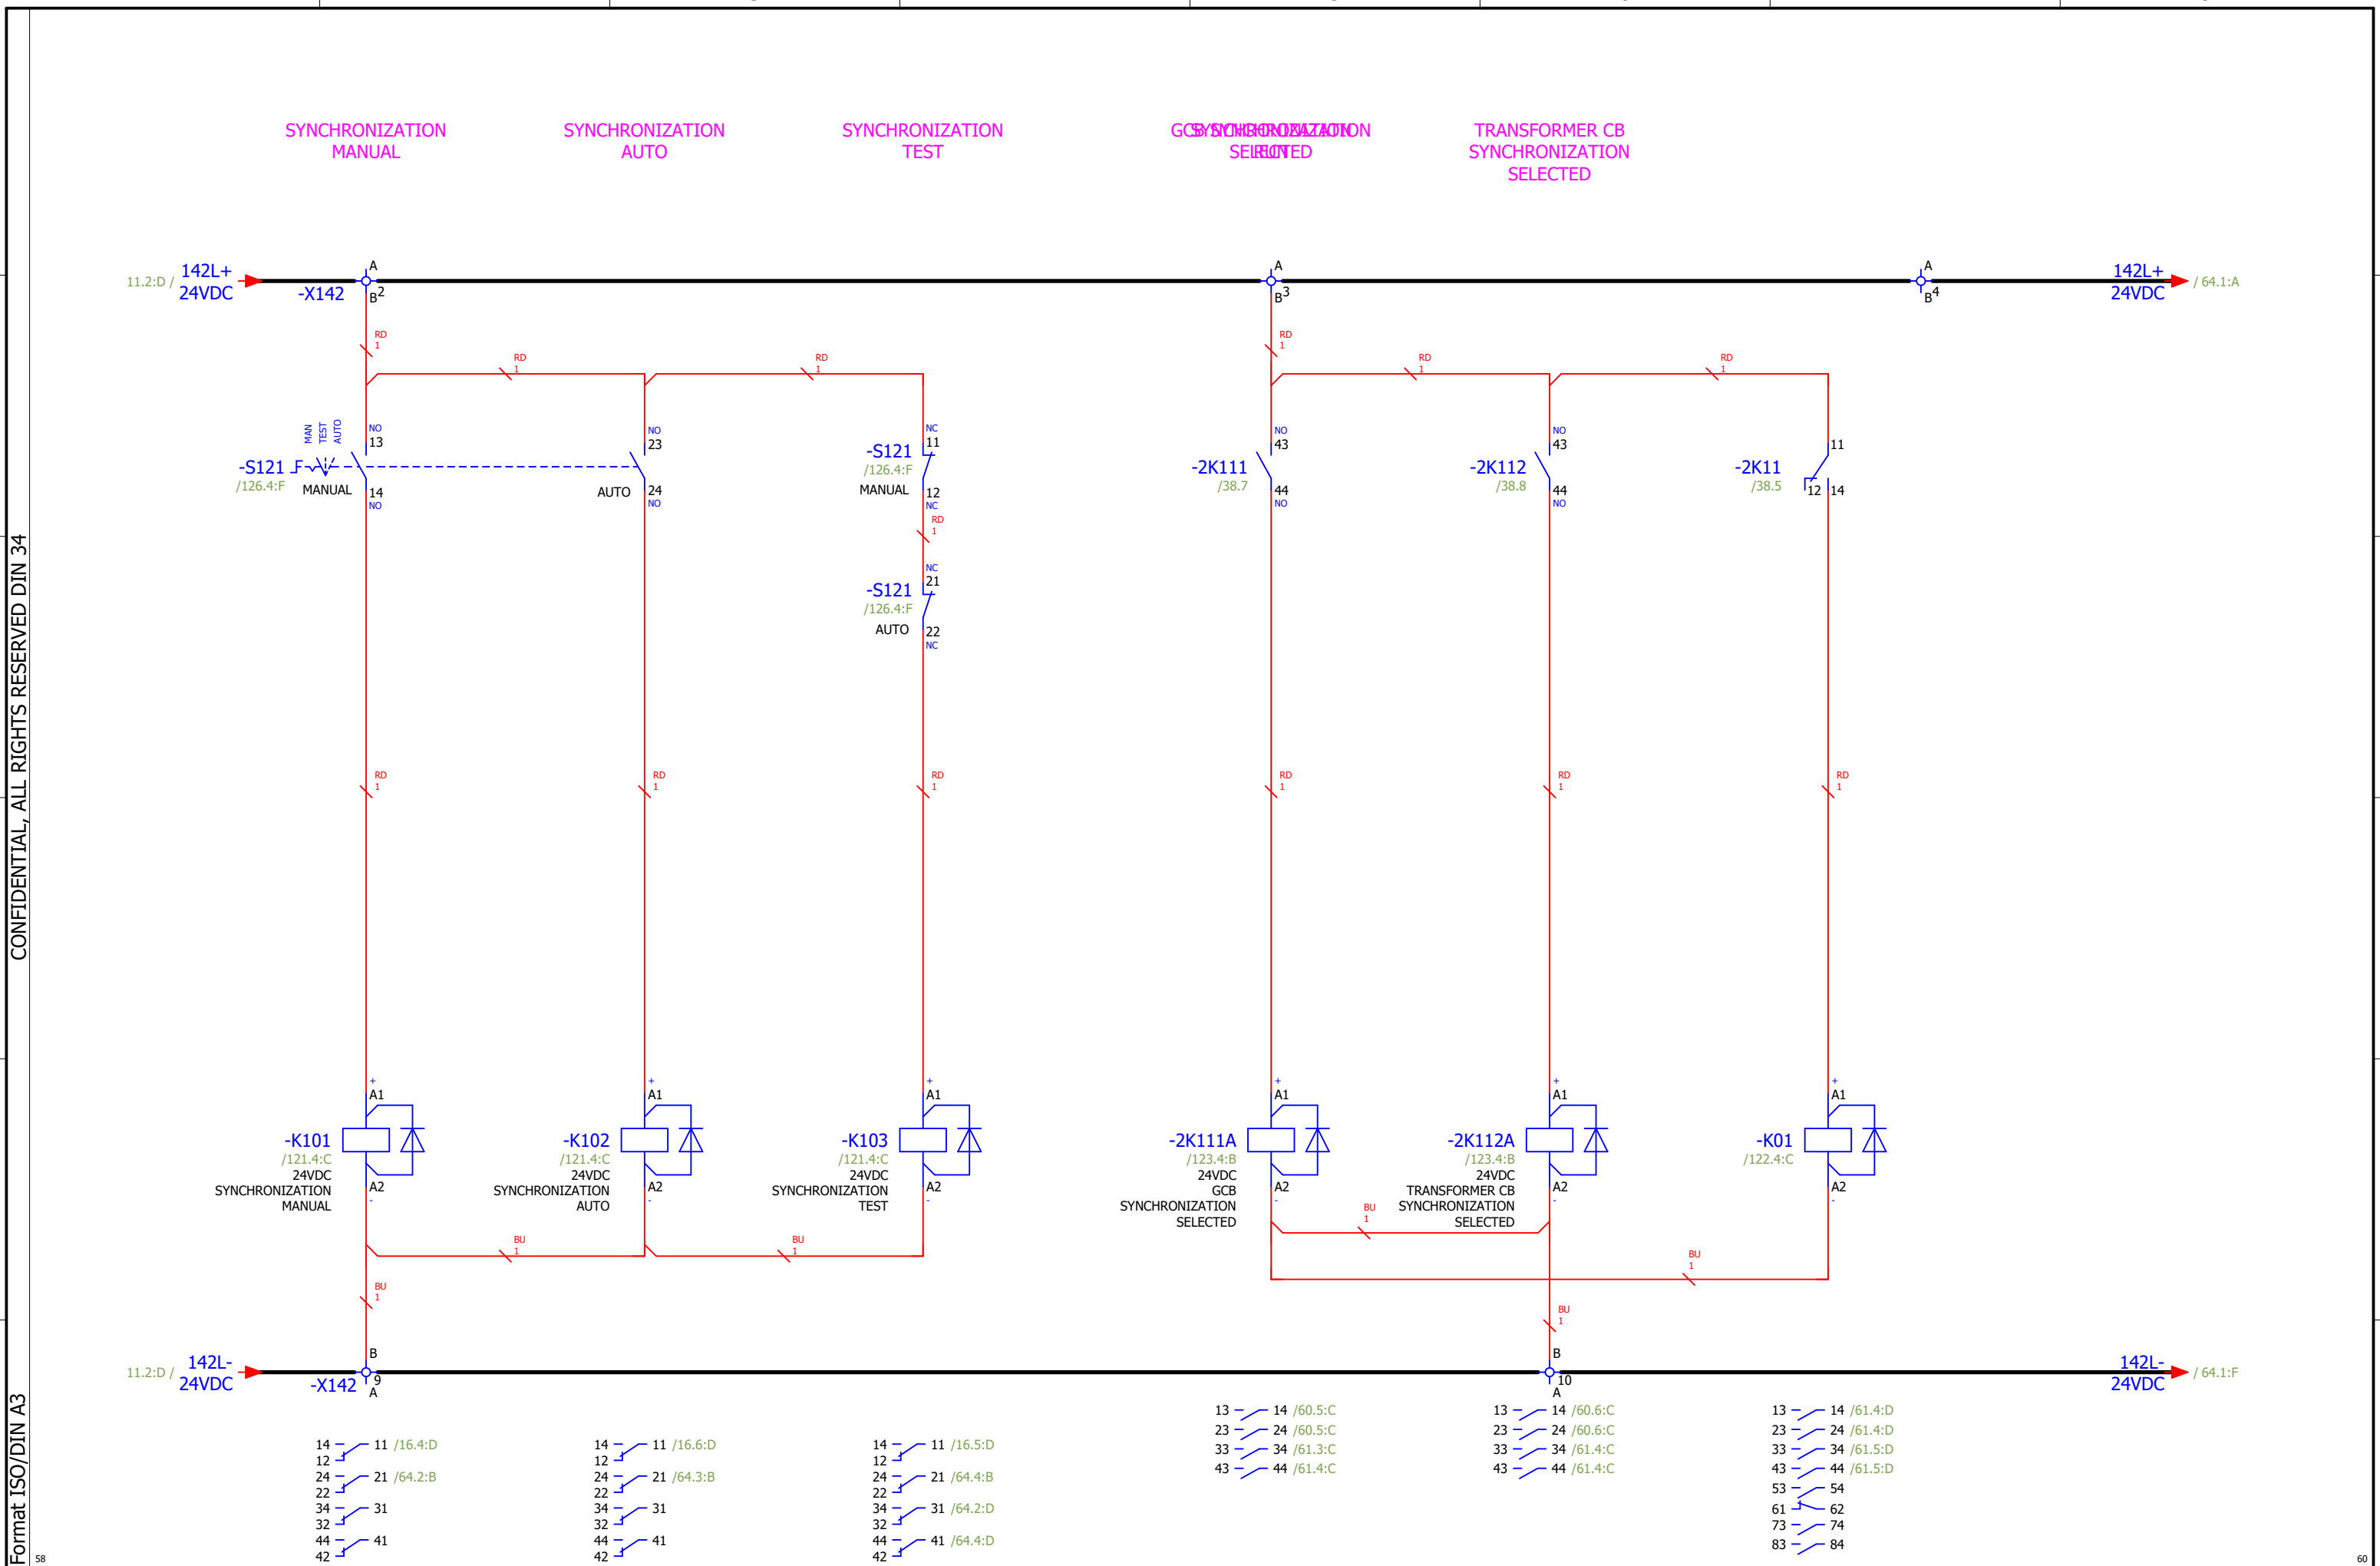

CONFIDENTIAL, ALL RIGHTS RESERVED DIN 34


Format ISO/DIN A3

59

61

Approved by Contractor			Reconstruction and Modernisation of HPP Perucica - Phase II		 A Voith Company Sintaksa - A Voith Company Ulica Domovinskog rata 104C, 21 000 Split, Hrvatska	Unit KA1 control cubicle circuit diagrams SYNCHRONIZATION CONTROL	DRAWING No.: PERU-01-19-170-31-001	REV No.: 02	= UACJA10GH100 + UACJA10
Approved by Designer	Grga Kolić	01.10.2026.					Designer No.:	SALES No.:	PAGE 60
Checked by	Antonio Aleksić	01.10.2026.							
Drawn by	Tamara Trogrlić	01.10.2026.							PAGE 60 / 156

SYNCHRONIZER
VOLTAGE MEASUREMENT

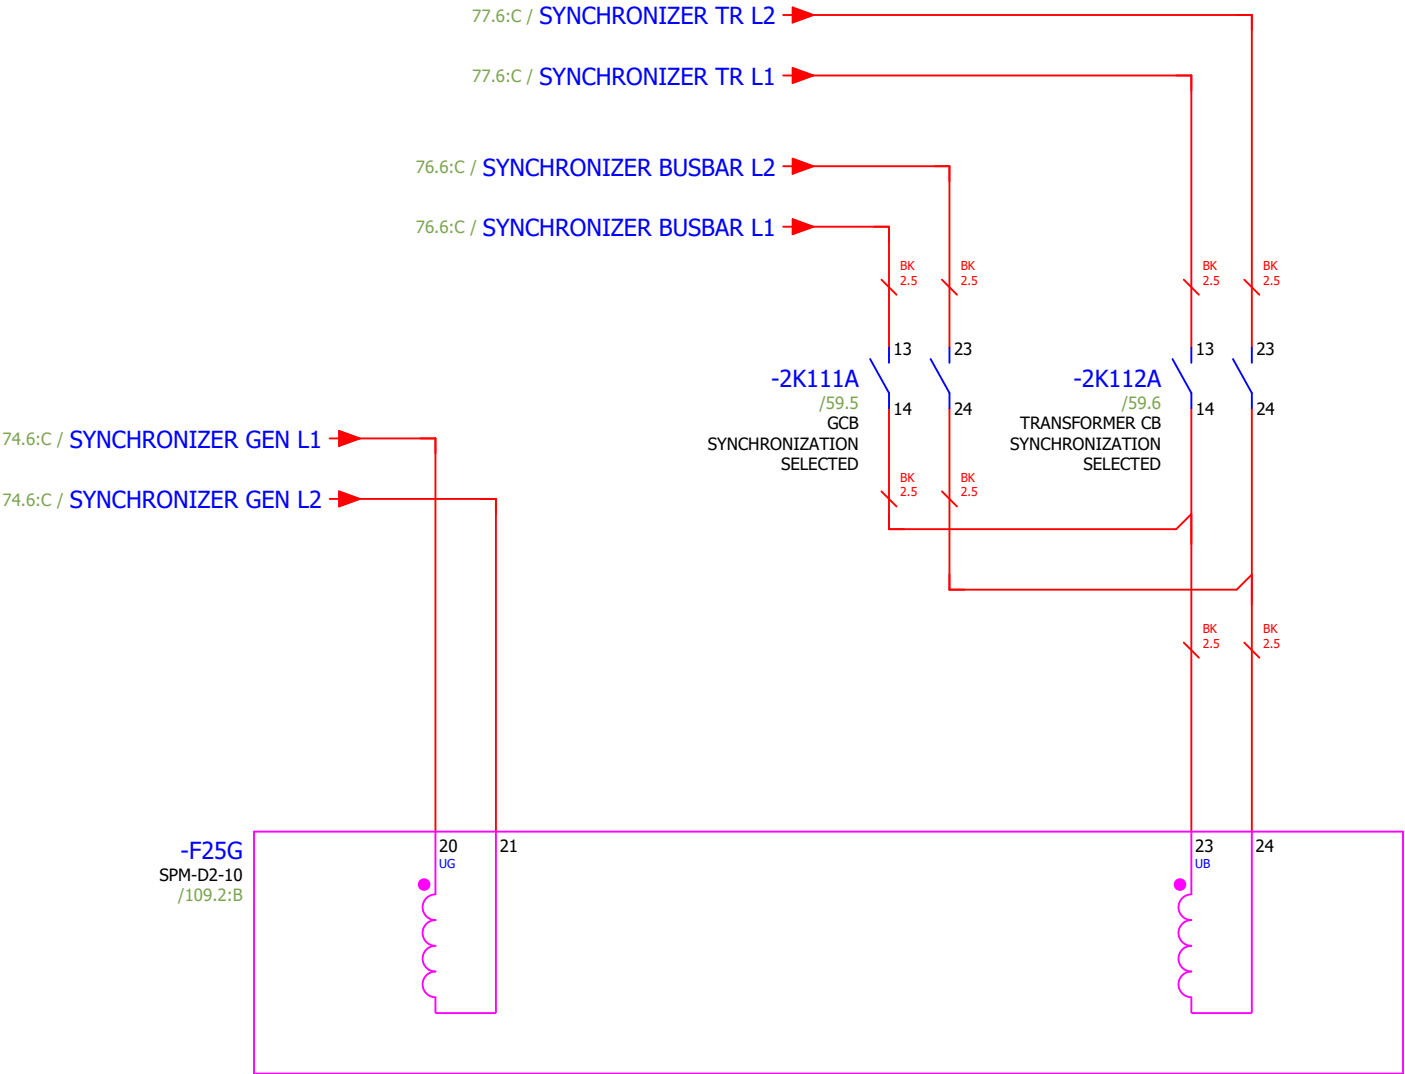

CONFIDENTIAL, ALL RIGHTS RESERVED DIN 34


Format ISO/DIN A3

60

62

Approved by Contractor			Reconstruction and Modernisation of HPP Perucica - Phase II		 A Voith Company Sintaksa - A Voith Company Ulica Domovinskog rata 104C, 21 000 Split, Hrvatska	Unit KA1 control cubicle circuit diagrams SYNCHRONIZATION	DRAWING No.: PERU-01-19-170-31-001	REV No.: 02	= UACJA10GH100 + UACJA10	
Approved by Designer	Grga Kolić	01.10.2026.					Designer No.:	SALES No.:	PAGE 61	PAGE 61 / 156
Checked by	Antonio Aleksić	01.10.2026.	PROJECT NAME	EMPLOYER	DESIGNER					
Drawn by	Tamara Trogrlić	01.10.2026.								

SYNCHROCHECK
VOLTAGE MEASUREMENT

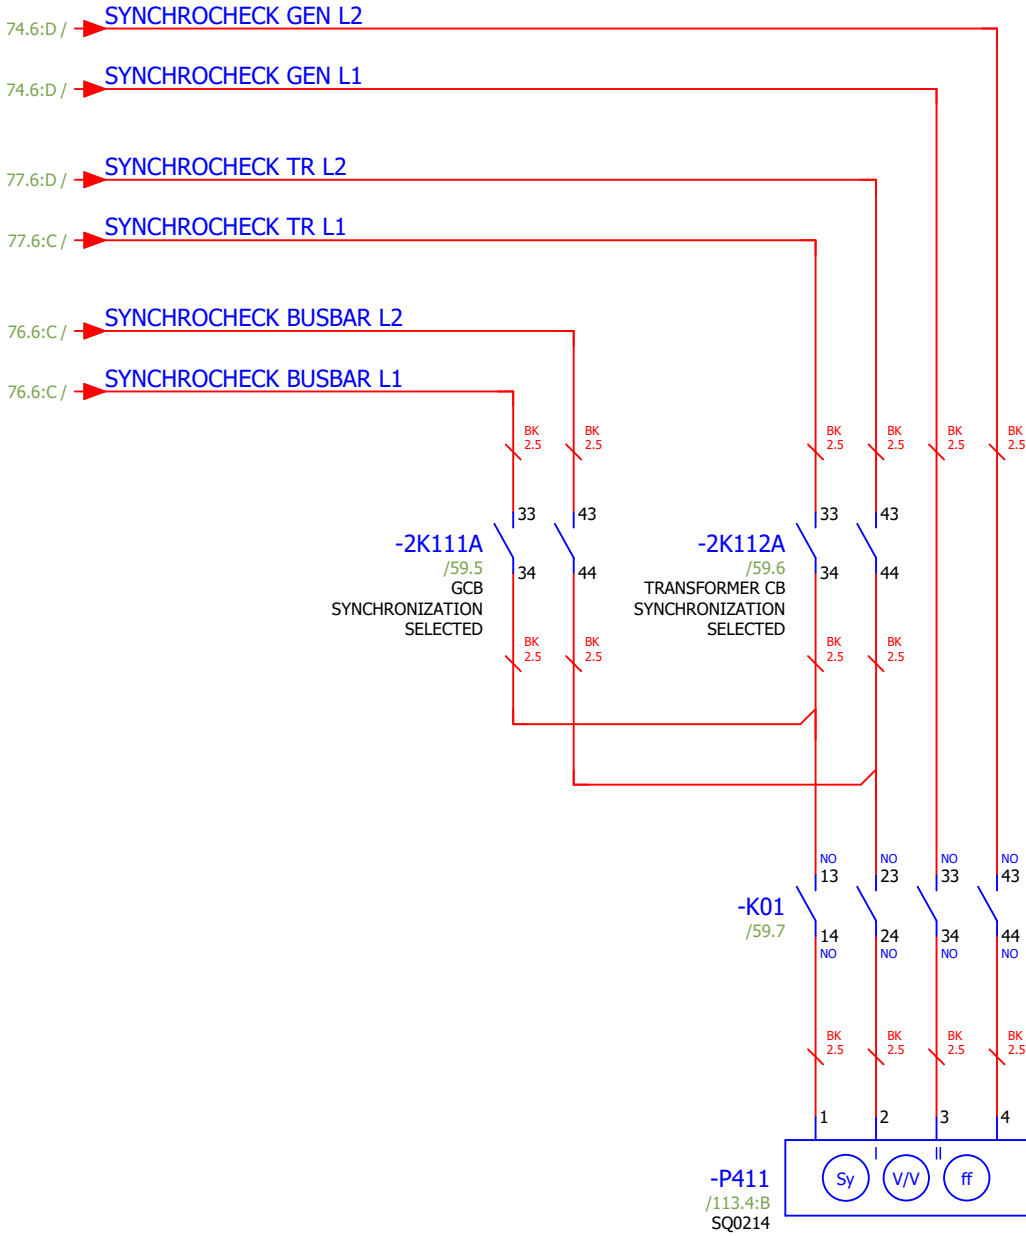


CONFIDENTIAL, ALL RIGHTS RESERVED DIN 34

Format ISO/DIN A3



61

63

Approved by Contractor			Reconstruction and Modernisation of HPP Perucica - Phase II		 A Voith Company Sintaksa - A Voith Company Ulica Domovinskog rata 104C, 21 000 Split, Hrvatska	Unit KA1 control cubicle circuit diagrams SYNCHRONIZATION	DRAWING No.: PERU-01-19-170-31-001	REV No.: 02	= UACJA10GH100 + UACJA10
Approved by Designer	Grga Kolić	01.10.2026.					Designer No.:	SALES No.:	PAGE 62
Checked by	Antonio Aleksić	01.10.2026.							
Drawn by	Tamara Trogrlić	01.10.2026.							PAGE 62 / 156

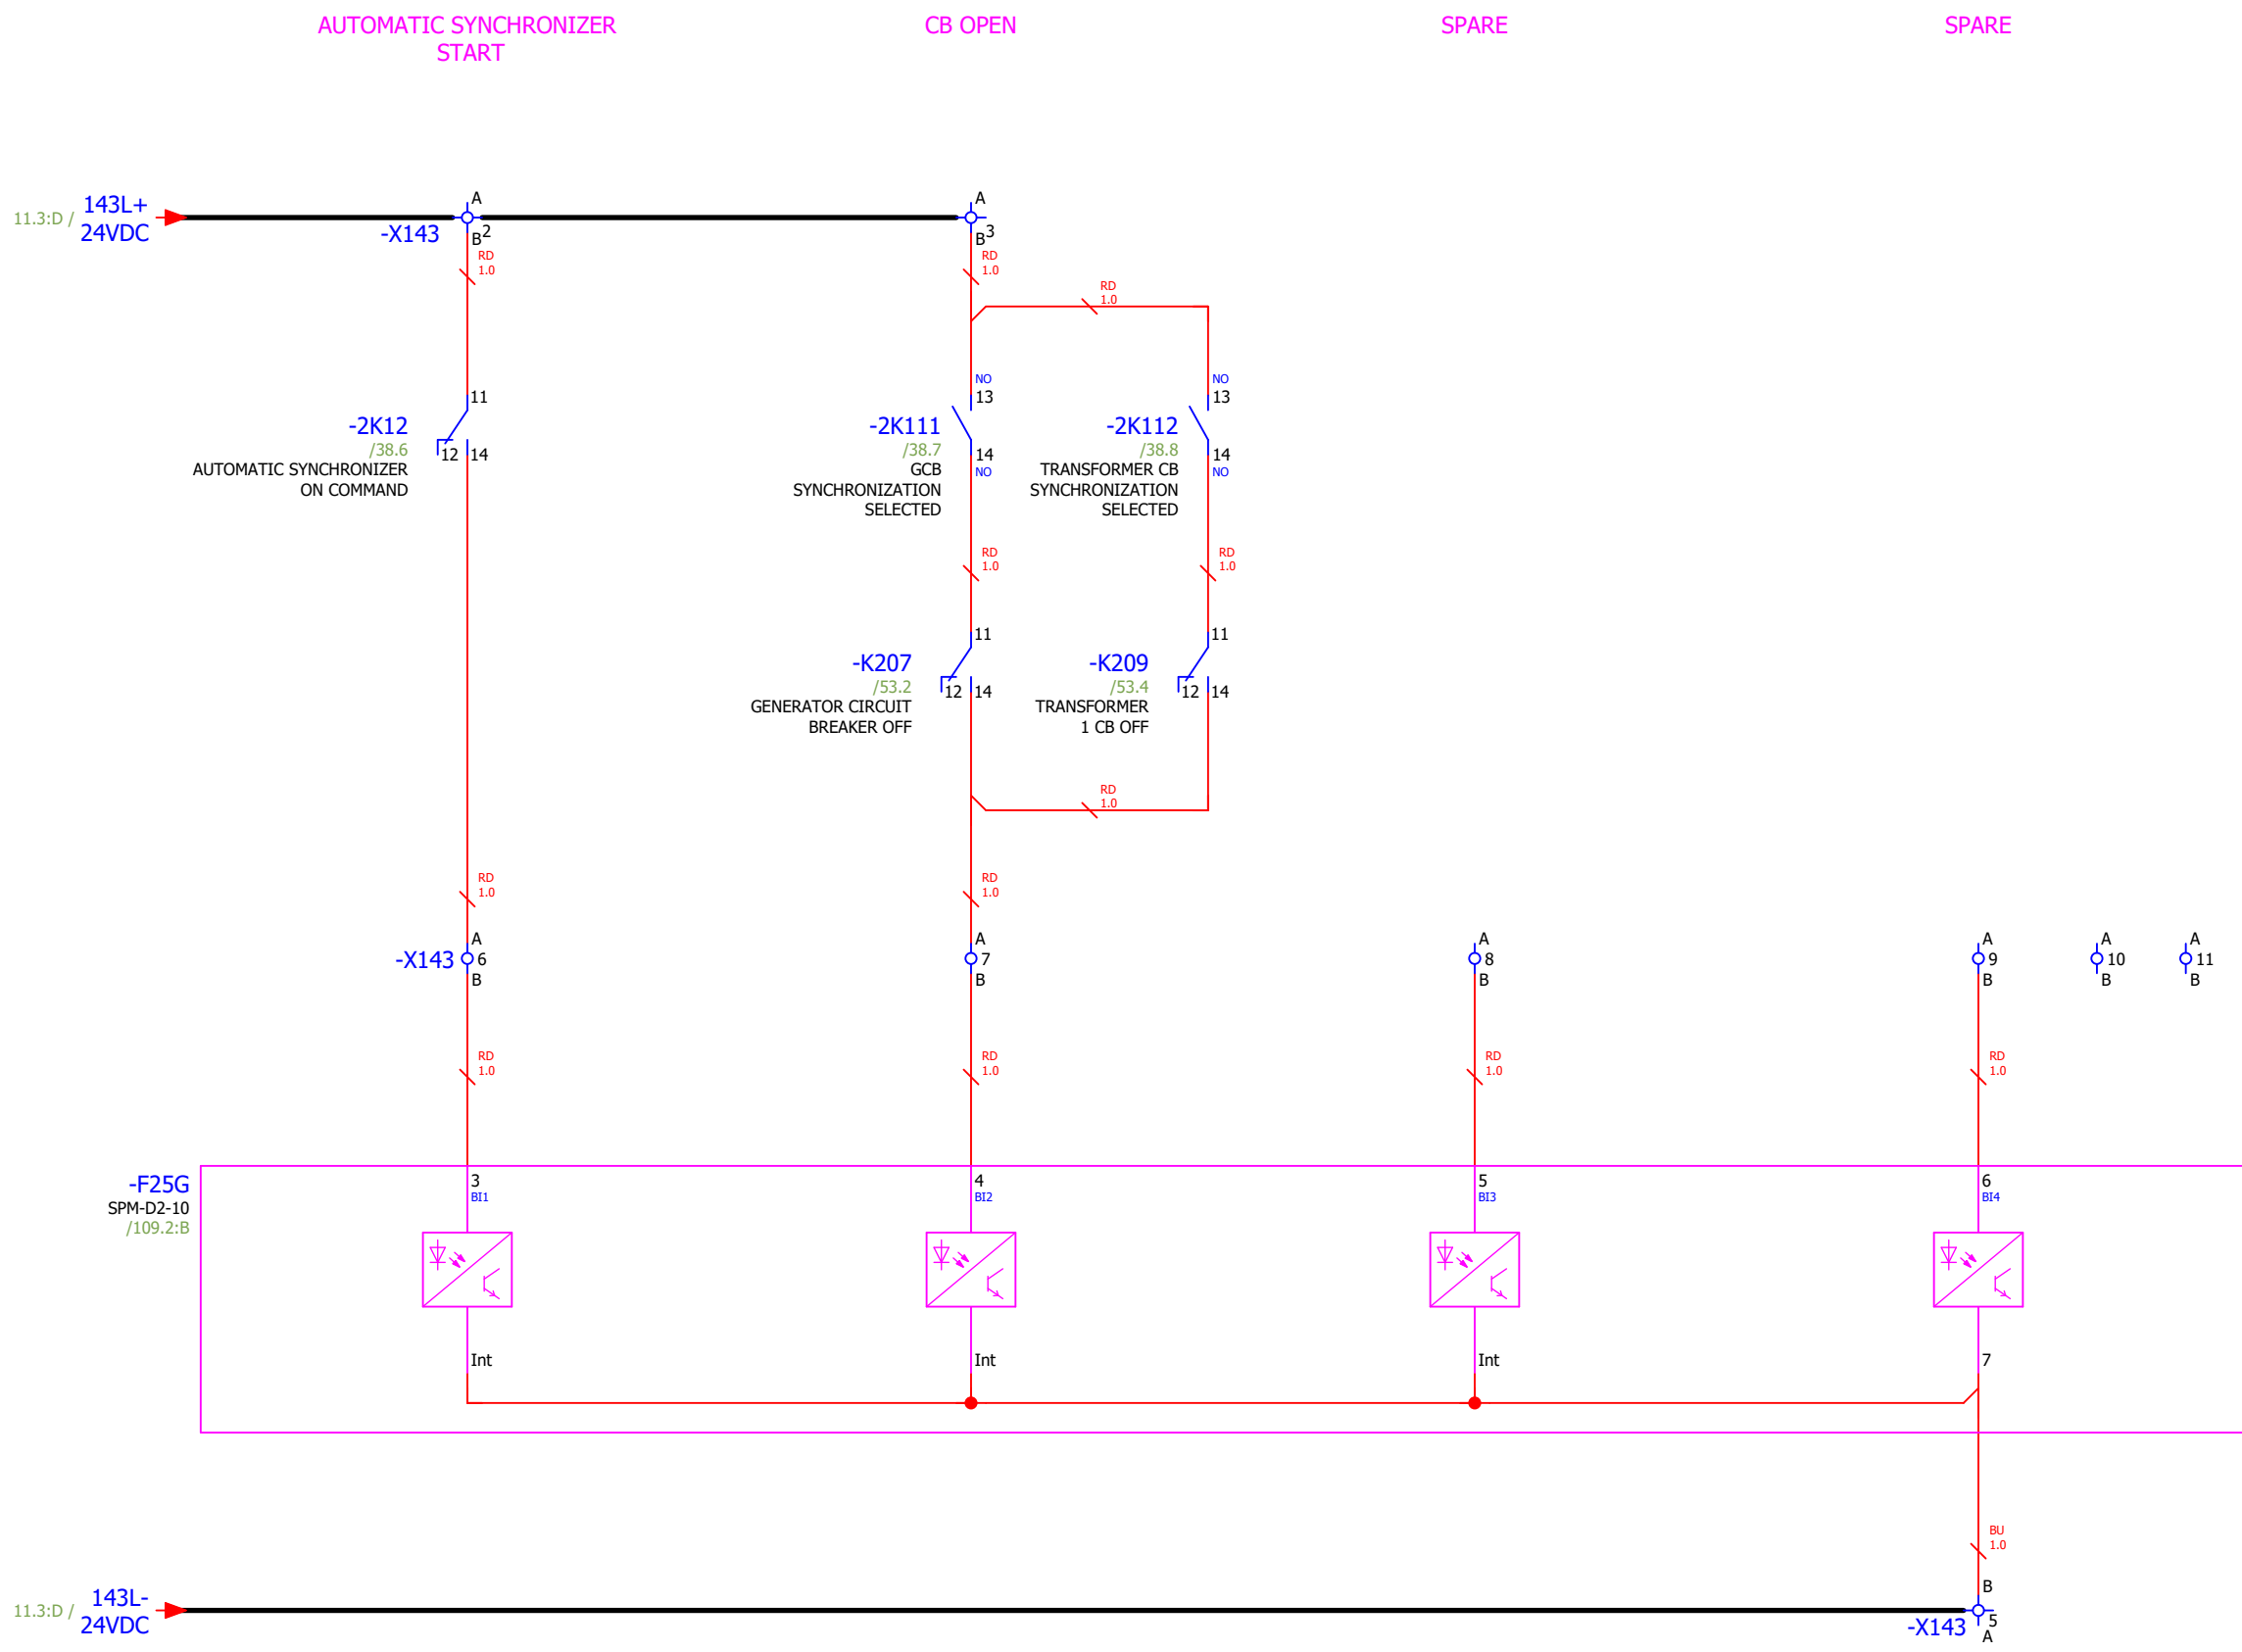

CONFIDENTIAL, ALL RIGHTS RESERVED DIN 34
Format ISO/DIN A3

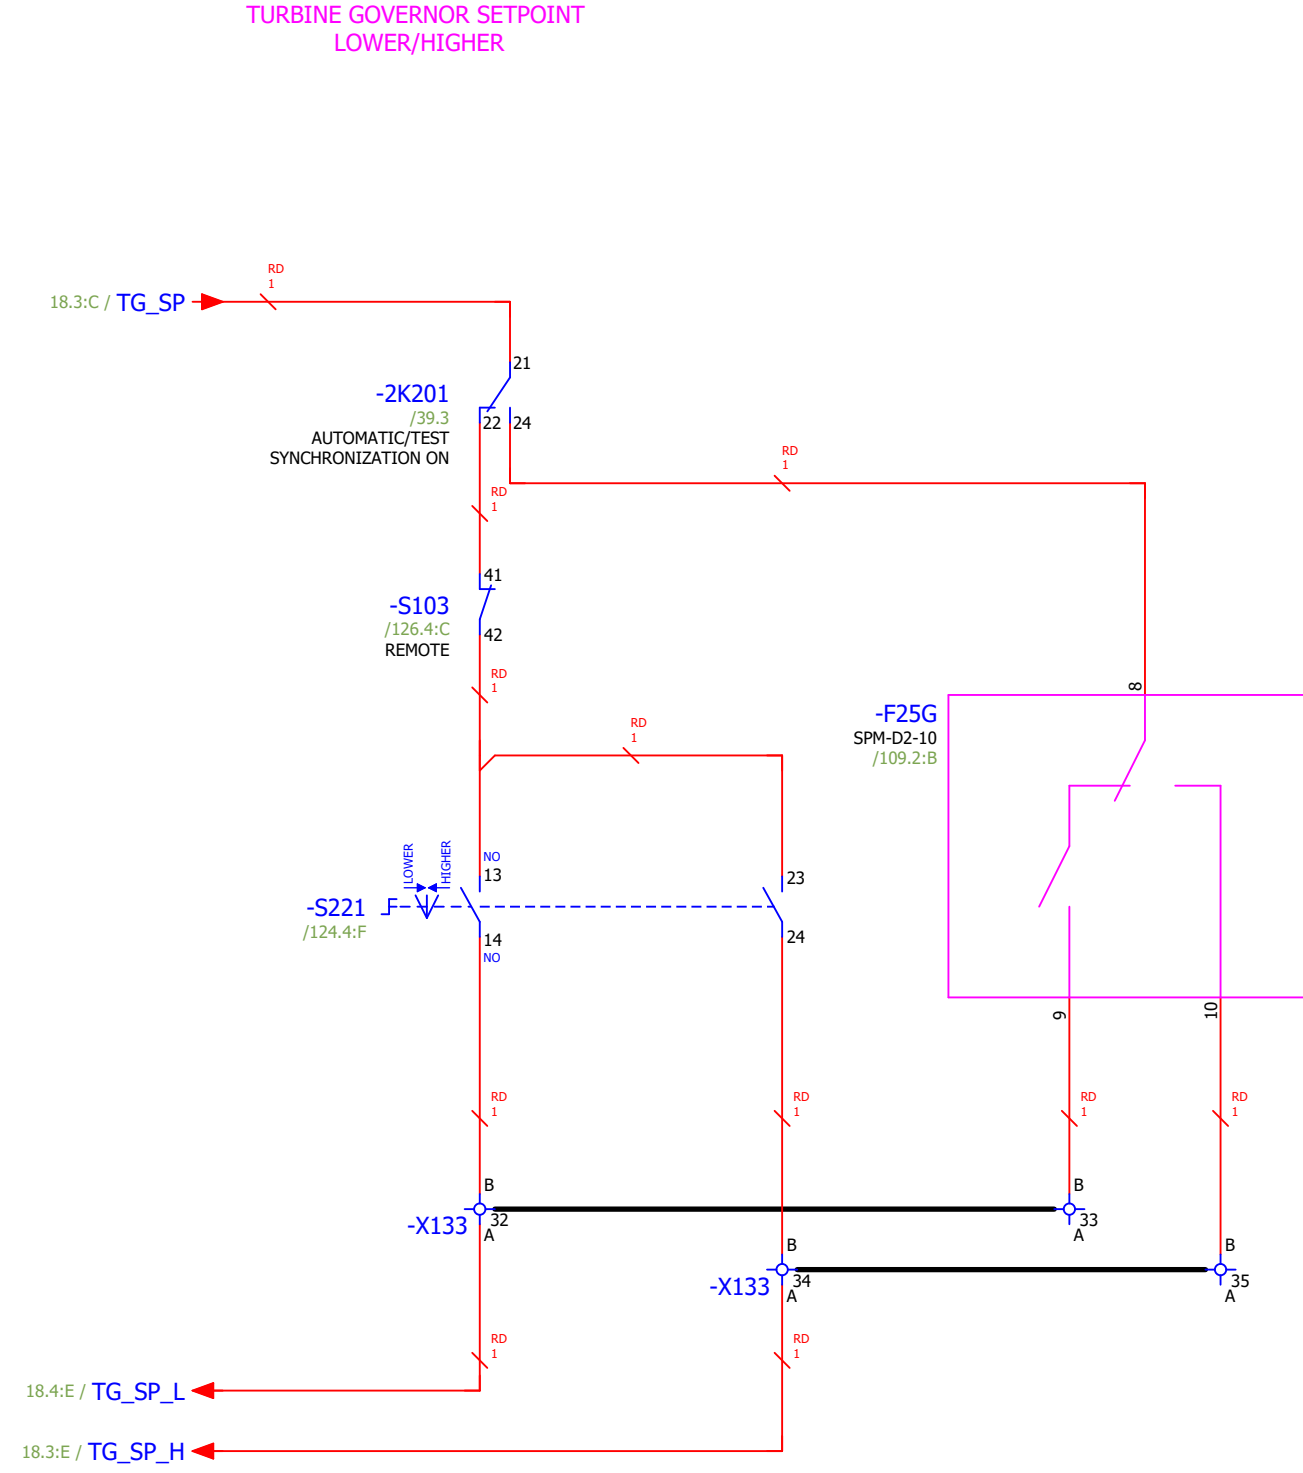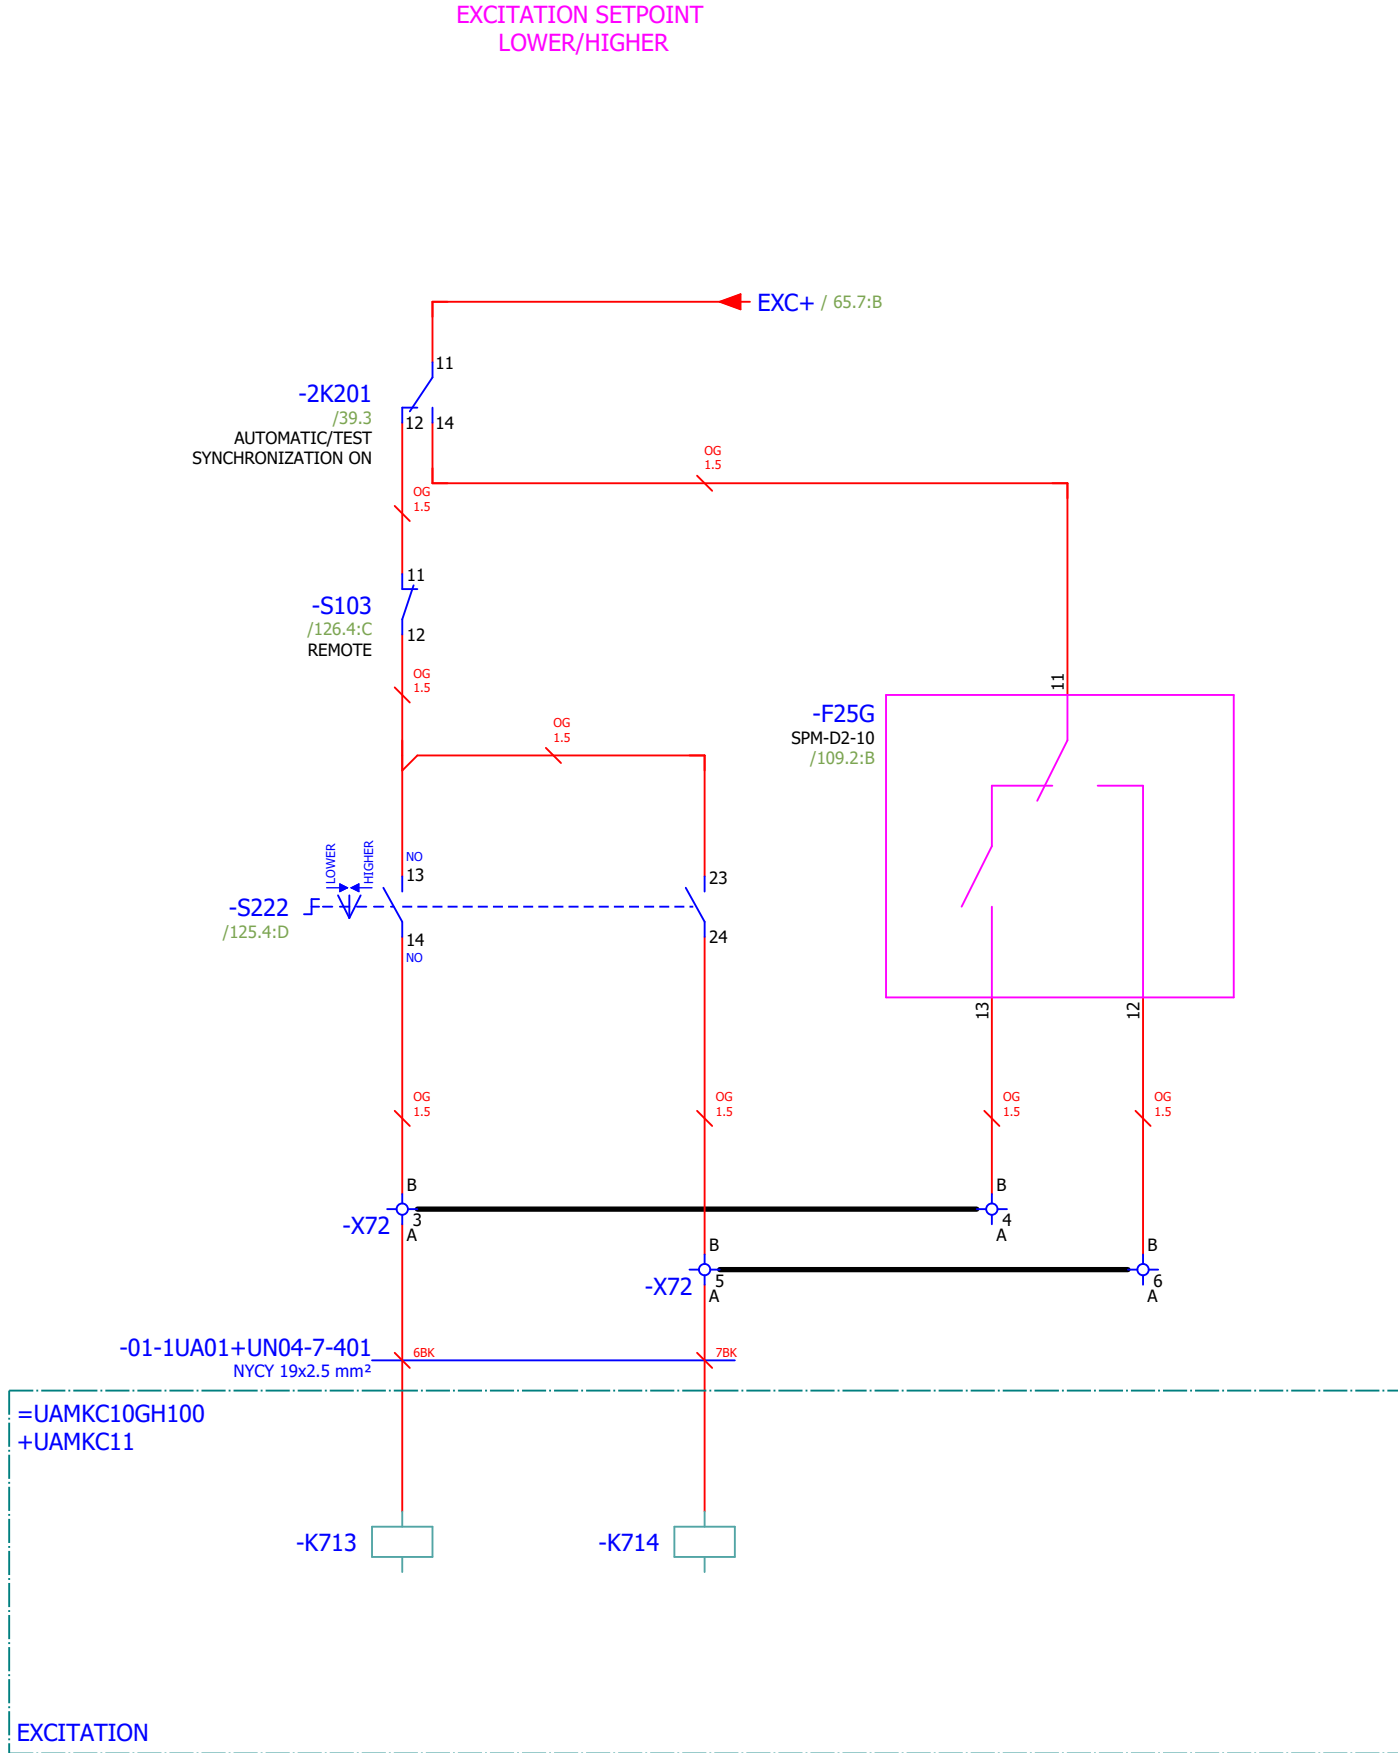


Approved by Contractor			Reconstruction and Modernisation of HPP Perucica - Phase II		 A Voith Company Sintaksa - A Voith Company Ulica Domovinskog rata 104C, 21 000 Split, Hrvatska	Unit KA1 control cubicle circuit diagrams SYNCHRONIZATION	DRAWING No.: PERU-01-19-170-31-001	REV No.: 02	= UACJA10GH100 + UACJA10
Approved by Designer	Grga Kolić	01.10.2026.					Designer No.:	SALES No.:	PAGE 63
Checked by	Antonio Aleksić	01.10.2026.	PROJECT NAME	EMPLOYER	DESIGNER				PAGE 63 / 156
Drawn by	Tamara Trogrlić	01.10.2026.							


Format ISO/DIN A3



Format ISO/DIN A3

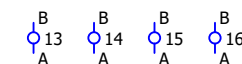


1	2	3	4	5	6	7	8
---	---	---	---	---	---	---	---

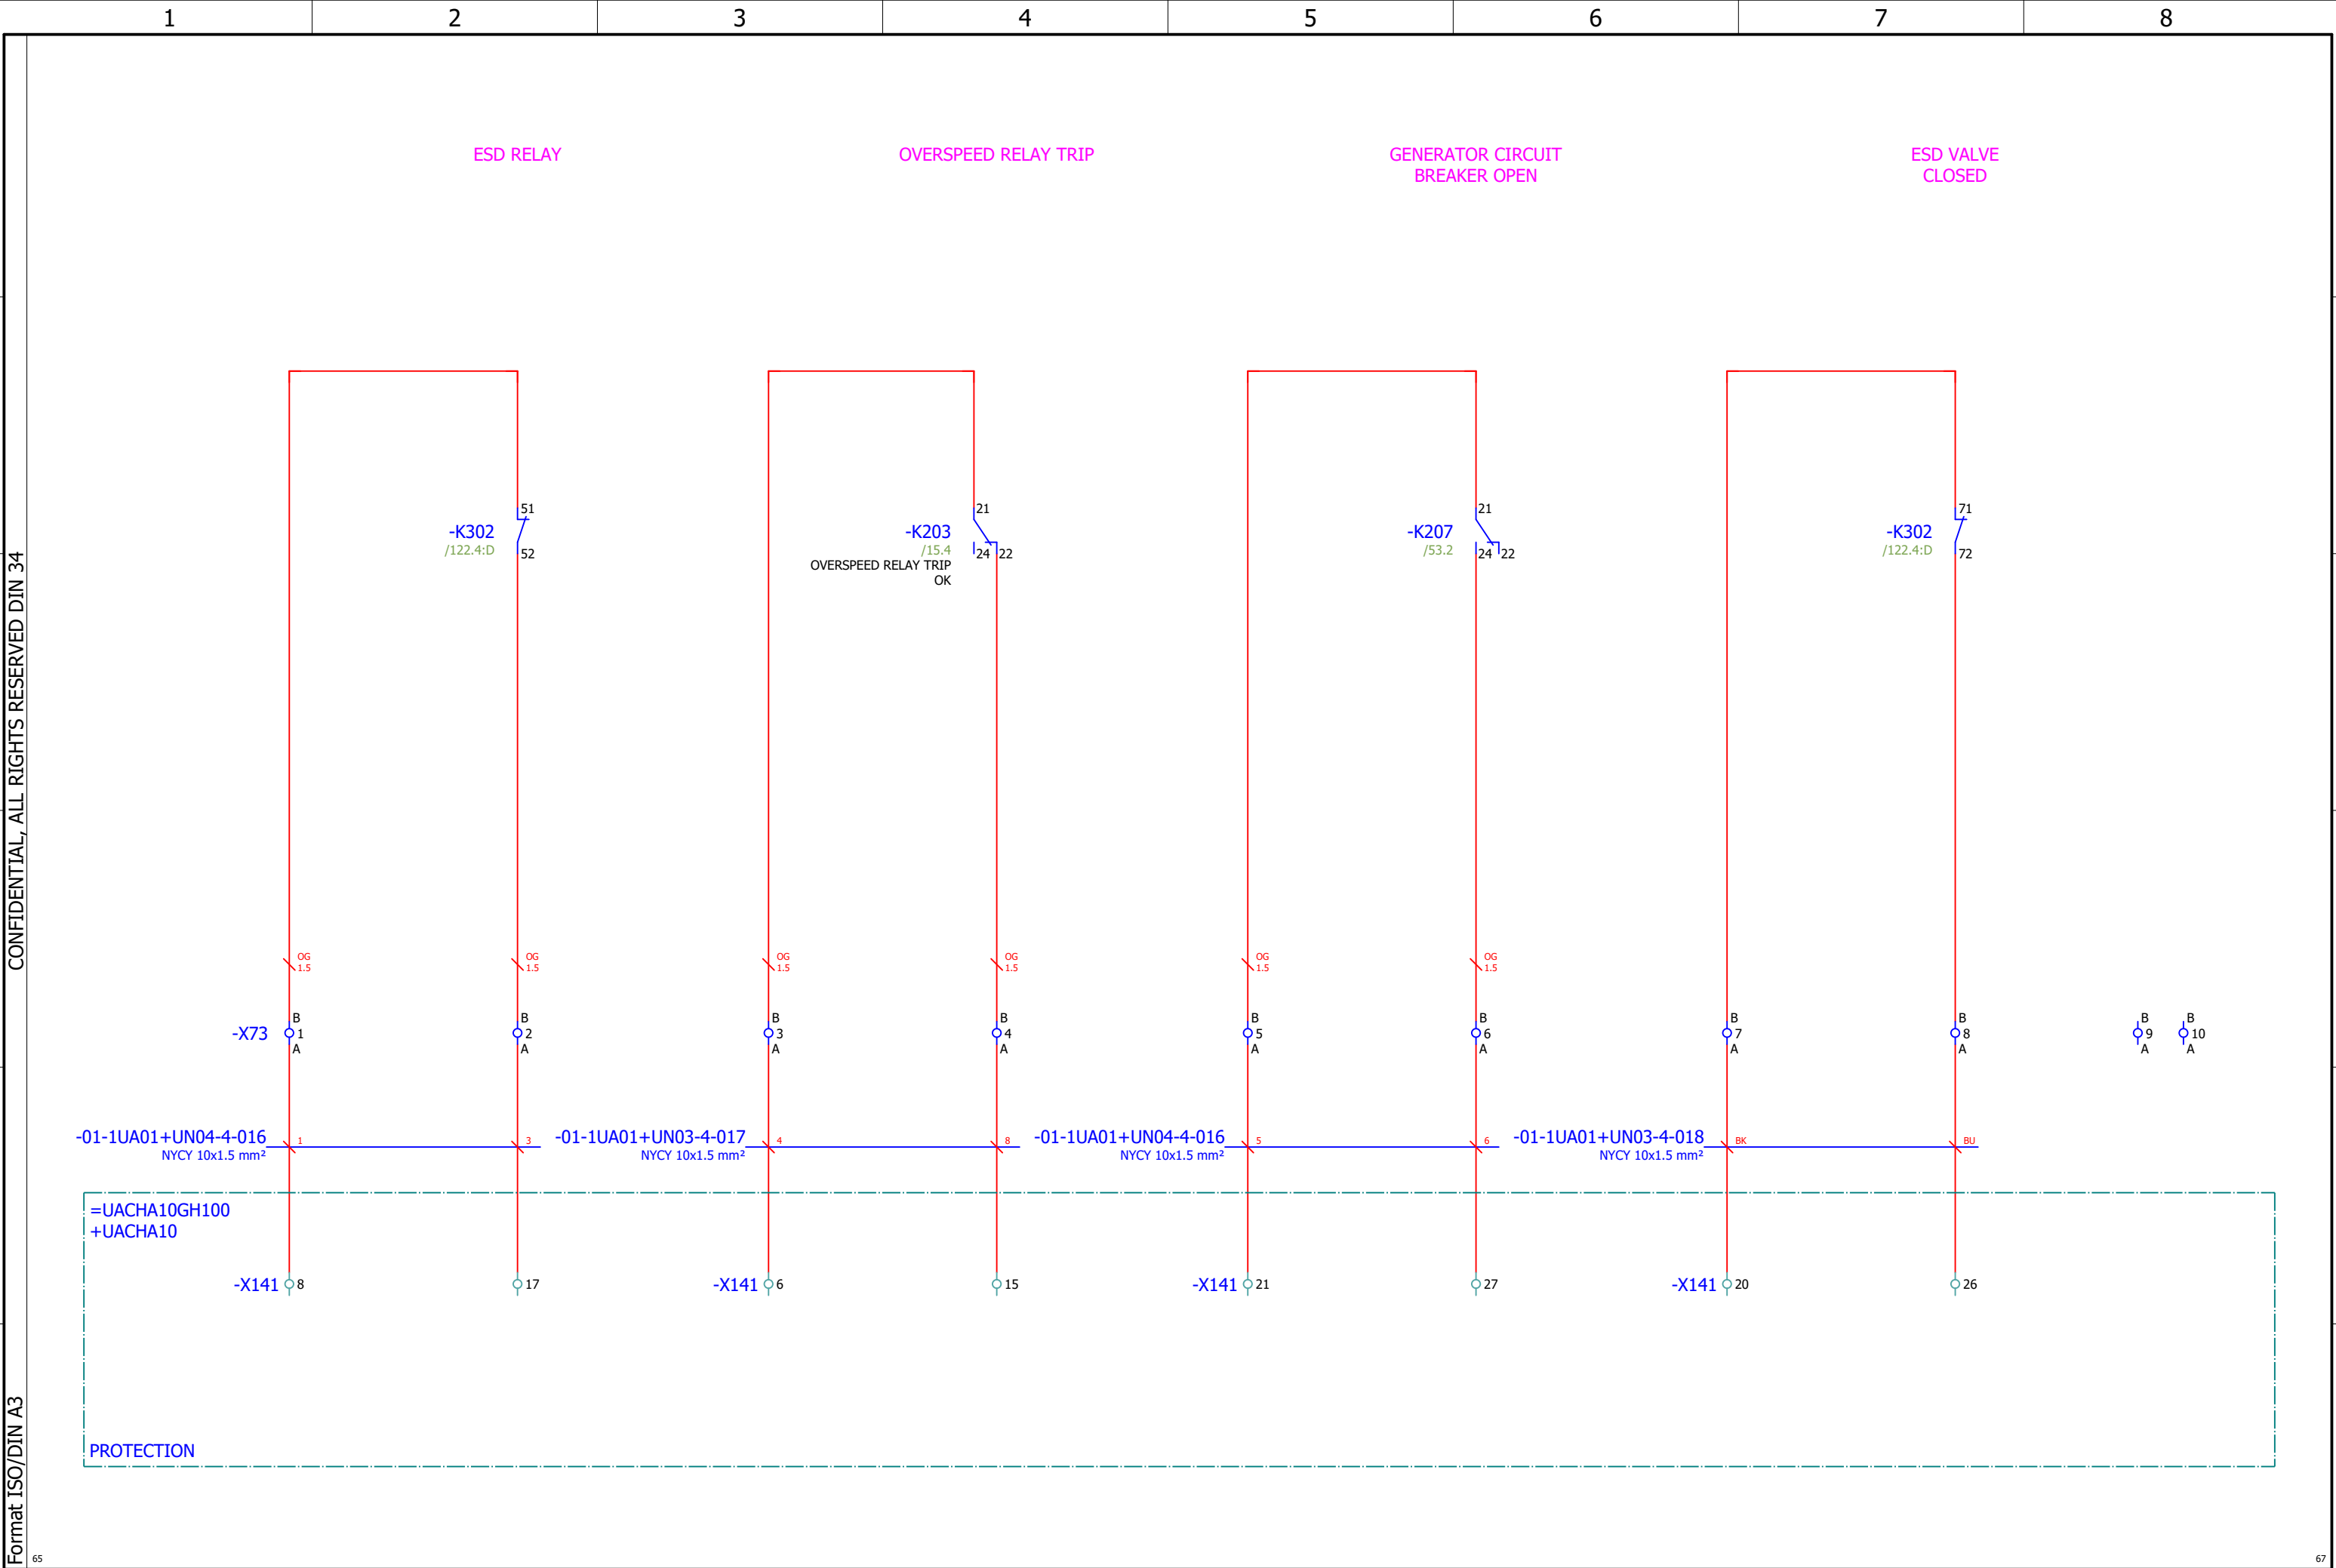


Approved by Contractor			Reconstruction and Modernisation of HPP Perucica - Phase II		 A Voith Company Sintaksa - A Voith Company Ulica Domovinskog rata 104C, 21 000 Split, Hrvatska	Unit KA1 control cubicle circuit diagrams SIGNALIZATION - PROTECTION	DRAWING No.: PERU-01-19-170-31-001	REV No.: 02	= UACJA10GH100 + UACJA10
Approved by Designer	Grga Kolić	01.10.2026.					Designer No.:	SALES No.:	PAGE 66
Checked by	Antonio Aleksić	01.10.2026.							
Drawn by	Tamara Trogrlić	01.10.2026.							PAGE 66 / 156


CONFIDENTIAL, ALL RIGHTS RESERVED DIN 34

Format ISO/DIN A3

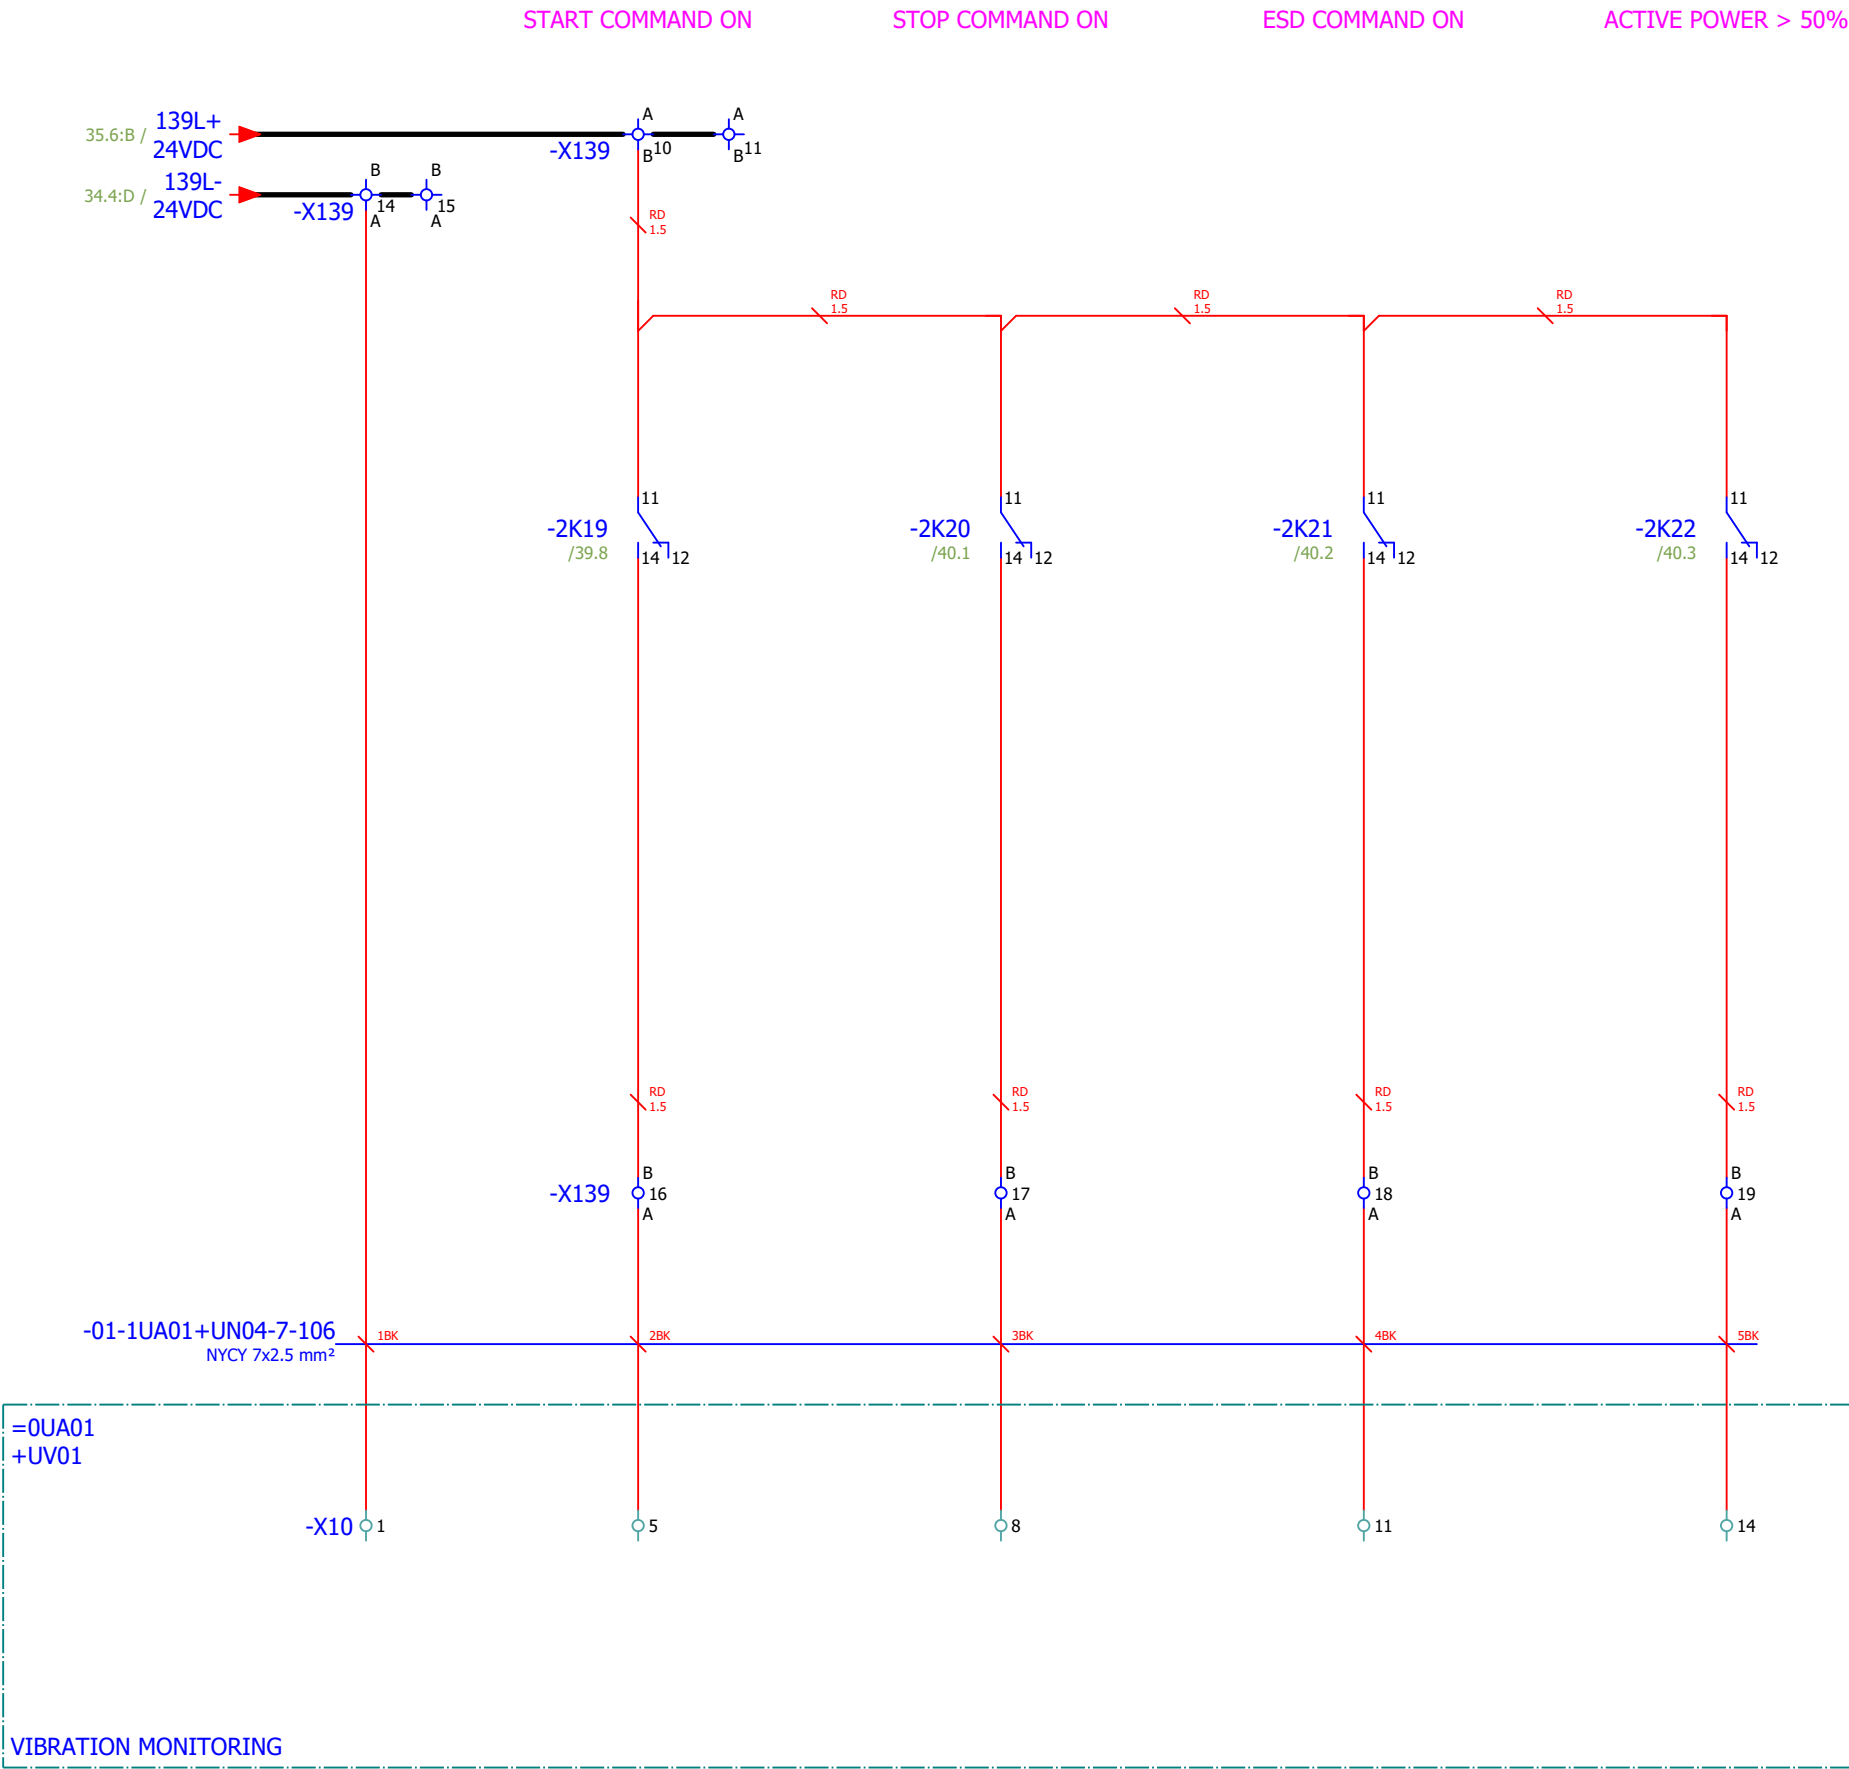

Approved by Contractor			Reconstruction and Modernisation of HPP Perucica - Phase II		 A Voith Company Sintaksa - A Voith Company Ulica Domovinskog rata 104C, 21 000 Split, Hrvatska	Unit KA1 control cubicle circuit diagrams SIGNALIZATION	DRAWING No.: PERU-01-19-170-31-001	REV No.: 02	= UACJA10GH100 + UACJA10
Approved by Designer	Grga Kolić	01.10.2026.					Designer No.:	SALES No.:	PAGE 67
Checked by	Antonio Aleksić	01.10.2026.							
Drawn by	Tamara Trogrlić	01.10.2026.							PAGE 67 / 156

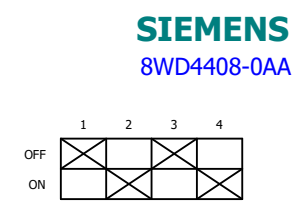


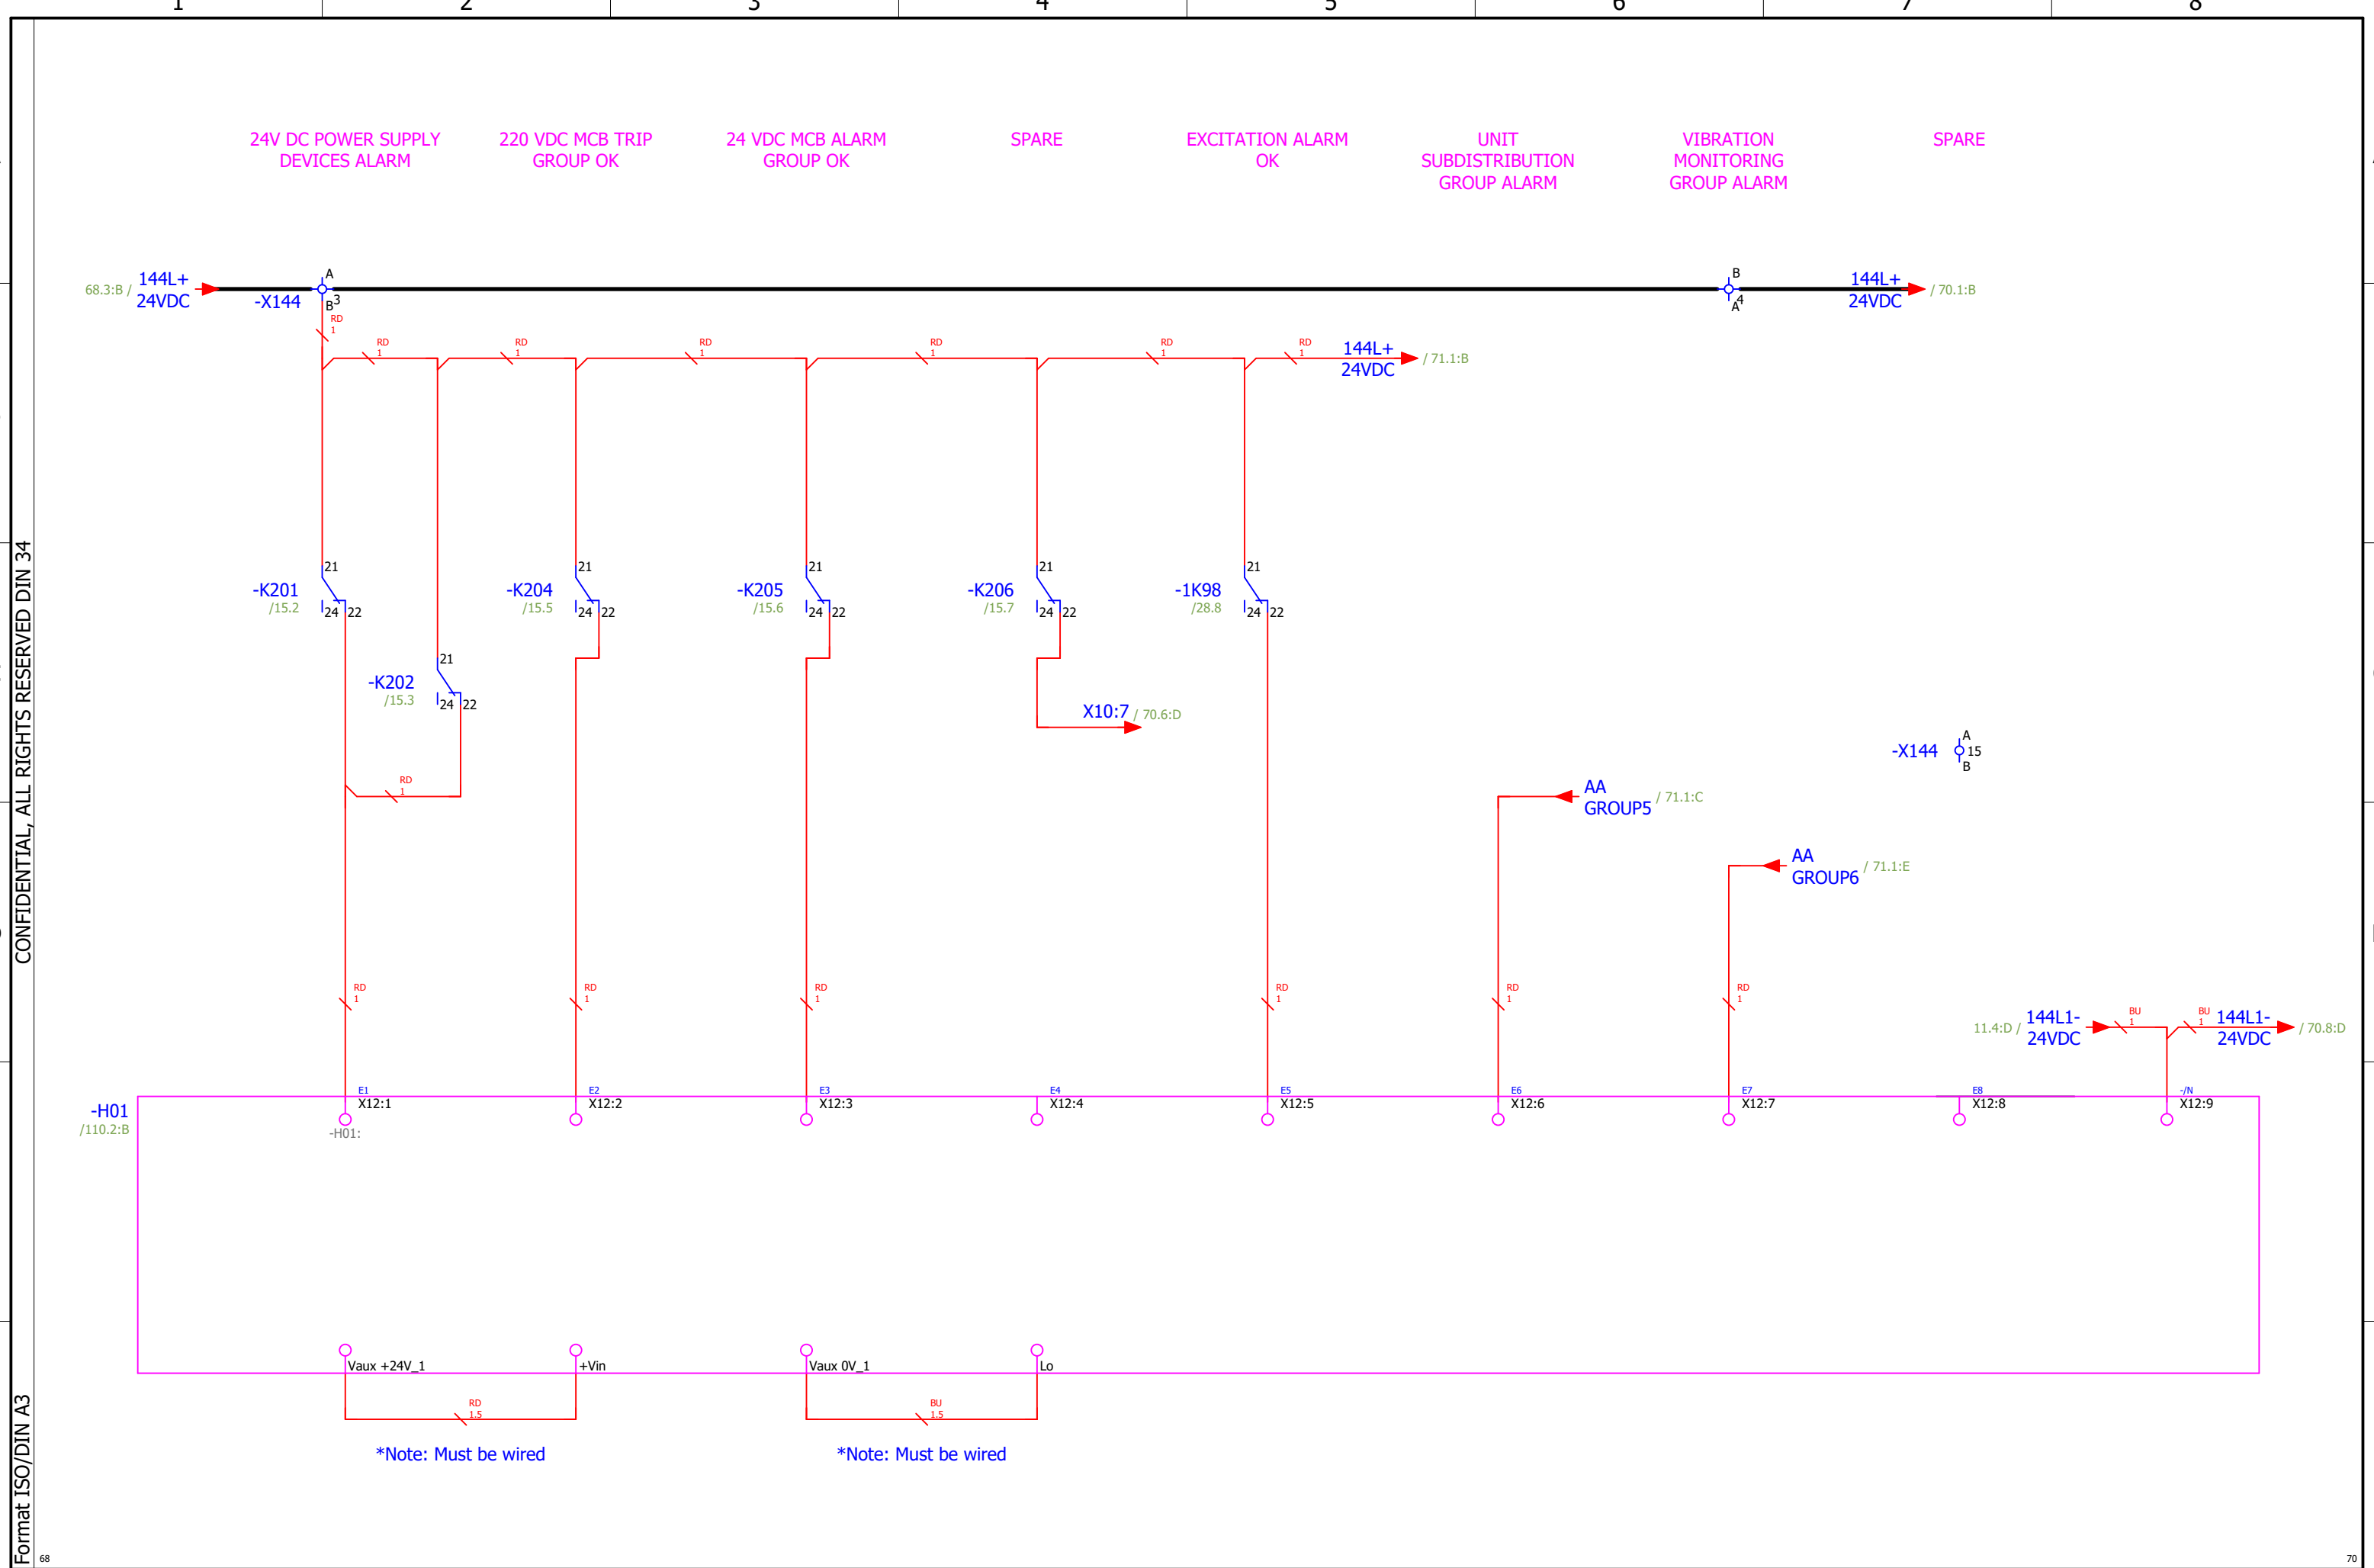


Approved by Contractor			Reconstruction and Modernisation of HPP Perucica - Phase II		 A Voith Company Sintaksa - A Voith Company Ulica Domovinskog rata 104C, 21 000 Split, Hrvatska	Unit KA1 control cubicle circuit diagrams ALARM ANNUNCIATOR - ALARM	DRAWING No.: PERU-01-19-170-31-001	REV No.: 02	= UACJA10GH100 + UACJA10
Approved by Designer	Grga Kolić	01.10.2026.					Designer No.:	SALES No.:	PAGE 69
Checked by	Antonio Aleksić	01.10.2026.							
Drawn by	Tamara Trogrlić	01.10.2026.							PAGE 69 / 156

CONFIDENTIAL, ALL RIGHTS RESERVED DIN 34

Format ISO/DIN A3

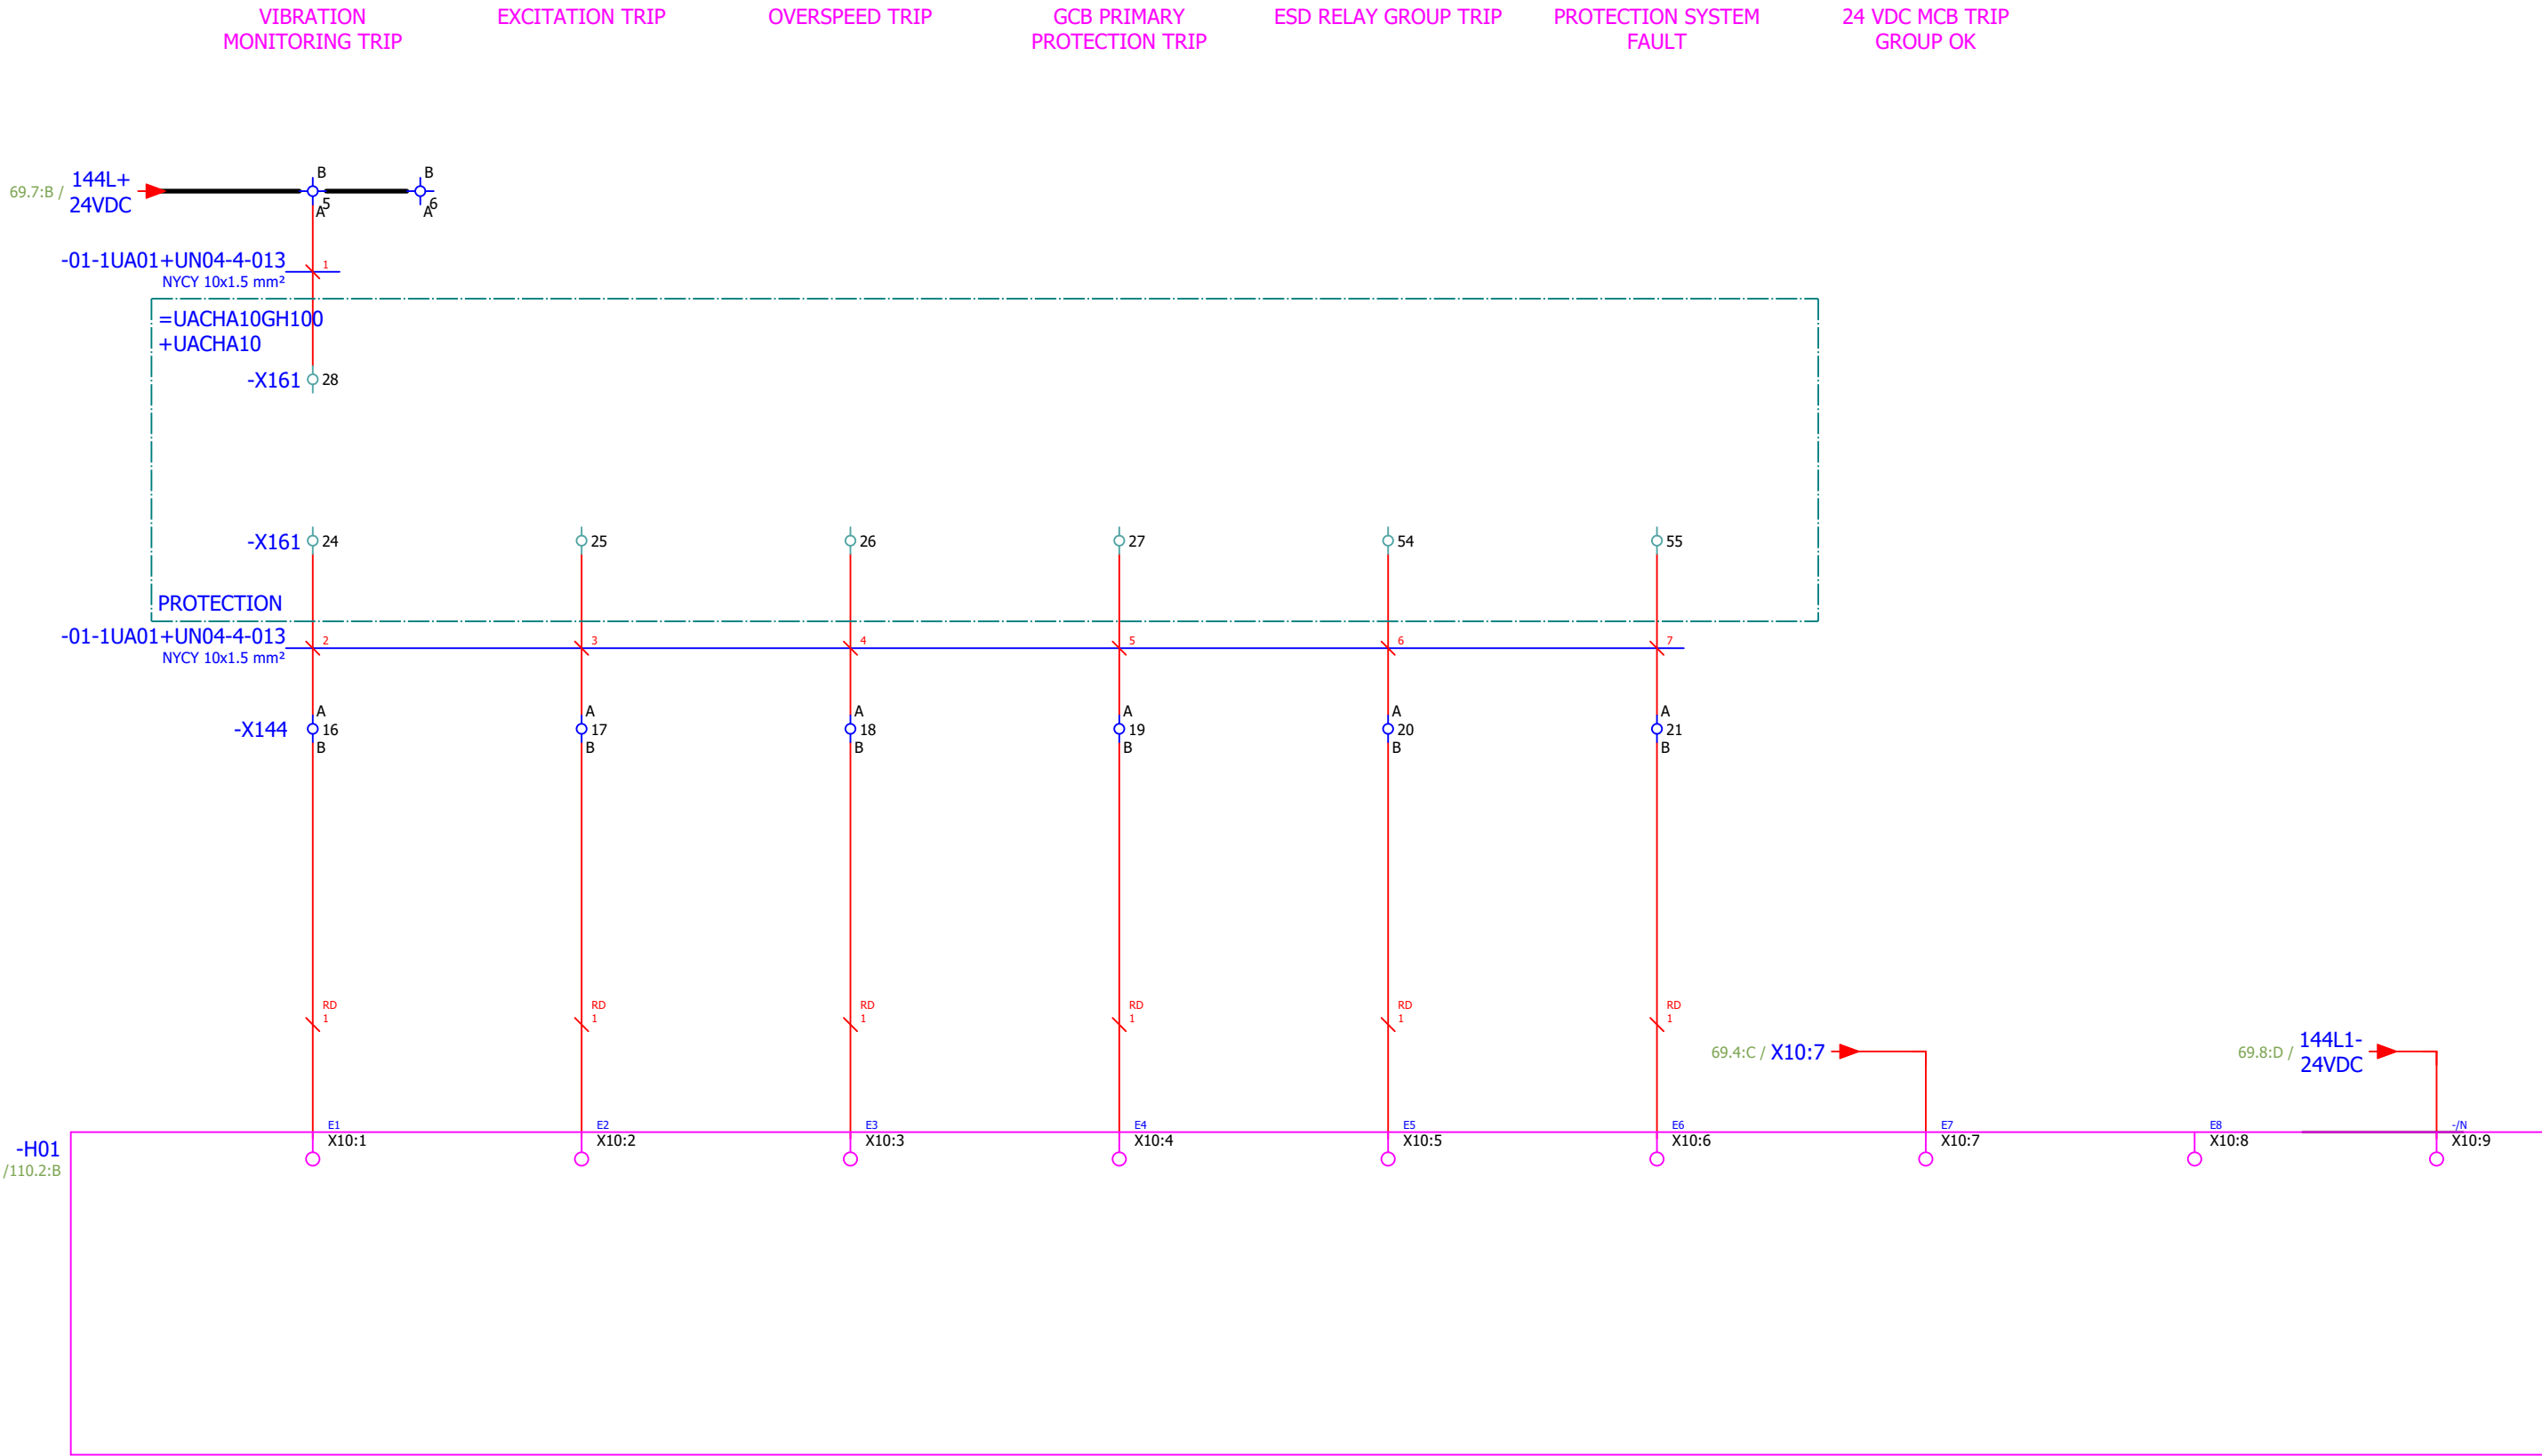

Approved by Contractor			Reconstruction and Modernisation of HPP Perucica - Phase II		 A Voith Company Sintaksa - A Voith Company Ulica Domovinskog rata 104C, 21 000 Split, Hrvatska	Unit KA1 control cubicle circuit diagrams ALARM ANNUNCIATOR - TRIP	DRAWING No.:	REV No.:	= UACJA10GH100
Approved by Designer	Grga Kolić	01.10.2026.					PERU-01-19-170-31-001	02	+ UACJA10
Checked by	Antonio Aleksić	01.10.2026.					Designer No.:	SALES No.:	PAGE 70
Drawn by	Tamara Trogrlić	01.10.2026.							PAGE 70 / 156

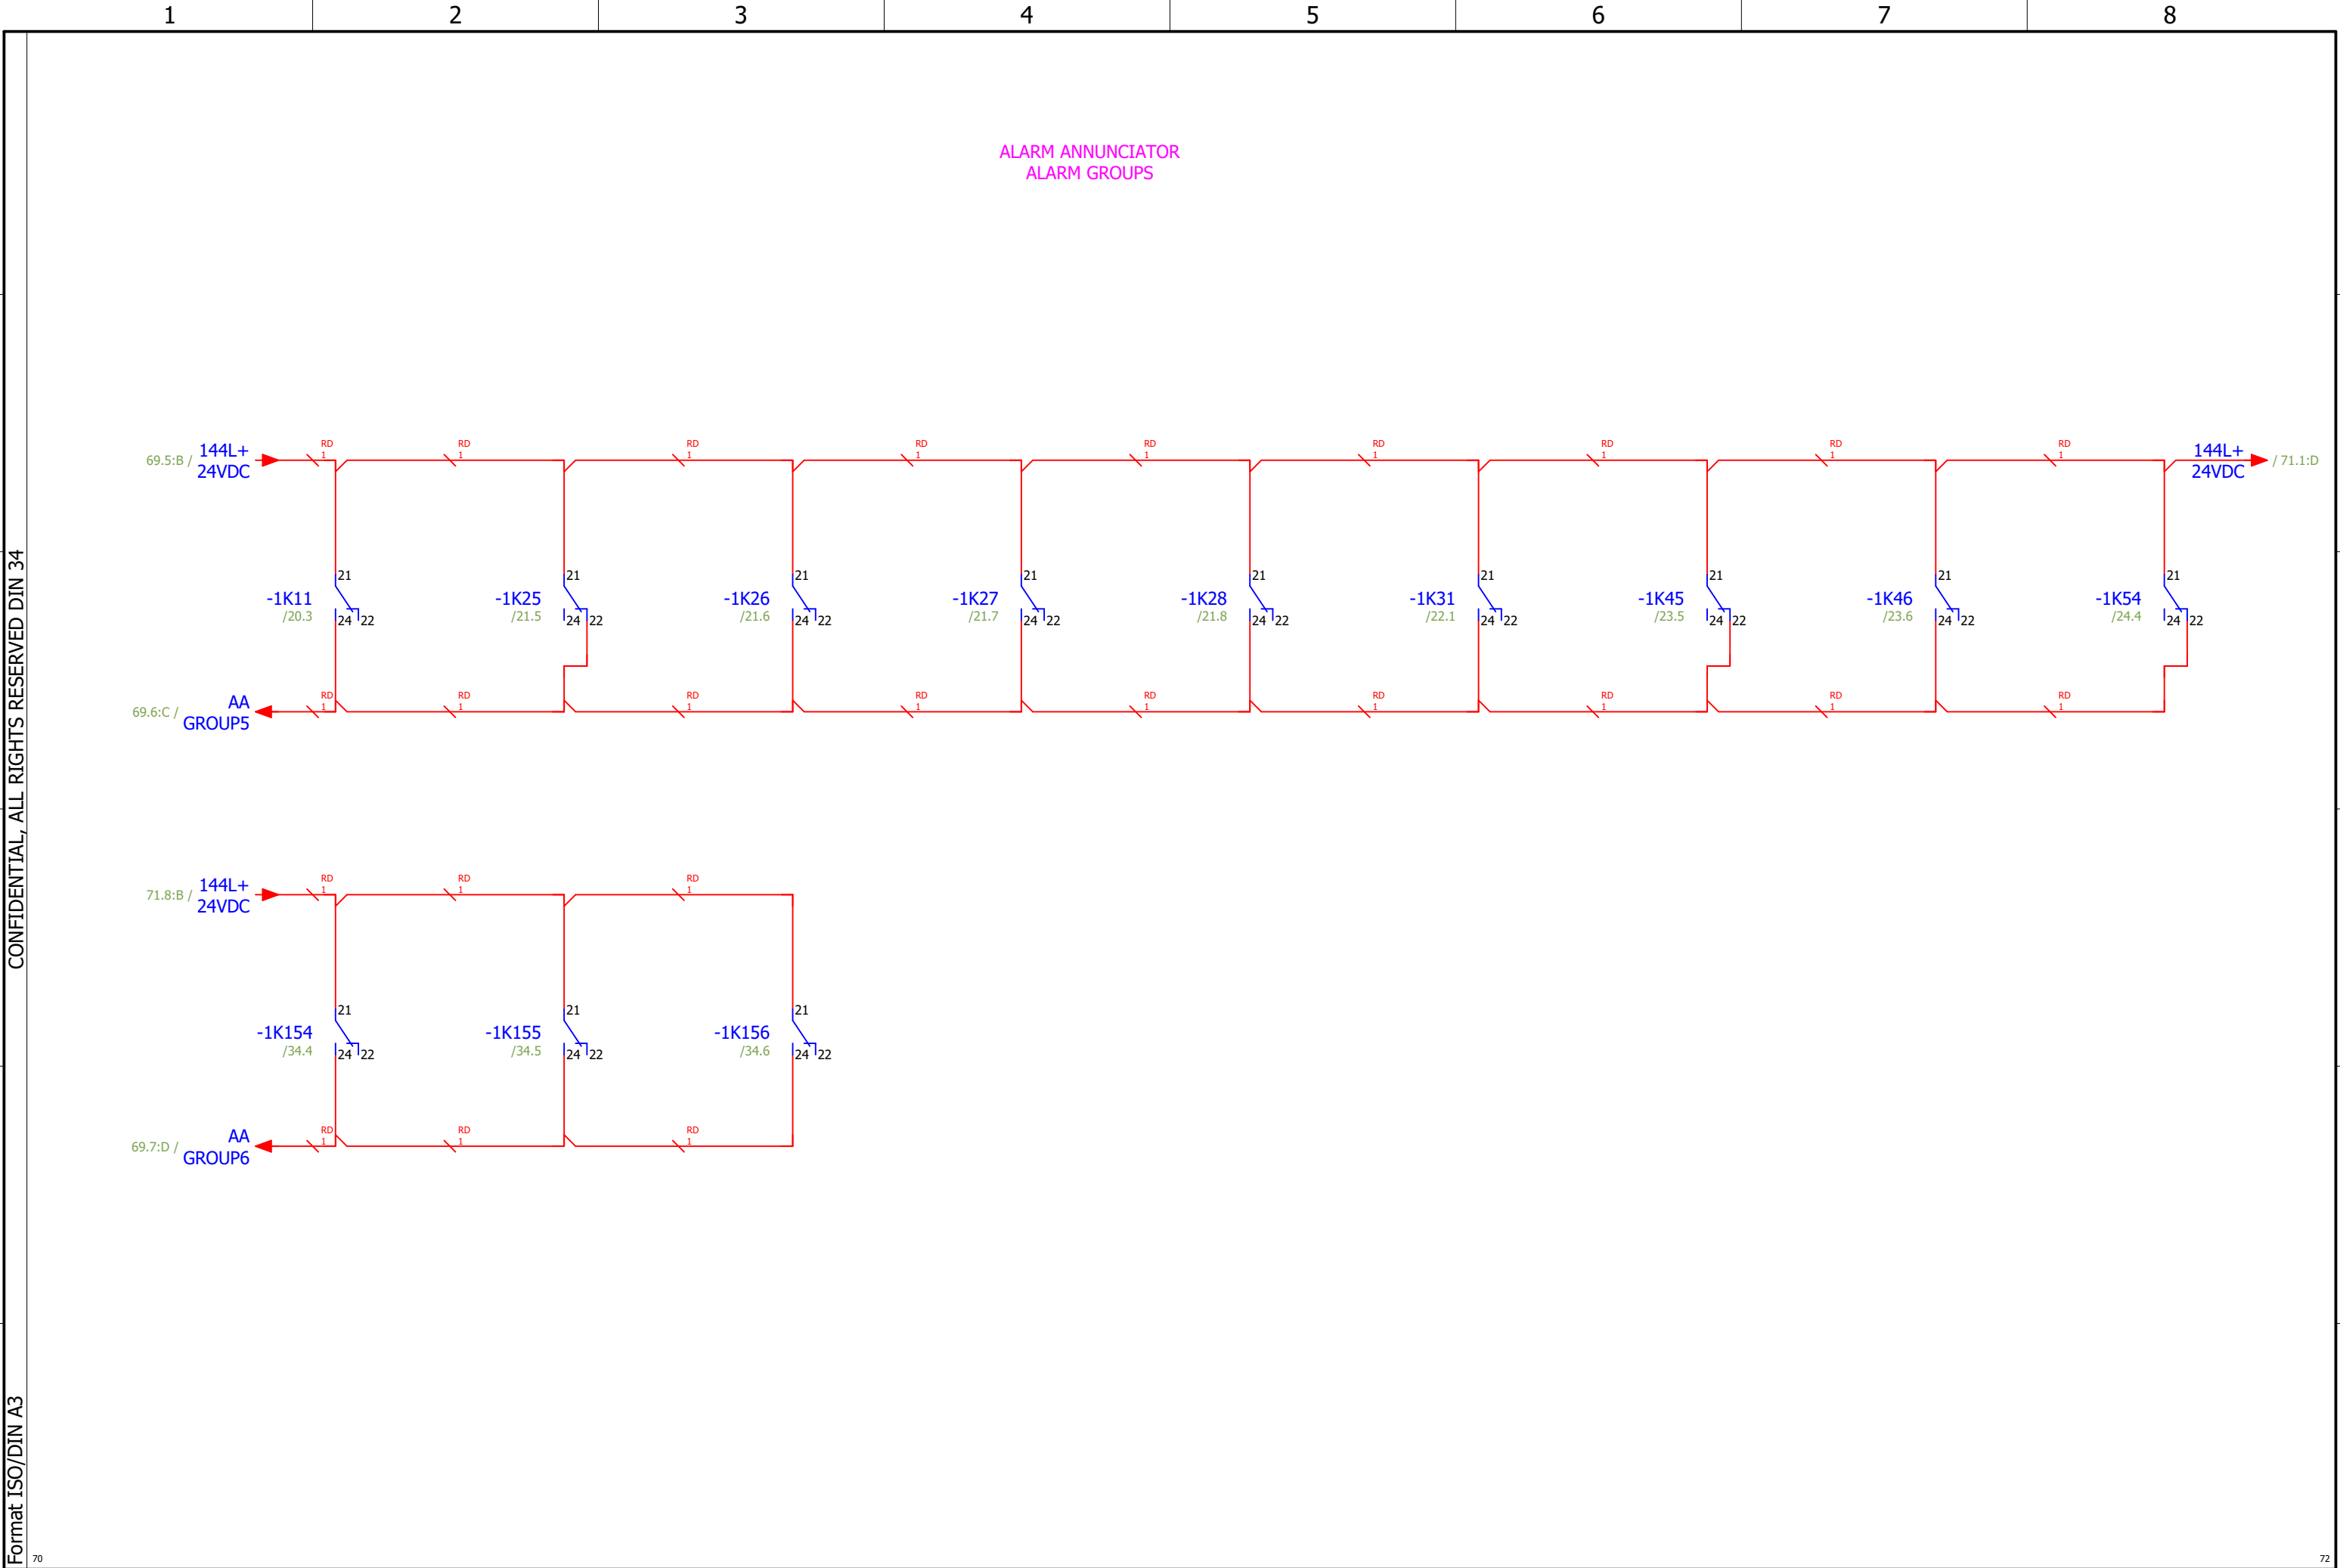

Approved by Contractor			Reconstruction and Modernisation of HPP Perucica - Phase II		 A Voith Company Sintaksa - A Voith Company Ulica Domovinskog rata 104C, 21 000 Split, Hrvatska	Unit KA1 control cubicle circuit diagrams ALARM ANNUNCIATOR - TRIP	DRAWING No.: PERU-01-19-170-31-001	REV No.: 02	= UACJA10GH100 + UACJA10
Approved by Designer	Grga Kolić	01.10.2026.					Designer No.:	SALES No.:	PAGE 71
Checked by	Antonio Aleksić	01.10.2026.	PROJECT NAME	EMPLOYER	DESIGNER				PAGE 71 / 156
Drawn by	Tamara Trogrlić	01.10.2026.							




CONFIDENTIAL, ALL RIGHTS RESERVED DIN 34

Format ISO/DIN A3

71

73

Approved by Contractor			Reconstruction and Modernisation of HPP Perucica - Phase II		 A Voith Company	Unit KA1 control cubicle circuit diagrams SPARE CONTACTS	DRAWING No.: PERU-01-19-170-31-001	REV No.: 02	= UACJA10GH100 + UACJA10
Approved by Designer	Grga Kolić	01.10.2026.			Sintaksa - A Voith Company Ulica Domovinskog rata 104C, 21 000 Split, Hrvatska		Designer No.:	SALES No.:	PAGE 72
Checked by	Antonio Aleksić	01.10.2026.							PAGE 72 / 156
Drawn by	Tamara Trogrlić	01.10.2026.			PROJECT NAME	EMPLOYER	DESIGNER		

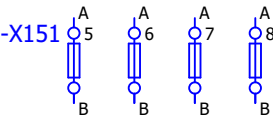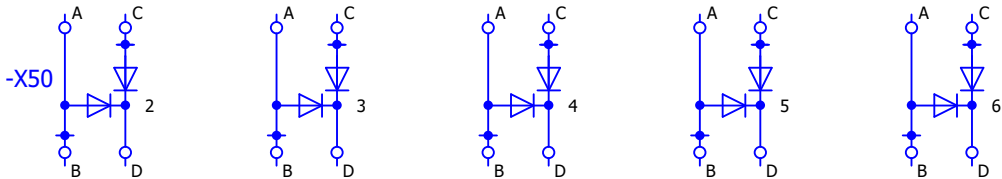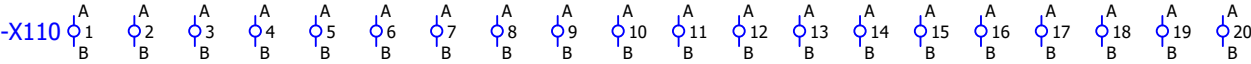

CONFIDENTIAL, ALL RIGHTS RESERVED DIN 34

Format ISO/DIN A3


72

Approved by Contractor			Reconstruction and Modernisation of HPP Perucica - Phase II		 A Voith Company Sintaksa - A Voith Company Ulica Domovinskog rata 104C, 21 000 Split, Hrvatska	Unit KA1 control cubicle circuit diagrams CT CIRCUITS	DRAWING No.: PERU-01-19-170-31-001	REV No.: 02	= UACJA10GH100 + UACJA10
Approved by Designer	Grga Kolić	01.10.2026.					Designer No.:	SALES No.:	PAGE 73
Checked by	Antonio Aleksić	01.10.2026.							
Drawn by	Tamara Trogrlić	01.10.2026.							PAGE 73 / 156

1	2	3	4	5	6	7	8
---	---	---	---	---	---	---	---


GENERATOR
PHASE 1 PHASE 2 PHASE 3
CURRENT

MULTIMETER

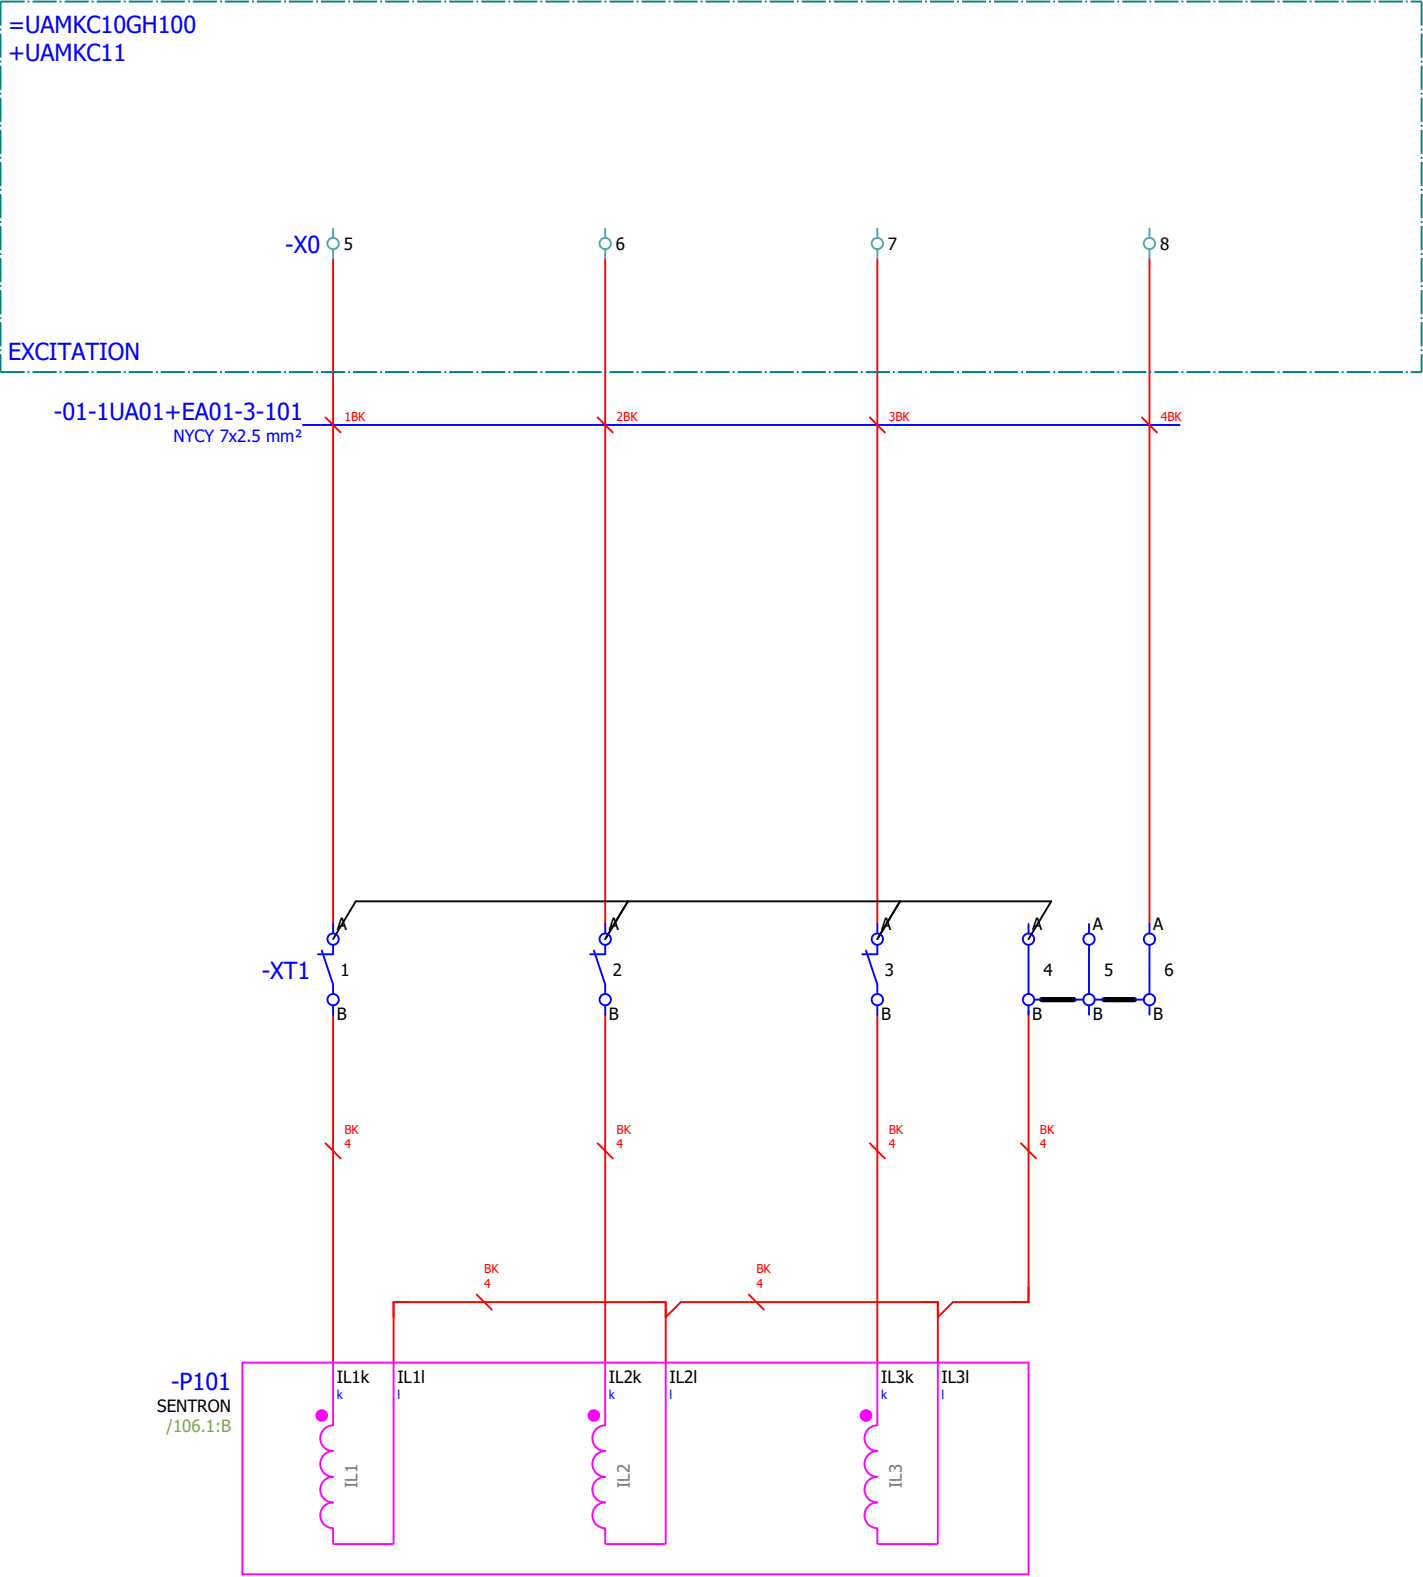

74

CONFIDENTIAL, ALL RIGHTS RESERVED DIN 34
Format ISO/DIN A3

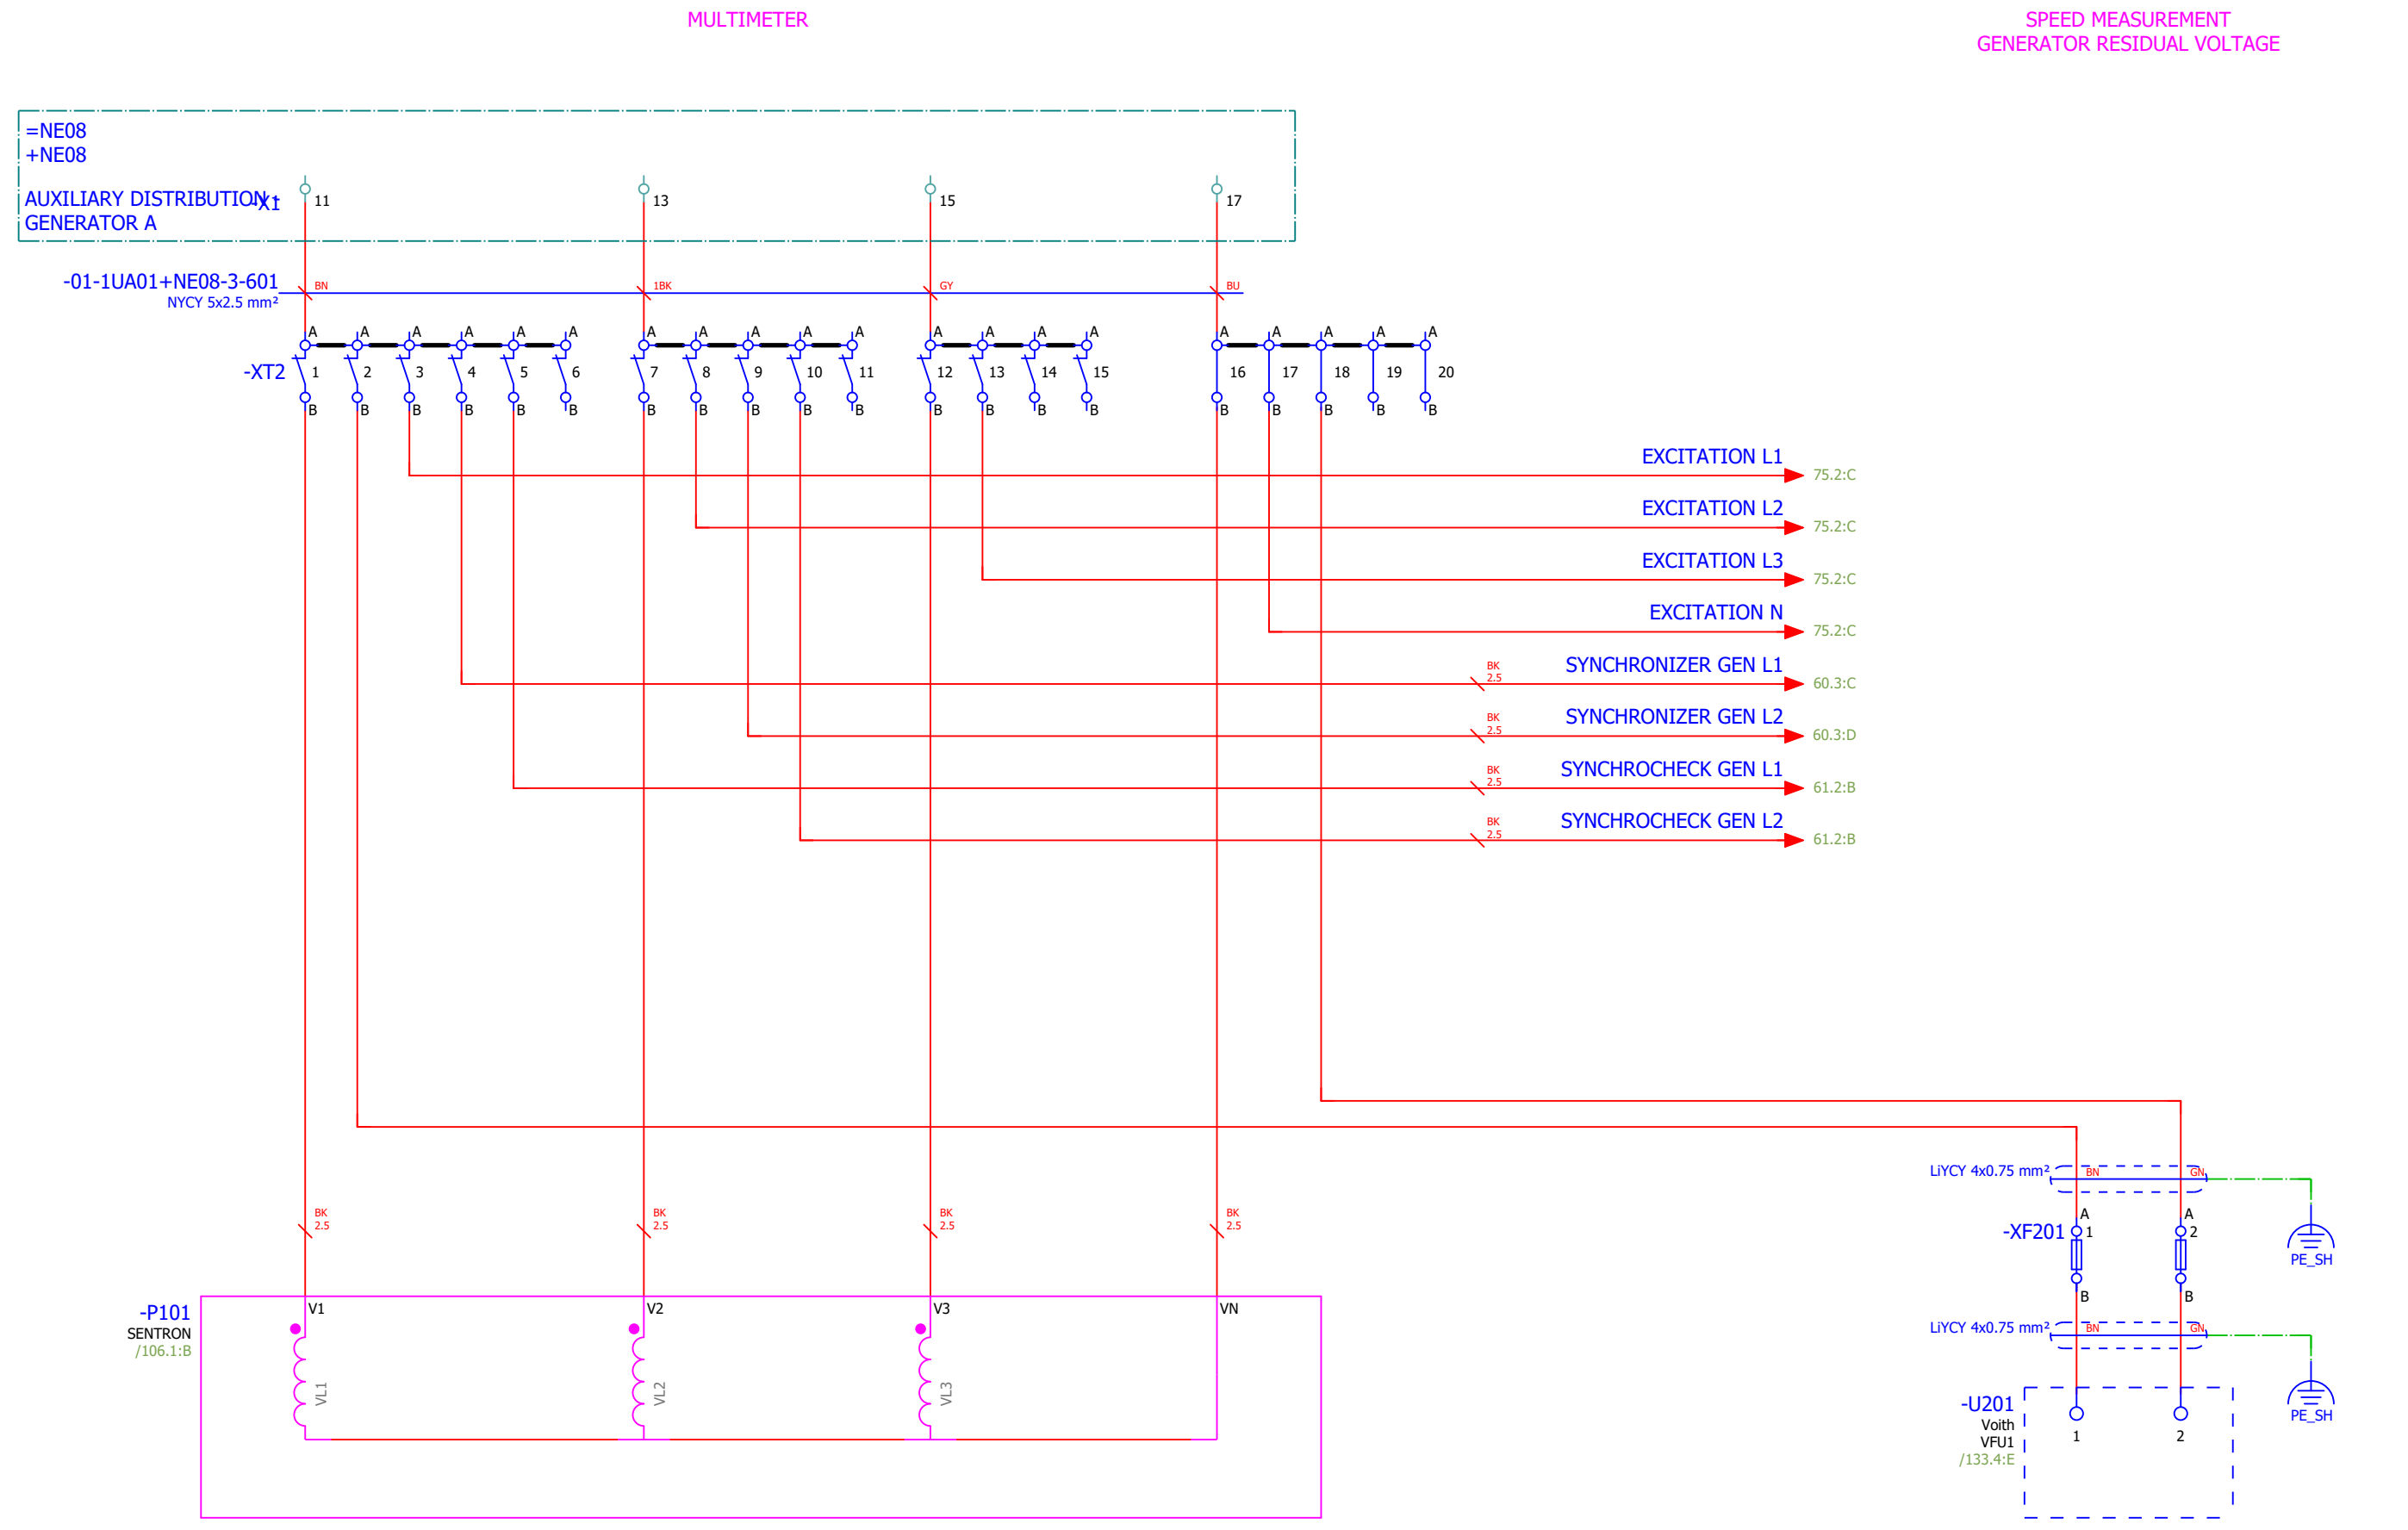

Approved by Contractor			Reconstruction and Modernisation of HPP Perucica - Phase II		 A Voith Company Sintaksa - A Voith Company Ulica Domovinskog rata 104C, 21 000 Split, Hrvatska	Unit KA1 control cubicle circuit diagrams VT CIRCUITS	DRAWING No.:	REV No.:	= UACJA10GH100
Approved by Designer	Grga Kolić	01.10.2026.					PERU-01-19-170-31-001	02	+ UACJA10
Checked by	Antonio Aleksić	01.10.2026.					Designer No.:	SALES No.:	PAGE 74
Drawn by	Tamara Trogrlić	01.10.2026.							PAGE 74 / 156

CONFIDENTIAL, ALL RIGHTS RESERVED DIN 34

Format ISO/DIN A3


74

76

Approved by Contractor			Reconstruction and Modernisation of HPP Perucica - Phase II		 A Voith Company Sintaksa - A Voith Company Ulica Domovinskog rata 104C, 21 000 Split, Hrvatska	Unit KA1 control cubicle circuit diagrams VT CIRCUITS	DRAWING No.: PERU-01-19-170-31-001	REV No.: 02	= UACJA10GH100 + UACJA10
Approved by Designer	Grga Kolić	01.10.2026.					Designer No.:	SALES No.:	PAGE 75
Checked by	Antonio Aleksić	01.10.2026.							
Drawn by	Tamara Trogrlić	01.10.2026.							PAGE 75 / 156


1	2	3	4	5	6	7	8
---	---	---	---	---	---	---	---

EXCITATION VOLTAGE

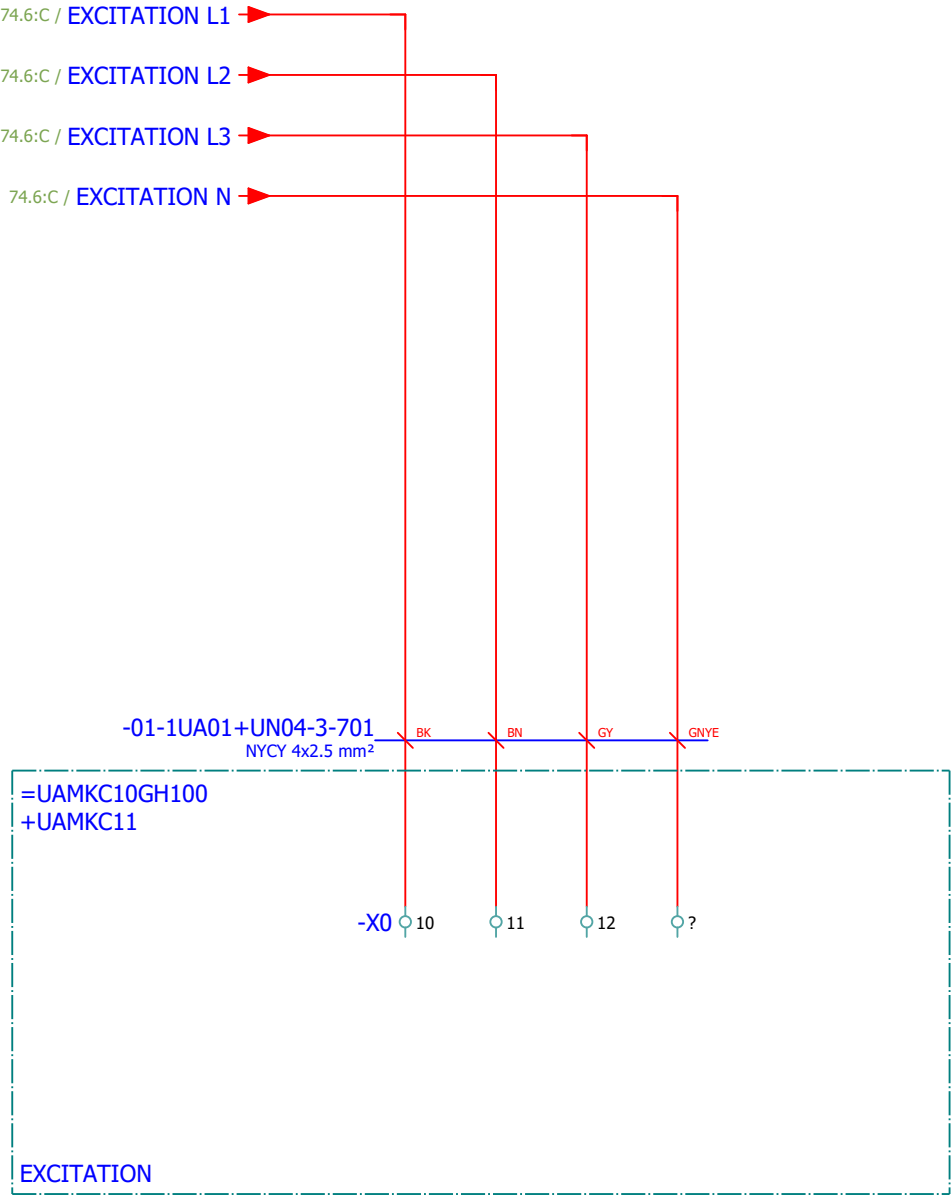

CONFIDENTIAL, ALL RIGHTS RESERVED DIN 34


Format ISO/DIN A3

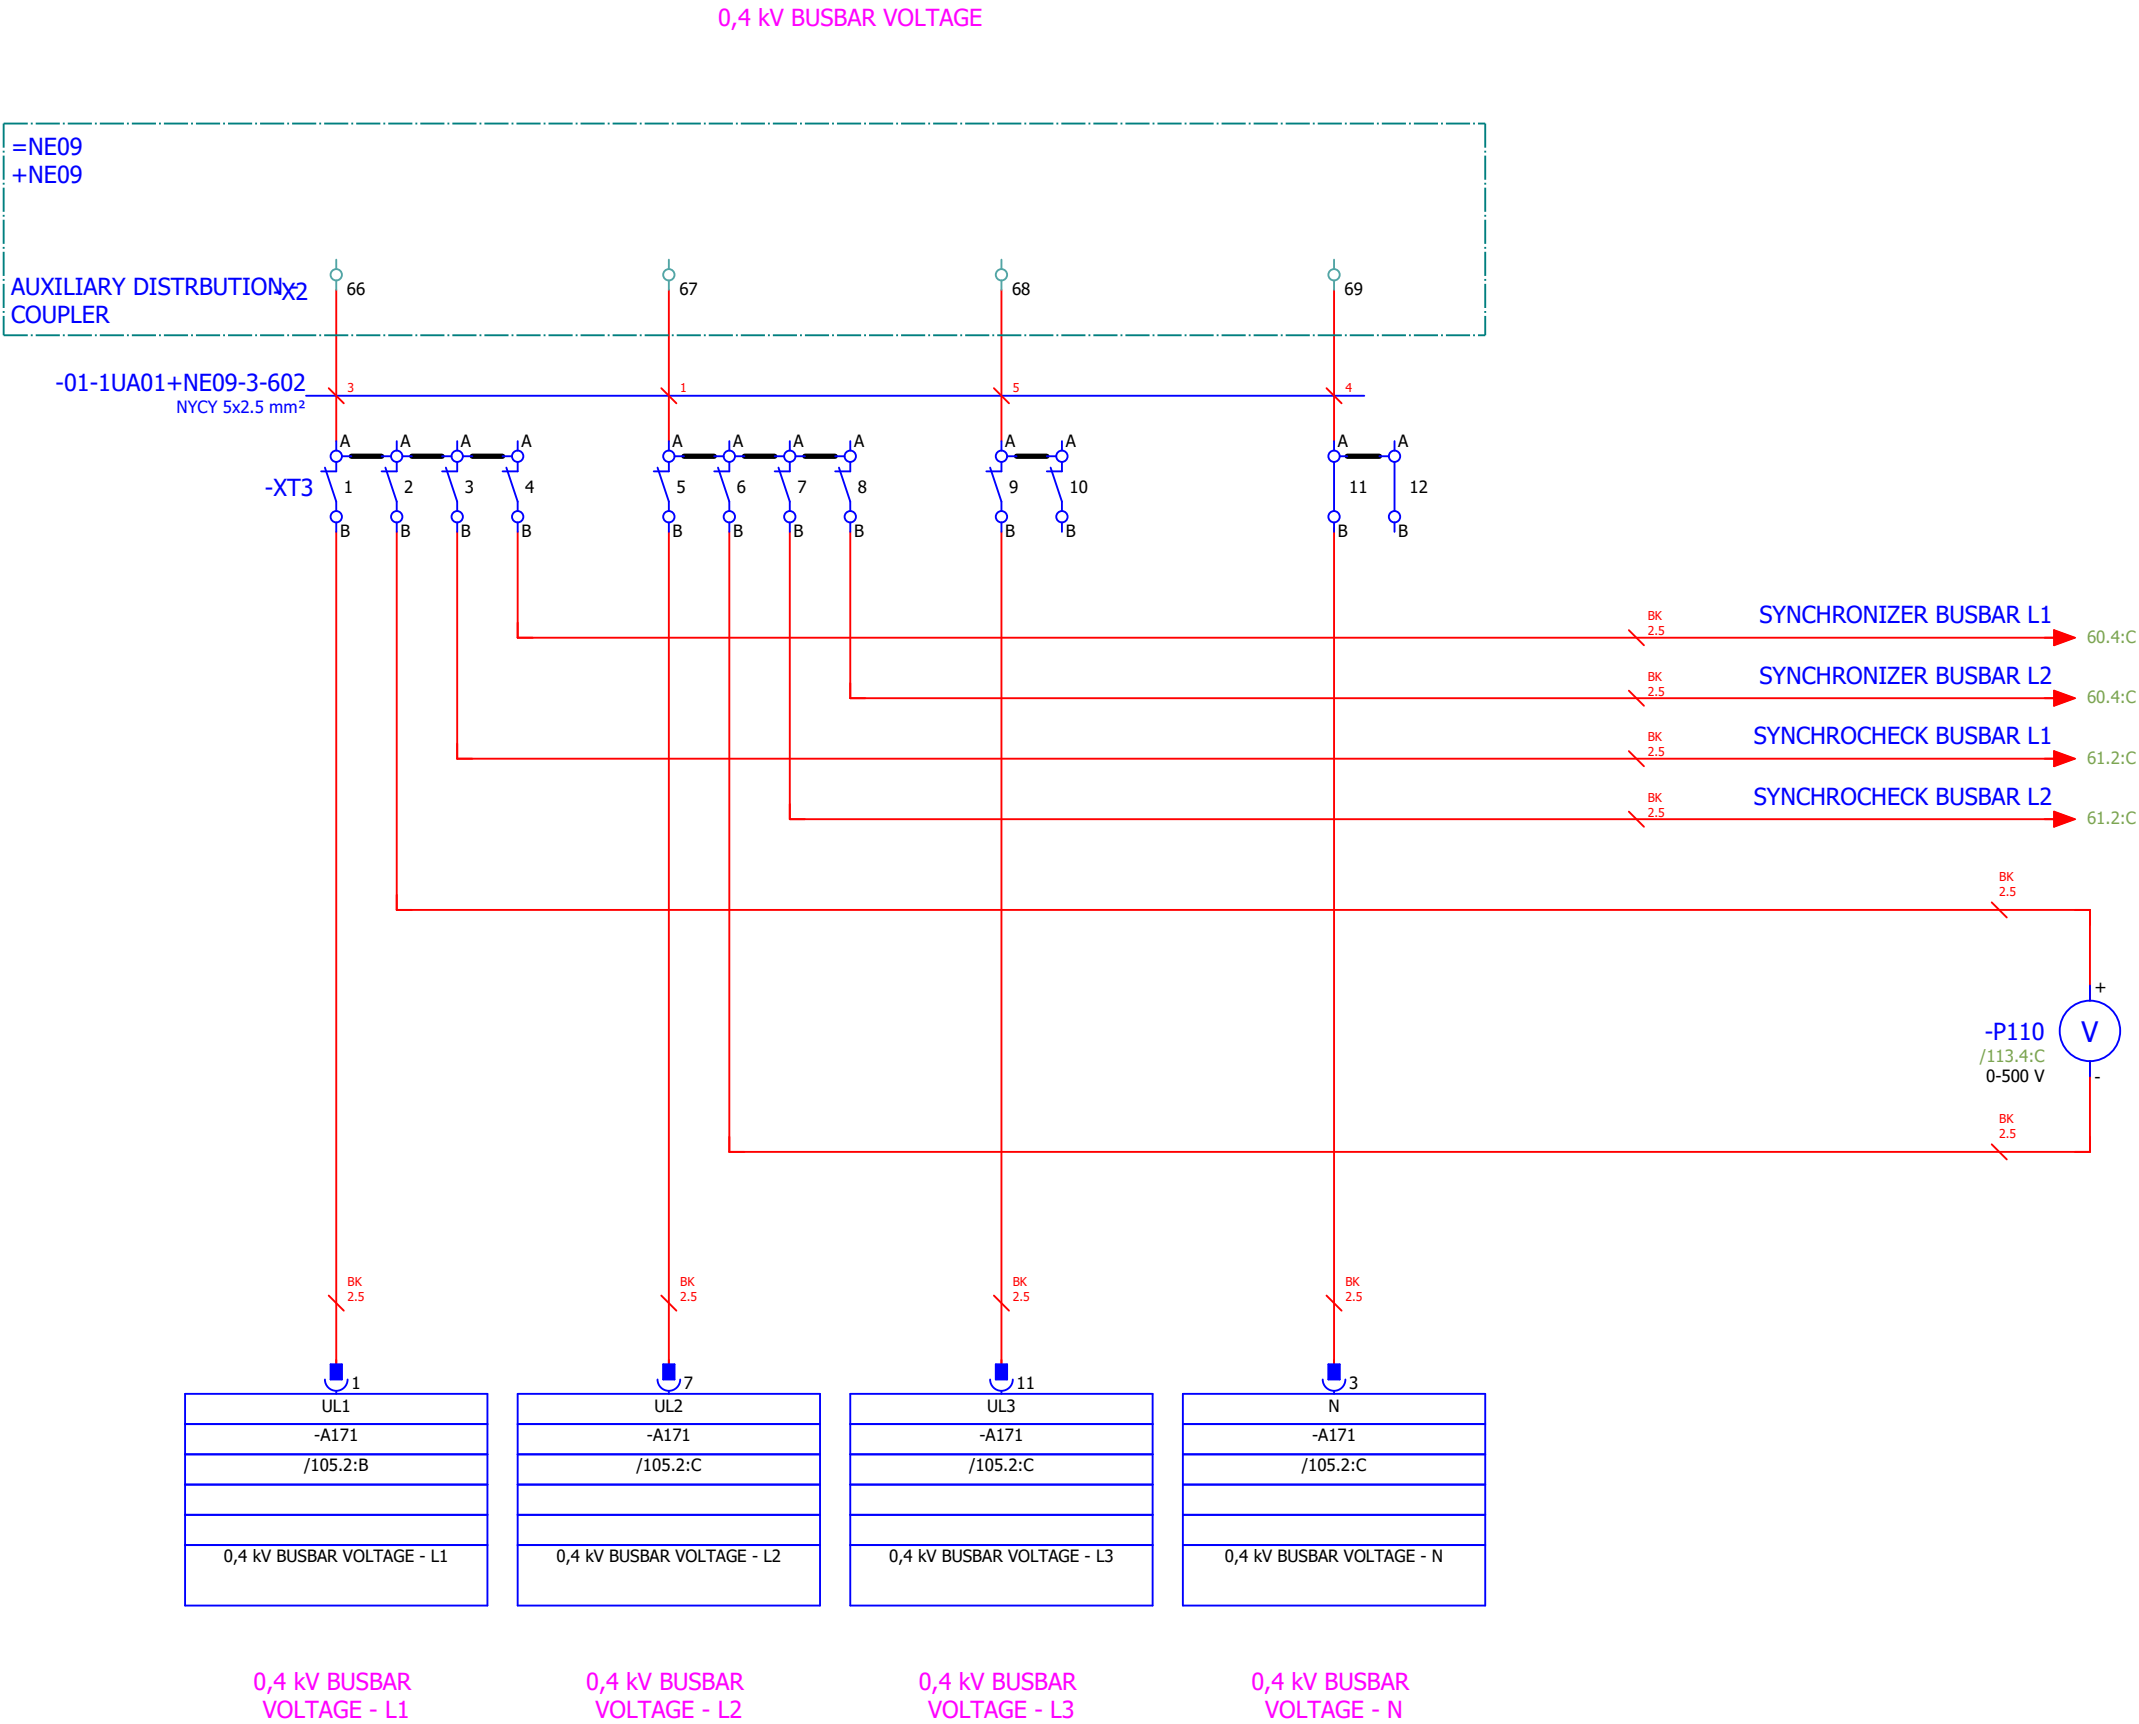

Approved by Contractor			Reconstruction and Modernisation of HPP Perucica - Phase II		 A Voith Company Sintaksa - A Voith Company Ulica Domovinskog rata 104C, 21 000 Split, Hrvatska	Unit KA1 control cubicle circuit diagrams VT CIRCUITS	DRAWING No.: PERU-01-19-170-31-001	REV No.: 02	= UACJA10GH100 + UACJA10
Approved by Designer	Grga Kolić	01.10.2026.					Designer No.:	SALES No.:	PAGE 76
Checked by	Antonio Aleksić	01.10.2026.							
Drawn by	Tamara Trogrlić	01.10.2026.							PAGE 76 / 156

CONFIDENTIAL, ALL RIGHTS RESERVED DIN 34

Format ISO/DIN A3

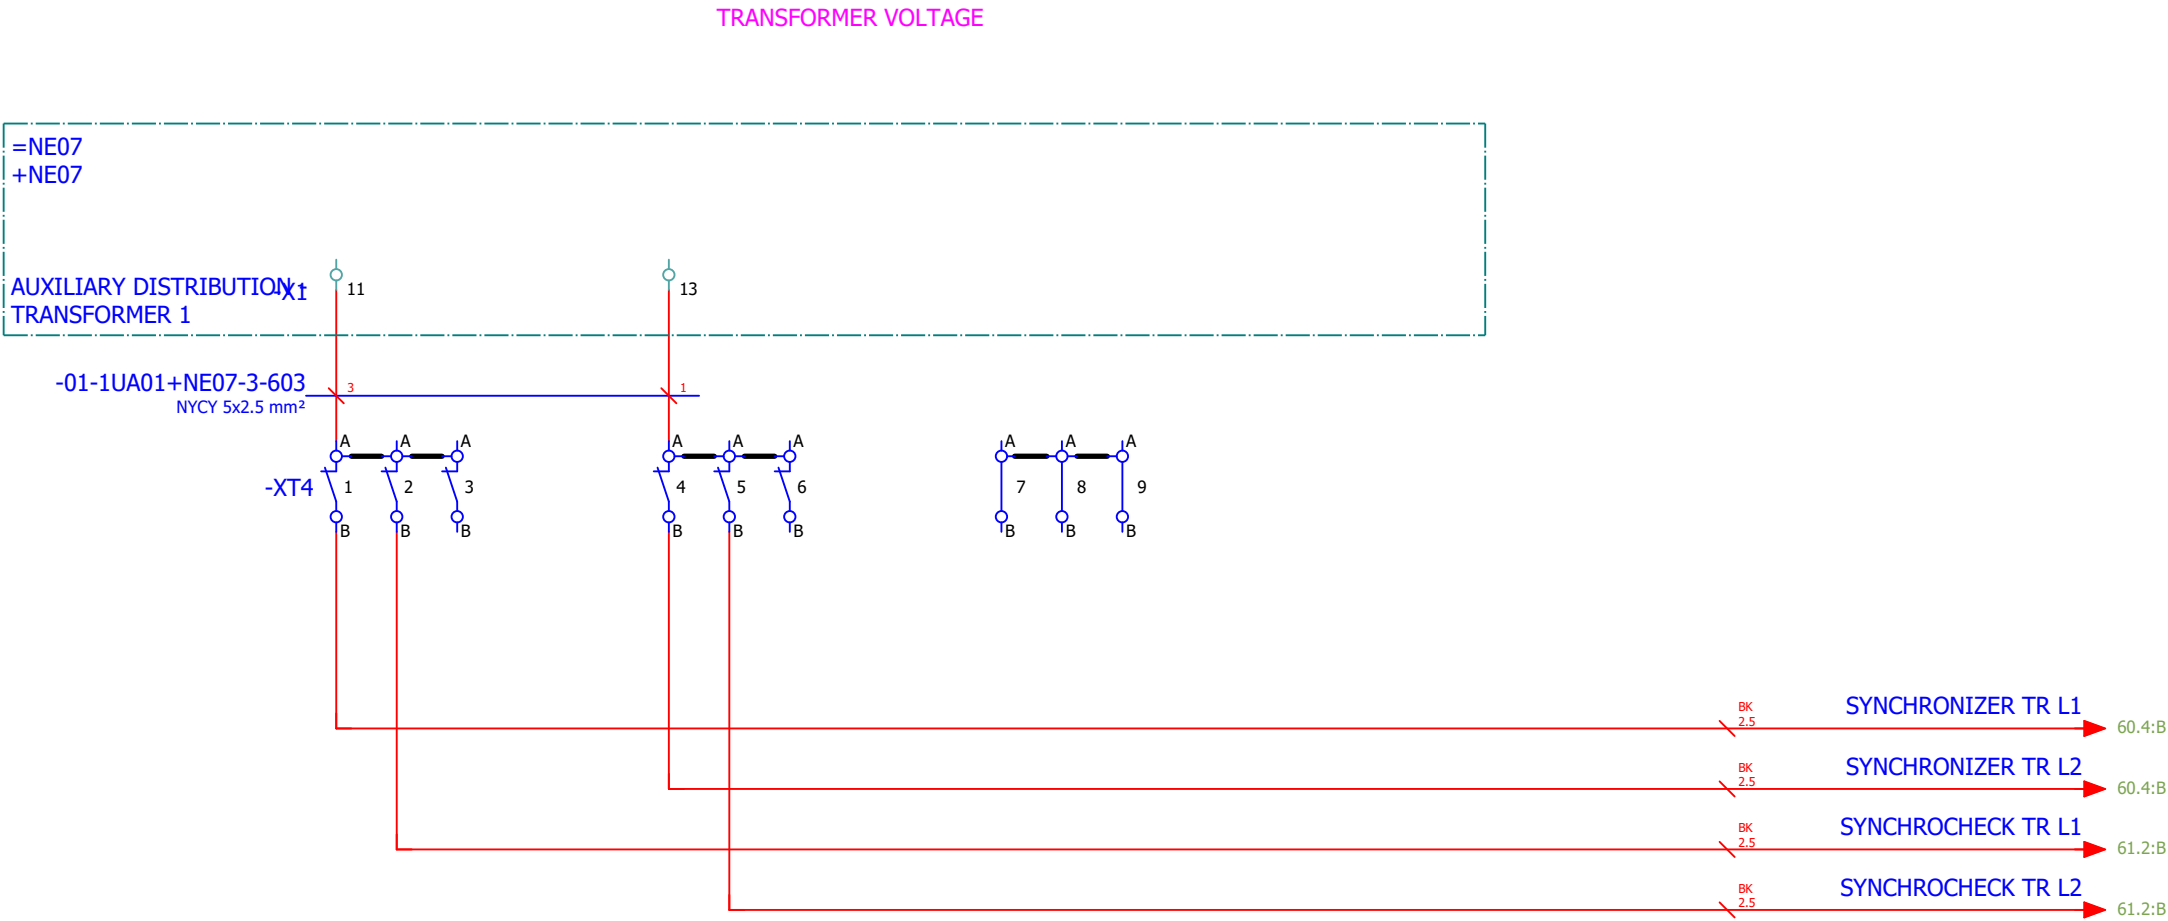


Approved by Contractor			Reconstruction and Modernisation of HPP Perucica - Phase II		 Sintaksa - A Voith Company Ulica Domovinskog rata 104C, 21 000 Split, Hrvatska	Unit KA1 control cubicle circuit diagrams VT CIRCUITS	DRAWING No.: PERU-01-19-170-31-001	REV No.: 02	= UACJA10GH100 + UACJA10
Approved by Designer	Grga Kolić	01.10.2026.					Designer No.:	SALES No.:	PAGE 77
Checked by	Antonio Aleksić	01.10.2026.							
Drawn by	Tamara Trogrlić	01.10.2026.							PAGE 77 / 156

CONFIDENTIAL, ALL RIGHTS RESERVED DIN 34

Format ISO/DIN A3

77

Approved by Contractor			Reconstruction and Modernisation of HPP Perucica - Phase II		 A Voith Company Sintaksa - A Voith Company Ulica Domovinskog rata 104C, 21 000 Split, Hrvatska	Unit KA1 control cubicle circuit diagrams SWITCH	DRAWING No.: PERU-01-19-170-31-001	REV No.: 02	= UACJA10GH100
Approved by Designer	Grga Kolić	01.10.2026.							+ UACJA10
Checked by	Antonio Aleksić	01.10.2026.					Designer No.:	SALES No.:	PAGE 78
Drawn by	Tamara Trogrlić	01.10.2026.							PAGE 78 / 156

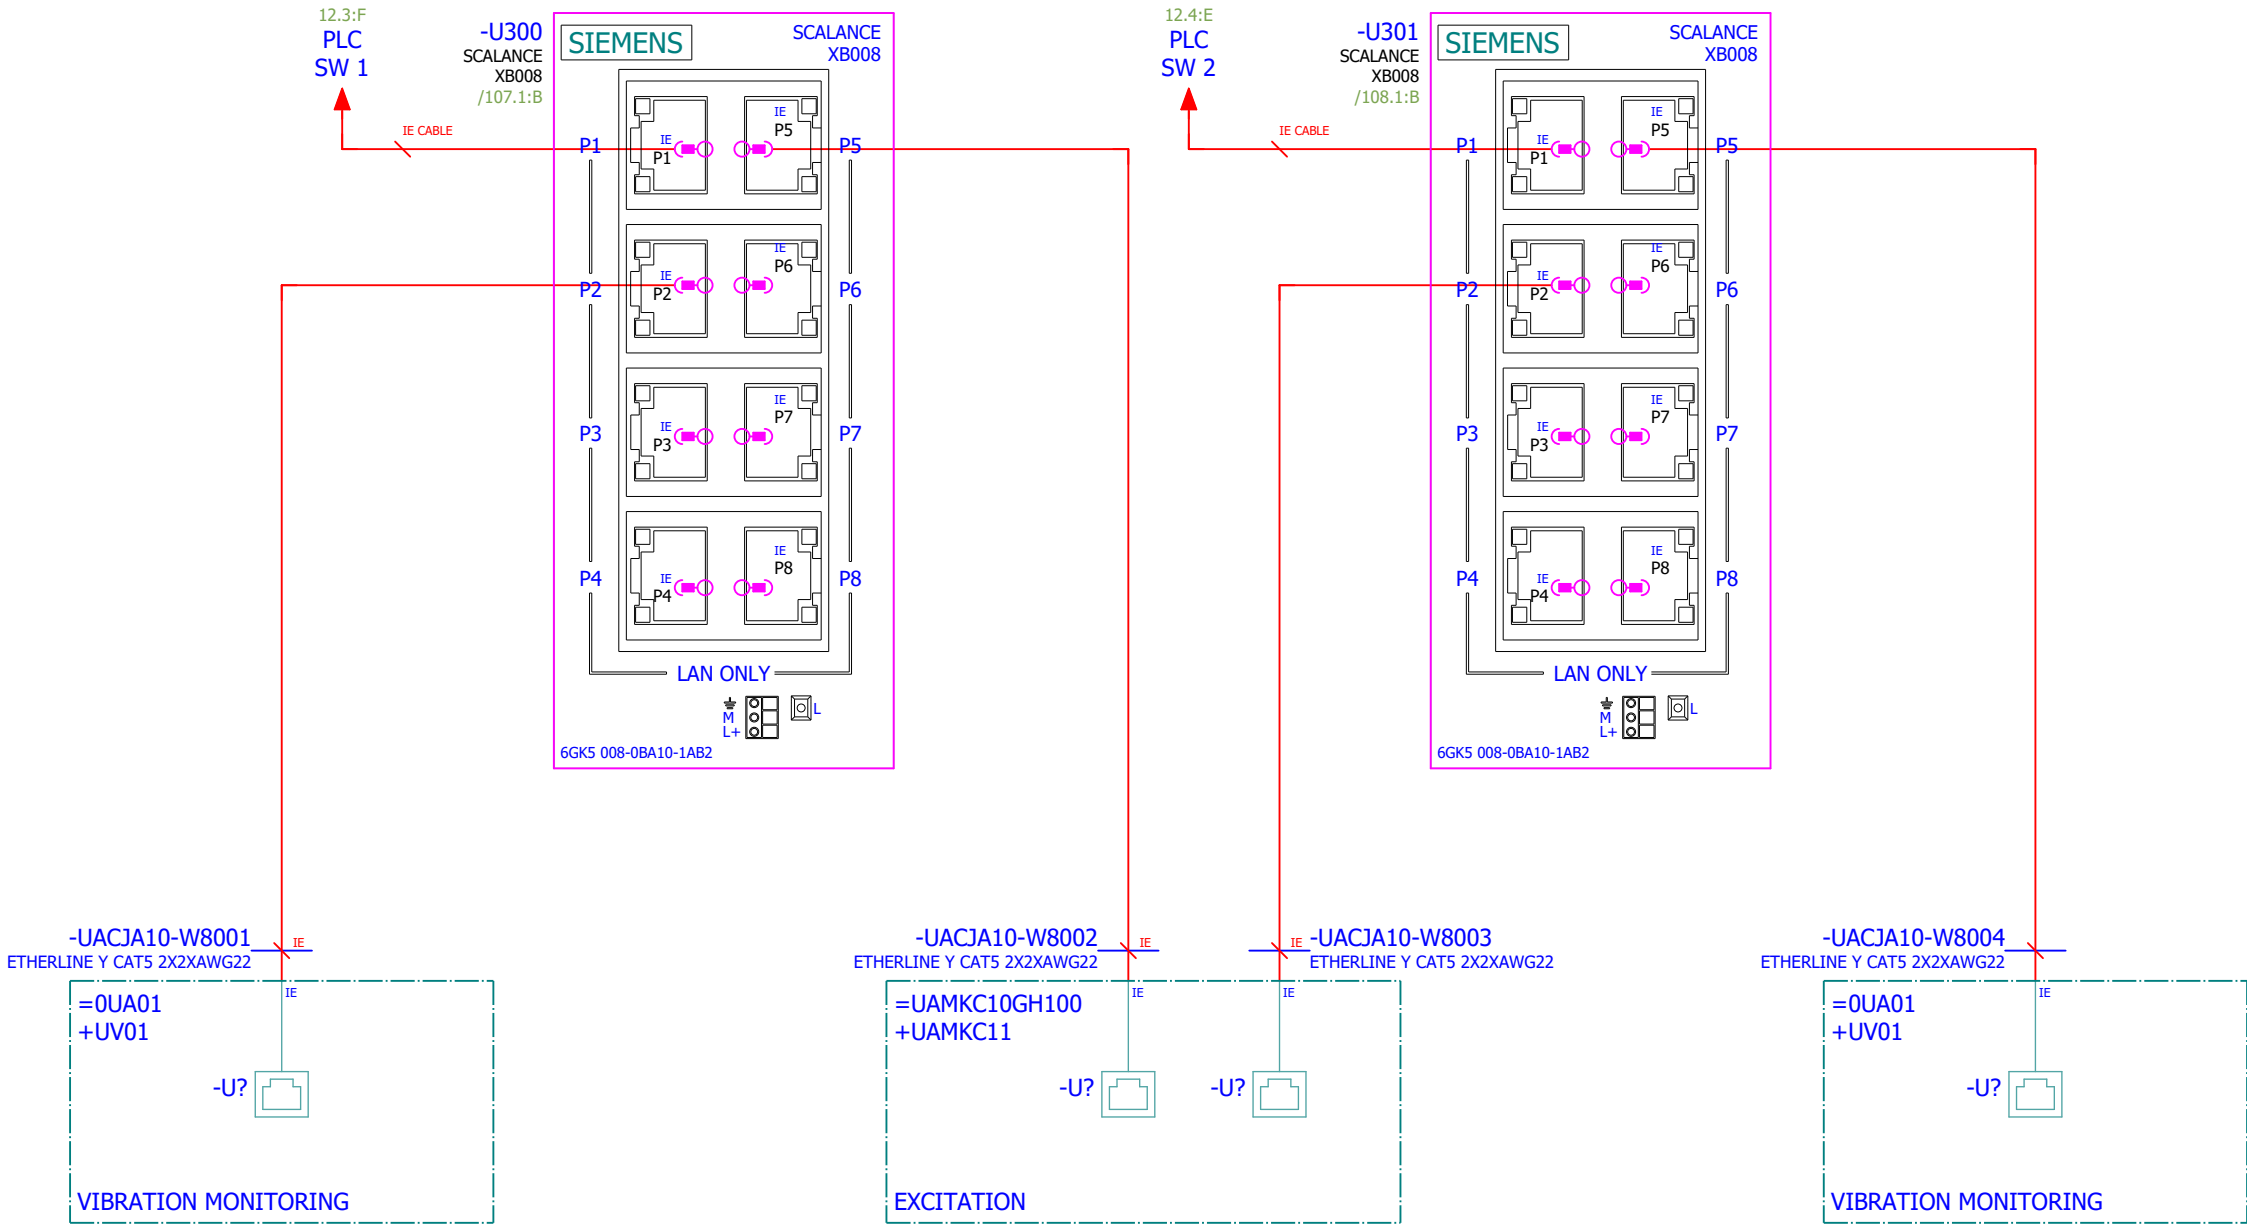


79

CONFIDENTIAL, ALL RIGHTS RESERVED DIN 34

Format ISO/DIN A3

78

Approved by Contractor			Reconstruction and Modernisation of HPP Perucica - Phase II		 A Voith Company Sintaksa - A Voith Company Ulica Domovinskog rata 104C, 21 000 Split, Hrvatska	Unit KA1 control cubicle circuit diagrams COMMUNICATION	DRAWING No.: PERU-01-19-170-31-001	REV No.: 02	= UACJA10GH100
Approved by Designer	Grga Kolić	01.10.2026.					Designer No.:	SALES No.:	+ UACJA10
Checked by	Antonio Aleksić	01.10.2026.							PAGE 79
Drawn by	Tamara Trogrlić	01.10.2026.							PAGE 79 / 156

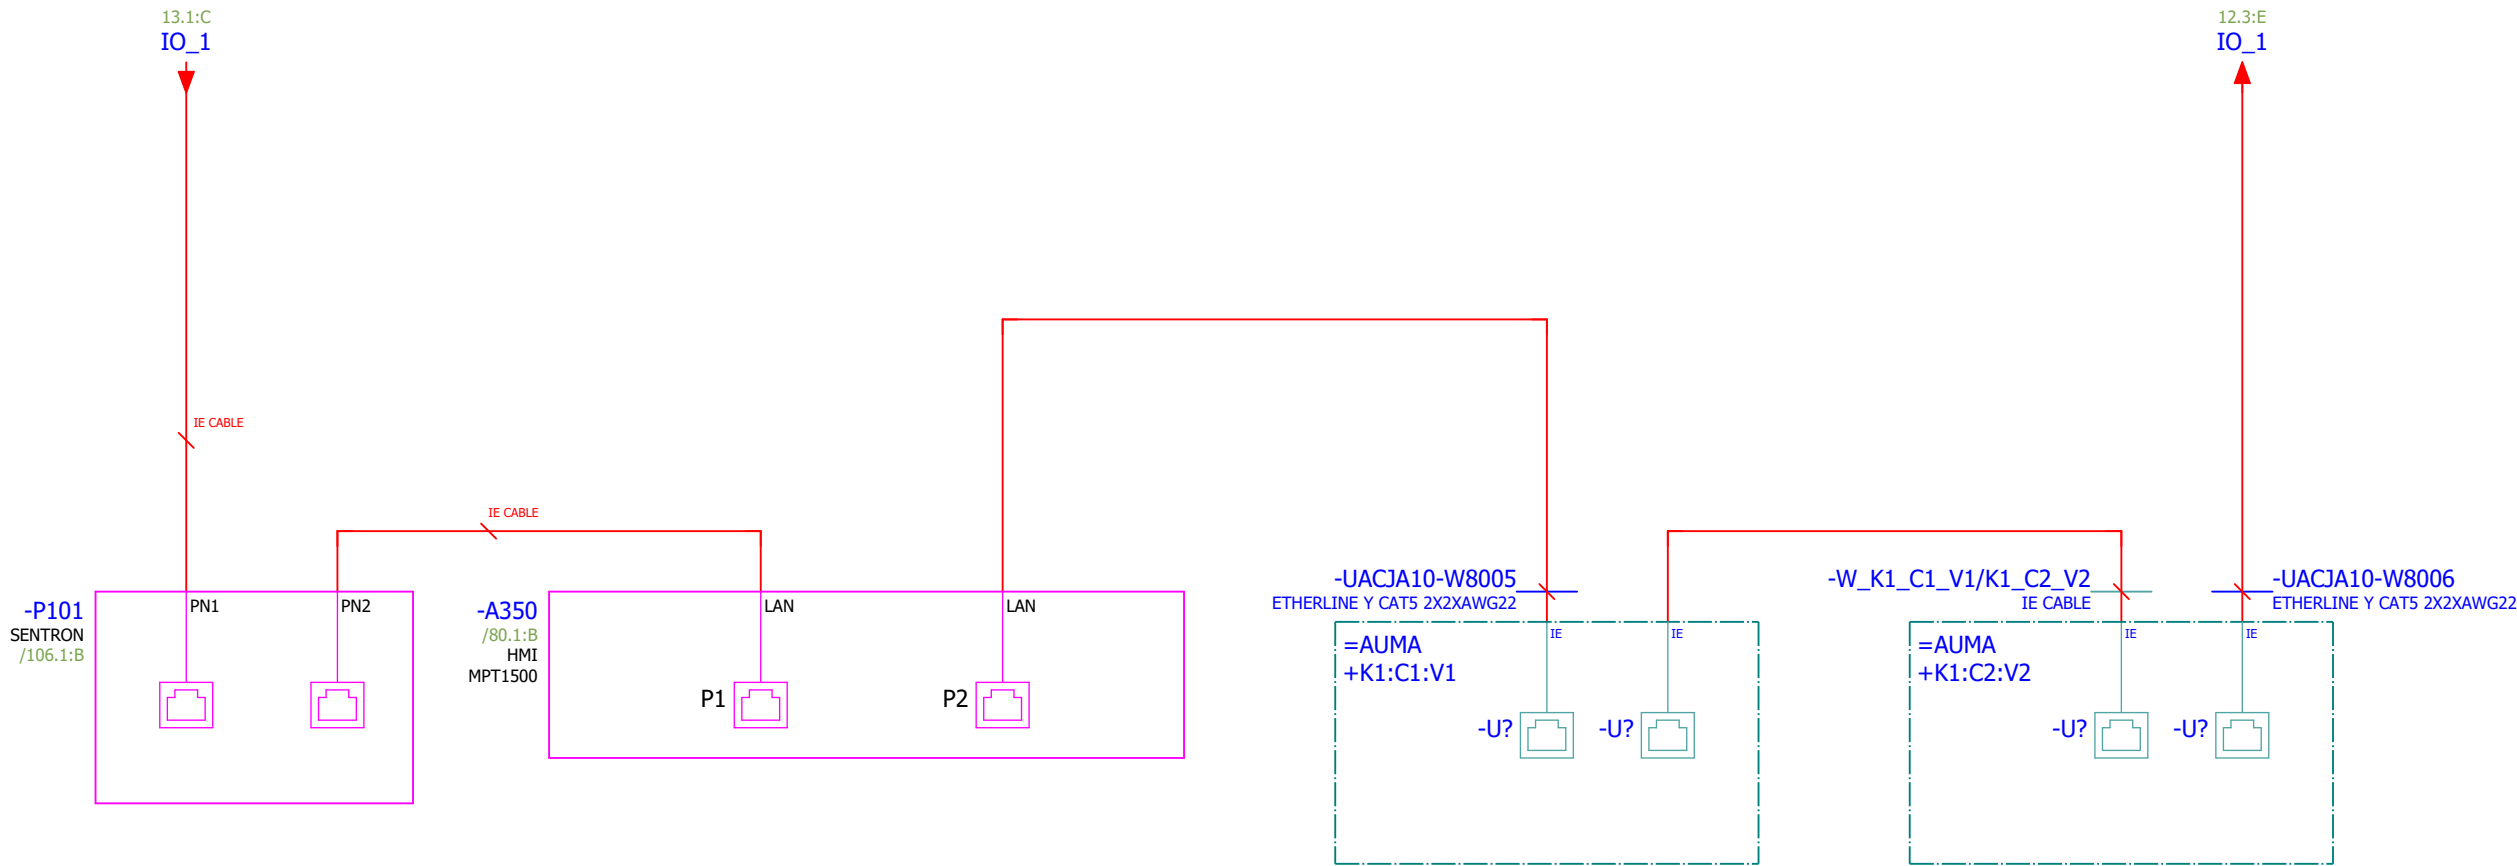

80

1		2		3		4		5		6		7		8					
A																A			
	Qty. (pcs)	Equipment technical description		Manufacturer	Location (= / +)	Designation (-)	Symbol Position in schematics (Page, column)												
B	1	SIMATIC HMI MTP1500 Unified Comfort SIMATIC HMI MTP1500, Unified Comfort Panel, touch operation, 15.6" widescreen TFT display, 16 million colors, PROFINET interface, configurable as of WinCC Unified Comfort V16, contains open-source software, which is provided free of charge see enclosed DVD 6AV2128-3QB06-0AX1 Memory card 6AV2181-8XP00-0AX0		Siemens	+UACJA10	-A350										B			
C	-A350 /79.3:E /9.4:E -X80:1 L+ /9.4:E -X80:2 M /9.5:E X1P1: /79.3:E X1P2: /79.4:E X2P1: X20: -X61: -X62: FE SIEMENS															C			
																D	D		
E																E			
F																F			
Format ISO/DIN A3																			
CONFIDENTIAL, ALL RIGHTS RESERVED DIN 34																			
Approved by Contractor				01.10.2026.		Reconstruction and Modernisation of HPP Perucica - Phase II				 Sintaksa - A Voith Company Ulica Domovinskog rata 104C, 21 000 Split, Hrvatska		Unit KA1 control cubicle circuit diagrams		DRAWING No.: PERU-01-19-170-31-001		REV No.: 02		= UACJA10GH100 + UACJA10	
Approved by Designer		Grga Kolić		01.10.2026.								HMI - TOUCH PANEL		Designer No.:		SALES No.:		PAGE 80	
Checked by		Antonio Aleksić		01.10.2026.															
Drawn by		Tamara Trogrlić		01.10.2026.		PROJECT NAME		EMPLOYER		DESIGNER								PAGE 80 / 156	
1		2		3		4		5		6		7		8					

B

1	2	3	4	5	6	7	8
---	---	---	---	---	---	---	---

		1	2	3	4	5	6	7	8		
A										A	
	Qty. (pcs)	Equipment technical description	Manufacturer	Location (= / +)	Designation (-)	Symbol Position in schematics (Page, column)					
B	1	CM 1542-1 Communications module CM 1542-1 for connection of S7-1500 to PROFINET as IO Controller or IO Device: TCP/IP, ISO-on-TCP, UDP, S7 communication, IP broadcast multicast, SNMPV1, time-of-day synchronization via NTP, 2xRJ45 (10/100 Mbit). 6GK7542-1AX10-0XE0	Siemens	+UACJA10	-A103					B	
C	-A103 /12.3:B X1P1: X1P2: SIEMENS									C	
										D	
E										E	
F										F	
Format ISO/DIN A3											
82											
84											
Approved by Contractor			01.10.2026.	Reconstruction and Modernisation of HPP Perucica - Phase II		 A Voith Company	Unit KA1 control cubicle circuit diagrams		DRAWING No.: PERU-01-19-170-31-001	REV No.: 02	= UACJA10GH100 + UACJA10
Approved by Designer		Grga Kolić					01.10.2026.	PLC OVERVIEW		Designer No.:	SALES No.:
Checked by		Antonio Aleksić	01.10.2026.	PROJECT NAME		EMPLOYER	DESIGNER			PAGE 83 / 156	
Drawn by		Tamara Trogrić	01.10.2026.								
		1	2	3	4	5	6	7	8		

CONFIDENTIAL, ALL RIGHTS RESERVED DIN 34

Format ISO/DIN A3

83

85

Approved by Contractor			Reconstruction and Modernisation of HPP Perucica - Phase II		 A Voith Company Sintaksa - A Voith Company Ulica Domovinskog rata 104C, 21 000 Split, Hrvatska	Unit KA1 control cubicle circuit diagrams PLC OVERVIEW COMM.	DRAWING No.: PERU-01-19-170-31-001	REV No.: 02	= UACJA10GH100 + UACJA10
Approved by Designer	Grga Kolić	01.10.2026.					Designer No.:	SALES No.:	PAGE 84
Checked by	Antonio Aleksić	01.10.2026.	PROJECT NAME	EMPLOYER	DESIGNER				PAGE 84 / 156
Drawn by	Tamara Trogrlić	01.10.2026.							

CONFIDENTIAL, ALL RIGHTS RESERVED DIN 34

Format ISO/DIN A3

83

85

Approved by Contractor			Reconstruction and Modernisation of HPP Perucica - Phase II		 A Voith Company Sintaksa - A Voith Company Ulica Domovinskog rata 104C, 21 000 Split, Hrvatska	Unit KA1 control cubicle circuit diagrams PLC OVERVIEW COMM.	DRAWING No.: PERU-01-19-170-31-001	REV No.: 02	= UACJA10GH100 + UACJA10
Approved by Designer	Grga Kolić	01.10.2026.					Designer No.:	SALES No.:	PAGE 84
Checked by	Antonio Aleksić	01.10.2026.	PROJECT NAME	EMPLOYER	DESIGNER				PAGE 84 / 156
Drawn by	Tamara Trogrlić	01.10.2026.							

CONFIDENTIAL, ALL RIGHTS RESERVED DIN 34

86

B

B

E

1		2		3		4		5		6		7		8																																																																									
Qty. (pcs)	Equipment technical description			Manufacturer		Location (= / +)		Designation (-)		Symbol Position in schematics (Page, column)																																																																													
1	Digital input module ET 200SP			Siemens		+UACJA10		-A112																																																																															
	DI 16X24V DC Standard type 3 (IEC 61131); sink input; fits to BU-type A0 input delay time 0,05..20ms; Diagnostics: wire break, supply voltage 6ES7131-6BH01-0BA0 BaseUnit BU15-P16+A0+2B 6ES7193-6BP00-0BA0																																																																																						
-A112 /13.4:B  <table><tr><td></td><td>I2.0</td><td>/18.1:E</td><td>GCB OFF COMMAND</td></tr><tr><td></td><td>I2.1</td><td>/18.2:E</td><td>GCB ON COMMAND</td></tr><tr><td></td><td>I2.2</td><td>/18.3:E</td><td>SPEED SETPOINT UP</td></tr><tr><td></td><td>I2.3</td><td>/18.4:E</td><td>SPEED SETPOINT DN</td></tr><tr><td></td><td>I2.4</td><td>/18.5:E</td><td>DC CONVERTER 1 OK</td></tr><tr><td></td><td>I2.5</td><td>/18.6:E</td><td>DC CONVERTER 2 OK</td></tr><tr><td></td><td>I2.6</td><td>/18.7:E</td><td>SPARE</td></tr><tr><td></td><td>I2.7</td><td>/18.8:E</td><td>OVERSPEED RELAY TRIP OK</td></tr><tr><td></td><td>I3.0</td><td>/19.1:E</td><td>GENERATOR PROTECTION ESD RELAY TRIP</td></tr><tr><td></td><td>I3.1</td><td>/19.2:E</td><td>GCB SYNCHRONIZATION NOT SELECTED FEEDBACK</td></tr><tr><td></td><td>I3.2</td><td>/19.3:E</td><td>TRANSFORMER CB SYNCHRONIZATION NOT SELECTED FEEDBACK</td></tr><tr><td></td><td>I3.3</td><td>/19.4:E</td><td>GCB CLOSE COMMAND FEEDBACK</td></tr><tr><td></td><td>I3.4</td><td>/19.5:E</td><td>TRANSFORMER CB CLOSE COMMAND FEEDBACK</td></tr><tr><td></td><td>I3.5</td><td>/19.6:E</td><td>220 VDC MCB TRIP GROUP OK</td></tr><tr><td></td><td>I3.6</td><td>/19.7:E</td><td>24 VDC MCB ALARM GROUP OK</td></tr><tr><td></td><td>I3.7</td><td>/19.8:E</td><td>24 VDC MCB TRIP GROUP OK</td></tr><tr><td></td><td>L+</td><td>/13.4:D</td><td></td></tr><tr><td></td><td>M</td><td>/13.4:D</td><td></td></tr></table>																	I2.0	/18.1:E	GCB OFF COMMAND		I2.1	/18.2:E	GCB ON COMMAND		I2.2	/18.3:E	SPEED SETPOINT UP		I2.3	/18.4:E	SPEED SETPOINT DN		I2.4	/18.5:E	DC CONVERTER 1 OK		I2.5	/18.6:E	DC CONVERTER 2 OK		I2.6	/18.7:E	SPARE		I2.7	/18.8:E	OVERSPEED RELAY TRIP OK		I3.0	/19.1:E	GENERATOR PROTECTION ESD RELAY TRIP		I3.1	/19.2:E	GCB SYNCHRONIZATION NOT SELECTED FEEDBACK		I3.2	/19.3:E	TRANSFORMER CB SYNCHRONIZATION NOT SELECTED FEEDBACK		I3.3	/19.4:E	GCB CLOSE COMMAND FEEDBACK		I3.4	/19.5:E	TRANSFORMER CB CLOSE COMMAND FEEDBACK		I3.5	/19.6:E	220 VDC MCB TRIP GROUP OK		I3.6	/19.7:E	24 VDC MCB ALARM GROUP OK		I3.7	/19.8:E	24 VDC MCB TRIP GROUP OK		L+	/13.4:D			M	/13.4:D	
	I2.0	/18.1:E	GCB OFF COMMAND																																																																																				
	I2.1	/18.2:E	GCB ON COMMAND																																																																																				
	I2.2	/18.3:E	SPEED SETPOINT UP																																																																																				
	I2.3	/18.4:E	SPEED SETPOINT DN																																																																																				
	I2.4	/18.5:E	DC CONVERTER 1 OK																																																																																				
	I2.5	/18.6:E	DC CONVERTER 2 OK																																																																																				
	I2.6	/18.7:E	SPARE																																																																																				
	I2.7	/18.8:E	OVERSPEED RELAY TRIP OK																																																																																				
	I3.0	/19.1:E	GENERATOR PROTECTION ESD RELAY TRIP																																																																																				
	I3.1	/19.2:E	GCB SYNCHRONIZATION NOT SELECTED FEEDBACK																																																																																				
	I3.2	/19.3:E	TRANSFORMER CB SYNCHRONIZATION NOT SELECTED FEEDBACK																																																																																				
	I3.3	/19.4:E	GCB CLOSE COMMAND FEEDBACK																																																																																				
	I3.4	/19.5:E	TRANSFORMER CB CLOSE COMMAND FEEDBACK																																																																																				
	I3.5	/19.6:E	220 VDC MCB TRIP GROUP OK																																																																																				
	I3.6	/19.7:E	24 VDC MCB ALARM GROUP OK																																																																																				
	I3.7	/19.8:E	24 VDC MCB TRIP GROUP OK																																																																																				
	L+	/13.4:D																																																																																					
	M	/13.4:D																																																																																					
87																																																																																							
Approved by Contractor			Reconstruction and Modernisation of HPP Perucica - Phase II				 A Voith Company Sintaksa - A Voith Company Ulica Domovinskog rata 104C, 21 000 Split, Hrvatska		Unit KA1 control cubicle circuit diagrams PLC OVERVIEW DI		DRAWING No.:		REV No.:		= UACJA10GH100																																																																								
Approved by Designer		Grga Kolić									01.10.2026.		PERU-01-19-170-31-001		02		+ UACJA10																																																																						
Checked by		Antonio Aleksić									01.10.2026.		Designer No.:		SALES No.:		PAGE 88																																																																						
Drawn by		Tamara Trogrlić	01.10.2026.		PROJECT NAME		EMPLOYER		DESIGNER		PAGE 88 / 156																																																																												
89																																																																																							

1

2

3

4

5

6

7

8

Qty.
(pcs)

Equipment technical description

Manufacturer

Location
(= / +)

Designation
(-)

Symbol
Position in schematics (Page, column)

1

Digital input module ET 200SP

DI 16X24V DC Standard
type 3 (IEC 61131); sink input; fits to BU-type A0
input delay time 0,05..20ms; Diagnostics: wire break,
supply voltage
6ES7131-6BH01-0BA0
BaseUnit BU15-P16+A0+2B
6ES7193-6BP00-0BA0

Siemens

+UACJA10

-A117

-A117
/13.6:B



I12.0

1

D10

I12.1

2

D11

I12.2

3

D12

I12.3

4

D13

I12.4

5

D14

I12.5

6

D15

I12.6

7

D16

I12.7

8

D17

I13.0

9

D18

I13.1

10

D19

I13.2

11

D110

I13.3

12

D111

I13.4

13

D112

I13.5

14

D113

I13.6

15

D114

I13.7

16

D115

L+

24VDC

M

0VDC

/28.1:E

SPARE

/28.2:E

SPARE

/28.3:E

EXCITATION CIRCUIT BREAKER OPEN

/28.4:E

EXCITATION CIRCUIT BREAKER CLOSED

/28.5:E

EXCITATION ESD PUSHBUTTON PRESSED

/28.6:E

EXCITATION THYRICON CRITICAL FAULT

/28.7:E

EXCITATION 24 V SIGNAL VOLTAGE FAULT

/28.8:E

EXCITATION ALARM OK

/29.1:E

SPARE

/29.2:E

SPARE

/29.3:E

HPU AC PUMP 1 AUTO

/29.4:E

HPU AC PUMP 1 NOT READY

/29.5:E

HPU DC PUMP AUTO

/29.6:E

HPU DC PUMP NOT READY

/29.7:E

HPU AC PUMP 2 AUTO

/29.8:E

HPU AC PUMP 2 NOT READY

/13.6:D

/13.6:D

Approved by Contractor

Approved by Designer

Checked by

Drawn by

Grga Kolić

Antonio Aleksić

Tamara Trogrlić

01.10.2026.

01.10.2026.

01.10.2026.

Reconstruction and Modernisation
of HPP Perucica - Phase II

PROJECT NAME



EMPLOYER


A Voith Company
Sintaksa - A Voith Company
Ulica Domovinskog rata 104C, 21 000 Split, Hrvatska

DESIGNER

Unit KA1 control cubicle circuit diagrams

PLC OVERVIEW DI

DRAWING No.:
PERU-01-19-170-31-001

Designer No.:

REV No.:
02

SALES No.:

= UACJA10GH100
+ UACJA10

PAGE
93 / 156

1

2

3

4


5

6

7

8

Qty. (pcs)	Equipment technical description	Manufacturer	Location (= / +)	Designation (-)	Symbol Position in schematics (Page, column)
1	Analog input module SIMATIC ET 200SP AI 4XI 2-/4-WIRE Standard fits to BU-TYPE A0, A1 Module diagnosis, 16 bit, +/-0,3% 6ES7134-6GD01-0BA1 BaseUnit BU15-P16+A0+2D 6ES7193-6BP00-0DA0	Siemens	+UACJA10	-A141	

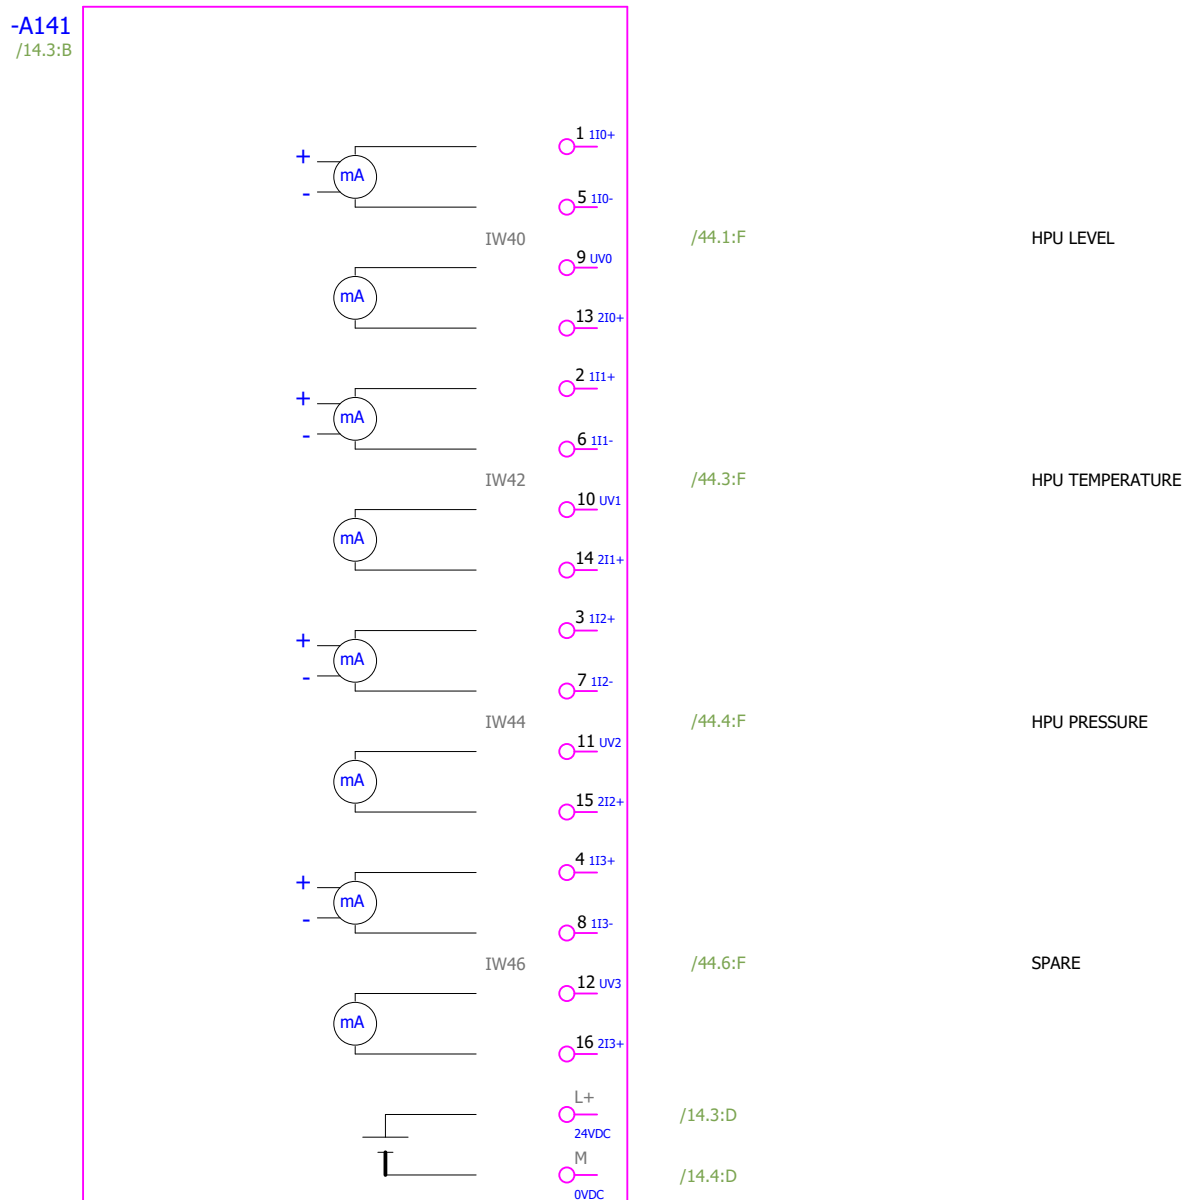

1103

CONFIDENTIAL, ALL RIGHTS RESERVED DIN 34

Format ISO/DIN A3


102

104

Approved by Contractor			Reconstruction and Modernisation of HPP Perucica - Phase II		 A Voith Company Sintaksa - A Voith Company Ulica Domovinskog rata 104C, 21 000 Split, Hrvatska	Unit KA1 control cubicle circuit diagrams PLC OVERVIEW AI 2XI	DRAWING No.: PERU-01-19-170-31-001	REV No.: 02	= UACJA10GH100 + UACJA10
Approved by Designer	Grga Kolić	01.10.2026.					Designer No.:	SALES No.:	PAGE 103
Checked by	Antonio Aleksić	01.10.2026.	PROJECT NAME	EMPLOYER	DESIGNER				PAGE 103 / 156
Drawn by	Tamara Trogrlić	01.10.2026.							

Qty. (pcs)	Equipment technical description	Manufacturer	Location (= / +)	Designation (-)	Symbol Position in schematics (Page, column)
1	Analog input module for ET 200SP Analog input module for ET200SP, Type: AI 2XI 2-/4-WIRE Standard 6ES7134-6GB00-0BA1 BaseUnit BU15-P16+A0+2B 6ES7193-6BP00-0BA0	Siemens	+UACJA10	-A152	

-A152
/14.4:B

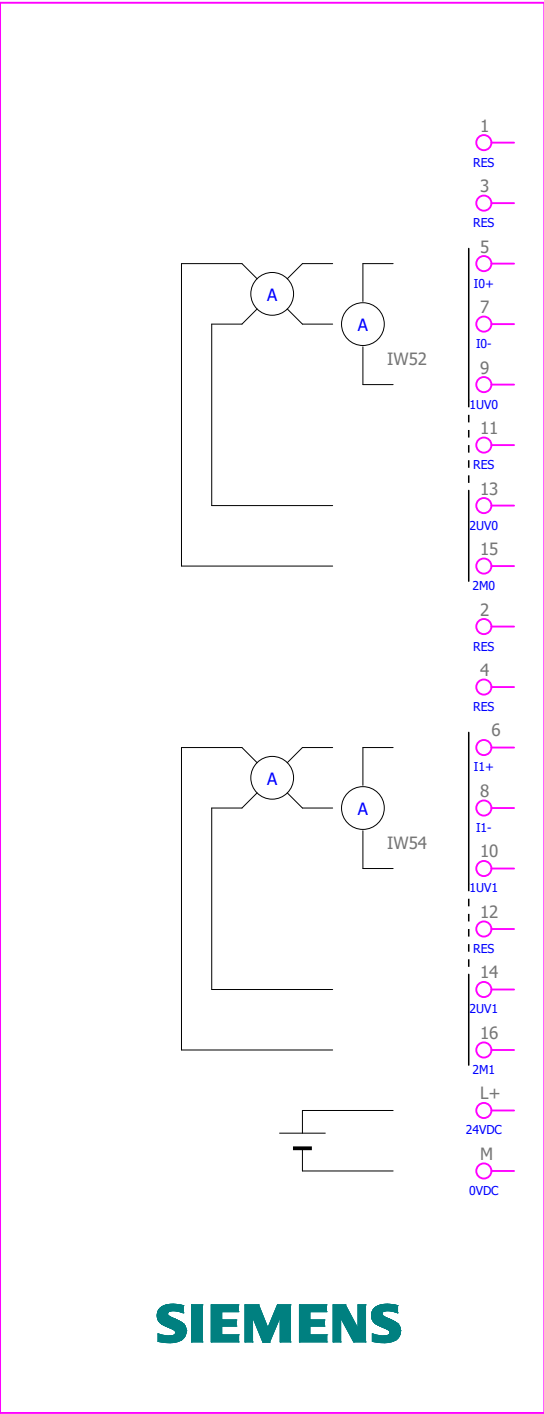

SIEMENS

103

Format ISO/DIN A3

CONFIDENTIAL, ALL RIGHTS RESERVED DIN 34


1	2	3	4	5	6	7	8
Qty. (pcs)	Equipment technical description	Manufacturer	Location (= / +)	Designation (-)	Symbol Position in schematics (Page, column)		
1	Analog output module SIMATIC ET 200SP, Analog output module, AQ 4XU/I Standard, suitable for BU type A0, A1, Color code CC00, Module diagnostics, 16 bit, +/-0.3% 6ES7135-6HD00-0BA1 BaseUnit BU15-P16+A0+2B 6ES7193-6BP00-0BA0	Siemens	+UACJA10	-A161			

-A161
/14.5:B

CONFIDENTIAL, ALL RIGHTS RESERVED DIN 34

Format ISO/DIN A3

-A161
/14.5:B

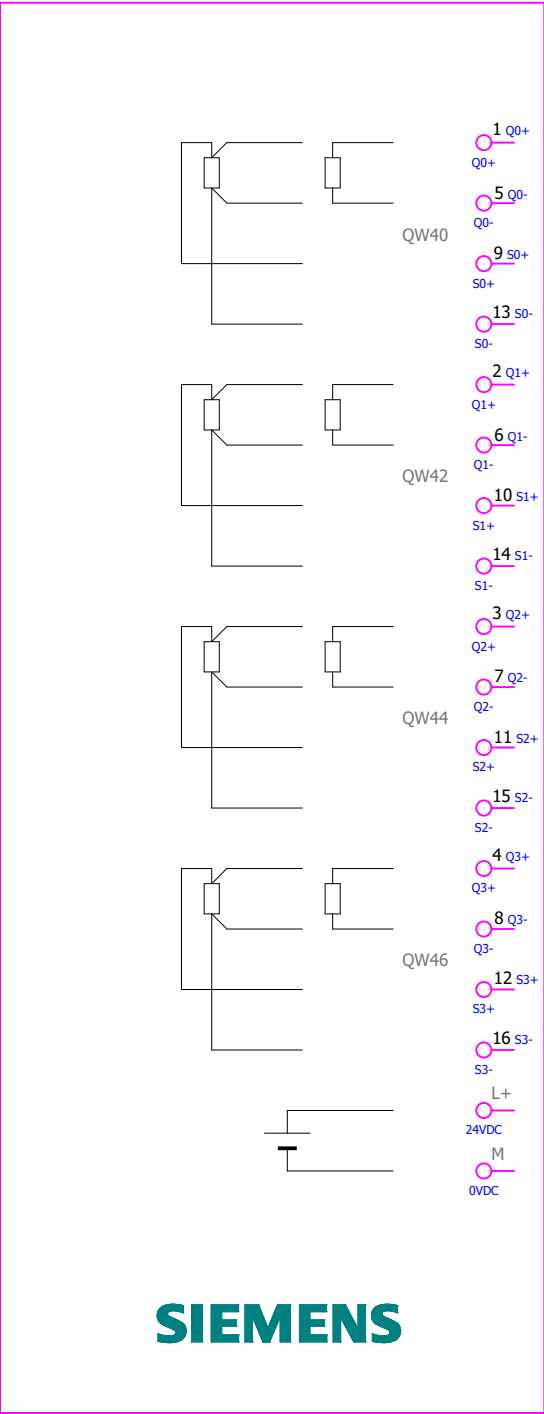

CONFIDENTIAL, ALL RIGHTS RESERVED DIN 34

/DIM/

106

108

CONFIDENTIAL, ALL RIGHTS RESERVED DIN 34

Format ISO/DIN A3

1	2	3	4	5	6	7	8
Qty. (pcs)	Equipment technical description	Manufacturer	Location (= / +)	Designation (-)	Symbol Position in schematics (Page, column)		
1	Ethernet switch 24 V DC 8x 10/100 Mbit/s twisted pair ports with RJ45 sockets LED diagnostics Type: Scalance XB008 Order No.: 6GK5008-0BA10-1AB2 6GK5008-0BA10-1AB2	Siemens	+UACJA10	-U300			
-U300 /9.1:E /78.3:B P1 /78.3:B P2 /78.3:C P3 /78.3:C P4 /78.3:D P5 /78.3:B P6 /78.3:C P7 /78.3:C P8 /78.3:D 1/GND 1 /9.2:E 2/M 2 /9.2:E 3 /9.1:E							

Approved by Contractor			Reconstruction and Modernisation of HPP Perucica - Phase II		 A Voith Company Sintaksa - A Voith Company Ulica Domovinskog rata 104C, 21 000 Split, Hrvatska	Unit KA1 control cubicle circuit diagrams SWITCH 1	DRAWING No.:	REV No.:	= UACJA10GH100
Approved by Designer	Grga Kolić	01.10.2026.					PERU-01-19-170-31-001	02	+ UACJA10
Checked by	Antonio Aleksić	01.10.2026.					Designer No.:	SALES No.:	PAGE 107
Drawn by	Tamara Trogrlić	01.10.2026.					PROJECT NAME	EMPLOYER	DESIGNER
1	2	3	4	5	6	7	8		

107

CONFIDENTIAL, ALL RIGHTS RESERVED DIN 34

Format ISO/DIN A3

1	2	3	4	5	6	7	8
Qty. (pcs)	Equipment technical description	Manufacturer	Location (= / +)	Designation (-)	Symbol Position in schematics (Page, column)		
1	Ethernet switch 24 V DC 8x 10/100 Mbit/s twisted pair ports with RJ45 sockets LED diagnostics Type: Scalance XB008 Order No.: 6GK5008-0BA10-1AB2 6GK5008-0BA10-1AB2	Siemens	+UACJA10	-U301			
-U301 /9.2:E /78.5:B P1 /78.5:B P2 /78.5:C P3 /78.5:C P4 /78.5:D P5 /78.5:B P6 /78.5:C P7 /78.5:C P8 /78.5:D 1/GND 1 /9.3:E 2/M 2 /9.3:E 3 /9.2:E							

109

Unit KA1 control cubicle circuit diagrams

SWITCH 2

Approved by Contractor

Approved by Designer

Checked by

Drawn by

Grga Kolić

Antonio Aleksić

Tamara Trogrlić

01.10.2026.

01.10.2026.

01.10.2026.

Reconstruction and Modernisation
of HPP Perucica - Phase II

PROJECT NAME

EMPLOYER

A Voith Company

Sintaksa - A Voith Company
Ulica Domovinskog rata 104C, 21 000 Split, Hrvatska

DESIGNER

DRAWING No.:
PERU-01-19-170-31-001

Designer No.:

REV No.:
02

SALES No.:

= UACJA10GH100
+ UACJA10

PAGE
108 / 156

1

2

3

4

5

6

7

8

108

CONFIDENTIAL, ALL RIGHTS RESERVED DIN 34

Format ISO/DIN A3

1	2	3	4	5	6	7	8
Qty. (pcs)	Equipment technical description	Manufacturer	Location (= / +)	Designation (-)	Symbol Position in schematics (Page, column)		
1	Power supply: 24 Vdc Discrete raise/lower: Speed Discrete raise/lower: Voltage Discrete alarm inputs: 4; discrete outputs: 2 Measuring inputs: 400 Vac Type: SPM-D2-10 8440-2164	Woodward	+UACJA10	-F25G			

Approved by Contractor			Reconstruction and Modernisation of HPP Perucica - Phase II		 A Voith Company Sintaksa - A Voith Company Ulica Domovinskog rata 104C, 21 000 Split, Hrvatska	Unit KA1 control cubicle circuit diagrams	DRAWING No.:	REV No.:	= UACJA10GH100
Approved by Designer	Grga Kolić	01.10.2026.					PERU-01-19-170-31-001	02	+ UACJA10
Checked by	Antonio Aleksić	01.10.2026.					Designer No.:	SALES No.:	PAGE 109
Drawn by	Tamara Trogrlić	01.10.2026.							
			PROJECT NAME	EMPLOYER	DESIGNER	AUTOMATIC SYNCHRONIZER	PAGE 109 / 156		

1

2

3

4

5



6




7

8

Approved by Contractor			Reconstruction and Modernisation of HPP Perucica - Phase II		 A Voith Company	Unit KA1 control cubicle circuit diagrams	DRAWING No.: PERU-01-19-170-31-001	REV No.: 02	= UACJA10GH100	
Approved by Designer	Grga Kolić	01.10.2026.			Sintaksa - A Voith Company Ulica Domovinskog rata 104C, 21 000 Split, Hrvatska				+ UACJA10	
Checked by	Antonio Aleksić	01.10.2026.							PAGE	110
Drawn by	Tamara Trogrlić	01.10.2026.							PAGE	110 / 156
			PROJECT NAME	EMPLOYER	DESIGNER	PANEL MOUNTED FAULT ANNUNCIATOR	Designer No.:	SALES No.:		


1		2		3		4		5		6		7		8		
A																A
	Qty. (pcs)	Equipment technical description	Manufacturer	Location (+)	Designation (-)	Symbol Position in schematics (Page, column)										
	1	Contact module with 1 contact element, 1 NO Contact module with 1 contact element, 1 NO, screw terminal, for front plate mounting Order No.: 3SU1400-1AA10-1BA0 ILLUMINATED PUSHBUTTON, RED Type: 3SU1051-0AB20-0AA0 Illuminated pushbutton, 22 mm, round, metal, shiny, red, pushbutton, flat, momentary contact type HOLDER Type: 3SU1550-0AA10-0AA0 Holder for 3 modules, universal, plastic/metal LED MODULE, RED Type: 3SU1401-1BB20-1AA0 LED MODULE WITH INTEGRATED LED 24V AC/DC, RED, SCREW TERMINAL, FOR FRONT PLATE MOUNTING SIRIUS ACT Label holder Type: 3SU1900-0AP10-0AA0 Label holder, 22mm, frame rectangular at the bottom, black, for labeling plate 17.5 mm x 27 mm, for gluing	Siemens													
		+UACJA10	-S112	/17.8:D		/42.4:D										
D		2	Heater Rated power: 100W Input voltage: 110-250V Order No.: HT100	Alfa Electric												
	+UACJA10				-R101	/5.5:F										
	+UACJA10				-R102	/5.6:F										
E	2	LED system light Slim enclosure LED lamp, 9 W, 100 to 230V, 50H, 538×23×36 mm Order No.: LL49W-100-230V	ALFA ELECTRIC													E
				+UACJA10	-E101	/5.3:F										
				+UACJA10	-E102	/5.4:F										
																F
110																112
Approved by Contractor				Reconstruction and Modernisation of HPP Perucica - Phase II			Unit KA1 control cubicle circuit diagrams		DRAWING No.: PERU-01-19-170-31-001		REV No.: 02		= UACJA10GH100			
Approved by Designer		Grga Kolić	01.10.2026.				Device tag List		Designer No.:		SALES No.:		PAGE 111			
Checked by		Antonio Aleksić	01.10.2026.	PROJECT NAME	EMPLOYER	DESIGNER					PAGE 111 / 156					
Drawn by		Tamara Trogrlić	01.10.2026.													
1		2		3		4		5		6		7		8		

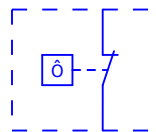
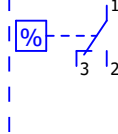
1		2		3		4		5		6		7		8	
CONFIDENTIAL, ALL RIGHTS RESERVED DIN 34															
Qty. (pcs)		Equipment technical description		Manufacturer		Location (+)		Designation (-)		Symbol Position in schematics (Page, column)					
1		Thermostat NO contact 0...+60°C Type: THV02 Order No.: THV02		Alfa Electric											
						+UACJA10		-B103		/5.6:C					
2		Diode Circuit configuration: Two diodes doubler circuit, two diodes common cathode, two diodes common anode, single diode Vf - Forward Voltage: 1.35 V Vr - Reverse Voltage: 800 V Order No.: 197-DD100KB80		SanRex											
						+UACJA10		-V1		/6.1:B					
						+UACJA10		-V2		/6.2:B					
1		Electronic hygrostat Hygrostat, Rated Voltage 120-240 V AC, Rated Current 10-5A 10-90 %RF Order No.: IGR35F													
						+UACJA10		-B102		/5.5:E /5.6:E					
1		Speed monitoring relay MONITOR/FR-1 /110-240VAC/DC Nominal voltage: 110...240VAC (50...60Hz)/27Hz (tip. 24VDC) 2 relay outputs, 2 transistor outputs Analog output: 0/4...20mA Impuls inputs: pnp/npn, NAMUR (24V) Input frequency (max): 5kHz Setting range: 1...60000 imp/min (0.1...1000Hz) Order No.: DD2503		ifm electronic											
						+UACJA10		-B111		/9.5:E /9.6:E /48.7:F /48.7:F /48.7:F					
Format ISO/DIN A3															
111															
Approved by Contractor						Reconstruction and Modernisation of HPP Perucica - Phase II						Unit KA1 control cubicle circuit diagrams		DRAWING No.: PERU-01-19-170-31-001	
Approved by Designer		Grga Kolić		01.10.2026.								Device tag List		REV No.: 02	
Checked by		Antonio Aleksić		01.10.2026.										SALES No.: PAGE 112	
Drawn by		Tamara Trogrlić		01.10.2026.		PROJECT NAME		EMPLOYER		DESIGNER				PAGE 112 / 156	

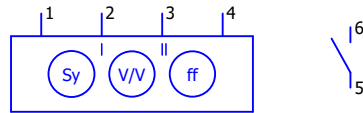
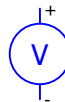
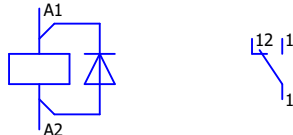
1		2		3		4		5		6		7		8	
CONFIDENTIAL, ALL RIGHTS RESERVED DIN 34															
Qty. (pcs)	Equipment technical description		Manufacturer	Location (+)	Designation (-)	Symbol Position in schematics (Page, column)									
1	Synchronisation meters for manual or semiautomatic synchronisation Scale: 360° Power supply from bus bar or generator Displayed value equal to voltage input Order No.: SQ0214-L-400V-R3-N-N-S-A-0		ISKRA												
				+UACJA10	-P411	/61.4:E /64.2:C									
1	Analog panel meter Scale: 0-500 V, 48x48mm Direct measurement Order No.: EA16N E61500000A8		LUMEL												
				+UACJA10	-P110	/76.6:D									
1	Analog panel meter Scale: 0-200% Input signal: 4-20mA Order No.: MA19LN A900X000008		LUMEL												
				+UACJA10	-P1	/46.5:C									
1	Auxiliary relay PLC-INTERFACE, consisting of PLC-BSC.../21 basic terminal block with screw connection and plug-in miniature relay with power contact, 1 C/O, input voltage 24 V DC for mounting on DIN rail NS 35/7.5 Order No.: 2966171		Phoenix Contact												
				+UACJA10	-1K12	/20.4:D /20.4:E									
				+UACJA10	-1K13	/20.5:D /20.5:E									
				+UACJA10	-1K14	/20.6:D /20.6:E									
				+UACJA10	-1K15	/20.7:D /20.7:E									
				+UACJA10	-1K16	/20.8:D /20.8:E									
				+UACJA10	-1K21	/21.1:D /21.1:E									
				+UACJA10	-1K22	/21.2:D /21.2:E									
				+UACJA10	-1K23	/21.3:D /21.3:E									
				+UACJA10	-1K24	/21.4:D /21.4:E									
				+UACJA10	-1K32	/22.2:D /22.2:E									
				+UACJA10	-1K33	/22.3:D /22.3:E									
				+UACJA10	-1K34	/22.4:D /22.4:E									
				+UACJA10	-1K35	/22.5:D /22.5:E									
				+UACJA10	-1K36	/22.6:D /22.6:E									
112															
Approved by Contractor			Reconstruction and Modernisation of HPP Perucica - Phase II			 A Voith Company Sintaksa - A Voith Company Ulica Domovinskog rata 104C, 21 000 Split, Hrvatska	Unit KA1 control cubicle circuit diagrams Device tag List		DRAWING No.:		REV No.:	= UACJA10GH100			
PERU-01-19-170-31-001		02							+ UACJA10						
Designer No.:		SALES No.:							PAGE						
									113						
									113 / 156						
Approved by Designer		Grga Kolić	01.10.2026.												
Checked by		Antonio Aleksić	01.10.2026.												
Drawn by		Tamara Trogrlić	01.10.2026.		PROJECT NAME		EMPLOYER		DESIGNER						
114															

Format ISO/DIN A3


Format ISO/DIN A3

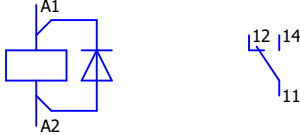1		2		3		4		5		6		7		8			
A																A	
	Qty. (pcs)	Equipment technical description	Manufacturer	Location (+)	Designation (-)	Symbol Position in schematics (Page, column)											
		Auxiliary relay PLC-INTERFACE, consisting of PLC-BSC.../21 basic terminal block with screw connection and plug-in miniature relay with power contact, 1 C/O, input voltage 24 V DC for mounting on DIN rail NS 35/7.5 Order No.: 2966171	Phoenix Contact														
B				+UACJA10	-1K143	/33.3:D		/33.3:E								B	
				+UACJA10	-1K144	/33.4:D		/33.4:E									
				+UACJA10	-1K145	/33.5:D		/33.5:E									
				+UACJA10	-1K146	/33.6:D		/33.6:E									
				+UACJA10	-1K147	/33.7:D		/33.7:E									
C				+UACJA10	-1K148	/33.8:D		/33.8:E								C	
				+UACJA10	-1K151	/34.1:D		/34.1:E									
				+UACJA10	-1K152	/34.2:D		/34.2:E									
				+UACJA10	-1K153	/34.3:D		/34.3:E									
				+UACJA10	-1K157	/34.7:D		/34.7:E									
				+UACJA10	-1K158	/34.8:D		/34.8:E									
				+UACJA10	-1K161	/35.1:D		/35.1:E									
				+UACJA10	-1K162	/35.2:D		/35.2:E									
				+UACJA10	-1K163	/35.3:D		/35.3:E									
				+UACJA10	-1K164	/35.4:D		/35.4:E									
D				+UACJA10	-1K165	/35.5:D		/35.5:E								D	
				+UACJA10	-1K166	/35.6:D		/35.6:E									
				+UACJA10	-1K167	/35.7:D		/35.7:E									
				+UACJA10	-1K168	/35.8:D		/35.8:E									
				+UACJA10	-2K01	/36.1:D		/56.2:C									
E				+UACJA10	-2K02	/36.2:D		/56.2:C								E	
				+UACJA10	-2K03	/36.3:D		/57.2:A									
				+UACJA10	-2K04	/36.4:D		/58.4:B									
				+UACJA10	-2K05	/36.5:D		/49.2:B									
				+UACJA10	-2K06	/36.6:D		/49.3:B									
				+UACJA10	-2K07	/36.7:D		/49.4:B									
				+UACJA10	-2K08	/37.6:D		/52.7:B									
				+UACJA10	-2K09	/37.7:D		/52.8:B									
				+UACJA10	-2K10	/38.2:D		/49.6:B									
				+UACJA10	-2K11	/38.5:D		/59.7:B									
F				+UACJA10	-2K12	/38.6:D		/62.2:B								F	
				+UACJA10	-2K13	/39.1:D		/64.5:B									
115																117	
Approved by Contractor				Reconstruction and Modernisation of HPP Perucica - Phase II				 A Voith Company		Unit KA1 control cubicle circuit diagrams		DRAWING No.: PERU-01-19-170-31-001		REV No.: 02		= UACJA10GH100	
Approved by Designer		Grga Kolić	01.10.2026.					Sintaksa - A Voith Company Ulica Domovinskog rata 104C, 21 000 Split, Hrvatska		Device tag List		Designer No.:		SALES No.:		+ UACJA10	
Checked by		Antonio Aleksić	01.10.2026.											PAGE		116	
Drawn by		Tamara Trogrlić	01.10.2026.	PROJECT NAME		EMPLOYER		DESIGNER						PAGE		116 / 156	
1		2		3		4		5		6		7		8			

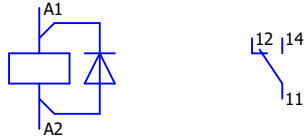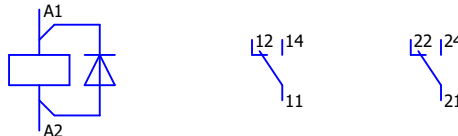1		2		3		4		5		6		7		8			
CONFIDENTIAL, ALL RIGHTS RESERVED DIN 34																	
Format ISO/DIN A3																	
Qty. (pcs)	Equipment technical description	Manufacturer	Location (+)	Designation (-)	Symbol Position in schematics (Page, column)												
127	Auxiliary relay	Phoenix Contact															
	PLC-INTERFACE, consisting of PLC-BSC.../21 basic terminal block with screw connection and plug-in miniature relay with power contact, 1 C/O, input voltage 24 V DC for mounting on DIN rail NS 35/7.5 Order No.: 2966171																
			+UACJA10	-2K14	/39.2:D		/64.6:B										
			+UACJA10	-2K15	/39.4:D		/65.2:B										
			+UACJA10	-2K16	/39.5:D		/65.3:B										
			+UACJA10	-2K17	/39.6:D		/65.4:B										
			+UACJA10	-2K18	/39.7:D		/65.5:B										
			+UACJA10	-2K19	/39.8:D		/67.2:B										
			+UACJA10	-2K20	/40.1:D		/67.3:B										
			+UACJA10	-2K21	/40.2:D		/67.4:B										
			+UACJA10	-2K22	/40.3:D		/67.5:B										
			+UACJA10	-2K23	/40.5:D		/68.6:C										
			+UACJA10	-2K24	/40.6:D												
			+UACJA10	-2K25	/40.7:D												
			+UACJA10	-2K26	/40.8:D												
			+UACJA10	-2K27	/41.1:D												
			+UACJA10	-2K28	/41.2:D												
			+UACJA10	-2K29	/41.3:D												
			+UACJA10	-2K30	/41.4:D												
		Interface relay 24VDC, 2CO	Phoenix Contact														
	Auxiliary relay Nominal coil voltage: 24VDC 2 CO Order No.: 2967060																
			+UACJA10	-1K11	/20.3:D		/20.3:E		/71.2:C								
			+UACJA10	-1K25	/21.5:D		/21.5:E		/71.2:C								
			+UACJA10	-1K26	/21.6:D		/21.6:E		/71.3:C								
			+UACJA10	-1K27	/21.7:D		/21.7:E		/71.4:C								
			+UACJA10	-1K28	/21.8:D		/21.8:E		/71.5:C								
			+UACJA10	-1K31	/22.1:D		/22.1:E		/71.6:C								
			+UACJA10	-1K45	/23.5:D		/23.5:E		/71.6:C								
			+UACJA10	-1K46	/23.6:D		/23.6:E		/71.7:C								
			+UACJA10	-1K54	/24.4:D		/24.4:E		/71.8:C								
			+UACJA10	-1K76	/26.6:D		/26.6:E										
116		118															
Approved by Contractor			Reconstruction and Modernisation of HPP Perucica - Phase II				 A Voith Company Sintaksa - A Voith Company Ulica Domovinskog rata 104C, 21 000 Split, Hrvatska		Unit KA1 control cubicle circuit diagrams		DRAWING No.:		REV No.:		= UACJA10GH100		
Approved by Designer		Grga Kolić									01.10.2026.	PERU-01-19-170-31-001		02		+ UACJA10	
Checked by		Antonio Aleksić									01.10.2026.	Designer No.:		SALES No.:		PAGE 117	
Drawn by		Tamara Trogrlić	01.10.2026.	PROJECT NAME		EMPLOYER		DESIGNER		Device tag List				PAGE 117 / 156			

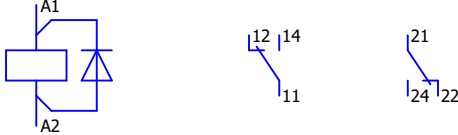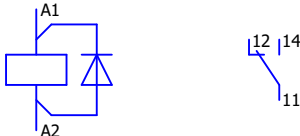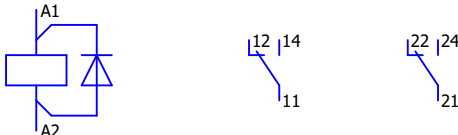1		2		3		4		5		6		7		8		
A																A
	Qty. (pcs)	Equipment technical description	Manufacturer	Location (+)	Designation (-)	Symbol Position in schematics (Page, column)										
B	16	Interface relay 24VDC, 2CO Auxiliary relay Nominal coil voltage: 24VDC 2 CO Order No.: 2967060	Phoenix Contact													B
				+UACJA10	-1K96	/28.6:D		/28.6:E								
				+UACJA10	-1K97	/28.7:D		/28.7:E								
				+UACJA10	-1K98	/28.8:D		/28.8:E		/69.5:C						
				+UACJA10	-1K154	/34.4:D		/34.4:E		/71.2:D						
				+UACJA10	-1K155	/34.5:D		/34.5:E		/71.2:D						
				+UACJA10	-1K156	/34.6:D		/34.6:E		/71.3:D						
C	9	Auxiliary relay Input voltage 230 V AC/220 V DC Order No.: 2966207	Phoenix Contact													C
				+UACJA10	-1K62	/25.2:D		/25.2:E								
				+UACJA10	-1K63	/25.3:D		/25.3:E								
				+UACJA10	-1K66	/25.6:D		/25.6:E								
				+UACJA10	-1K67	/25.7:D		/25.7:E								
				+UACJA10	-1K68	/25.8:D		/25.8:E								
				+UACJA10	-1K71	/26.1:D		/26.1:E								
				+UACJA10	-1K72	/26.2:D		/26.2:E								
				+UACJA10	-1K73	/26.3:D		/26.3:E								
E	4	Interface relay 230VAC/220VDC, 2CO Auxiliary relay Nominal coil voltage: 230VAC/220VDC 2 C/O Order No.: 2967099	Phoenix Contact													E
				+UACJA10	-1K58	/24.8:D		/24.8:E		/53.2:C						
				+UACJA10	-1K61	/25.1:D		/25.1:E		/53.3:C						
				+UACJA10	-1K64	/25.4:D		/25.4:E		/53.4:C						
				+UACJA10	-1K65	/25.5:D		/25.5:E		/53.5:C						
F																F
117														119		
Approved by Contractor				Reconstruction and Modernisation of HPP Perucica - Phase II				 A Voith Company Sintaksa - A Voith Company Ulica Domovinskog rata 104C, 21 000 Split, Hrvatska		Unit KA1 control cubicle circuit diagrams Device tag List		DRAWING No.:		REV No.:	= UACJA10GH100	
Approved by Designer		Grga Kolić	01.10.2026.									PERU-01-19-170-31-001		02	+ UACJA10	
Checked by		Antonio Aleksić		01.10.2026.						Designer No.:		SALES No.:		PAGE 118		
Drawn by		Tamara Trogrlić		01.10.2026.		PROJECT NAME		EMPLOYER						PAGE 118 / 156		
1		2		3		4		5		6		7		8		



CONFIDENTIAL, ALL RIGHTS RESERVED DIN 34 <

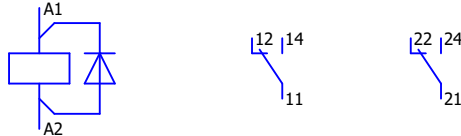1		2		3		4		5		6		7		8				
A																A		
	Qty. (pcs)	Equipment technical description	Manufacturer	Location (+)	Designation (-)	Symbol Position in schematics (Page, column)											B	
	13	Interface plug-in relay - Zelio RXG Nominal coil voltage: 24VDC Nominal contact current: 5A 2 CO, with LED, lockable test button Base: RGZE1S48M Protection diode: RXM040W Order No.: RXG22BD Protection module Harmony 6...230V DC Type: SE.RZM040W Harmony, Protection module, diode, for RSZ, 6...230 V DC Socket Type: RGZE1S48M Socket with clamp, 5 A, For RXG2 relays 2 C/O, screw connectors	Schneider Electric															C
						+UACJA10 -2K201 /39.3:D /63.2:B /63.6:B												
						+UACJA10 -2K202 /41.5:D												
						+UACJA10 -2K203 /41.6:D												
						+UACJA10 -K201 /15.2:E /18.5:D /69.2:C												
						+UACJA10 -K202 /15.3:E /18.6:D /69.2:C												
						+UACJA10 -K203 /15.4:E /18.8:D /66.4:B												
						+UACJA10 -K204 /15.5:E /19.6:D /69.2:C												
						+UACJA10 -K205 /15.6:E /19.7:D /69.3:C												
						+UACJA10 -K206 /15.7:E /19.8:D /69.4:C												
						+UACJA10 -K207 /53.2:E /62.3:C /66.6:B												
+UACJA10 -K208 /53.3:E /65.6:B /68.5:C																		
+UACJA10 -K209 /53.4:E /62.4:C																		
+UACJA10 -K210 /53.5:E																		
															D			
																E		
																	F	

120

Format ISO/DIN A3

CONFIDENTIAL, ALL RIGHTS RESERVED DIN 34

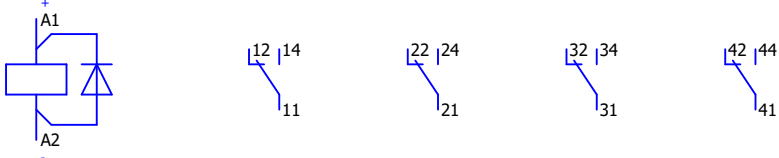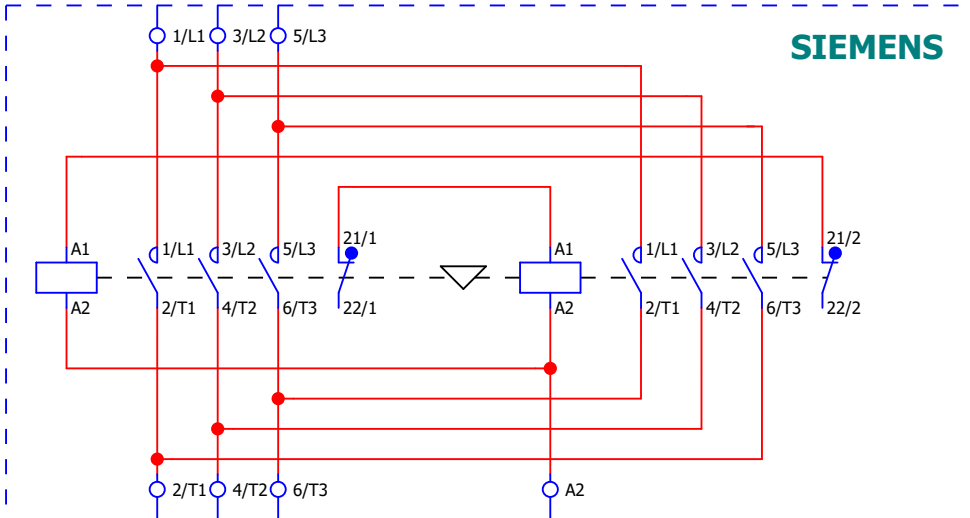1		2		3		4		5		6		7		8	
Qty. (pcs)	Equipment technical description			Manufacturer	Location (+)	Designation (-)	Symbol Position in schematics (Page, column)								
3	Miniature plug-in relay - Zelio RXM 6 A 4 CO With LED With lockable test button 24 V DC Order No.: RXM4AB2BD Socket RXZ Type: RXZE2S114M Separate contact For RXM2/RXM4 relays 4 C/O, screw connectors 10 A, 250V AC Protection module Harmony 6...230V DC Type: SE.RZM040W Harmony, Protection module, diode, for RSZ, 6...230 V DC			Schneider Electric											
2	Door contact Door contact, 1NO+1NC Order No.: XCKN2110G11			Schneider Electric											
1	REV.COMB.,4KW, DC24V REV. COMB., AC3, 4KW/400V DC24V 3-POLE, SZ S00 SCREW TERMINAL ELECTR. AND MECH. INTERLOCK Electrical and mechanical interlocking Type: 3RA2316-8XB30-1BB4 Order No.: 3RA2316-8XB30-1BB4			Siemens											
					+UACJA10	-K1	/52.2:B				/52.7:C				

Approved by Contractor			Approved by Designer			Checked by			Drawn by			Reconstruction and Modernisation of HPP Perucica - Phase II						 Sintaksa - A Voith Company Ulica Domovinskog rata 104C, 21 000 Split, Hrvatska			Unit KA1 control cubicle circuit diagrams			DRAWING No.: PERU-01-19-170-31-001			REV No.: 02			= UACJA10GH100		
			Grga Kolić			Antonio Aleksić			Tamara Trogrlić			PROJECT NAME			EMPLOYER			DESIGNER			Device tag List			Designer No.:			SALES No.:			PAGE 121		
																											PAGE 121 / 156					
1			2			3			4			5			6			7			8											

122

CONFIDENTIAL, ALL RIGHTS RESERVED DIN 34

Format ISO/DIN A3





120

122

121

CONFIDENTIAL, ALL RIGHTS RESERVED DIN 34

Format ISO/DIN A3

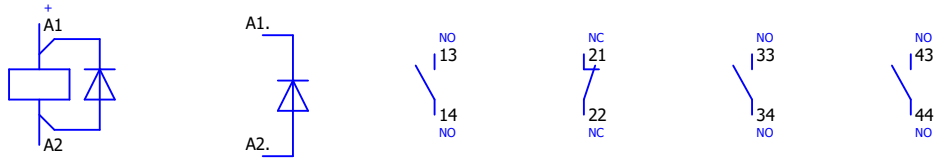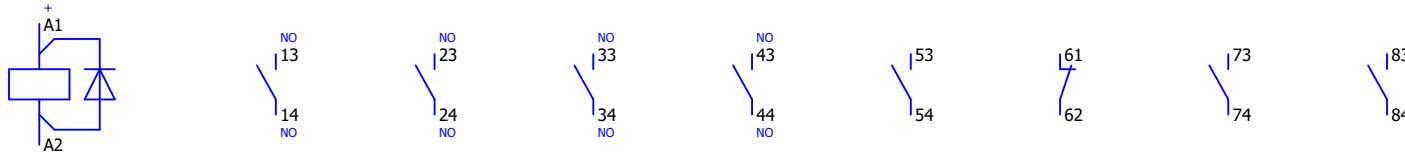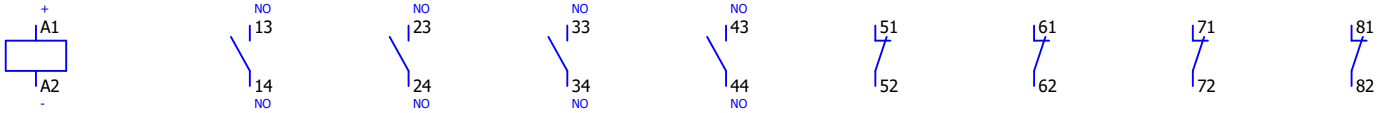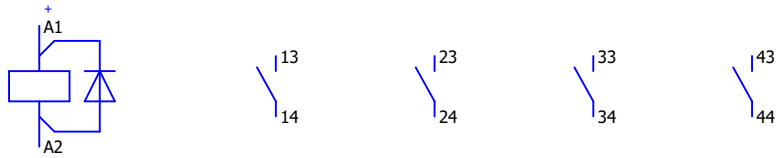1		2		3		4		5		6		7		8	
Qty. (pcs)	Equipment technical description	Manufacturer	Location (+)	Designation (-)	Symbol Position in schematics (Page, column)										
2	COUPL.CONT.RELAY,3NO+1NC,DC24V,DIODE COUPLING CONTACTOR RELAY, 3NO+1NC, DC 24V, 0.85...1.85*US, W/ INTEGRATED DIODE, SIZE S00, SCREW TERMINAL Order No.: 3RH2131-1VB40	Siemens													
			+UACJA10	-2K111	/38.7:D	/62.3:B	/19.2:D	/64.2:D	/59.5:B						
			+UACJA10	-2K112	/38.8:D	/62.4:B	/19.3:D	/64.4:D	/59.6:B						
1	SIRIUS contactor relay Contactor relay, 4NO, 24VDC, with integrated diode, size S00, screw terminal Order No.: 3RH2140-1FB40 AUX. SWITCH BLOCK , 3NO+1NC COND. PATHS: 1NO, 1NC, Type: 3RH2911-1GA31 Auxiliary switch block , 3NO+1NC conditional paths: 1NO, 1NC, 1NO, 1NO, for contactor relays size S00, screw terminal DIN EN 50011	Siemens													
			+UACJA10	-K01	/59.7:E	/61.4:D	/61.4:D	/61.5:D	/61.5:D						
2	SIRIUS contactor relay Contactor relay, 4NO, 24VDC, with integrated diode, size S00, screw terminal Order No.: 3RH2140-1FB40 AUXILIARY SWITCH BLOCK, 4NC Type: 3RH2911-1GA04 Auxiliary switch block 4NC, only with contactor relays 3RH2140 and 3RH2440 combinable, screw terminal DIN EN 50011	Siemens													
			+UACJA10	-K302	/57.3:E	/16.8:D					/66.2:B	/57.3:A	/66.7:B	/55.7:C	
			+UACJA10	-K303	/57.4:E					/51.4:B	/51.4:C	/51.4:C	/57.4:A		
	COUPL.CONT.RELAY,4NO,DC24V,DIODE COUPLING CONTACTOR RELAY, 4NO, DC 24V, 0.85...1.85*US, W/ INTEGRATED DIODE, SIZE S00, SCREW TERMINAL Order No.: 3RH2140-1VB40	Siemens													
			+UACJA10	-2K101	/36.8:D	/50.2:B	/50.2:C	/50.2:C							
			+UACJA10	-2K102	/37.1:D	/50.3:B	/50.3:C	/50.3:C							
			+UACJA10	-2K103	/37.2:D	/50.4:B	/50.4:C	/50.4:C							
			+UACJA10	-2K104	/37.3:D	/50.5:B	/50.5:C	/50.5:C							
			+UACJA10	-2K105	/37.4:D	/50.6:B	/50.6:C	/50.6:C							
			+UACJA10	-2K106	/37.5:D	/51.3:B	/51.3:C	/51.3:C							
			+UACJA10	-2K107	/37.8:D	/52.4:B	/52.4:C	/52.4:C							
			+UACJA10	-2K108	/38.1:D	/52.6:B	/52.6:C	/52.6:C							

122

Approved by Contractor

Approved by Designer

Checked by

Drawn by

Grga Kolić

Antonio Aleksić

Tamara Trogrlić

01.10.2026.

01.10.2026.

01.10.2026.

Reconstruction and Modernisation of HPP Perucica - Phase II

PROJECT NAME

EMPLOYER

DESIGNER

Unit KA1 control cubicle circuit diagrams

Device tag List

DRAWING No.: PERU-01-19-170-31-001

Designer No.:

REV No.: 02

SALES No.:

= UACJA10GH100



+ UACJA10

PAGE 122

PAGE 122 / 156

122

Format ISO/DIN A3

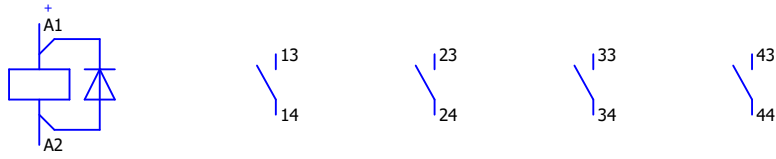
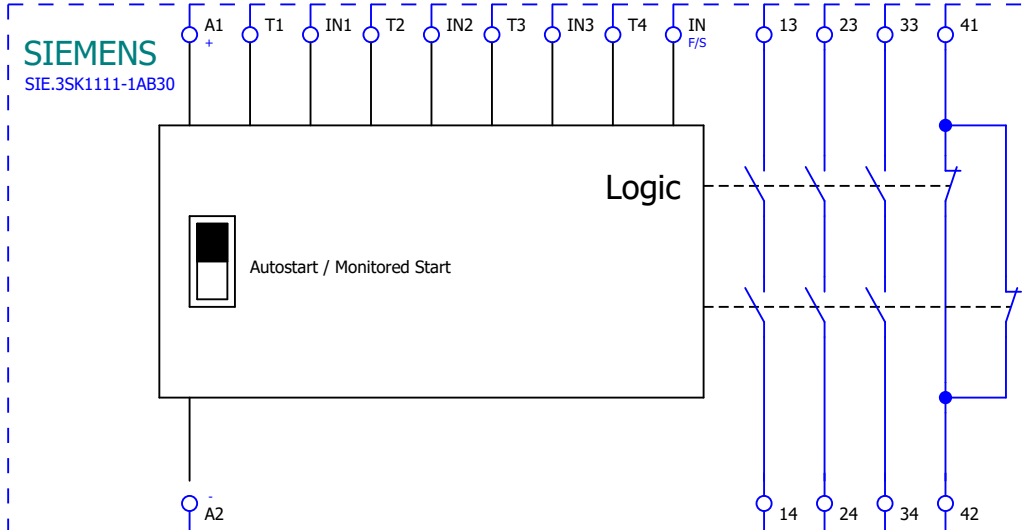
1		2		3		4		5		6		7		8	
CONFIDENTIAL, ALL RIGHTS RESERVED DIN 34															
Qty. (pcs)	Equipment technical description			Manufacturer	Location (+)	Designation (-)	Symbol Position in schematics (Page, column)								
14	COUPL.CONT.RELAY,4NO,DC24V,DIODE COUPLING CONTACTOR RELAY, 4NO, DC 24V, 0.85...1.85*US, W/ INTEGRATED DIODE, SIZE S00, SCREW TERMINAL Order No.: 3RH2140-1VB40			Siemens											
					+UACJA10	-2K109	/38.3:D	/54.3:B	/54.3:B	/54.3:C					
					+UACJA10	-2K110	/38.4:D								
					+UACJA10	-2K111A	/59.5:E	/60.5:C	/60.5:C	/61.3:C	/61.4:C				
					+UACJA10	-2K112A	/59.6:E	/60.6:C	/60.6:C	/61.4:C	/61.4:C				
					+UACJA10	-2K113	/41.7:D								
					+UACJA10	-2K114	/41.8:D								
1	SIRIUS SAFETY RELAY STD RELAYS 3NO+1NC SIRIUS safety relay Basic unit Standard series Relay enabling circuits 3 NO contacts plus Relay signaling circuit 1 NC contact Us = 24 V AC/DC screw terminal Type: 3SK1111-1AB30 Order No.: 3SK1111-1AB30			Siemens											
					+UACJA10	-K301	/57.2:C	/57.4:E							



CONFIDENTIAL, ALL RIGHTS RESERVED DIN 34

Format ISO/DIN A3

122




124

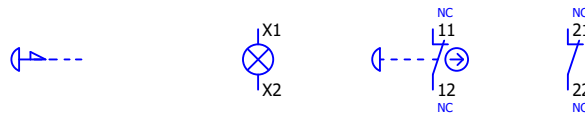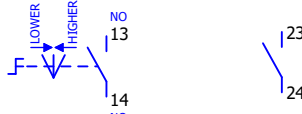1		2		3		4		5		6		7		8			
A																A	
	Qty. (pcs)	Equipment technical description	Manufacturer	Location (+)	Designation (-)	Symbol Position in schematics (Page, column)											
	1	ILLUM. MUSHROOM PUSHBUTTON, 40MM, RED Illuminated mushroom pushbutton, 22 mm, round, metal, shiny, red, 40 mm, latching, Pull-to-unlatch mechanism Order No.: 3SU1051-1BA20-0AA0 LED MODULE, RED Type: 3SU1401-1BB20-1AA0 LED MODULE WITH INTEGRATED LED 24V AC/DC, RED, SCREW TERMINAL, FOR FRONT PLATE MOUNTING PROTECTIVE COLLAR Type: 3SU1900-0DY30-0AA0 PROTECTIVE COLLAR FOR EM. STOP MUSHROOM PUSHBUTTON, WITHOUT OR WITH RONIS LOCK, YELLOW, PLASTIC HOLDER, CONTACT MODULE 1NC,1NC Type: 3SU1550-1AA10-1PA0 Holder for 3 modules, metal, 1 NC, 1 NC, screw terminal	Siemens														
+UACJA10						-S301	/43.8:D /16.7:D /56.1:B										
B																B	
	1	SELECTOR SWITCH, I>O<II, RED Selector switch, illuminable, 22 mm, round, metal, shiny, red, selector switch, short, 3 switch positions I>O<II, momentary contact type, actuating angle 2x45°, 10:30h/12h/13:30h Order No.: 3SU1052-2BM20-0AA0 Contact module with 1 contact element, 1 NO Type: 3SU1400-1AA10-1BA0 Contact module with 1 contact element, 1 NO, screw terminal, for front plate mounting Contact module with 1 contact element, 1 NO Type: 3SU1400-1AA10-1BA0 Contact module with 1 contact element, 1 NO, screw terminal, for front plate mounting HOLDER Type: 3SU1550-0AA10-0AA0 Holder for 3 modules, universal, plastic/metal SIRIUS ACT Label holder Type: 3SU1900-0AP10-0AA0 Label holder, 22mm, frame rectangular at the bottom, black, for labeling plate 17.5 mm x 27 mm, for gluing	Siemens														
						+UACJA10	-S221	/63.6:D /63.7:D									
C																C	
D																D	
E																E	
F																F	
123																125	
Approved by Contractor				Reconstruction and Modernisation of HPP Perucica - Phase II				 A Voith Company		Unit KA1 control cubicle circuit diagrams		DRAWING No.: PERU-01-19-170-31-001		REV No.: 02		= UACJA10GH100	
Approved by Designer		Grga Kolić	01.10.2026.					Sintaksa - A Voith Company Ulica Domovinskog rata 104C, 21 000 Split, Hrvatska		Device tag List		Designer No.:		SALES No.:		PAGE 124	
Checked by		Antonio Aleksić	01.10.2026.													PAGE 124 / 156	
Drawn by		Tamara Trogrlić	01.10.2026.	PROJECT NAME		EMPLOYER		DESIGNER									
1		2		3		4		5		6		7		8			

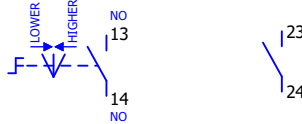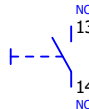CONFIDENTIAL, ALL RIGHTS RESERVED DIN 34	1		2		3		4		5		6		7		8	
	Qty. (pcs)	Equipment technical description		Manufacturer	Location (+)	Designation (-)	Symbol Position in schematics (Page, column)									
	1	SELECTOR SWITCH, I>O<II, BLUE Selector switch, illuminable, 22 mm, round, metal, shiny, blue, selector switch, short, 3 switch positions I>O<II, momentary contact type, actuating angle 2x45°, 10:30h/12h/13:30h Order No.: 3SU1052-2BM50-0AA0 Contact module with 1 contact element, 1 NO Type: 3SU1400-1AA10-1BA0 Contact module with 1 contact element, 1 NO, screw terminal, for front plate mounting Contact module with 1 contact element, 1 NO Type: 3SU1400-1AA10-1BA0 Contact module with 1 contact element, 1 NO, screw terminal, for front plate mounting HOLDER Type: 3SU1550-0AA10-0AA0 Holder for 3 modules, universal, plastic/metal SIRIUS ACT Label holder Type: 3SU1900-0AP10-0AA0 Label holder, 22mm, frame rectangular at the bottom, black, for labeling plate 17.5 mm x 27 mm, for gluing		Siemens												
				+UACJA10	-S222	/63.2:D		/63.3:D								
	2	PUSHBUTTON, BLACK Pushbutton, 22 mm, round, metal, shiny, black, pushbutton, flat, momentary contact type, with holder, 1 NO, screw terminal Order No.: 3SU1150-0AB10-1BA0 SIRIUS ACT Label holder Type: 3SU1900-0AP10-0AA0 Label holder, 22mm, frame rectangular at the bottom, black, for labeling plate 17.5 mm x 27 mm, for gluing		Siemens												
				+UACJA10	-S203	/17.2:D										
				+UACJA10	-S302	/17.1:D										

CONFIDENTIAL, ALL RIGHTS RESERVED DIN 34

Format ISO/DIN A3

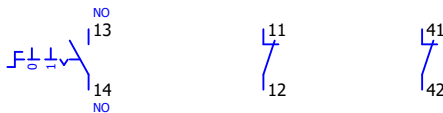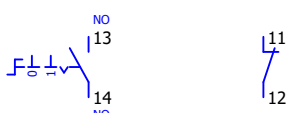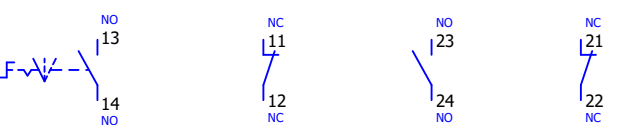1		2		3		4		5		6		7		8	
Qty. (pcs)	Equipment technical description		Manufacturer	Location (+)	Designation (-)	Symbol Position in schematics (Page, column)									
1	SELECTOR SWITCH, O-I, BLACK, WHITE Selector switch, illuminable, 22 mm, round, metal, shiny, white, selector switch, short, 2 switch positions O-I, latching, actuating angle 90°, 10:30h/13:30h, with holder, 1 NO, screw terminal Order No.: 3SU1150-2BF60-1BA0 CONTACT MODULE 2NC Type: 3SU1400-1AA10-1EA0 Contact module with 2 contact elements, 2 NC, screw terminal, for front plate mounting SIRIUS ACT Label holder Type: 3SU1900-0AP10-0AA0 Label holder, 22mm, frame rectangular at the bottom, black, for labeling plate 17.5 mm x 27 mm, for gluing		Siemens												
				+UACJA10	-S103	/16.2:D	/63.2:C	/63.6:C							
1	SELECTOR SWITCH, O-I, BLACK, WHITE Selector switch, illuminable, 22 mm, round, metal, shiny, white, selector switch, short, 2 switch positions O-I, latching, actuating angle 90°, 10:30h/13:30h, with holder, 1 NO, screw terminal Order No.: 3SU1150-2BF60-1BA0 Contact module with 1 contact element, 1 NC Type: 3SU1400-1AA10-1CA0 Contact module with 1 contact element, 1 NC, screw terminal, for front plate mounting SIRIUS ACT Label holder Type: 3SU1900-0AP10-0AA0 Label holder, 22mm, frame rectangular at the bottom, black, for labeling plate 17.5 mm x 27 mm, for gluing		Siemens												
				+UACJA10	-S104	/20.1:D									
1	SELECTOR SWITCH, I-O-II, BLACK, WHITE Selector switch, illuminable, 22 mm, round, metal, shiny, white, selector switch, short, 3 switch positions I-O-II, latching, actuating angle 2x45°, 10:30h/12h/13:30h, with holder, 2x1NO+1NC, screw terminal Order No.: 3SU1150-2BL60-1LA0 SIRIUS ACT Label holder Type: 3SU1900-0AP10-0AA0 Label holder, 22mm, frame rectangular at the bottom, black, for labeling plate 17.5 mm x 27 mm, for gluing		Siemens												
				+UACJA10	-S121	/59.2:B	/59.4:B	/59.3:B	/59.4:C						

125

127

Approved by Contractor			Reconstruction and Modernisation of HPP Perucica - Phase II		 A Voith Company	Unit KA1 control cubicle circuit diagrams	DRAWING No.: PERU-01-19-170-31-001	REV No.: 02	= UACJA10GH100 + UACJA10
Approved by Designer	Grga Kolić	01.10.2026.							
Checked by	Antonio Aleksić	01.10.2026.							
Drawn by	Tamara Trogrlić	01.10.2026.	PROJECT NAME	EMPLOYER	DESIGNER	Device tag List	Designer No.:	SALES No.:	PAGE 126 / 156

Format ISO/DIN A3




125

127

CONFIDENTIAL, ALL RIGHTS RESERVED DIN 34

CONFIDENTIAL, ALL RIGHTS RESERVED DIN 34

Format ISO/DIN A3

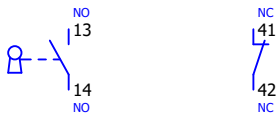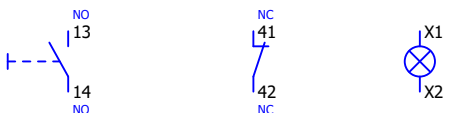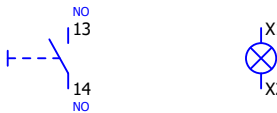1		2		3		4		5		6		7		8	
Qty. (pcs)	Equipment technical description		Manufacturer	Location (+)	Designation (-)	Symbol Position in schematics (Page, column)									
1	KEY-OPERATED SWITCH RONIS, O-I RONIS key-operated switch, 22 mm, round, metal, shiny, lock number SB30, with 2 keys, 2 switch positions O-I, latching, actuating angle 90°, 10:30h/13:30h, key removal O+I, with holder, 1 NO+1 NC, screw terminal, possible special locks: 3SB31, 421, 455 Order No.: 3SU1150-4BF11-1FA0 SIRIUS ACT Label holder Type: 3SU1900-0AP10-0AA0 Label holder, 22mm, frame rectangular at the bottom, black, for labeling plate 17.5 mm x 27 mm, for gluing DIN rail mounting base - Ø 22 mm units - for control and signalling unit Type: A9A15151 DIN rail mounting base - Ø 22 mm units - for control and signalling unit		Siemens												
				+UACJA10	-S100	/16.1:D									
1	ILLUMINATED PUSHBUTTON, RED Illuminated pushbutton, 22 mm, round, metal, shiny, red, pushbutton, flat, momentary contact type, with holder, 1 NO+1 NC, LED module with integrated LED 24 V AC/DC, screw terminal Order No.: 3SU1152-0AB20-1FA0 SIRIUS ACT Label holder Type: 3SU1900-0AP10-0AA0 Label holder, 22mm, frame rectangular at the bottom, black, for labeling plate 17.5 mm x 27 mm, for gluing		Siemens												
				+UACJA10	-S290	/17.3:D /43.6:D									
4	ILLUMINATED PUSHBUTTON, GREEN Illuminated pushbutton, 22 mm, round, metal, shiny, green, pushbutton, flat, momentary contact type, with holder, 1 NO, LED module with integrated LED 24 V AC/DC, screw terminal Order No.: 3SU1152-0AB40-1BA0 SIRIUS ACT Label holder Type: 3SU1900-0AP10-0AA0 Label holder, 22mm, frame rectangular at the bottom, black, for labeling plate 17.5 mm x 27 mm, for gluing		Siemens												
				+UACJA10	-S111	/17.7:D /42.3:D									
				+UACJA10	-S113	/18.1:D									
				+UACJA10	-S131	/17.6:D /43.2:D									
				+UACJA10	-S291	/17.4:D /43.7:D									

126

128

Approved by Contractor			Reconstruction and Modernisation of HPP Perucica - Phase II		 A Voith Company Sintaksa - A Voith Company Ulica Domovinskog rata 104C, 21 000 Split, Hrvatska	Unit KA1 control cubicle circuit diagrams	DRAWING No.:	REV No.:	= UACJA10GH100
Approved by Designer	Grga Kolić	01.10.2026.					PERU-01-19-170-31-001	02	+ UACJA10
Checked by	Antonio Aleksić	01.10.2026.					Designer No.:	SALES No.:	PAGE 127
Drawn by	Tamara Trogrlić	01.10.2026.	PROJECT NAME	EMPLOYER	DESIGNER	Device tag List			PAGE 127 / 156

1		2		3		4		5		6		7		8	
A 															

Approved by Contractor			Reconstruction and Modernisation of HPP Perucica - Phase II		 A Voith Company Sintaksa - A Voith Company Ulica Domovinskog rata 104/C, 21 000 Split, Hrvatska	Unit KA1 control cubicle circuit diagrams	DRAWING No.:	REV No.:	= UACJA10GH100	
Approved by Designer	Grga Kolić	01.10.2026.					PERU-01-19-170-31-001	02	+ UACJA10	
Checked by	Antonio Aleksić	01.10.2026.					Device tag List	Designer No.:	SALES No.:	PAGE 130
Drawn by	Tamara Troglić	01.10.2026.						PROJECT NAME	EMPLOYER	DESIGNER




Format ISO/DIN A3

Approved by Contractor			Reconstruction and Modernisation of HPP Perucica - Phase II		 A Voith Company	Unit KA1 control cubicle circuit diagrams	DRAWING No.:	REV No.:	= UACJA10GH100		
Approved by Designer	Grga Kolić	01.10.2026.			Sintaksa - A Voith Company Ulica Domovinskog rata 104C, 21 000 Split, Hrvatska		PERU-01-19-170-31-001	02	+ UACJA10		
Checked by	Antonio Aleksić	01.10.2026.			PROJECT NAME		EMPLOYER	DESIGNER	Designer No.:	SALES No.:	PAGE 132
Drawn by	Tamara Troglić	01.10.2026.							PAGE 132 / 156		

132

Format ISO/DIN A3

CONFIDENTIAL, ALL RIGHTS RESERVED DIN 34

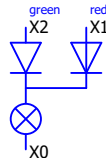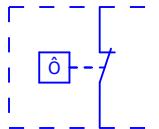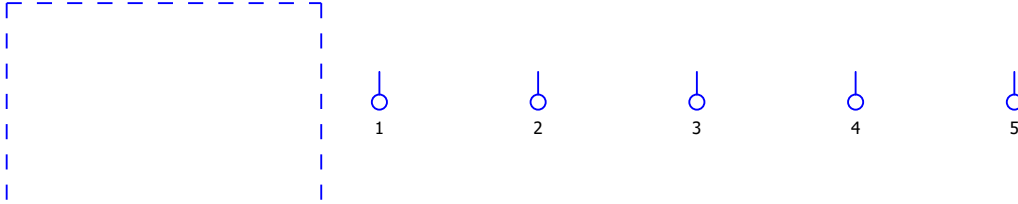1	2	3	4	5	6	7	8			
Qty. (pcs)	Equipment technical description	Manufacturer	Location (+)	Designation (-)	Symbol Position in schematics (Page, column)					
2	Indicator Light The indicators glow in two colors: red or green. Power supply is connected as follows: X0 - common terminal (ground) X1 - red color (voltage) X2 - green color (voltage) Diameter - 22mm 24 AC/DC Order No.: PK22-WP/24									
								+UACJA10	-H101	/42.5:D
								+UACJA10	-H106	/42.1:D
1	Thermostat HellermannTyton Thermostat, NC contact 0...+60°C Type: THR02 Order No.: THR02	Alfa Electric								
								+UACJA10	-B101	/5.5:E
1	Measuring instrument VOITH Frequency converter with electrical isolation for measuring the speed from the residual voltage of the generator in connection with a speed transducer. Order No.: VFU1	VOITH								
								+UACJA10	-U201	/48.1:D

133

Format ISO/DIN A3

Approved by Contractor			Reconstruction and Modernisation of HPP Perucica - Phase II		 A Voith Company Sintaksa - A Voith Company Ulica Domovinskog rata 104C, 21 000 Split, Hrvatska	Unit KA1 control cubicle circuit diagrams Device tag List	DRAWING No.:	REV No.:	= UACJA10GH100
Approved by Designer	Grga Kolić	01.10.2026.					PERU-01-19-170-31-001	02	+ UACJA10
Checked by	Antonio Aleksić	01.10.2026.	PROJECT NAME	EMPLOYER	DESIGNER		Designer No.:	SALES No.:	PAGE 133
Drawn by	Tamara Trogrlić	01.10.2026.					PAGE 133 / 156		

CONFIDENTIAL, ALL RIGHTS RESERVED DIN 34

Format ISO/DIN A3

133

	Cable name : -1WT100		Number of conductors : 7		Description :			
			Number of used conductors : 5					
	Cable type : LiYCY		Cable cross section : 0.75					
	External Connections			Internal Connections				
To device		Pin designation	Page/column	Connection color/number	From device		Pin designation	Page/column
=T1+T1-X1		1	=UACJA10GH100+UACJA10/10.8:E	WH	=UACJA10GH100+UACJA10-X141		2:A	=UACJA10GH100+UACJA10/10.8:D
=T1+T1-X1		5	=UACJA10GH100+UACJA10/10.8:E	BN	=UACJA10GH100+UACJA10-X141		20:A	=UACJA10GH100+UACJA10/10.8:D
=T1+T1-X1		9	=UACJA10GH100+UACJA10/45.3:C	GN	=UACJA10GH100+UACJA10-X135		12:A	=UACJA10GH100+UACJA10/45.3:E
=T1+T1-X1		10	=UACJA10GH100+UACJA10/45.3:C	YE	=UACJA10GH100+UACJA10-PE_SH		6:A	=UACJA10GH100+UACJA10/45.3:C
=T1+T1-X1		11	=UACJA10GH100+UACJA10/48.7:C	GY	=UACJA10GH100+UACJA10-X51		5:A	=UACJA10GH100+UACJA10/48.7:D
				PK				
				BU				

	Cable name : -1WT101		Number of conductors : 7		Description :			
			Number of used conductors : 4					
	Cable type : LiYCY		Cable cross section : 0.75					
	External Connections				Internal Connections			
To device		Pin designation	Page/column	Connection color/number	From device		Pin designation	Page/column
=T1+T1-X1		12	=UACJA10GH100+UACJA10/48.5:C	WH	=UACJA10GH100+UACJA10-X51		1:A	=UACJA10GH100+UACJA10/48.5:D
=T1+T1-X1		13	=UACJA10GH100+UACJA10/48.5:C	BN	=UACJA10GH100+UACJA10-X51		2:A	=UACJA10GH100+UACJA10/48.5:D
=T1+T1-X1		14	=UACJA10GH100+UACJA10/48.5:C	GN	=UACJA10GH100+UACJA10-X51		3:A	=UACJA10GH100+UACJA10/48.5:D
=T1+T1-X1		15	=UACJA10GH100+UACJA10/30.4:C	YE	=UACJA10GH100+UACJA10-1K114		A1	=UACJA10GH100+UACJA10/30.4:D
				GY				
				PK				
				BU				

	Cable name : -01-0UA01+UV01-7-104		Number of conductors : 10		Description :	
			Number of used conductors : 10			
	Cable type : NYCY		Cable cross section : 2.5			
	External Connections			Connection color/number	Internal Connections	
To device	Pin designation	Page/column	From device		Pin designation	Page/column
=0UA01+UV01-X30	1	=UACJA10GH100+UACJA10/10.4:E	1BK	=UACJA10GH100+UACJA10-X139	1:A	=UACJA10GH100+UACJA10/10.4:D
=0UA01+UV01-X30	2	=UACJA10GH100+UACJA10/10.5:E	2BK	=UACJA10GH100+UACJA10-X139	12:A	=UACJA10GH100+UACJA10/10.5:D
=0UA01+UV01-X11	18	=UACJA10GH100+UACJA10/34.4:B	3BK	=UACJA10GH100+UACJA10-X139	2:A	=UACJA10GH100+UACJA10/34.4:B
=0UA01+UV01-X11	19	=UACJA10GH100+UACJA10/34.4:C	4BK	=UACJA10GH100+UACJA10-1K154	A1	=UACJA10GH100+UACJA10/34.4:D
=0UA01+UV01-X11	23	=UACJA10GH100+UACJA10/34.5:B	5BK	=UACJA10GH100+UACJA10-X139	3:A	=UACJA10GH100+UACJA10/34.5:B
=0UA01+UV01-X11	25	=UACJA10GH100+UACJA10/34.5:C	6BK	=UACJA10GH100+UACJA10-1K155	A1	=UACJA10GH100+UACJA10/34.5:D
=0UA01+UV01-X11	2	=UACJA10GH100+UACJA10/34.6:B	7BK	=UACJA10GH100+UACJA10-X139	4:A	=UACJA10GH100+UACJA10/34.6:B
=0UA01+UV01-X11	3	=UACJA10GH100+UACJA10/34.6:C	8BK	=UACJA10GH100+UACJA10-1K156	A1	=UACJA10GH100+UACJA10/34.6:D
=0UA01+UV01-X11	27	=UACJA10GH100+UACJA10/34.7:C	9BK	=UACJA10GH100+UACJA10-1K157	A1	=UACJA10GH100+UACJA10/34.7:D
=0UA01+UV01-X11	29	=UACJA10GH100+UACJA10/34.7:B	10BK	=UACJA10GH100+UACJA10-X139	5:A	=UACJA10GH100+UACJA10/34.7:B

Approved by Contractor			Reconstruction and Modernisation of HPP Perucica - Phase II		 A Voith Company Sintaksa - A Voith Company Ulica Domovinskog rata 104C, 21 000 Split, Hrvatska	Unit KA1 control cubicle circuit diagrams CABLE DIAGRAM	DRAWING No.: PERU-01-19-170-31-001	REV No.:	= UACJA10GH100
Approved by Designer	Grga Kolić	01.10.2026.					Designer No.:	SALES No.:	+ UACJA10
Checked by	Antonio Aleksić	01.10.2026.							PAGE 134
Drawn by	Tamara Trogrlić	01.10.2026.	PROJECT NAME	EMPLOYER	DESIGNER				PAGE 134 / 156

CONFIDENTIAL, ALL RIGHTS RESERVED DIN 34

Format ISO/DIN A3

	Cable name : -01-0XC01+XC01-7-101		Number of conductors : 10		Description :	
	Cable type : NYCY		Number of used conductors : 8			
			Cable cross section : 2.5			
	External Connections			Connection color/number	Internal Connections	
To device	Pin designation	Page/column	From device		Pin designation	Page/column
=0XC01+XC01-X01	1	=UACJA10GH100+UACJA10/35.2:B	1BK	=UACJA10GH100+UACJA10-X139	7:A	=UACJA10GH100+UACJA10/35.2:B
=0XC01+XC01-X02	1	=UACJA10GH100+UACJA10/35.2:C	2BK	=UACJA10GH100+UACJA10-1K162	A1	=UACJA10GH100+UACJA10/35.2:D
=0XC01+XC01-X02	3	=UACJA10GH100+UACJA10/35.3:C	3BK	=UACJA10GH100+UACJA10-1K163	A1	=UACJA10GH100+UACJA10/35.3:D
=0XC01+XC01-X02	6	=UACJA10GH100+UACJA10/35.4:C	4BK	=UACJA10GH100+UACJA10-1K164	A1	=UACJA10GH100+UACJA10/35.4:D
=0XC01+XC01-X02	5	=UACJA10GH100+UACJA10/35.5:C	5BK	=UACJA10GH100+UACJA10-1K165	A1	=UACJA10GH100+UACJA10/35.5:D
=0XC01+XC01-X02	4	=UACJA10GH100+UACJA10/35.6:C	6BK	=UACJA10GH100+UACJA10-1K166	A1	=UACJA10GH100+UACJA10/35.6:D
=0XC01+XC01-X02	7	=UACJA10GH100+UACJA10/35.7:C	7BK	=UACJA10GH100+UACJA10-1K167	A1	=UACJA10GH100+UACJA10/35.7:D
=0XC01+XC01-X02	2	=UACJA10GH100+UACJA10/35.8:C	8BK	=UACJA10GH100+UACJA10-1K168	A1	=UACJA10GH100+UACJA10/35.8:D

	Cable name :	-01-1NA01+NA01-1-204	Number of conductors :		4	Description :
	Cable type :	NYCY	Number of used conductors :		3	
			Cable cross section :		4	
External Connections			Connection color/number	Internal Connections		
To device	Pin designation	Page/column		From device	Pin designation	Page/column
=1NA01+NA01-N		=UACJA10GH100+UACJA10/5.2:B	BU	=UACJA10GH100+UACJA10-X0	2:A	=UACJA10GH100+UACJA10/5.2:C
=1NA01+NA01-X10	16	=UACJA10GH100+UACJA10/5.2:B	BN	=UACJA10GH100+UACJA10-X0	1:A	=UACJA10GH100+UACJA10/5.2:C
			BK			
			GY			
=1NA01+NA01-X10	19/PE	=UACJA10GH100+UACJA10/5.3:B	GY	=UACJA10GH100+UACJA10-X0	3:A	=UACJA10GH100+UACJA10/5.3:C

	Cable name :	-01-1NA01+NA01-2-203	Number of conductors :		4	Description :
	Cable type :	NYCY	Number of used conductors :		2	
			Cable cross section :		4	
External Connections			Connection color/number	Internal Connections		
To device	Pin designation	Page/column		From device	Pin designation	Page/column
=1NA01+NA01-X4	6	=UACJA10GH100+UACJA10/6.1:F	BU	=UACJA10GH100+UACJA10-X10	2:A	=UACJA10GH100+UACJA10/6.1:E
=1NA01+NA01-X4	5	=UACJA10GH100+UACJA10/6.1:F	BN	=UACJA10GH100+UACJA10-X10	1:A	=UACJA10GH100+UACJA10/6.1:E
			BK			
			GY			

	Cable name : -01-1NA01+NA01-2-204		Number of conductors : 3		Description :			
	Cable type : NYY		Number of used conductors : 2					
			Cable cross section : 4					
External Connections			Connection color/number	Internal Connections				
To device		Pin designation		Page/column	From device		Pin designation	Page/column
=1NA01+NA01-X4		9		=UACJA10GH100+UACJA10/6.2:F	=UACJA10GH100+UACJA10-X10		3:A	=UACJA10GH100+UACJA10/6.2:E
=1NA01+NA01-X4		10		=UACJA10GH100+UACJA10/6.2:F	=UACJA10GH100+UACJA10-X10		4:A	=UACJA10GH100+UACJA10/6.2:E
				GNYE				

Approved by Contractor			Reconstruction and Modernisation of HPP Perucica - Phase II		 A Voith Company Sintaksa - A Voith Company Ulica Domovinskog rata 104C, 21 000 Split, Hrvatska	Unit KA1 control cubicle circuit diagrams CABLE DIAGRAM	DRAWING No.: PERU-01-19-170-31-001	REV No.:	= UACJA10GH100
Approved by Designer	Grga Kolić	01.10.2026.							+ UACJA10
Checked by	Antonio Aleksić	01.10.2026.					Designer No.:	SALES No.:	PAGE 135
Drawn by	Tamara Trogrlić	01.10.2026.	PROJECT NAME	EMPLOYER	DESIGNER				PAGE 135 / 156

CONFIDENTIAL, ALL RIGHTS RESERVED DIN 34

Format ISO/DIN A3

135

Approved by Contractor			Reconstruction and Modernisation of HPP Perucica - Phase II		 A Voith Company Sintaksa - A Voith Company Ulica Domovinskog rata 104C, 21 000 Split, Hrvatska	Unit KA1 control cubicle circuit diagrams CABLE DIAGRAM	DRAWING No.:	REV No.:	= UACJA10GH100
Approved by Designer	Grga Kolić	01.10.2026.						PERU-01-19-170-31-001	+ UACJA10
Checked by	Antonio Aleksić	01.10.2026.					SALES No.:	PAGE	136
Drawn by	Tamara Trogrlić	01.10.2026.						PAGE	136 / 156

	Cable name :	-01-1NA01+NA01-4-301	Number of conductors :	2	Description :	
			Number of used conductors :	2		
	Cable type :	NYCY	Cable cross section :	2.5		
External Connections			Connection color/number	Internal Connections		
To device	Pin designation	Page/column		From device	Pin designation	Page/column
=1NA01+NA01-X11	1	=UACJA10GH100+UACJA10/20.3:B	BN	=UACJA10GH100+UACJA10-X137	2:A	=UACJA10GH100+UACJA10/20.3:B
=1NA01+NA01-X11	2	=UACJA10GH100+UACJA10/20.3:C	BU	=UACJA10GH100+UACJA10-1K11	A1	=UACJA10GH100+UACJA10/20.3:D

	Cable name : -01-1NA01+NA01-4-302		Number of conductors : 2		Description :			
	Cable type : NYCY		Number of used conductors : 2					
			Cable cross section : 2.5					
	External Connections			Connection color/number	Internal Connections			
To device		Pin designation	Page/column		From device		Pin designation	Page/column
=1NA01+NA01-X11		43	=UACJA10GH100+UACJA10/21.5:C	BN	=UACJA10GH100+UACJA10-1K25		A1	=UACJA10GH100+UACJA10/21.5:D
=1NA01+NA01-X11		7	=UACJA10GH100+UACJA10/21.5:B	BU	=UACJA10GH100+UACJA10-X137		5:A	=UACJA10GH100+UACJA10/21.5:B

	Cable name : -01-1NA01+NA01-4-303		Number of conductors : 19		Description :		
	Cable type : NYCY		Number of used conductors : 9				
			Cable cross section : 2.5				
	External Connections			Connection color/number	Internal Connections		
To device	Pin designation	Page/column	From device		Pin designation	Page/column	
=1NA01+NA01-X11	10	=UACJA10GH100+UACJA10/21.4:B	1BK	=UACJA10GH100+UACJA10-X137	4:A	=UACJA10GH100+UACJA10/21.4:B	
=1NA01+NA01-X11	12	=UACJA10GH100+UACJA10/21.4:C	2BK	=UACJA10GH100+UACJA10-1K24	A1	=UACJA10GH100+UACJA10/21.4:D	
=1NA01+NA01-X11	16	=UACJA10GH100+UACJA10/20.4:C	3BK	=UACJA10GH100+UACJA10-1K12	A1	=UACJA10GH100+UACJA10/20.4:D	
=1NA01+NA01-X11	24	=UACJA10GH100+UACJA10/20.6:C	5BK	=UACJA10GH100+UACJA10-1K14	A1	=UACJA10GH100+UACJA10/20.6:D	
=1NA01+NA01-X11	32	=UACJA10GH100+UACJA10/20.8:C	7BK	=UACJA10GH100+UACJA10-1K16	A1	=UACJA10GH100+UACJA10/20.8:D	
=1NA01+NA01-X11	36	=UACJA10GH100+UACJA10/21.1:C	8BK	=UACJA10GH100+UACJA10-1K21	A1	=UACJA10GH100+UACJA10/21.1:D	
=1NA01+NA01-X11	40	=UACJA10GH100+UACJA10/21.2:C	9BK	=UACJA10GH100+UACJA10-1K22	A1	=UACJA10GH100+UACJA10/21.2:D	
=1NA01+NA01-X11	44	=UACJA10GH100+UACJA10/21.3:C	10BK	=UACJA10GH100+UACJA10-1K23	A1	=UACJA10GH100+UACJA10/21.3:D	
=UACJA10GH100+UACJA10-1K56	A1	=UACJA10GH100+UACJA10/24.6:D	11	=1NA01+NA01-X5.1	3	=UACJA10GH100+UACJA10/24.6:C	

	Cable name : -01-1NA01+NA01-4-304		Number of conductors : 2		Description :			
	Cable type : NYCY		Number of used conductors : 2					
			Cable cross section : 2.5					
External Connections			Connection color/number	Internal Connections				
To device		Pin designation		Page/column	From device		Pin designation	Page/column
=1NA01+NA01-X5		1	=UACJA10GH100+UACJA10/21.6:B	BN	=UACJA10GH100+UACJA10-X137		6:A	=UACJA10GH100+UACJA10/21.6:B
=1NA01+NA01-X5		2	=UACJA10GH100+UACJA10/21.6:C	BU	=UACJA10GH100+UACJA10-1K26		A1	=UACJA10GH100+UACJA10/21.6:D

1

2

3

4

5

6

7

8

137

CONFIDENTIAL, ALL RIGHTS RESERVED DIN 34

Format ISO/DIN A3

136

1

2

3

4

5

6

7

8

	Cable name : -01-1NA01+NA01-4-305		Number of conductors : 2		Description :			
	Cable type : NYCY		Number of used conductors : 2					
			Cable cross section : 2.5					
	External Connections			Connection color/number	Internal Connections			
To device		Pin designation	Page/column		From device		Pin designation	Page/column
=1NA01+NA01-X5		7	=UACJA10GH100+UACJA10/21.7:B		=UACJA10GH100+UACJA10-X137		7:A	=UACJA10GH100+UACJA10/21.7:B
=1NA01+NA01-X5		9	=UACJA10GH100+UACJA10/21.7:C		=UACJA10GH100+UACJA10-1K27		A1	=UACJA10GH100+UACJA10/21.7:D

	Cable name : -01-1NA01+NA01-4-306		Number of conductors : 2		Description :			
	Cable type : NYCY		Number of used conductors : 2					
			Cable cross section : 2.5					
	External Connections			Connection color/number	Internal Connections			
To device		Pin designation	Page/column		From device		Pin designation	Page/column
=1NA01+NA01-X5		10	=UACJA10GH100+UACJA10/21.8:B		=UACJA10GH100+UACJA10-X137		8:A	=UACJA10GH100+UACJA10/21.8:B
=1NA01+NA01-X5		11	=UACJA10GH100+UACJA10/21.8:C		=UACJA10GH100+UACJA10-1K28		A1	=UACJA10GH100+UACJA10/21.8:D

	Cable name :	-01-1NA01+NA01-4-307	Number of conductors :		2	Description :		
	Cable type :	NYCY	Number of used conductors :		2			
			Cable cross section :		2.5			
External Connections			Connection color/number	Internal Connections				
To device		Pin designation		Page/column	From device		Pin designation	Page/column
=1NA01+NA01-X5		16	=UACJA10GH100+UACJA10/22.1:B	BN	=UACJA10GH100+UACJA10-X137		9:A	=UACJA10GH100+UACJA10/22.1:B
=1NA01+NA01-X5		18	=UACJA10GH100+UACJA10/22.1:C	BU	=UACJA10GH100+UACJA10-1K31		A1	=UACJA10GH100+UACJA10/22.1:D

	Cable name :	-01-1NA01+NA01-4-308	Number of conductors :		2	Description :		
	Cable type :	NYCY	Number of used conductors :		2			
			Cable cross section :		2.5			
External Connections			Connection color/number	Internal Connections				
To device		Pin designation		Page/column	From device		Pin designation	Page/column
=1NA01+NA01-X5		19	=UACJA10GH100+UACJA10/23.5:B	BN	=UACJA10GH100+UACJA10-X137		13:A	=UACJA10GH100+UACJA10/23.5:B
=1NA01+NA01-X5		61	=UACJA10GH100+UACJA10/23.5:C	BU	=UACJA10GH100+UACJA10-1K45		A1	=UACJA10GH100+UACJA10/23.5:D

	Cable name : -01-1NA01+NA01-4-309		Number of conductors : 19		Description :	
	Cable type : NYCY		Number of used conductors : 14			
			Cable cross section : 2.5			
	External Connections			Connection color/number	Internal Connections	
To device	Pin designation	Page/column	From device		Pin designation	Page/column
=1NA01+NA01-X5	20	=UACJA10GH100+UACJA10/22.2:B	1BK	=UACJA10GH100+UACJA10-X137	10:A	=UACJA10GH100+UACJA10/22.2:B
=1NA01+NA01-X5	22	=UACJA10GH100+UACJA10/22.2:C	2BK	=UACJA10GH100+UACJA10-1K32	A1	=UACJA10GH100+UACJA10/22.2:D
=1NA01+NA01-X5	46	=UACJA10GH100+UACJA10/22.3:C	3BK	=UACJA10GH100+UACJA10-1K33	A1	=UACJA10GH100+UACJA10/22.3:D
=1NA01+NA01-X5	26	=UACJA10GH100+UACJA10/22.4:C	4BK	=UACJA10GH100+UACJA10-1K34	A1	=UACJA10GH100+UACJA10/22.4:D
=1NA01+NA01-X5	50	=UACJA10GH100+UACJA10/22.5:C	5BK	=UACJA10GH100+UACJA10-1K35	A1	=UACJA10GH100+UACJA10/22.5:D
=1NA01+NA01-X5	30	=UACJA10GH100+UACJA10/22.6:C	6BK	=UACJA10GH100+UACJA10-1K36	A1	=UACJA10GH100+UACJA10/22.6:D
=1NA01+NA01-X5	54	=UACJA10GH100+UACJA10/22.7:C	7BK	=UACJA10GH100+UACJA10-1K37	A1	=UACJA10GH100+UACJA10/22.7:D
=1NA01+NA01-X5	34	=UACJA10GH100+UACJA10/22.8:C	8BK	=UACJA10GH100+UACJA10-1K38	A1	=UACJA10GH100+UACJA10/22.8:D

Approved by Contractor			Reconstruction and Modernisation of HPP Perucica - Phase II		 A Voith Company Sintaksa - A Voith Company Ulica Domovinskog rata 104C, 21 000 Split, Hrvatska	Unit KA1 control cubicle circuit diagrams CABLE DIAGRAM	DRAWING No.: PERU-01-19-170-31-001	REV No.:	= UACJA10GH100
Approved by Designer	Grga Kolić	01.10.2026.							+ UACJA10
Checked by	Antonio Aleksić	01.10.2026.					Designer No.:	SALES No.:	PAGE 137
Drawn by	Tamara Trogrlić	01.10.2026.							PAGE 137 / 156

1

2

3

4

5

6

7

8

CONFIDENTIAL, ALL RIGHTS RESERVED DIN 34

Format ISO/DIN A3

137

139

Approved by Contractor			Reconstruction and Modernisation of HPP Perucica - Phase II		 A Voith Company Sintaksa - A Voith Company Ulica Domovinskog rata 104C, 21 000 Split, Hrvatska	Unit KA1 control cubicle circuit diagrams CABLE DIAGRAM	DRAWING No.: PERU-01-19-170-31-001	REV No.:	= UACJA10GH100
Approved by Designer	Grga Kolić	01.10.2026.							+ UACJA10
Checked by	Antonio Aleksić	01.10.2026.					Designer No.:	SALES No.:	PAGE 138
Drawn by	Tamara Trogrlić	01.10.2026.							PAGE 138 / 156

	Cable name :	-01-1NA01+NA01-4-309	Number of conductors :	19	Description :
			Number of used conductors :	14	
	Cable type :	NYCY	Cable cross section :	2.5	

External Connections			Connection color/number	Internal Connections		
To device	Pin designation	Page/column		From device	Pin designation	Page/column
=1NA01+NA01-X5	58	=UACJA10GH100+UACJA10/23.1:C	9BK	=UACJA10GH100+UACJA10-1K41	A1	=UACJA10GH100+UACJA10/23.1:D
=1NA01+NA01-X5	38	=UACJA10GH100+UACJA10/23.2:C	10BK	=UACJA10GH100+UACJA10-1K42	A1	=UACJA10GH100+UACJA10/23.2:D
=1NA01+NA01-X5	62	=UACJA10GH100+UACJA10/23.3:C	11BK	=UACJA10GH100+UACJA10-1K43	A1	=UACJA10GH100+UACJA10/23.3:D
=1NA01+NA01-X5	42	=UACJA10GH100+UACJA10/23.4:C	12BK	=UACJA10GH100+UACJA10-1K44	A1	=UACJA10GH100+UACJA10/23.4:D
=1NA01+NA01-X5.1	1	=UACJA10GH100+UACJA10/24.5:B	13BK	=UACJA10GH100+UACJA10-X137	18:A	=UACJA10GH100+UACJA10/24.5:B
=1NA01+NA01-X5.1	2	=UACJA10GH100+UACJA10/24.5:C	14BK	=UACJA10GH100+UACJA10-1K55	A1	=UACJA10GH100+UACJA10/24.5:D

	Cable name :	-01-1NA01+NA01-4-311	Number of conductors :	2	Description :
			Number of used conductors :	2	
	Cable type :	NYCY	Cable cross section :	2.5	

External Connections			Connection color/number	Internal Connections		
To device	Pin designation	Page/column		From device	Pin designation	Page/column
=1NA01+NA01-X8	7	=UACJA10GH100+UACJA10/24.4:B	BN	=UACJA10GH100+UACJA10-X137	17:A	=UACJA10GH100+UACJA10/24.4:B
=1NA01+NA01-X8	25	=UACJA10GH100+UACJA10/24.4:C	BU	=UACJA10GH100+UACJA10-1K54	A1	=UACJA10GH100+UACJA10/24.4:D

	Cable name :	-01-1NA01+NA01-4-312	Number of conductors :	19	Description :
			Number of used conductors :	6	
	Cable type :	NYCY	Cable cross section :	2.5	

External Connections			Connection color/number	Internal Connections		
To device	Pin designation	Page/column		From device	Pin designation	Page/column
=1NA01+NA01-X8	7	=UACJA10GH100+UACJA10/23.7:B	1BK	=UACJA10GH100+UACJA10-X137	15:A	=UACJA10GH100+UACJA10/23.7:B
=1NA01+NA01-X8	10	=UACJA10GH100+UACJA10/23.7:C	2BK	=UACJA10GH100+UACJA10-1K47	A1	=UACJA10GH100+UACJA10/23.7:D
=1NA01+NA01-X8	14	=UACJA10GH100+UACJA10/23.8:C	3BK	=UACJA10GH100+UACJA10-1K48	A1	=UACJA10GH100+UACJA10/23.8:D
=1NA01+NA01-X8	18	=UACJA10GH100+UACJA10/24.1:C	4BK	=UACJA10GH100+UACJA10-1K51	A1	=UACJA10GH100+UACJA10/24.1:D
=1NA01+NA01-X8	22	=UACJA10GH100+UACJA10/24.2:C	5BK	=UACJA10GH100+UACJA10-1K52	A1	=UACJA10GH100+UACJA10/24.2:D
=1NA01+NA01-X8	26	=UACJA10GH100+UACJA10/24.3:C	6BK	=UACJA10GH100+UACJA10-1K53	A1	=UACJA10GH100+UACJA10/24.3:D

	Cable name :	-01-1UA01+EA01-3-101	Number of conductors :	7	Description :
			Number of used conductors :	4	
	Cable type :	NYCY	Cable cross section :	2.5	

External Connections			Connection color/number	Internal Connections		
To device	Pin designation	Page/column		From device	Pin designation	Page/column
=UAMKC10GH100+UAMKC11-X0	5	=UACJA10GH100+UACJA10/73.3:B	1BK	=UACJA10GH100+UACJA10-XT1	1:A	=UACJA10GH100+UACJA10/73.3:D
=UAMKC10GH100+UAMKC11-X0	6	=UACJA10GH100+UACJA10/73.3:B	2BK	=UACJA10GH100+UACJA10-XT1	2:A	=UACJA10GH100+UACJA10/73.3:D
=UAMKC10GH100+UAMKC11-X0	7	=UACJA10GH100+UACJA10/73.4:B	3BK	=UACJA10GH100+UACJA10-XT1	3:A	=UACJA10GH100+UACJA10/73.4:D
=UAMKC10GH100+UAMKC11-X0	8	=UACJA10GH100+UACJA10/73.5:B	4BK	=UACJA10GH100+UACJA10-XT1	6:A	=UACJA10GH100+UACJA10/73.5:D

CONFIDENTIAL, ALL RIGHTS RESERVED DIN 34

Format ISO/DIN A3

138

140

Approved by Contractor			Reconstruction and Modernisation of HPP Perucica - Phase II		 A Voith Company Sintaksa - A Voith Company Ulica Domovinskog rata 104C, 21 000 Split, Hrvatska	Unit KA1 control cubicle circuit diagrams CABLE DIAGRAM	DRAWING No.:	REV No.:	= UACJA10GH100
Approved by Designer	Grga Kolić	01.10.2026.						+ UACJA10	
Checked by	Antonio Aleksić	01.10.2026.					SALES No.:	PAGE 139	
Drawn by	Tamara Trogrlić	01.10.2026.						PAGE 139 / 156	

	Cable name :	-01-1UA01+EA01-7-402	Number of conductors :	19	Description :
			Number of used conductors :	2	
	Cable type :	NYCY	Cable cross section :	2.5	

External Connections			Connection color/number	Internal Connections		
To device	Pin designation	Page/column		From device	Pin designation	Page/column
=UAMKC10GH100+UAMKC11-X80	60	=UACJA10GH100+UACJA10/28.8:B	1BK	=UACJA10GH100+UACJA10-X138	18:A	=UACJA10GH100+UACJA10/28.8:B
=UAMKC10GH100+UAMKC11-K1	14	=UACJA10GH100+UACJA10/28.8:C	2BK	=UACJA10GH100+UACJA10-1K98	A1	=UACJA10GH100+UACJA10/28.8:D

	Cable name :	-01-1UA01+EA01-7-403	Number of conductors :	4	Description :
			Number of used conductors :	4	
	Cable type :	NYCY	Cable cross section :	2.5	

External Connections			Connection color/number	Internal Connections		
To device	Pin designation	Page/column		From device	Pin designation	Page/column
=UAMKC10GH100+UAMKC11-X80	26	=UACJA10GH100+UACJA10/28.3:C	BK	=UACJA10GH100+UACJA10-1K93	A1	=UACJA10GH100+UACJA10/28.3:D
=UAMKC10GH100+UAMKC11-X80	23	=UACJA10GH100+UACJA10/28.4:B	BN	=UACJA10GH100+UACJA10-X138	14:A	=UACJA10GH100+UACJA10/28.4:B
=UAMKC10GH100+UAMKC11-X80	24	=UACJA10GH100+UACJA10/28.4:C	BU	=UACJA10GH100+UACJA10-1K94	A1	=UACJA10GH100+UACJA10/28.4:D
=UAMKC10GH100+UAMKC11-X80	25	=UACJA10GH100+UACJA10/28.3:B	GY	=UACJA10GH100+UACJA10-X138	13:A	=UACJA10GH100+UACJA10/28.3:B

	Cable name :	-01-1UA01+EA01-7-404	Number of conductors :	7	Description :
			Number of used conductors :	6	
	Cable type :	NYCY	Cable cross section :	2.5	

External Connections			Connection color/number	Internal Connections		
To device	Pin designation	Page/column		From device	Pin designation	Page/column
=UAMKC10GH100+UAMKC11-X80	40	=UACJA10GH100+UACJA10/28.5:B	1BK	=UACJA10GH100+UACJA10-X138	15:A	=UACJA10GH100+UACJA10/28.5:B
=UAMKC10GH100+UAMKC11-X80	41	=UACJA10GH100+UACJA10/28.5:C	2BK	=UACJA10GH100+UACJA10-1K95	A1	=UACJA10GH100+UACJA10/28.5:D
=UAMKC10GH100+UAMKC11-X80	42	=UACJA10GH100+UACJA10/28.6:B	3BK	=UACJA10GH100+UACJA10-X138	16:A	=UACJA10GH100+UACJA10/28.6:B
=UAMKC10GH100+UAMKC11-X80	44	=UACJA10GH100+UACJA10/28.6:C	4BK	=UACJA10GH100+UACJA10-1K96	A1	=UACJA10GH100+UACJA10/28.6:D
=UAMKC10GH100+UAMKC11-X80	43	=UACJA10GH100+UACJA10/28.7:B	5BK	=UACJA10GH100+UACJA10-X138	17:A	=UACJA10GH100+UACJA10/28.7:B
=UAMKC10GH100+UAMKC11-X80	45	=UACJA10GH100+UACJA10/28.7:C	6BK	=UACJA10GH100+UACJA10-1K97	A1	=UACJA10GH100+UACJA10/28.7:D

	Cable name :	-01-1UA01+NE07-3-603	Number of conductors :	5	Description :
			Number of used conductors :	2	
	Cable type :	NYCY	Cable cross section :	2.5	

External Connections			Connection color/number	Internal Connections		
To device	Pin designation	Page/column		From device	Pin designation	Page/column
=NE07+NE07-X1	13	=UACJA10GH100+UACJA10/77.3:B	1	=UACJA10GH100+UACJA10-XT4	4:A	=UACJA10GH100+UACJA10/77.3:B
=NE07+NE07-X1	11	=UACJA10GH100+UACJA10/77.2:B	3	=UACJA10GH100+UACJA10-XT4	1:A	=UACJA10GH100+UACJA10/77.2:B

CONFIDENTIAL, ALL RIGHTS RESERVED DIN 34

Format ISO/DIN A3

	Cable name : -01-1UA01+NE07-4-103		Number of conductors : 7		Description :			
	Cable type : NYCY		Number of used conductors : 3					
			Cable cross section : 2.5					
External Connections			Connection color/number	Internal Connections				
To device		Pin designation		Page/column	From device		Pin designation	Page/column
=NE07+NE07-X2		54	=UACJA10GH100+UACJA10/25.4:C	1BK	=UACJA10GH100+UACJA10-1K64		A1	=UACJA10GH100+UACJA10/25.4:D
=NE07+NE07-X2		53	=UACJA10GH100+UACJA10/25.4:B	2BK	=UACJA10GH100+UACJA10-X14		5:A	=UACJA10GH100+UACJA10/25.4:B
=NE07+NE07-X2		55	=UACJA10GH100+UACJA10/25.5:C	3BK	=UACJA10GH100+UACJA10-1K65		A1	=UACJA10GH100+UACJA10/25.5:D

	Cable name : -01-1UA01+NE08-3-601		Number of conductors : 5		Description :	
	Cable type : NYCY		Number of used conductors : 4			
			Cable cross section : 2.5			
	External Connections			Connection color/number	Internal Connections	
To device	Pin designation	Page/column	From device		Pin designation	Page/column
=NE08+NE08-X1	13	=UACJA10GH100+UACJA10/74.3:B	1BK	=UACJA10GH100+UACJA10-XT2	7:A	=UACJA10GH100+UACJA10/74.3:B
=NE08+NE08-X1	11	=UACJA10GH100+UACJA10/74.2:B	BN	=UACJA10GH100+UACJA10-XT2	1:A	=UACJA10GH100+UACJA10/74.2:B
=NE08+NE08-X1	17	=UACJA10GH100+UACJA10/74.5:B	BU	=UACJA10GH100+UACJA10-XT2	16:A	=UACJA10GH100+UACJA10/74.5:B
=NE08+NE08-X1	15	=UACJA10GH100+UACJA10/74.4:B	GY	=UACJA10GH100+UACJA10-XT2	12:A	=UACJA10GH100+UACJA10/74.4:B

	Cable name : -01-1UA01+NE08-4-101		Number of conductors : 12		Description :		
	Cable type : NYCY		Number of used conductors : 9				
			Cable cross section : 2.5				
	External Connections			Connection color/number	Internal Connections		
To device	Pin designation	Page/column	From device		Pin designation	Page/column	
=NE08+NE08-X2	39	=UACJA10GH100+UACJA10/24.8:C	1BK	=UACJA10GH100+UACJA10-1K58	A1	=UACJA10GH100+UACJA10/24.8:D	
=NE08+NE08-X2	40	=UACJA10GH100+UACJA10/25.1:C	3BK	=UACJA10GH100+UACJA10-1K61	A1	=UACJA10GH100+UACJA10/25.1:D	
=NE08+NE08-X2	20	=UACJA10GH100+UACJA10/25.6:B	4BK	=UACJA10GH100+UACJA10-X14	6:A	=UACJA10GH100+UACJA10/25.6:B	
=NE08+NE08-X2	46	=UACJA10GH100+UACJA10/25.2:C	5BK	=UACJA10GH100+UACJA10-1K62	A1	=UACJA10GH100+UACJA10/25.2:D	
=NE08+NE08-X2	33	=UACJA10GH100+UACJA10/25.2:B	6BK	=UACJA10GH100+UACJA10-X14	3:A	=UACJA10GH100+UACJA10/25.2:B	
=NE08+NE08-X2	48	=UACJA10GH100+UACJA10/25.3:C	7BK	=UACJA10GH100+UACJA10-1K63	A1	=UACJA10GH100+UACJA10/25.3:D	
=NE08+NE08-X2	34	=UACJA10GH100+UACJA10/25.3:B	8BK	=UACJA10GH100+UACJA10-X14	4:A	=UACJA10GH100+UACJA10/25.3:B	
=NE08+NE08-X2	37	=UACJA10GH100+UACJA10/25.6:C	9BK	=UACJA10GH100+UACJA10-1K66	A1	=UACJA10GH100+UACJA10/25.6:D	
=NE08+NE08-X2	38	=UACJA10GH100+UACJA10/25.7:C	10BK	=UACJA10GH100+UACJA10-1K67	A1	=UACJA10GH100+UACJA10/25.7:D	

	Cable name : -01-1UA01+NE09-3-602		Number of conductors : 5		Description :	
	Cable type : NYCY		Number of used conductors : 4			
			Cable cross section : 2.5			
	External Connections			Connection color/number	Internal Connections	
To device	Pin designation	Page/column	From device		Pin designation	Page/column
=NE09+NE09-X2	67	=UACJA10GH100+UACJA10/76.3:B	1	=UACJA10GH100+UACJA10-XT3	5:A	=UACJA10GH100+UACJA10/76.3:B
=NE09+NE09-X2	66	=UACJA10GH100+UACJA10/76.2:B	3	=UACJA10GH100+UACJA10-XT3	1:A	=UACJA10GH100+UACJA10/76.2:B
=NE09+NE09-X2	69	=UACJA10GH100+UACJA10/76.4:B	4	=UACJA10GH100+UACJA10-XT3	11:A	=UACJA10GH100+UACJA10/76.4:B
=NE09+NE09-X2	68	=UACJA10GH100+UACJA10/76.4:B	5	=UACJA10GH100+UACJA10-XT3	9:A	=UACJA10GH100+UACJA10/76.4:B

Approved by Contractor			Reconstruction and Modernisation of HPP Perucica - Phase II		 A Voith Company Sintaksa - A Voith Company Ulica Domovinskog rata 104C, 21 000 Split, Hrvatska	Unit KA1 control cubicle circuit diagrams CABLE DIAGRAM	DRAWING No.: PERU-01-19-170-31-001	REV No.:	= UACJA10GH100
Approved by Designer	Grga Kolić	01.10.2026.							+ UACJA10
Checked by	Antonio Aleksić	01.10.2026.					Designer No.:	SALES No.:	PAGE 140
Drawn by	Tamara Trogrlić	01.10.2026.							PAGE 140 / 156

CONFIDENTIAL, ALL RIGHTS RESERVED DIN 34

Format ISO/DIN A3

140

142

Approved by Contractor			Reconstruction and Modernisation of HPP Perucica - Phase II		 A Voith Company Sintaksa - A Voith Company Ulica Domovinskog rata 104C, 21 000 Split, Hrvatska	Unit KA1 control cubicle circuit diagrams CABLE DIAGRAM	DRAWING No.:	REV No.:	= UACJA10GH100
Approved by Designer	Grga Kolić	01.10.2026.					PERU-01-19-170-31-001		+ UACJA10
Checked by	Antonio Aleksić	01.10.2026.					Designer No.:	SALES No.:	PAGE 141
Drawn by	Tamara Trogrlić	01.10.2026.							PAGE 141 / 156

	Cable name : -01-1UA01+UN03-4-017		Number of conductors :	10	Description :		
	Cable type : NYCY		Number of used conductors :	2			
			Cable cross section :	1.5			
	External Connections			Connection color/number	Internal Connections		
To device	Pin designation	Page/column	From device		Pin designation	Page/column	
			1				
			2				
			3				
=UACHA10GH100+UACHA10-X141	6	=UACJA10GH100+UACJA10/66.3:E	4	=UACJA10GH100+UACJA10-X73	3:A	=UACJA10GH100+UACJA10/66.3:D	
			5				
			6				
			7				
=UACHA10GH100+UACHA10-X141	15	=UACJA10GH100+UACJA10/66.4:E	8	=UACJA10GH100+UACJA10-X73	4:A	=UACJA10GH100+UACJA10/66.4:D	
			9				
			10				

	Cable name : -01-1UA01+UN03-4-018		Number of conductors : 10	Description :		
	Cable type : NYCY		Number of used conductors : 2			
			Cable cross section : 1.5			
			External Connections		Internal Connections	
To device	Pin designation	Page/column	Connection color/number	From device	Pin designation	Page/column
			1			
			2			
			3			
			4			
			5			
			6			
			7			
			8			
			9			
			10			
=UACHA10GH100+UACHA10-X141	20	=UACJA10GH100+UACJA10/66.6:E	BK	=UACJA10GH100+UACJA10-X73	7:A	=UACJA10GH100+UACJA10/66.6:D
=UACHA10GH100+UACHA10-X141	26	=UACJA10GH100+UACJA10/66.7:E	BU	=UACJA10GH100+UACJA10-X73	8:A	=UACJA10GH100+UACJA10/66.7:D

	Cable name : -01-1UA01+UN04-3-701		Number of conductors : 4		Description :	
	Cable type : NYCY		Number of used conductors : 4			
			Cable cross section : 2.5			
	External Connections			Connection color/number	Internal Connections	
To device	Pin designation	Page/column	From device		Pin designation	Page/column
			BU			
=UAMKC10GH100+UAMKC11-X0	11	=UACJA10GH100+UACJA10/75.3:E	BN	=UACJA10GH100+UACJA10-XT2	8:B	=UACJA10GH100+UACJA10/74.3:B
=UAMKC10GH100+UAMKC11-X0	10	=UACJA10GH100+UACJA10/75.3:E	BK	=UACJA10GH100+UACJA10-XT2	3:B	=UACJA10GH100+UACJA10/74.2:B
=UAMKC10GH100+UAMKC11-X0	12	=UACJA10GH100+UACJA10/75.3:E	GY	=UACJA10GH100+UACJA10-XT2	13:B	=UACJA10GH100+UACJA10/74.4:B
=UAMKC10GH100+UAMKC11-X0	?	=UACJA10GH100+UACJA10/75.4:E	GNYE	=UACJA10GH100+UACJA10-XT2	17:B	=UACJA10GH100+UACJA10/74.5:B

BDE

CONFIDENTIAL, ALL RIGHTS RESERVED DIN 34

Format ISO/DIN A3

142

144

Approved by Contractor			Reconstruction and Modernisation of HPP Perucica - Phase II		 A Voith Company Sintaksa - A Voith Company Ulica Domovinskog rata 104C, 21 000 Split, Hrvatska	Unit KA1 control cubicle circuit diagrams CABLE DIAGRAM	DRAWING No.: PERU-01-19-170-31-001	REV No.:	= UACJA10GH100
Approved by Designer	Grga Kolić	01.10.2026.							+ UACJA10
Checked by	Antonio Aleksić	01.10.2026.					Designer No.:	SALES No.:	PAGE 143
Drawn by	Tamara Trogrlić	01.10.2026.							PAGE 143 / 156

	Cable name :	-01-1UA01+UN04-4-016	Number of conductors :		10	Description :
			Number of used conductors :		8	
	Cable type :	NYCY	Cable cross section :		1.5	
External Connections			Connection color/number	Internal Connections		
To device	Pin designation	Page/column		From device	Pin designation	Page/column
=UACHA10GH100+UACHA10-X161	60	=UACJA10GH100+UACJA10/55.6:E	2	=UACJA10GH100+UACJA10-X72	13:A	=UACJA10GH100+UACJA10/55.6:E
=UACHA10GH100+UACHA10-X161	61	=UACJA10GH100+UACJA10/55.7:E	4	=UACJA10GH100+UACJA10-X72	14:A	=UACJA10GH100+UACJA10/55.7:E
=UACHA10GH100+UACHA10-X152	2	=UACJA10GH100+UACJA10/55.4:E	7	=UACJA10GH100+UACJA10-X72	1:A	=UACJA10GH100+UACJA10/55.4:E
=UACHA10GH100+UACHA10-X152	6	=UACJA10GH100+UACJA10/55.5:E	9	=UACJA10GH100+UACJA10-X72	2:A	=UACJA10GH100+UACJA10/55.5:E

	Cable name : -01-1UA01+UN04-4-106		Number of conductors : 10		Description :			
			Number of used conductors : 8					
	Cable type : NYCY		Cable cross section : 2.5					
	External Connections			Connection color/number	Internal Connections			
To device	Pin designation	Page/column	From device		Pin designation	Page/column		
=NE08+NE08-X2		60	=UACJA10GH100+UACJA10/54.3:D	1BK	=UACJA10GH100+UACJA10-X71		7:A	=UACJA10GH100+UACJA10/54.3:E
=NE08+NE08-X2		4	=UACJA10GH100+UACJA10/54.3:D	2BK	=UACJA10GH100+UACJA10-X71		8:A	=UACJA10GH100+UACJA10/54.3:E
=NE08+NE08-X2		14	=UACJA10GH100+UACJA10/54.2:C	3BK	=UACJA10GH100+UACJA10-X71		1:A	=UACJA10GH100+UACJA10/54.2:C
=NE08+NE08-X2		9	=UACJA10GH100+UACJA10/54.3:C	4BK	=UACJA10GH100+UACJA10-X71		5:A	=UACJA10GH100+UACJA10/54.3:C
=NE08+NE08-X2		7	=UACJA10GH100+UACJA10/54.2:C	5BK	=UACJA10GH100+UACJA10-X71		3:A	=UACJA10GH100+UACJA10/54.2:C
=NE08+NE08-X2		1	=UACJA10GH100+UACJA10/54.4:C	6BK	=UACJA10GH100+UACJA10-X71		13:A	=UACJA10GH100+UACJA10/54.4:C
=NE08+NE08-X2		12	=UACJA10GH100+UACJA10/54.2:D	7BK	=UACJA10GH100+UACJA10-X71		2:A	=UACJA10GH100+UACJA10/54.2:E
=NE08+NE08-X2		61	=UACJA10GH100+UACJA10/54.2:D	8BK	=UACJA10GH100+UACJA10-X71		4:A	=UACJA10GH100+UACJA10/54.2:E

	Cable name : -01-1UA01+UN04-4-112		Number of conductors : 8		Description :	
			Number of used conductors : 4			
	Cable type : NYCY		Cable cross section : 1.5			
	External Connections			Connection color/number	Internal Connections	
To device	Pin designation	Page/column	From device		Pin designation	Page/column
=UN5+UN5-X2	24	=UACJA10GH100+UACJA10/54.6:C	1	=UACJA10GH100+UACJA10-X71	9:A	=UACJA10GH100+UACJA10/54.6:C
=UN5+UN5-X2	28	=UACJA10GH100+UACJA10/54.6:D	2	=UACJA10GH100+UACJA10-X71	10:A	=UACJA10GH100+UACJA10/54.6:E
=UN5+UN5-X2	25	=UACJA10GH100+UACJA10/54.6:C	3	=UACJA10GH100+UACJA10-X71	11:A	=UACJA10GH100+UACJA10/54.6:C
=UN5+UN5-X2	120	=UACJA10GH100+UACJA10/54.6:D	4	=UACJA10GH100+UACJA10-X71	12:A	=UACJA10GH100+UACJA10/54.6:E
			5			
			6			
			7			
			8			

CONFIDENTIAL, ALL RIGHTS RESERVED DIN 34

Format ISO/DIN A3

	Cable name : -01-1UA01+UN04-7-106		Number of conductors : 7		Description :	
	Cable type : NYCY		Number of used conductors : 5			
			Cable cross section : 2.5			
External Connections			Connection color/number	Internal Connections		
To device	Pin designation	Page/column		From device	Pin designation	Page/column
=0UA01+UV01-X10	1	=UACJA10GH100+UACJA10/67.2:E	1BK	=UACJA10GH100+UACJA10-X139	14:A	=UACJA10GH100+UACJA10/67.2:A
=0UA01+UV01-X10	5	=UACJA10GH100+UACJA10/67.2:E	2BK	=UACJA10GH100+UACJA10-X139	16:A	=UACJA10GH100+UACJA10/67.2:D
=0UA01+UV01-X10	8	=UACJA10GH100+UACJA10/67.3:E	3BK	=UACJA10GH100+UACJA10-X139	17:A	=UACJA10GH100+UACJA10/67.3:D
=0UA01+UV01-X10	11	=UACJA10GH100+UACJA10/67.4:E	4BK	=UACJA10GH100+UACJA10-X139	18:A	=UACJA10GH100+UACJA10/67.4:D
=0UA01+UV01-X10	14	=UACJA10GH100+UACJA10/67.5:E	5BK	=UACJA10GH100+UACJA10-X139	19:A	=UACJA10GH100+UACJA10/67.5:D

	Cable name : -01-1UA01+UN04-7-401		Number of conductors :	19	Description :	
	Cable type : NYCY		Number of used conductors :	8		
			Cable cross section :	2.5		
External Connections			Connection color/number	Internal Connections		
To device	Pin designation	Page/column		From device	Pin designation	Page/column
=UAMKC10GH100+UAMKC11-X80	61	=UACJA10GH100+UACJA10/65.1:E	1BK	=UACJA10GH100+UACJA10-X72	7:A	=UACJA10GH100+UACJA10/65.1:D
=UAMKC10GH100+UAMKC11-K701		=UACJA10GH100+UACJA10/65.3:E	2BK	=UACJA10GH100+UACJA10-X72	9:A	=UACJA10GH100+UACJA10/65.3:D
=UAMKC10GH100+UAMKC11-K700		=UACJA10GH100+UACJA10/65.2:E	3BK	=UACJA10GH100+UACJA10-X72	8:A	=UACJA10GH100+UACJA10/65.2:D
=UAMKC10GH100+UAMKC11-K707		=UACJA10GH100+UACJA10/65.4:E	4BK	=UACJA10GH100+UACJA10-X72	10:A	=UACJA10GH100+UACJA10/65.4:D
=UAMKC10GH100+UAMKC11-K712		=UACJA10GH100+UACJA10/65.5:E	5BK	=UACJA10GH100+UACJA10-X72	11:A	=UACJA10GH100+UACJA10/65.5:D
=UAMKC10GH100+UAMKC11-K713		=UACJA10GH100+UACJA10/63.2:E	6BK	=UACJA10GH100+UACJA10-X72	3:A	=UACJA10GH100+UACJA10/63.2:D
=UAMKC10GH100+UAMKC11-K714		=UACJA10GH100+UACJA10/63.3:E	7BK	=UACJA10GH100+UACJA10-X72	5:A	=UACJA10GH100+UACJA10/63.3:E
=UAMKC10GH100+UAMKC11-K717		=UACJA10GH100+UACJA10/65.6:E	8BK	=UACJA10GH100+UACJA10-X72	12:A	=UACJA10GH100+UACJA10/65.6:D

	Cable name : -01-1UA01+UN12-4-003		Number of conductors : 5		Description :			
	Cable type : NYCY		Number of used conductors : 2					
			Cable cross section : 2.5					
	External Connections			Connection color/number	Internal Connections			
To device		Pin designation	Page/column		From device		Pin designation	Page/column
=UACHA10GH100+UACHA10-X153		5	=UACJA10GH100+UACJA10/58.2:C	BU	=UACJA10GH100+UACJA10-X14		19:A	=UACJA10GH100+UACJA10/58.2:C
				GY				
				BN				
=UACHA10GH100+UACHA10-X153		1	=UACJA10GH100+UACJA10/58.2:B	1BK	=UACJA10GH100+UACJA10-X14		10:A	=UACJA10GH100+UACJA10/58.2:A
				2BK				

	Cable name : -01-1UA01+UN12-4-011		Number of conductors : 10		Description :			
	Cable type : NYCY		Number of used conductors : 4					
			Cable cross section : 1.5					
External Connections			Connection color/number	Internal Connections				
To device		Pin designation		Page/column	From device		Pin designation	Page/column
=UACHA10GH100+UACHA10-X161		4	=UACJA10GH100+UACJA10/27.4:B	1	=UACJA10GH100+UACJA10-X138		9:A	=UACJA10GH100+UACJA10/27.4:B
=UACHA10GH100+UACHA10-X161		5	=UACJA10GH100+UACJA10/27.4:C	2	=UACJA10GH100+UACJA10-1K84		A1	=UACJA10GH100+UACJA10/27.4:D
				3				
				4				
				5				

Approved by Contractor			Reconstruction and Modernisation of HPP Perucica - Phase II		 A Voith Company	Unit KA1 control cubicle circuit diagrams	DRAWING No.:	REV No.:	= UACJA10GH100	
Approved by Designer	Grga Kolić	01.10.2026.					PERU-01-19-170-31-001		+ UACJA10	
Checked by	Antonio Aleksić	01.10.2026.					CABLE DIAGRAM	Designer No.:	SALES No.:	PAGE 144
Drawn by	Tamara Trogrlić	01.10.2026.								PAGE 144 / 156
PROJECT NAME			EMPLOYER	DESIGNER						

CONFIDENTIAL, ALL RIGHTS RESERVED DIN 34

Format ISO/DIN A3

144

146

Approved by Contractor			Reconstruction and Modernisation of HPP Perucica - Phase II		 A Voith Company Sintaksa - A Voith Company Ulica Domovinskog rata 104C, 21 000 Split, Hrvatska	Unit KA1 control cubicle circuit diagrams CABLE DIAGRAM	DRAWING No.:	REV No.:	= UACJA10GH100
Approved by Designer	Grga Kolić	01.10.2026.						+ UACJA10	
Checked by	Antonio Aleksić	01.10.2026.					SALES No.:	PAGE 145	
Drawn by	Tamara Trogrlić	01.10.2026.						PAGE 145 / 156	

	Cable name :	-01-1UA01+UN12-4-011	Number of conductors :	10	Description :	
	Cable type :	NYCY	Number of used conductors :	4		
			Cable cross section :	1.5		
External Connections			Connection color/number	Internal Connections		
To device	Pin designation	Page/column		From device	Pin designation	Page/column
			6			
=UACHA10GH100+UACHA10-X161	10	=UACJA10GH100+UACJA10/26.8:B	7	=UACJA10GH100+UACJA10-X138	5:A	=UACJA10GH100+UACJA10/26.8:B
=UACHA10GH100+UACHA10-X161	11	=UACJA10GH100+UACJA10/26.8:C	8	=UACJA10GH100+UACJA10-1K78	A1	=UACJA10GH100+UACJA10/26.8:D
			9			
			10			

	Cable name : -01-1UA01+UN12-4-012		Number of conductors : 10		Description :			
	Cable type : NYCY		Number of used conductors : 8					
			Cable cross section : 1.5					
	External Connections			Connection color/number	Internal Connections			
To device		Pin designation	Page/column		From device		Pin designation	Page/column
=UACHA10GH100+UACHA10-X161		12	=UACJA10GH100+UACJA10/27.1:B	1	=UACJA10GH100+UACJA10-X138		6:A	=UACJA10GH100+UACJA10/27.1:B
=UACHA10GH100+UACHA10-X161		13	=UACJA10GH100+UACJA10/27.1:C	2	=UACJA10GH100+UACJA10-1K81		A1	=UACJA10GH100+UACJA10/27.1:D
=UACHA10GH100+UACHA10-X161		14	=UACJA10GH100+UACJA10/27.2:B	3	=UACJA10GH100+UACJA10-X138		7:A	=UACJA10GH100+UACJA10/27.2:B
=UACHA10GH100+UACHA10-X161		15	=UACJA10GH100+UACJA10/27.2:C	4	=UACJA10GH100+UACJA10-1K82		A1	=UACJA10GH100+UACJA10/27.2:D
=UACHA10GH100+UACHA10-X161		16	=UACJA10GH100+UACJA10/27.3:B	5	=UACJA10GH100+UACJA10-X138		8:A	=UACJA10GH100+UACJA10/27.3:B
=UACHA10GH100+UACHA10-X161		17	=UACJA10GH100+UACJA10/27.3:C	6	=UACJA10GH100+UACJA10-1K83		A1	=UACJA10GH100+UACJA10/27.3:D
=UACHA10GH100+UACHA10-X161		47	=UACJA10GH100+UACJA10/26.6:C	7	=UACJA10GH100+UACJA10-1K76		A1	=UACJA10GH100+UACJA10/26.6:D
=UACHA10GH100+UACHA10-X161		46	=UACJA10GH100+UACJA10/26.6:B	8	=UACJA10GH100+UACJA10-X138		3:A	=UACJA10GH100+UACJA10/26.6:B
				9				
				10				

	Cable name : -1319		Number of conductors : 4		Description :		
	Cable type : LiYCY		Number of used conductors : 3				
			Cable cross section : 0.75				
External Connections			Connection color/number	Internal Connections			
To device	Pin designation	Page/column		From device	Pin designation	Page/column	
=UACJA10GH100+UACJA10-X141	13:A	=UACJA10GH100+UACJA10/33.2:B	WH	=UACJA10GH100+UACJA10-TI4	1	=UACJA10GH100+UACJA10/33.2:B	
=UACJA10GH100+UACJA10-TI4	2	=UACJA10GH100+UACJA10/33.2:C	BN	=UACJA10GH100+UACJA10-1K142	A1	=UACJA10GH100+UACJA10/33.2:D	
=UACJA10GH100+UACJA10-TI4	3	=UACJA10GH100+UACJA10/33.2:C	GN	=UACJA10GH100+UACJA10-1K143	A1	=UACJA10GH100+UACJA10/33.3:D	
			YE				

CONFIDENTIAL, ALL RIGHTS RESERVED DIN 34

Format ISO/DIN A3

145

147

Approved by Contractor			Reconstruction and Modernisation of HPP Perucica - Phase II		 A Voith Company Sintaksa - A Voith Company Ulica Domovinskog rata 104C, 21 000 Split, Hrvatska	Unit KA1 control cubicle circuit diagrams CABLE DIAGRAM	DRAWING No.:	REV No.:	= UACJA10GH100
Approved by Designer	Grga Kolić	01.10.2026.						+ UACJA10	
Checked by	Antonio Aleksić	01.10.2026.					SALES No.:	PAGE 146	
Drawn by	Tamara Trogrlić	01.10.2026.						PAGE 146 / 156	

	Cable name : -1320		Number of conductors : 4		Description :			
			Number of used conductors : 3					
	Cable type : LiYCY		Cable cross section : 0.75					
	External Connections			Connection color/number	Internal Connections			
To device	Pin designation	Page/column	From device		Pin designation	Page/column		
=UACJA10GH100+UACJA10-TI3		1	=UACJA10GH100+UACJA10/32.8:B	WH	=UACJA10GH100+UACJA10-X141		11:A	=UACJA10GH100+UACJA10/32.8:B
=UACJA10GH100+UACJA10-TI3		2	=UACJA10GH100+UACJA10/32.8:C	BN	=UACJA10GH100+UACJA10-1K138		A1	=UACJA10GH100+UACJA10/32.8:D
=UACJA10GH100+UACJA10-TI3		3	=UACJA10GH100+UACJA10/32.8:C	GN	=UACJA10GH100+UACJA10-1K141		A1	=UACJA10GH100+UACJA10/33.1:D
				YE				

	Cable name : -1321		Number of conductors : 4		Description :			
			Number of used conductors : 3					
	Cable type : LiYCY		Cable cross section : 0.75					
	External Connections			Connection color/number	Internal Connections			
To device	Pin designation	Page/column	From device		Pin designation	Page/column		
=UACJA10GH100+UACJA10-X141		15:A	=UACJA10GH100+UACJA10/33.6:B	WH	=UACJA10GH100+UACJA10-TI2		1	=UACJA10GH100+UACJA10/33.6:B
=UACJA10GH100+UACJA10-TI2		2	=UACJA10GH100+UACJA10/33.6:C	BN	=UACJA10GH100+UACJA10-1K146		A1	=UACJA10GH100+UACJA10/33.6:D
=UACJA10GH100+UACJA10-TI2		3	=UACJA10GH100+UACJA10/33.6:C	GN	=UACJA10GH100+UACJA10-1K147		A1	=UACJA10GH100+UACJA10/33.7:D
				YE				

	Cable name :	-1322	Number of conductors :		4	Description :		
			Number of used conductors :		3			
	Cable type :	LiYCY	Cable cross section :		0.75			
External Connections				Internal Connections				
To device		Pin designation	Page/column	Connection color/number	From device		Pin designation	Page/column
=UACJA10GH100+UACJA10-X141		14:A	=UACJA10GH100+UACJA10/33.4:B	WH	=UACJA10GH100+UACJA10-TI1		1	=UACJA10GH100+UACJA10/33.4:B
=UACJA10GH100+UACJA10-TI1		2	=UACJA10GH100+UACJA10/33.4:C	BN	=UACJA10GH100+UACJA10-1K144		A1	=UACJA10GH100+UACJA10/33.4:D
=UACJA10GH100+UACJA10-TI1		3	=UACJA10GH100+UACJA10/33.4:C	GN	=UACJA10GH100+UACJA10-1K145		A1	=UACJA10GH100+UACJA10/33.5:D
				YE				

	Cable name : +UACJA10-W5001		Number of conductors : 7		Description :	
			Number of used conductors : 5			
	Cable type : NYCY		Cable cross section : 1.5			
	External Connections			Connection color/number	Internal Connections	
To device	Pin designation	Page/column	From device		Pin designation	Page/column
=OUT+OUT-H02	4	=UACJA10GH100+UACJA10/68.2:D	1	=UACJA10GH100+UACJA10-X144	10:A	=UACJA10GH100+UACJA10/68.2:D
=OUT+OUT-H02	2	=UACJA10GH100+UACJA10/68.3:D	2	=UACJA10GH100+UACJA10-X144	11:A	=UACJA10GH100+UACJA10/68.3:D
=OUT+OUT-H02	3	=UACJA10GH100+UACJA10/68.4:D	3	=UACJA10GH100+UACJA10-X144	12:A	=UACJA10GH100+UACJA10/68.4:D
=OUT+OUT-H02	1	=UACJA10GH100+UACJA10/68.5:D	4	=UACJA10GH100+UACJA10-X144	13:A	=UACJA10GH100+UACJA10/68.5:D
=OUT+OUT-H02	0	=UACJA10GH100+UACJA10/68.2:E	5	=UACJA10GH100+UACJA10-X144	8:A	=UACJA10GH100+UACJA10/68.2:F

CONFIDENTIAL, ALL RIGHTS RESERVED DIN 34

Format ISO/DIN A3

146

148

Approved by Contractor			Reconstruction and Modernisation of HPP Perucica - Phase II		 A Voith Company Sintaksa - A Voith Company Ulica Domovinskog rata 104C, 21 000 Split, Hrvatska	Unit KA1 control cubicle circuit diagrams CABLE DIAGRAM	DRAWING No.: PERU-01-19-170-31-001	REV No.:	= UACJA10GH100
Approved by Designer	Grga Kolić	01.10.2026.							+ UACJA10
Checked by	Antonio Aleksić	01.10.2026.					Designer No.:	SALES No.:	PAGE 147
Drawn by	Tamara Trogrlić	01.10.2026.							PAGE 147 / 156

	Cable name :	-UACJA10-W8001	Number of conductors :		Description :			
	Cable type :	ETHERLINE Y CAT5 2X2XAWG22	Number of used conductors : 1					
			Cable cross section :					
External Connections			Connection color/number	Internal Connections				
To device		Pin designation		Page/column	From device		Pin designation	Page/column
=0UA01+UV01-U?				=UACJA10GH100+UACJA10/78.2:E	=UACJA10GH100+UACJA10-U300		P2	=UACJA10GH100+UACJA10/78.3:C

	Cable name :	-UACJA10-W8002	Number of conductors :		Description :			
	Cable type :	ETHERLINE Y CAT5 2X2XAWG22	Number of used conductors : 1					
			Cable cross section :					
External Connections			Connection color/number	Internal Connections				
To device		Pin designation		Page/column	From device		Pin designation	Page/column
=UAMKC10GH100+UAMKC11-U?				=UACJA10GH100+UACJA10/78.4:E	=UACJA10GH100+UACJA10-U300		P5	=UACJA10GH100+UACJA10/78.3:B

	Cable name :	-UACJA10-W8003	Number of conductors :		Description :			
	Cable type :	ETHERLINE Y CAT5 2X2XAWG22	Number of used conductors : 1					
			Cable cross section :					
External Connections			Connection color/number	Internal Connections				
To device		Pin designation		Page/column	From device		Pin designation	Page/column
=UAMKC10GH100+UAMKC11-U?				=UACJA10GH100+UACJA10/78.5:E	=UACJA10GH100+UACJA10-U301		P2	=UACJA10GH100+UACJA10/78.5:C

	Cable name :	-UACJA10-W8004	Number of conductors :		Description :			
	Cable type :	ETHERLINE Y CAT5 2X2XAWG22	Number of used conductors : 1					
			Cable cross section :					
External Connections			Connection color/number	Internal Connections				
To device		Pin designation		Page/column	From device		Pin designation	Page/column
				IE				
=0UA01+UV01-U?			=UACJA10GH100+UACJA10/78.7:E		=UACJA10GH100+UACJA10-U301		P5	=UACJA10GH100+UACJA10/78.5:B

	Cable name : -UACJA10-W8005		Number of conductors :		Description :				
	Cable type : ETHERLINE Y CAT5 2X2XAWG22		Number of used conductors : 1						
			Cable cross section :						
External Connections			Connection color/number		Internal Connections				
To device		Pin designation			Page/column	From device		Pin designation	Page/column
				IE					
=AUMA+K1:C1:V1-U?			=UACJA10GH100+UACJA10/79.5:E			=UACJA10GH100+UACJA10-A350		X1P2:LAN	=UACJA10GH100+UACJA10/79.4:E

CONFIDENTIAL, ALL RIGHTS RESERVED DIN 34

Format ISO/DIN A3

147

149

Approved by Contractor			Reconstruction and Modernisation of HPP Perucica - Phase II		 A Voith Company Sintaksa - A Voith Company Ulica Domovinskog rata 104C, 21 000 Split, Hrvatska	Unit KA1 control cubicle circuit diagrams CABLE DIAGRAM	DRAWING No.:	REV No.:	= UACJA10GH100
Approved by Designer	Grga Kolić	01.10.2026.						PERU-01-19-170-31-001	+ UACJA10
Checked by	Antonio Aleksić	01.10.2026.					SALES No.:	PAGE	148
Drawn by	Tamara Trogrlić	01.10.2026.						PAGE	148 / 156

	Cable name : -UACJA10-W8006		Number of conductors :		Description :			
	Cable type : ETHERLINE Y CAT5 2X2XAWG22		Number of used conductors : 1					
			Cable cross section :					
External Connections			Connection color/number	Internal Connections				
To device		Pin designation		Page/column	From device		Pin designation	Page/column
				IE				
=AUMA+K1:C2:V2-U?			=UACJA10GH100+UACJA10/79.7:E	IE CABLE	=UACJA10GH100+UACJA10-A102		P2 R	=UACJA10GH100+UACJA10/12.3:E

	Cable name : -WK1001		Number of conductors : 4		Description :			
	Cable type : NYY		Number of used conductors : 2					
			Cable cross section : 2.5					
	External Connections			Connection color/number	Internal Connections			
To device		Pin designation	Page/column		From device		Pin designation	Page/column
=KZK1+KZK1-X1		1	=UACJA10GH100+UACJA10/10.7:E		=UACJA10GH100+UACJA10-X141		1:A	=UACJA10GH100+UACJA10/10.7:D
=KZK1+KZK1-X1		14	=UACJA10GH100+UACJA10/10.7:E		=UACJA10GH100+UACJA10-X141		19:A	=UACJA10GH100+UACJA10/10.7:D

	Cable name : -WK1002		Number of conductors : 12		Description :	
	Cable type : LiYCY		Number of used conductors : 12			
			Cable cross section : 0.75			
	External Connections			Connection color/number	Internal Connections	
To device	Pin designation	Page/column	From device		Pin designation	Page/column
=KZK1+KZK1-X1	30	=UACJA10GH100+UACJA10/31.8:C	WH	=UACJA10GH100+UACJA10-1K128	A1	=UACJA10GH100+UACJA10/31.8:D
=KZK1+KZK1-X1	29	=UACJA10GH100+UACJA10/31.7:C	BN	=UACJA10GH100+UACJA10-1K127	A1	=UACJA10GH100+UACJA10/31.7:D
=KZK1+KZK1-X1	28	=UACJA10GH100+UACJA10/31.6:C	GN	=UACJA10GH100+UACJA10-1K126	A1	=UACJA10GH100+UACJA10/31.6:D
=KZK1+KZK1-X1	27	=UACJA10GH100+UACJA10/31.3:C	YE	=UACJA10GH100+UACJA10-1K123	A1	=UACJA10GH100+UACJA10/31.3:D
=KZK1+KZK1-X1	35	=UACJA10GH100+UACJA10/32.5:C	GY	=UACJA10GH100+UACJA10-1K135	A1	=UACJA10GH100+UACJA10/32.5:D
=KZK1+KZK1-X1	33	=UACJA10GH100+UACJA10/32.3:C	PK	=UACJA10GH100+UACJA10-1K133	A1	=UACJA10GH100+UACJA10/32.3:D
=KZK1+KZK1-X1	26	=UACJA10GH100+UACJA10/31.2:C	BU	=UACJA10GH100+UACJA10-1K122	A1	=UACJA10GH100+UACJA10/31.2:D
=KZK1+KZK1-X1	36	=UACJA10GH100+UACJA10/32.6:C	RD	=UACJA10GH100+UACJA10-1K136	A1	=UACJA10GH100+UACJA10/32.6:D
=KZK1+KZK1-X1	25	=UACJA10GH100+UACJA10/31.1:C	BK	=UACJA10GH100+UACJA10-1K121	A1	=UACJA10GH100+UACJA10/31.1:D
=KZK1+KZK1-X1	32	=UACJA10GH100+UACJA10/32.2:C	VT	=UACJA10GH100+UACJA10-1K132	A1	=UACJA10GH100+UACJA10/32.2:D
=KZK1+KZK1-X1	34	=UACJA10GH100+UACJA10/32.4:C	GY-PK	=UACJA10GH100+UACJA10-1K134	A1	=UACJA10GH100+UACJA10/32.4:D
=KZK1+KZK1-X1	31	=UACJA10GH100+UACJA10/32.1:C	RD-BU	=UACJA10GH100+UACJA10-1K131	A1	=UACJA10GH100+UACJA10/32.1:D

	Cable name : -WK1003		Number of conductors : 4		Description :			
	Cable type : LiYCY		Number of used conductors : 1					
			Cable cross section : 0.75					
	External Connections			Connection color/number	Internal Connections			
To device		Pin designation	Page/column		From device		Pin designation	Page/column
=KZK1+KZK1-X1		37	=UACJA10GH100+UACJA10/45.2:C		=UACJA10GH100+UACJA10-X151		5:A	=UACJA10GH100+UACJA10/45.2:C

CONFIDENTIAL, ALL RIGHTS RESERVED DIN 34

Format ISO/DIN A3

148

150

Approved by Contractor			Reconstruction and Modernisation of HPP Perucica - Phase II		 A Voith Company Sintaksa - A Voith Company Ulica Domovinskog rata 104C, 21 000 Split, Hrvatska	Unit KA1 control cubicle circuit diagrams CABLE DIAGRAM	DRAWING No.: PERU-01-19-170-31-001	REV No.:	= UACJA10GH100
Approved by Designer	Grga Kolić	01.10.2026.							+ UACJA10
Checked by	Antonio Aleksić	01.10.2026.					Designer No.:	SALES No.:	PAGE 149
Drawn by	Tamara Trogrlić	01.10.2026.							PAGE 149 / 156

	Cable name :	-WK1004	Number of conductors :	7	Description :
			Number of used conductors :	5	
	Cable type :	YSLY	Cable cross section :	0.75	

External Connections			Connection color/number	Internal Connections		
To device	Pin designation	Page/column		From device	Pin designation	Page/column
=KZK1+KZK1-X2	1	=UACJA10GH100+UACJA10/52.4:E	BN	=UACJA10GH100+UACJA10-X15	11:A	=UACJA10GH100+UACJA10/52.4:D
=KZK1+KZK1-X2	3	=UACJA10GH100+UACJA10/52.4:E	BU	=UACJA10GH100+UACJA10-X15	7:A	=UACJA10GH100+UACJA10/52.4:B
=KZK1+KZK1-X2	9	=UACJA10GH100+UACJA10/52.2:E	GN	=UACJA10GH100+UACJA10-X15	10:A	=UACJA10GH100+UACJA10/52.2:D
=KZK1+KZK1-X2	10	=UACJA10GH100+UACJA10/52.2:E	GY	=UACJA10GH100+UACJA10-X15	9:A	=UACJA10GH100+UACJA10/52.2:D
=KZK1+KZK1-X2	5	=UACJA10GH100+UACJA10/52.6:E	YE	=UACJA10GH100+UACJA10-X15	12:A	=UACJA10GH100+UACJA10/52.6:D

	Cable name :	-WK1005	Number of conductors :	4	Description :
			Number of used conductors :	3	
	Cable type :	LiYCY	Cable cross section :	0.75	

External Connections			Connection color/number	Internal Connections		
To device	Pin designation	Page/column		From device	Pin designation	Page/column
			WH			
=KZK1+KZK1-X1	38	=UACJA10GH100+UACJA10/32.7:C	BN	=UACJA10GH100+UACJA10-1K137	A1	=UACJA10GH100+UACJA10/32.7:D
=KZK1+KZK1-X2	11	=UACJA10GH100+UACJA10/31.4:C	GN	=UACJA10GH100+UACJA10-1K124	A1	=UACJA10GH100+UACJA10/31.4:D
=KZK1+KZK1-X2	12	=UACJA10GH100+UACJA10/31.5:C	YE	=UACJA10GH100+UACJA10-1K125	A1	=UACJA10GH100+UACJA10/31.5:D

	Cable name :	-WK1006	Number of conductors :	4	Description :
			Number of used conductors :	2	
	Cable type :	PP00	Cable cross section :	1.5	

External Connections			Connection color/number	Internal Connections		
To device	Pin designation	Page/column		From device	Pin designation	Page/column
=TN+TN-X4	12	=UACJA10GH100+UACJA10/49.5:E	3	=UACJA10GH100+UACJA10-X62	7:A	=UACJA10GH100+UACJA10/49.5:D
=TN+TN-X4	13	=UACJA10GH100+UACJA10/49.6:E	4	=UACJA10GH100+UACJA10-X62	8:A	=UACJA10GH100+UACJA10/49.6:D

	Cable name :	-WS811	Number of conductors :	4	Description :
			Number of used conductors :	2	
	Cable type :	LiYCY	Cable cross section :	0.75	

External Connections			Connection color/number	Internal Connections		
To device	Pin designation	Page/column		From device	Pin designation	Page/column
=UACJA10GH100+UACJA10-S811	1	=UACJA10GH100+UACJA10/30.5:B	WH	=UACJA10GH100+UACJA10-X140	7:A	=UACJA10GH100+UACJA10/30.5:B
			BN			
			GN			
			YE			
=UACJA10GH100+UACJA10-1K115	A1	=UACJA10GH100+UACJA10/30.5:D	BN	=UACJA10GH100+UACJA10-S811	3	=UACJA10GH100+UACJA10/30.5:C

CONFIDENTIAL, ALL RIGHTS RESERVED DIN 34

Format ISO/DIN A3

149

151

Approved by Contractor			Reconstruction and Modernisation of HPP Perucica - Phase II		 A Voith Company Sintaksa - A Voith Company Ulica Domovinskog rata 104C, 21 000 Split, Hrvatska	Unit KA1 control cubicle circuit diagrams CABLE DIAGRAM	DRAWING No.: PERU-01-19-170-31-001	REV No.:	= UACJA10GH100
Approved by Designer	Grga Kolić	01.10.2026.							+ UACJA10
Checked by	Antonio Aleksić	01.10.2026.					Designer No.:	SALES No.:	PAGE 150
Drawn by	Tamara Trogrlić	01.10.2026.							PAGE 150 / 156

	Cable name : -WUN300		Number of conductors : 4		Description :			
	Cable type : PP00		Number of used conductors : 2					
			Cable cross section : 2.5					
	External Connections			Connection color/number	Internal Connections			
To device		Pin designation	Page/column		From device		Pin designation	Page/column
=TN+TN-X1		1	=UACJA10GH100+UACJA10/10.6:E		=UACJA10GH100+UACJA10-X140		1:A	=UACJA10GH100+UACJA10/10.6:D
=TN+TN-X1		14	=UACJA10GH100+UACJA10/10.6:E	=UACJA10GH100+UACJA10-X140		10:A	=UACJA10GH100+UACJA10/10.6:D	

	Cable name : -WUN301		Number of conductors : 7		Description :	
			Number of used conductors : 7			
	Cable type : LiYCY		Cable cross section : 0.75			
	External Connections			Connection color/number	Internal Connections	
To device	Pin designation	Page/column	From device		Pin designation	Page/column
=TN+TN-X1	29	=UACJA10GH100+UACJA10/30.1:C	WH	=UACJA10GH100+UACJA10-1K111	A1	=UACJA10GH100+UACJA10/30.1:D
=TN+TN-X1	30	=UACJA10GH100+UACJA10/30.2:C	BN	=UACJA10GH100+UACJA10-1K112	A1	=UACJA10GH100+UACJA10/30.2:D
=TN+TN-X1	31	=UACJA10GH100+UACJA10/50.4:E	GN	=UACJA10GH100+UACJA10-X136	15:A	=UACJA10GH100+UACJA10/50.4:D
=TN+TN-X1	32	=UACJA10GH100+UACJA10/50.2:E	YE	=UACJA10GH100+UACJA10-X136	13:A	=UACJA10GH100+UACJA10/50.2:D
=TN+TN-X1	33	=UACJA10GH100+UACJA10/50.3:E	GY	=UACJA10GH100+UACJA10-X136	14:A	=UACJA10GH100+UACJA10/50.3:D
=TN+TN-X1	36	=UACJA10GH100+UACJA10/50.5:E	PK	=UACJA10GH100+UACJA10-X136	16:A	=UACJA10GH100+UACJA10/50.5:D
=TN+TN-X1	37	=UACJA10GH100+UACJA10/50.6:E	BU	=UACJA10GH100+UACJA10-X136	17:A	=UACJA10GH100+UACJA10/50.6:D

	Cable name :	-WUN302	Number of conductors :		4	Description :		
			Number of used conductors :		4			
	Cable type :	LiYCY	Cable cross section :		0.75			
External Connections			Connection color/number	Internal Connections				
To device		Pin designation		Page/column	From device		Pin designation	Page/column
=TN+TN-X1		38		=UACJA10GH100+UACJA10/46.1:E	=UACJA10GH100+UACJA10-X140		15:B	=UACJA10GH100+UACJA10/46.1:D
=TN+TN-X1		39		=UACJA10GH100+UACJA10/46.3:E	=UACJA10GH100+UACJA10-X61		1:A	=UACJA10GH100+UACJA10/46.3:E
=TN+TN-X1		40		=UACJA10GH100+UACJA10/46.3:E	=UACJA10GH100+UACJA10-X61		2:A	=UACJA10GH100+UACJA10/46.3:E
=TN+TN-X1		41	=UACJA10GH100+UACJA10/46.3:E	=UACJA10GH100+UACJA10-X61		3:A	=UACJA10GH100+UACJA10/46.3:E	

	Cable name :	-WUN303	Number of conductors :	4	Description :		
			Number of used conductors :	2			
	Cable type :	LiYCY	Cable cross section :	0.75			
External Connections				Internal Connections			
To device		Pin designation	Page/column	Connection color/number	From device	Pin designation	Page/column
=TN+TN-X1		47	=UACJA10GH100+UACJA10/51.3:E	BN	=UACJA10GH100+UACJA10-X13	4:A	=UACJA10GH100+UACJA10/51.3:D
=TN+TN-X1		46	=UACJA10GH100+UACJA10/51.3:E	WH	=UACJA10GH100+UACJA10-X13	5:A	=UACJA10GH100+UACJA10/51.3:D

CONFIDENTIAL, ALL RIGHTS RESERVED DIN 34

Format ISO/DIN A3

	Cable name : -WUN304		Number of conductors : 7		Description :	
	Cable type : LiYCY		Number of used conductors : 4			
			Cable cross section : 0.75			
	External Connections			Connection color/number	Internal Connections	
To device	Pin designation	Page/column	From device		Pin designation	Page/column
=TN+TN-X2	12	=UACJA10GH100+UACJA10/44.5:C	WH	=UACJA10GH100+UACJA10-X151	3:A	=UACJA10GH100+UACJA10/44.5:C
=TN+TN-X2	15	=UACJA10GH100+UACJA10/30.3:C	BN	=UACJA10GH100+UACJA10-1K113	A1	=UACJA10GH100+UACJA10/30.3:D
=TN+TN-X2	18	=UACJA10GH100+UACJA10/44.1:C	GN	=UACJA10GH100+UACJA10-X151	1:A	=UACJA10GH100+UACJA10/44.1:C
=TN+TN-X2	20	=UACJA10GH100+UACJA10/44.3:C	YE	=UACJA10GH100+UACJA10-X151	2:A	=UACJA10GH100+UACJA10/44.3:C
			GY			
			PK			
			BU			

	Cable name : -WUN310		Number of conductors : 4		Description :			
	Cable type : PP00		Number of used conductors : 4					
			Cable cross section : 1.5					
	External Connections			Connection color/number	Internal Connections			
To device		Pin designation	Page/column		From device		Pin designation	Page/column
=TN+TN-X3		6	=UACJA10GH100+UACJA10/49.2:E	BK	=UACJA10GH100+UACJA10-X62		1:A	=UACJA10GH100+UACJA10/49.2:D
=TN+TN-X3		17	=UACJA10GH100+UACJA10/49.4:E	BN	=UACJA10GH100+UACJA10-X62		5:A	=UACJA10GH100+UACJA10/49.4:D
=TN+TN-X3		7	=UACJA10GH100+UACJA10/49.2:E	BU	=UACJA10GH100+UACJA10-X62		2:A	=UACJA10GH100+UACJA10/49.2:D
=TN+TN-X3		18	=UACJA10GH100+UACJA10/49.5:E	GNYE	=UACJA10GH100+UACJA10-X62		6:A	=UACJA10GH100+UACJA10/49.5:D

	Cable name : -WUN311		Number of conductors : 4		Description :			
	Cable type : PP00		Number of used conductors : 2					
			Cable cross section : 1.5					
	External Connections			Connection color/number	Internal Connections			
To device		Pin designation	Page/column		From device		Pin designation	Page/column
=TN+TN-X4		5	=UACJA10GH100+UACJA10/49.3:E	BK	=UACJA10GH100+UACJA10-X62		3:A	=UACJA10GH100+UACJA10/49.3:D
=TN+TN-X4		6	=UACJA10GH100+UACJA10/49.3:E	BU	=UACJA10GH100+UACJA10-X62		4:A	=UACJA10GH100+UACJA10/49.3:D

	Cable name : -WUN312		Number of conductors : 7		Description :	
	Cable type : LiYCY		Number of used conductors : 6			
			Cable cross section : 0.75			
	External Connections			Connection color/number	Internal Connections	
To device	Pin designation	Page/column	From device		Pin designation	Page/column
=TN+TN-X3	9	=UACJA10GH100+UACJA10/29.3:C	WH	=UACJA10GH100+UACJA10-1K103	A1	=UACJA10GH100+UACJA10/29.3:D
=TN+TN-X3	10	=UACJA10GH100+UACJA10/29.4:C	BN	=UACJA10GH100+UACJA10-1K104	A1	=UACJA10GH100+UACJA10/29.4:D
=TN+TN-X4	8	=UACJA10GH100+UACJA10/29.5:C	GN	=UACJA10GH100+UACJA10-1K105	A1	=UACJA10GH100+UACJA10/29.5:D
=TN+TN-X4	9	=UACJA10GH100+UACJA10/29.6:C	YE	=UACJA10GH100+UACJA10-1K106	A1	=UACJA10GH100+UACJA10/29.6:D
=TN+TN-X3	21	=UACJA10GH100+UACJA10/29.8:C	GY	=UACJA10GH100+UACJA10-1K108	A1	=UACJA10GH100+UACJA10/29.8:D
			PK			
=TN+TN-X3	20	=UACJA10GH100+UACJA10/29.7:C	BU	=UACJA10GH100+UACJA10-1K107	A1	=UACJA10GH100+UACJA10/29.7:D

Approved by Contractor			Reconstruction and Modernisation of HPP Perucica - Phase II		 A Voith Company Sintaksa - A Voith Company Ulica Domovinskog rata 104C, 21 000 Split, Hrvatska	Unit KA1 control cubicle circuit diagrams CABLE DIAGRAM	DRAWING No.: PERU-01-19-170-31-001	REV No.:	= UACJA10GH100
Approved by Designer	Grga Kolić	01.10.2026.							+ UACJA10
Checked by	Antonio Aleksić	01.10.2026.					Designer No.:	SALES No.:	PAGE 151
Drawn by	Tamara Trogrlić	01.10.2026.							PAGE 151 / 156

CONFIDENTIAL, ALL RIGHTS RESERVED DIN 34

Format ISO/DIN A3

1		2		3		4		5		6		7		8	
Device Tag (Location + Displayed DT)		Qty.	Description			Designation		Type number		Manufacturer		Part number			
=UACJA10GH100+UACJA10	A100	1	PROFINET, 2-port interface module IM 155-6PN/2 SIMATIC ET 200SP 1 BusAdapter slot; max. 64 I/O modules; 16 ET 200AL modules			Interface module ET200SP		6ES7155-6AU01-0CN0		SIE		SIE.6ES7155-6AU01-0CN0			
=UACJA10GH100+UACJA10	A100	1	SIMATIC ET 200SP, BA 2X RJ45, 2 RJ45 SOCKETS FOR PROFINET			PLC Bus adapter		6ES7193-6AR00-0AA0		SIE		SIE.6ES7193-6AR00-0AA0			
=UACJA10GH100+UACJA10	A101	1	Power supply module 25W 24 V DC Simatic S7-1500 Supplies the backplane bus of the S7-1500 with operating voltage			Power supply module for S7-1500		6ES7505-0KA00-0AB0		SIE		SIE.6ES7505-0KA00-0AB0			
=UACJA10GH100+UACJA10	A102	1	Work memory 1 MB and 4.5 MB for data 1st interface: PROFINET IRT with 2-port switch, 2nd interface: PROFINET RT, 6 ns bit performance SIMATIC Memory Card required			CPU 1515-2 PN SIMATIC S7-1500		6ES7515-2AN03-0AB0		SIE		SIE.6ES7515-2AN03-0AB0			
=UACJA10GH100+UACJA10	A102	1	SIMATIC S7, memory cards for S7-1x00 CPU/SINAMICS, 3, 3V Flash, 24 MB			SIMATIC S7 Memory card 24 MB For S7-1x00 CPU		6ES7954-8LF04-0AA0		SIE		SIE.6ES7954-8LF04-0AA0			
=UACJA10GH100+UACJA10	A103	2	Communications module CM 1542-1 for connection of S7-1500 to PROFINET as IO Controller or IO Device: TCP/IP, ISO-on-TCP, UDP, S7 communication, IP broadcast multicast, SNMPV1, time-of-day synchronization via NTP, 2xRJ45 (10/100 Mbit).			CM 1542-1		6GK7542-1AX10-0XE0		SIE		SIE.6GK7542-1AX10-0XE0			
=UACJA10GH100+UACJA10	A104;A105	2	1 channel for 24V incremental encoder or pulse encoder Type: TM count 1x 24 V Counter module Order No.: 6ES7138-6AA01-0BA0			Counter module for ET200SP		6ES7138-6AA01-0BA0		SIE		SIE.6ES7138-6AA01-0BA0			
=UACJA10GH100+UACJA10	A104;A131;A141	3	SIMATIC ET 200SP BU type A0 push-in terminals, without aux. terminals, new load group			BaseUnit BU15-P16+A0+2D		6ES7193-6BP00-0DA0		SIE		SIE.6ES7193-6BP00-0DA0			
=UACJA10GH100+UACJA10	A105;A111...A120 A132...A134;A151;A152 A161	17	BU type A0, Push-in terminals, without AUX terminals, bridged to the left			BaseUnit BU15-P16+A0+2B		6ES7193-6BP00-0BA0		SIE		SIE.6ES7193-6BP00-0BA0			
=UACJA10GH100+UACJA10	A111...A120	10	DI 16X24V DC Standard type 3 (IEC 61131); sink input; fits to BU-type A0 input delay time 0,05..20ms; Diagnostics: wire break, supply voltage			Digital input module ET 200SP		6ES7131-6BH01-0BA0		SIE		SIE.6ES7131-6BH01-0BA0			
=UACJA10GH100+UACJA10	A131...A134	4	DQ 16x 24V DC/0,5A fits to BU-type A0; Source output (PNP/P-switching); substitute value output; Module diagnostics: short-circuit to L+ and ground, wire break, supply voltage			Digital output module ET200SP		6ES7132-6BH01-0BA0		SIE		SIE.6ES7132-6BH01-0BA0			
=UACJA10GH100+UACJA10	A141	1	AI 4XI 2-/4-WIRE Standard fits to BU-TYPE A0, A1 Module diagnosis, 16 bit, +/-0,3%			Analog input module SIMATIC ET 200SP		6ES7134-6GD01-0BA1		SIE		SIE.6ES7134-6GD01-0BA1			
=UACJA10GH100+UACJA10	A151;A152	2	Analog input module for ET200SP, Type: AI 2XI 2-/4-WIRE Standard			Analog input module for ET 200SP		6ES7134-6GB00-0BA1		SIE		SIE.6ES7134-6GB00-0BA1			
=UACJA10GH100+UACJA10	A161	1	SIMATIC ET 200SP, Analog output module, AQ 4XU/I Standard, suitable for BU type A0, A1, Color code CC00, Module diagnostic s, 16 bit, +/-0.3%			Analog output module		6ES7135-6HD00-0BA1		SIE		SIE.6ES7135-6HD00-0BA1			
=UACJA10GH100+UACJA10	A171	1	SIMATIC ET 200SP, analog input module, AI Energy Meter CT ST, for 1A or 5A current transformer, suitable for BU type U0, channel diagnostics			SIMATIC ET 200SP AI Energy Meter CT ST		6ES7134-6PA01-0BU0		SIE		SIE.6ES7134-6PA01-0BU0			
=UACJA10GH100+UACJA10	A171	1	SIMATIC ET 200SP, BaseUnit BU20-P16+A0+2D, BU-TYPE U0, Packaging Unit: 1 Pieces, Push-in terminals, w/o AUX-terminals, new potential group, WxH: 20mm x 117mm			SIMATIC ET 200SP BU type U0 BU20-P16+A0+2D PU 1		6ES7193-6BP00-0DU0		SIE		SIE.6ES7193-6BP00-0DU0			
=UACJA10GH100+UACJA10	A350	1	SIMATIC HMI MTP1500, Unified Comfort Panel, touch operation, 15.6" widescreen TFT display, 16 million colors, PROFINET interface, configurable as of WinCC Unified Comfort V16, contains open-source software, which is provided free of charge see enclosed DVD			SIMATIC HMI MTP1500 Unified Comfort		6AV2128-3QB06-0AX1		SIE		SIE.6AV2128-3QB06-0AX1			
=UACJA10GH100+UACJA10	A350	1	2GB Type: SIMATIC SD Order No.: 6AV2181-8XP00-0AX0			Memory card		6AV2181-8XP00-0AX0		SIE		SIE.6AV2181-8XP00-0AX0			
=UACJA10GH100+UACJA10	B101	1	HellermannTyton Thermostat, NC contact 0...+60°C			Thermostat		THR02		ALFA ELECTRIC		THR02			
=UACJA10GH100+UACJA10	B102	1	Hygrostat, Rated Voltage 120-240 V AC, Rated Current 10-5A 10-90 %RF			Electronic hygrostat		IGR35F		FANDIS		FANDISEU.IGR35F			
=UACJA10GH100+UACJA10	B103	1	NO contact 0...+60°C			Thermostat		THV02		ALFA ELECTRIC		AEL.THV02			

151

153

Approved by Contractor			Reconstruction and Modernisation of HPP Perucica - Phase II			 A Voith Company Sintaksa - A Voith Company Ulica Domovinskog rata 104C, 21 000 Split, Hrvatska	Unit KA1 control cubicle circuit diagrams Summarized parts list		DRAWING No.:		REV No.:	= UACJA10GH100			
Approved by Designer		Grga Kolić							01.10.2026.	PERU-01-19-170-31-001			+ UACJA10		
Checked by		Antonio Aleksić	01.10.2026.	PROJECT NAME		EMPLOYER	DESIGNER			Designer No.:		SALES No.:	PAGE 152		
Drawn by		Tamara Trogrlić	01.10.2026.							PAGE 152 / 156					
1		2		3		4		5		6		7		8	

1		2		3		4		5		6		7		8		
A	CONFIDENTIAL, ALL RIGHTS RESERVED DIN 34 Format ISO/DIN A3															A
C																C
D																D
E																E
F																F
1		2		3		4		5		6		7		8		
1		2		3		4		5		6		7		8		
A	CONFIDENTIAL, ALL RIGHTS RESERVED DIN 34															A			
B																B			
C	Format ISO/DIN A3															C			
D																D			
E																E			
F																F			
1		2		3		4		5		6		7		8					
Approved by Contractor				01.10.2026.		Reconstruction and Modernisation of HPP Perucica - Phase II				 A Voith Company		Unit KA1 control cubicle circuit diagrams		DRAWING No.: PERU-01-19-170-31-001		REV No.:		= UACJA10GH100	
Approved by Designer		Grga Kolić		01.10.2026.														+ UACJA10	
Checked by		Antonio Aleksić		01.10.2026.								Summarized parts list		Designer No.:		SALES No.:		PAGE 155	
Drawn by		Tamara Trogrić		01.10.2026.		PROJECT NAME		EMPLOYER		DESIGNER								PAGE 155 / 156	

CONFIDENTIAL, ALL RIGHTS RESERVED DIN 34

Format ISO/DIN A3

155

1		2		3		4		5		6		7		8	
Device Tag (Location + Displayed DT)		Qty.	Description			Designation		Type number		Manufacturer		Part number			
=UACJA10GH100+UACJA10	U101;U102	2	SITOP PSU8200M 20A stabilized power supply input: 120-230 V AC 110-220 V DC output: 24 V DC/20 A			Power supply		SITOP PSU8200		SIE		SIE.6EP1336-3BA10			
=UACJA10GH100+UACJA10	U201	1	VOITH Frequency converter with electrical isolation for measuring the speed from the residual voltage of the generator in connection with a speed transducer.			Measuring instrument		VFU1		VOITH		VOITH.VFU1			
=UACJA10GH100+UACJA10	U300;U301	2	24 V DC 8x 10/100 Mbit/s twisted pair ports with RJ45 sockets LED diagnostics Type: Scalance XB008 Order No.: 6GK5008-0BA10-1AB2			Ethernet switch		6GK5008-0BA10-1AB2		SIE		SIE.6GK5008-0BA10-1AB2			
=UACJA10GH100+UACJA10	V1;V2	2	Circuit configuration: Two diodes doubler circuit, two diodes common cathode, two diodes common anode, single diode Vf - Forward Voltage: 1.35 V Vr - Reverse Voltage: 800 V			Diode		DD100KB80		SanRex		DD100KB80			
=UACJA10GH100+UACJA10	V101	1	Input/output: DC 24-48V/40A Suitable for decoupling two SITOP power supplies with max. 20 A output current each			Redundancy module		SITOP RED1200		SIE		SIE.6EP4347-7RB00-0AX0			
=UACJA10GH100+UACJA10	X0;X10	7	Feed-through terminal block, nom. voltage: 800 V, nominal current: 32 A, number of connections: 2, connection method: Push-in connection, Rated cross section: 4 mm2, cross section: 0.2 mm2 - 6 mm2, mounting type: NS 35/7,5, NS 35/15, color: gray			PT 4 Feed-through terminal block		3211757		PXC		PXC.3211757			
=UACJA10GH100+UACJA10	X0;X13...X16;X51;X61 X62;X71...X73;X110 X131...X147	400	Feed-through terminal block, nom. voltage: 800 V nominal current: 24 A number of connections: 2 number of positions: 1 connection method: Push-in connection Rated cross section: 2.5 mm2 cross section: 0.14 mm2 - 4 mm2 mounting type: NS 35/7,5, NS 35/15 color: gray			PT 2,5 Feed-through terminal block		3209510		PXC		PXC.3209510			
=UACJA10GH100+UACJA10	X0;X61	4	Ground terminal, number of connections: 2, connection method: Push-in connection, cross section: 0.14 mm2 - 4 mm2, mounting type: NS 35/7,5, NS 35/15, color: green-yellow			PT 2,5-PE Ground terminal		3209536		PXC		PXC.3209536			
=UACJA10GH100+UACJA10	X50	6	PTTB 2,5-2DIO/O-UR/UL-UR - Component terminal block			Component terminal block		3215041		PXC		PXC.3215041			
=UACJA10GH100+UACJA10	X101	1	Rated voltage: 250V, 50Hz Rated current: 16A			Socket-outlet		A9A15310		SE		SE.A9A15310			
=UACJA10GH100+UACJA10	XT1...XT4	34	Test disconnect terminal block, nom. voltage: 500 V, nominal current: 41 A, connection method: Screw connection, 1 level, Rated cross section: 6 mm2, cross section: 0.5 mm2 - 10 mm2 , mounting type: NS 35/7,5, NS 35/15, NS 32, color: gray			URTK 6 Test disconnect terminal block		3026272		PXC		PXC.3026272			
=UACJA10GH100+UACJA10	XT1...XT4	13	Slide-type terminal block, with slide, nom. voltage: 400 V, nominal current: 41 A, number of connections: 2, connection method: Screw connection, 1 level, Rated cross section: 6 mm2, cross section: 0.5 mm2 - 10 mm2, mounting type: NS 35/7,5, NS 35/15, NS 32, color: gray			UGSK 6 Test disconnect terminal block		3026285		PXC		PXC.3026285			

Approved by Contractor			Reconstruction and Modernisation of HPP Perucica - Phase II		 A Voith Company Sintaksa - A Voith Company Ulica Domovinskog rata 104C, 21 000 Split, Hrvatska	Unit KA1 control cubicle circuit diagrams		DRAWING No.: PERU-01-19-170-31-001		REV No.:		= UACJA10GH100			
Approved by Designer		Grga Kolić				01.10.2026.	Summarized parts list		Designer No.:		SALES No.:		+ UACJA10		
Checked by		Antonio Aleksić				01.10.2026.							PAGE		
Drawn by		Tamara Trogrlić				01.10.2026.	PROJECT NAME		EMPLOYER		DESIGNER		PAGE		
1		2		3		4		5		6		7		8	