

1

2

3

4

5

6

7

8

A

B

C

D

E

F

CONFIDENTIAL, ALL RIGHTS RESERVED DIN 34

Format ISO/DIN A3

Purpose of Document

Informationfor ApprovalX

Type of Document

Detail Design

Place for digital signature of Contractor

Place for digital signature of Revisor

00	As Built	Tamara Trogrlić	Antonio Aleksić	Grga Kolić		01.10.2026.
Rev.	Revision Description	Drawn by	Checked by	Approved by Designer	Approved by Contractor	Date

Document No. (CSD)PER-E-8-KA1&KA2-SCH-002-00-VHHR

Employer:

epcg
Elektroprivreda Crne Gore AD

Consultant:

ENERGOPROJEKT
HIDROINŽENJERING a.d.

Contractor:

VOITH
VOITH HYDRO GmbH&CoKG
St. Pölten

Project:

Reconstruction and Modernisation of HPP Perucica - Phase II

Title:

Unit KA2 control cubicle circuit diagrams

Approved by Contractor			Reconstruction and Modernisation of HPP Perucica - Phase II		 Sintaksa - A Voith Company Ulica Domovinskog rata 104C, 21 000 Split, Hrvatska	Unit KA2 control cubicle circuit diagrams	DRAWING No.: PERU-01-19-170-31-002	REV No.: 00	= UBCJA10GH100 + UBCJA10	
Approved by Designer	Grga Kolić	01.10.2026.				TITLE PAGE	Designer No.:	SALES No.:	PAGE	1
Checked by	Antonio Aleksić	01.10.2026.							PAGE	1 / 157
Drawn by	Tamara Trogrlić	01.10.2026.							PROJECT NAME	EMPLOYER

1

2

3

4

5

6

7

8

A

A

B

B

C

C

D

D

E

E

F

 
F

Page	Page type	Page description	Rev.
2	Table of contents	TABLE OF CONTENTS	
3	Table of contents	TABLE OF CONTENTS	
4	Schematic multi-line	DESIGNATION CODES	
5	Schematic multi-line	AC DISTRIBUTION	
6	Schematic multi-line	DC DISTRIBUTION 220VDC	
7	Schematic multi-line	DC DISTRIBUTION 220VDC	
8	Schematic multi-line	DC DISTRIBUTION 24VDC	
9	Schematic multi-line	DC DISTRIBUTION 24VDC	
10	Schematic multi-line	DC DISTRIBUTION 24VDC	
11	Schematic multi-line	DC DISTRIBUTION 24VDC	
12	Schematic multi-line	PLC CONFIGURATION	
13	Schematic multi-line	PLC CONFIGURATION	
14	Schematic multi-line	PLC CONFIGURATION	
15	Schematic multi-line	PLC DIGITAL INPUTS: INTERNAL SIGNALS	
16	Schematic multi-line	DIGITAL INPUTS: 0.0 - 0.7	
17	Schematic multi-line	DIGITAL INPUTS: 1.0 - 1.7	
18	Schematic multi-line	DIGITAL INPUTS: 2.0 - 2.7	
19	Schematic multi-line	DIGITAL INPUTS: 3.0 - 3.7	
20	Schematic multi-line	DIGITAL INPUTS: 4.0 - 4.7	
21	Schematic multi-line	DIGITAL INPUTS: 5.0 - 5.7	
22	Schematic multi-line	DIGITAL INPUTS: 6.0 - 6.7	
23	Schematic multi-line	DIGITAL INPUTS: 7.0 - 7.7	
24	Schematic multi-line	DIGITAL INPUTS: 8.0 - 8.7	
25	Schematic multi-line	DIGITAL INPUTS: 9.0 - 9.7	
26	Schematic multi-line	DIGITAL INPUTS: 10.0 - 10.7	
27	Schematic multi-line	DIGITAL INPUTS: 11.0 - 11.7	
28	Schematic multi-line	DIGITAL INPUTS: 12.0 - 12.7	
29	Schematic multi-line	DIGITAL INPUTS: 13.0 - 13.7	
30	Schematic multi-line	DIGITAL INPUTS: 14.0 - 14.7	
31	Schematic multi-line	DIGITAL INPUTS: 15.0 - 15.7	
32	Schematic multi-line	DIGITAL INPUTS: 16.0 - 16.7	
33	Schematic multi-line	DIGITAL INPUTS: 17.0 - 17.7	
34	Schematic multi-line	DIGITAL INPUTS: 18.0 - 18.7	
35	Schematic multi-line	DIGITAL INPUTS: 19.0 - 19.7	
36	Schematic multi-line	DIGITAL OUTPUTS: 0.0 - 0.7	
37	Schematic multi-line	DIGITAL OUTPUTS: 1.0 - 1.7	
38	Schematic multi-line	DIGITAL OUTPUTS: 2.0 - 2.7	
39	Schematic multi-line	DIGITAL OUTPUTS: 3.0 - 3.7	
40	Schematic multi-line	DIGITAL OUTPUTS: 4.0 - 4.7	
41	Schematic multi-line	DIGITAL OUTPUTS: 5.0 - 5.7	

Page	Page type	Page description	Rev.
42	Schematic multi-line	DIGITAL OUTPUTS: 6.0 - 6.7	
43	Schematic multi-line	DIGITAL OUTPUTS: 7.0 - 7.7	
44	Schematic multi-line	ANALOG INPUTS: 1 - 4	
45	Schematic multi-line	ANALOG INPUTS: 5 - 8	
46	Schematic multi-line	ANALOG OUTPUTS: 1 - 2	
47	Schematic multi-line	ANALOG OUTPUTS: 3 - 4	
48	Schematic multi-line	SPEED MEASUREMENT	
49	Schematic multi-line	HPU CONTROL	
50	Schematic multi-line	HPU CONTROL	
51	Schematic multi-line	ESD VALVE CONTROL	
52	Schematic multi-line	MIV CONTROL 24VDC	
53	Schematic multi-line	LOCAL CONTROL	
54	Schematic multi-line	CB CONTROL	
55	Schematic multi-line	EXCITATION CB TRIP COMMAND	
56	Schematic multi-line	EMERGENCY SHUTDOWN	
57	Schematic multi-line	EMERGENCY SHUTDOWN	
58	Schematic multi-line	GENERATOR PROTECTION ESD	
59	Schematic multi-line	SYNCHRONIZATION CONTROL	
60	Schematic multi-line	SYNCHRONIZATION CONTROL	
61	Schematic multi-line	SYNCHRONIZATION	
62	Schematic multi-line	SYNCHRONIZATION	
63	Schematic multi-line	SYNCHRONIZATION	
64	Schematic multi-line	SYNCHRONIZATION	
65	Schematic multi-line	SIGNALIZATION - EXCITATION	
66	Schematic multi-line	SIGNALIZATION - PROTECTION	
67	Schematic multi-line	SIGNALIZATION	
68	Schematic multi-line	SIGNAL COLUMN	
69	Schematic multi-line	ALARM ANNUCIATOR - ALARM	
70	Schematic multi-line	ALARM ANNUCIATOR - TRIP	
71	Schematic multi-line	ALARM ANNUCIATOR - TRIP	
72	Schematic multi-line	SPARE CONTACTS	
73	Schematic multi-line	CT CIRCUITS	
74	Schematic multi-line	VT CIRCUITS	
75	Schematic multi-line	VT CIRCUITS	
76	Schematic multi-line	VT CIRCUITS	
77	Schematic multi-line	VT CIRCUITS	
78	Schematic multi-line	SWITCH	
79	Schematic multi-line	COMMUNICATION	
80	Overview	HMI - TOUCH PANEL	
81	Overview	PLC OVERVIEW	

CONFIDENTIAL, ALL RIGHTS RESERVED DIN 34

Format ISO/DIN A3

Approved by Contractor			Reconstruction and Modernisation of HPP Perucica - Phase II		 SINTAKSA A Voith Company Sintaksa - A Voith Company Ulica Domovinskog rata 104C, 21 000 Split, Hrvatska	Unit KA2 control cubicle circuit diagrams	DRAWING No.:	REV No.:	= UBCJA10GH100
Approved by Designer	Grga Kolić	01.10.2026.					PERU-01-19-170-31-002	02	+ UBCJA10
Checked by	Antonio Aleksić	01.10.2026.					Designer No.:	SALES No.:	PAGE 2
Drawn by	Tamara Trogrlić	01.10.2026.	PROJECT NAME	EMPLOYER	DESIGNER				PAGE 2 / 157

1		2		3		4		5		6		7		8			
A	CONFIDENTIAL, ALL RIGHTS RESERVED DIN 34																A
	Format ISO/DIN A3																
B																	B
C																	C
D																	D
E																	E
F																	F
1		2		3		4		5		6		7		8			
1		2		3		4		5		6		7		8			
1		2		3		4		5									

A																		A																								
	SYSTEM/EQUIPMENT				DEVICE				DOCUMENT				CIRCUIT DIAGRAM INDEX				WIRE AND CABLE COLOURS																									
	=UBAMKC10GH100+UBMKC11 =UBCHA10GH100+UBCHA10 =0UA01+UV01				EXCITATION PROTECTION VIBRATION MONITORING				A - Assemblies, subassemblies B - Transducers from non-electric to electric quantities or vice versa C - Capacitors D - Binary elements E - Miscellaneous F - Protective devices G - Generators, power supplies H - Signaling devices J - K - Relays, contactors L - Inductors, reactors M - Motors N - Amplifiers, controllers P - Measuring instruments, test equipment Q - Switching devices for power circuits R - Resistors S - Switches for control circuits, selectors T - Transformers U - Modulators V - Tubes, semiconductors W - Transmission paths, cables, busbars, antennas X - Terminals, plugs, sockets Y - Electrically operated mechanical devices Z - Terminations, hybrid transformers, filters, equilizers, limiters 100..199 - Station services 200..299 - Control 300..399 - Protection 400..499 - Measuring 500..599 - Freely disposable				001...099 - Text documents, chapters 100...999 - Drawings: Block-diagrams, Single line diagrams, General arrangement drawings, Circuit diagrams, Cubicle layouts, Cubicle assigned drawings, Cable lists, cable core lists, Grounding and lightning, Unassigned drawings,				A - Indexes, title sheet, document list B - Function diagrams C - Designation code D - AC power supply (heating, lighting voltage distribution, fuses...) E - F - G - DC power supply (voltage distribution...) H - Signaling devices J - K - L - Operating mechanisms for switching devices (circuit breakers, disconnectors...) M - Control (local, remote, station...) N - Protection P - Interlocking Q - Position indication (local, remote, station...) R - Alarm (signaling, monitoring...) S - Instruments transformers circuits (measuring, protection...) T - Measuring (local, remote station... unless under "S") U - Feedback control (voltage regulator...) V - Communication W - Wiring diagrams, terminal matrix X - Cable list, cable core list Y - Z - Equipment documents for "C" to "W"				BK - Black BN - Brown RD - Red OG - Orange YE - Yellow GN - Green BU - Blue VT - Violet GY - Grey WH - White PK - Pink TO - Turquoise GNYE - Green yellow LB - Light Blue																					
B																																										B
																									C																	
D																		D																								
	E																		E																							
		F																		F																						


3

5


Approved by Contractor			Reconstruction and Modernisation of HPP Perucica - Phase II		 A Voith Company	Unit KA2 control cubicle circuit diagrams	DRAWING No.:	REV No.:	= UBCJA10GH100
Approved by Designer	Grga Kolić	01.10.2026.					PERU-01-19-170-31-002	02	+ UBCJA10
Checked by	Antonio Aleksić	01.10.2026.					Designer No.:	SALES No.:	PAGE 4
Drawn by	Tamara Trogrlić	01.10.2026.					PROJECT NAME	EMPLOYER	DESIGNER

1	2	3	4	5	6	7	8
---	---	---	---	---	---	---	---

CONFIDENTIAL, ALL RIGHTS RESERVED DIN 34
Format ISO/DIN A3

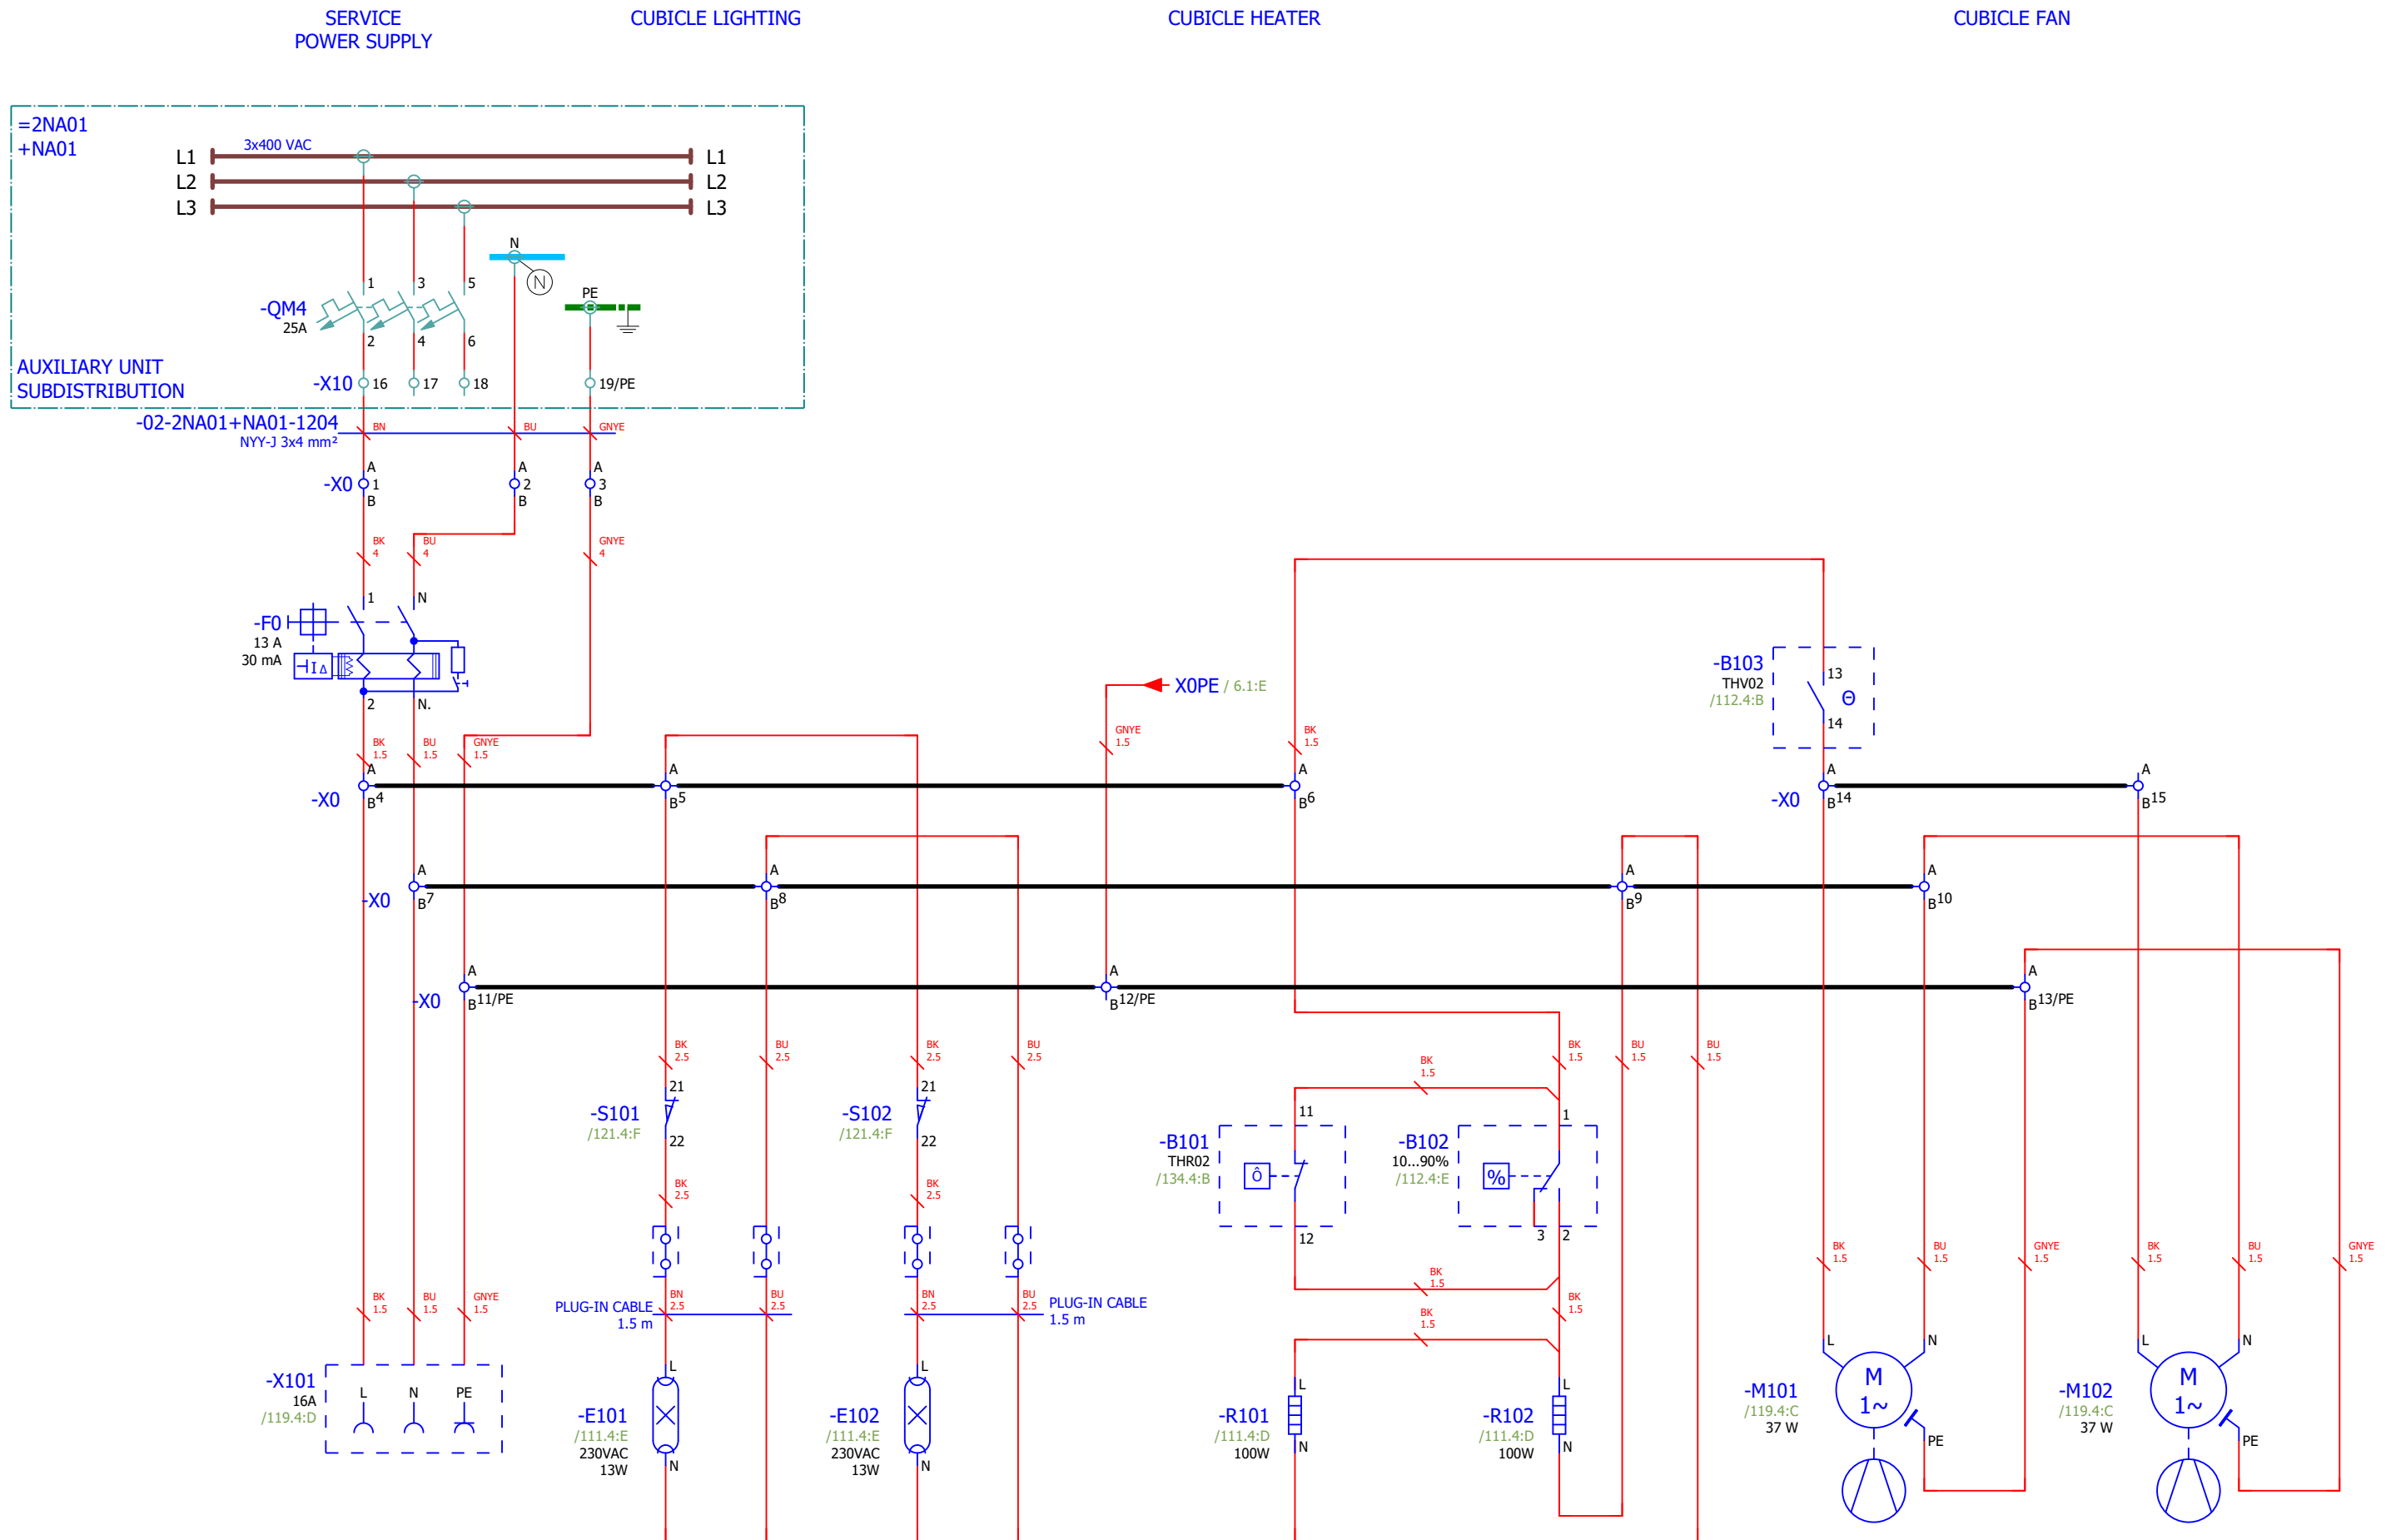


Approved by Contractor			Reconstruction and Modernisation of HPP Perucica - Phase II		 A Voith Company	Unit KA2 control cubicle circuit diagrams	DRAWING No.: PERU-01-19-170-31-002	REV No.: 02	= UBCJA10GH100
Approved by Designer	Grga Kolić	01.10.2026.	of HPP Perucica - Phase II		Sintaksa - A Voith Company Ulica Domovinskog rata 104C, 21 000 Split, Hrvatska	AC DISTRIBUTION	Designer No.:	SALES No.:	+ UBCJA10
Checked by	Antonio Aleksić	01.10.2026.	PROJECT NAME	EMPLOYER	DESIGNER				PAGE 5
Drawn by	Tamara Trogrlić	01.10.2026.							PAGE 5 / 157

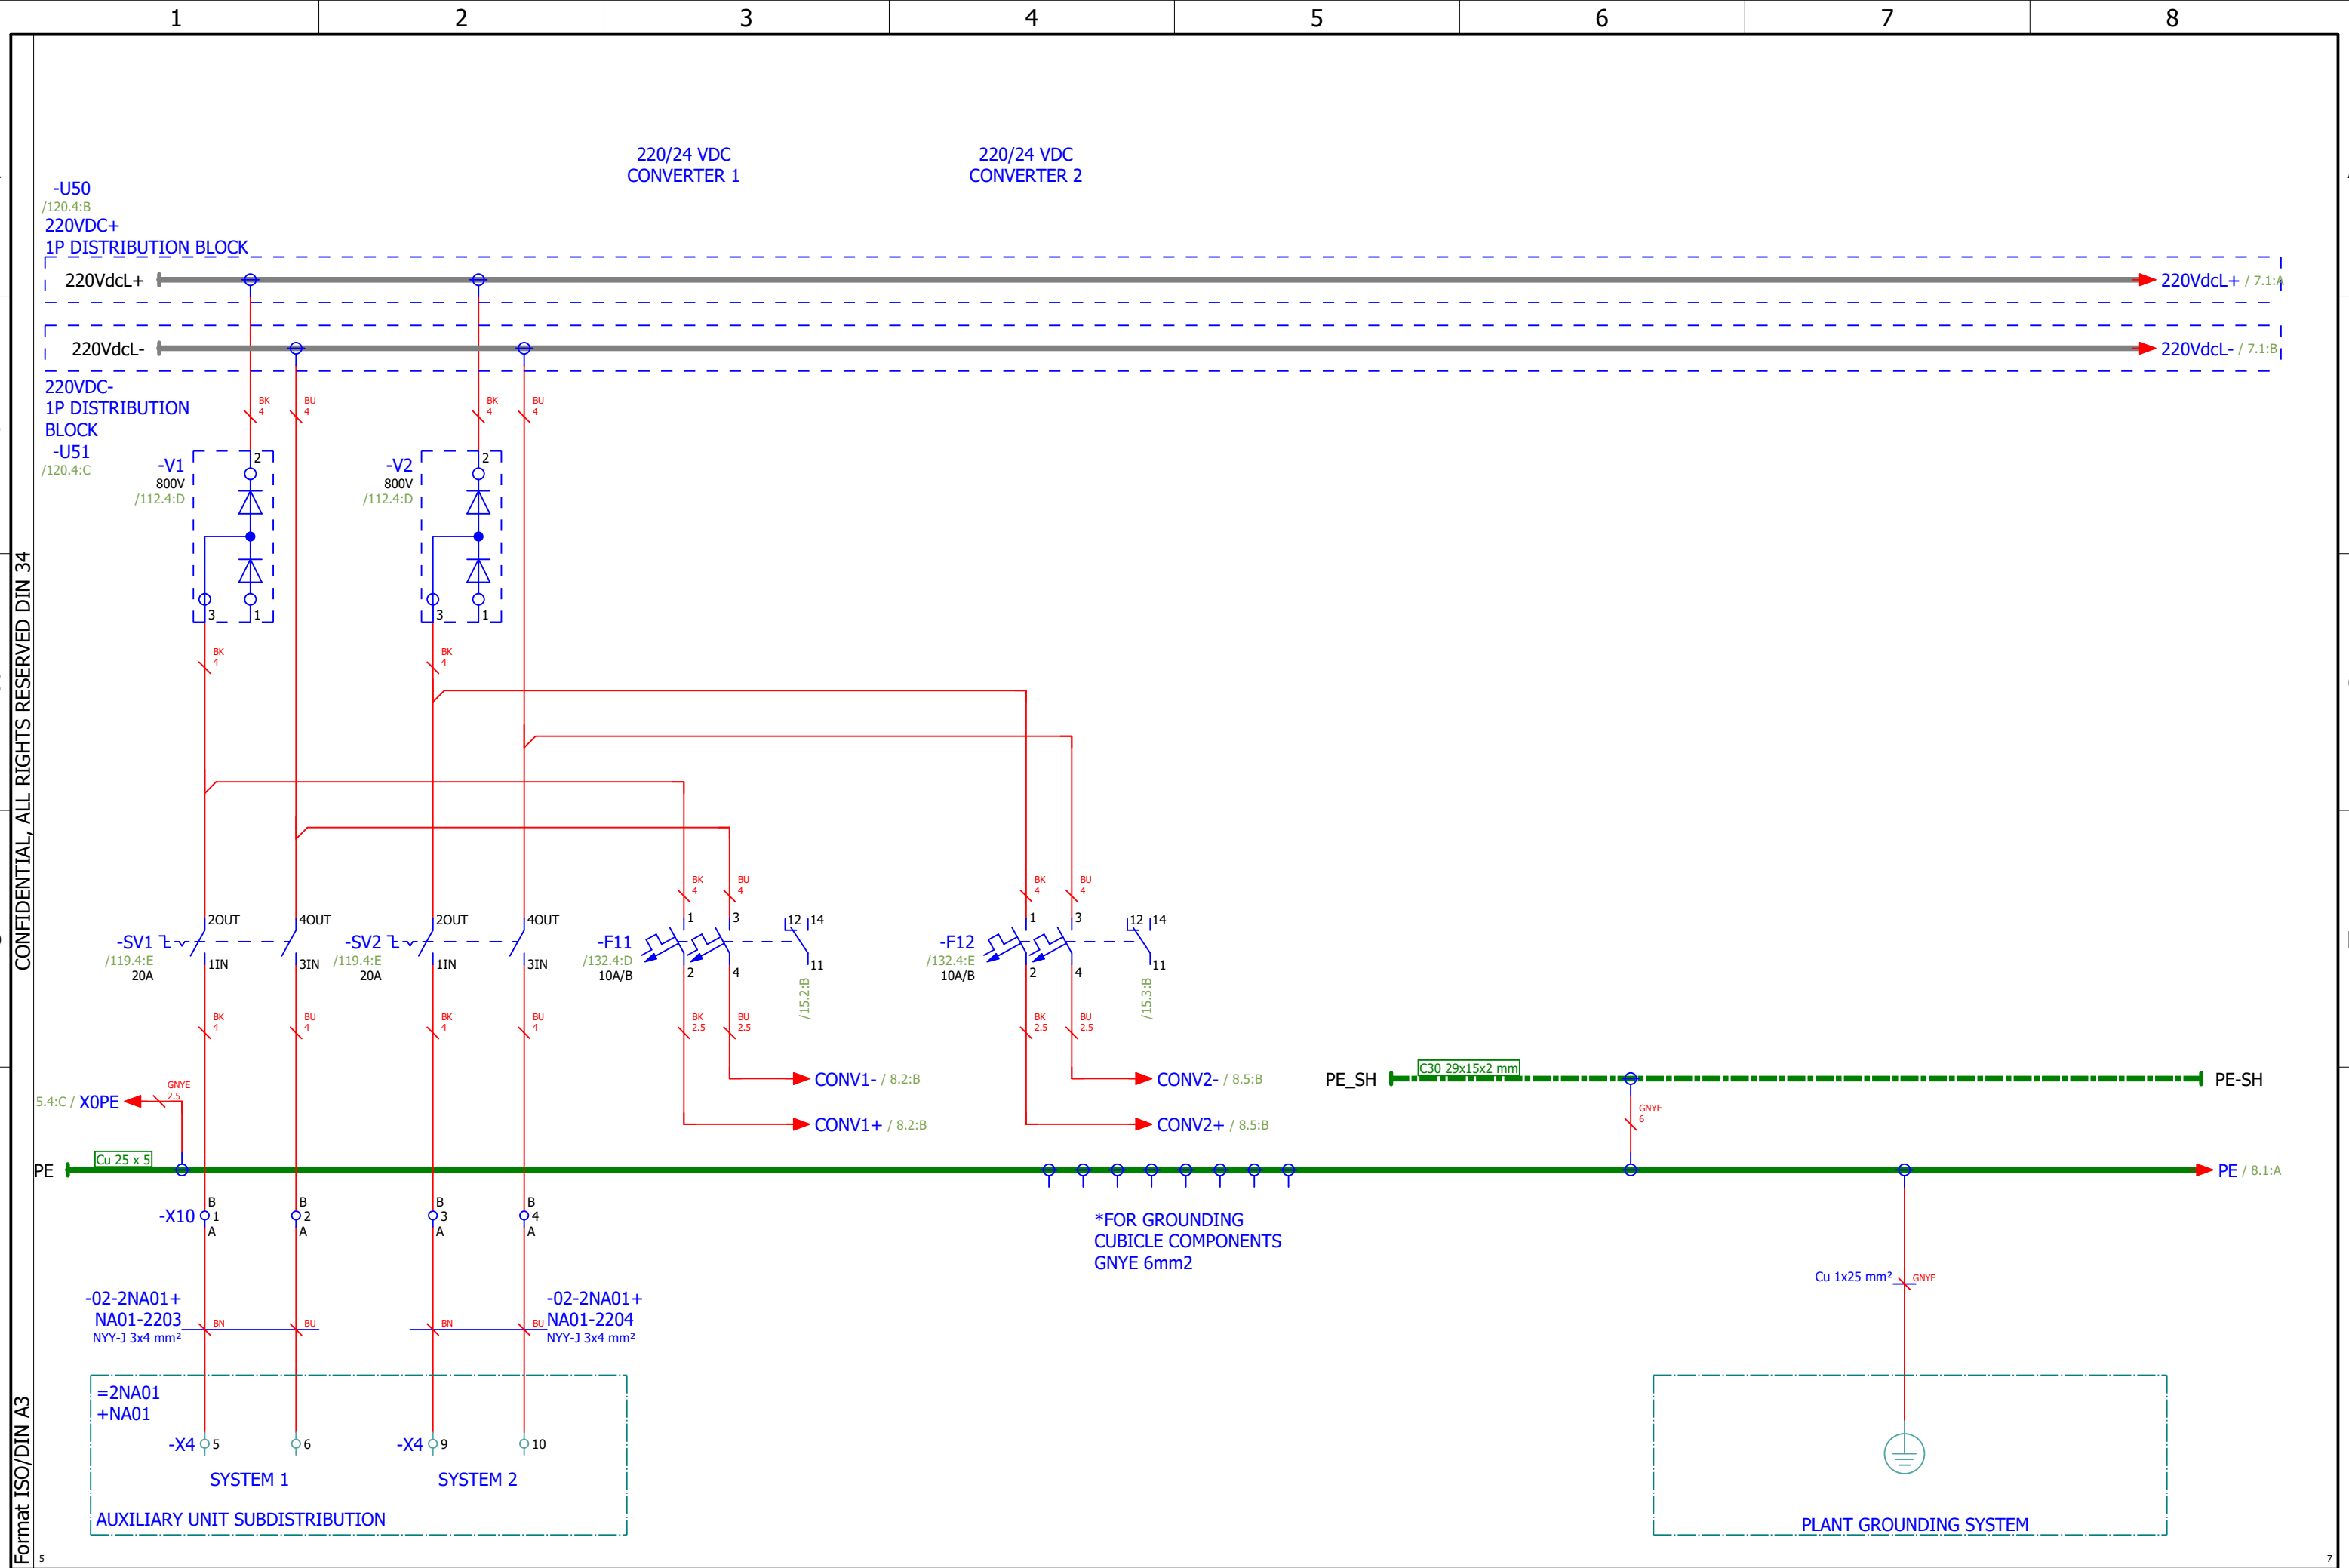

Approved by Contractor			Reconstruction and Modernisation of HPP Perucica - Phase II		 A Voith Company	Unit KA2 control cubicle circuit diagrams	DRAWING No.: PERU-01-19-170-31-002	REV No.: 02	= UBCJA10GH100
Approved by Designer	Grga Kolić	01.10.2026.			Sintaksa - A Voith Company Ulica Domovinskog rata 104C, 21 000 Split, Hrvatska	DC DISTRIBUTION 220VDC	Designer No.:	SALES No.:	+ UBCJA10
Checked by	Antonio Aleksić	01.10.2026.							PAGE 6
Drawn by	Tamara Trogrić	01.10.2026.	PROJECT NAME	EMPLOYER	DESIGNER				PAGE 6 / 157

CONFIDENTIAL, ALL RIGHTS RESERVED DIN 34

Format ISO/DIN A3

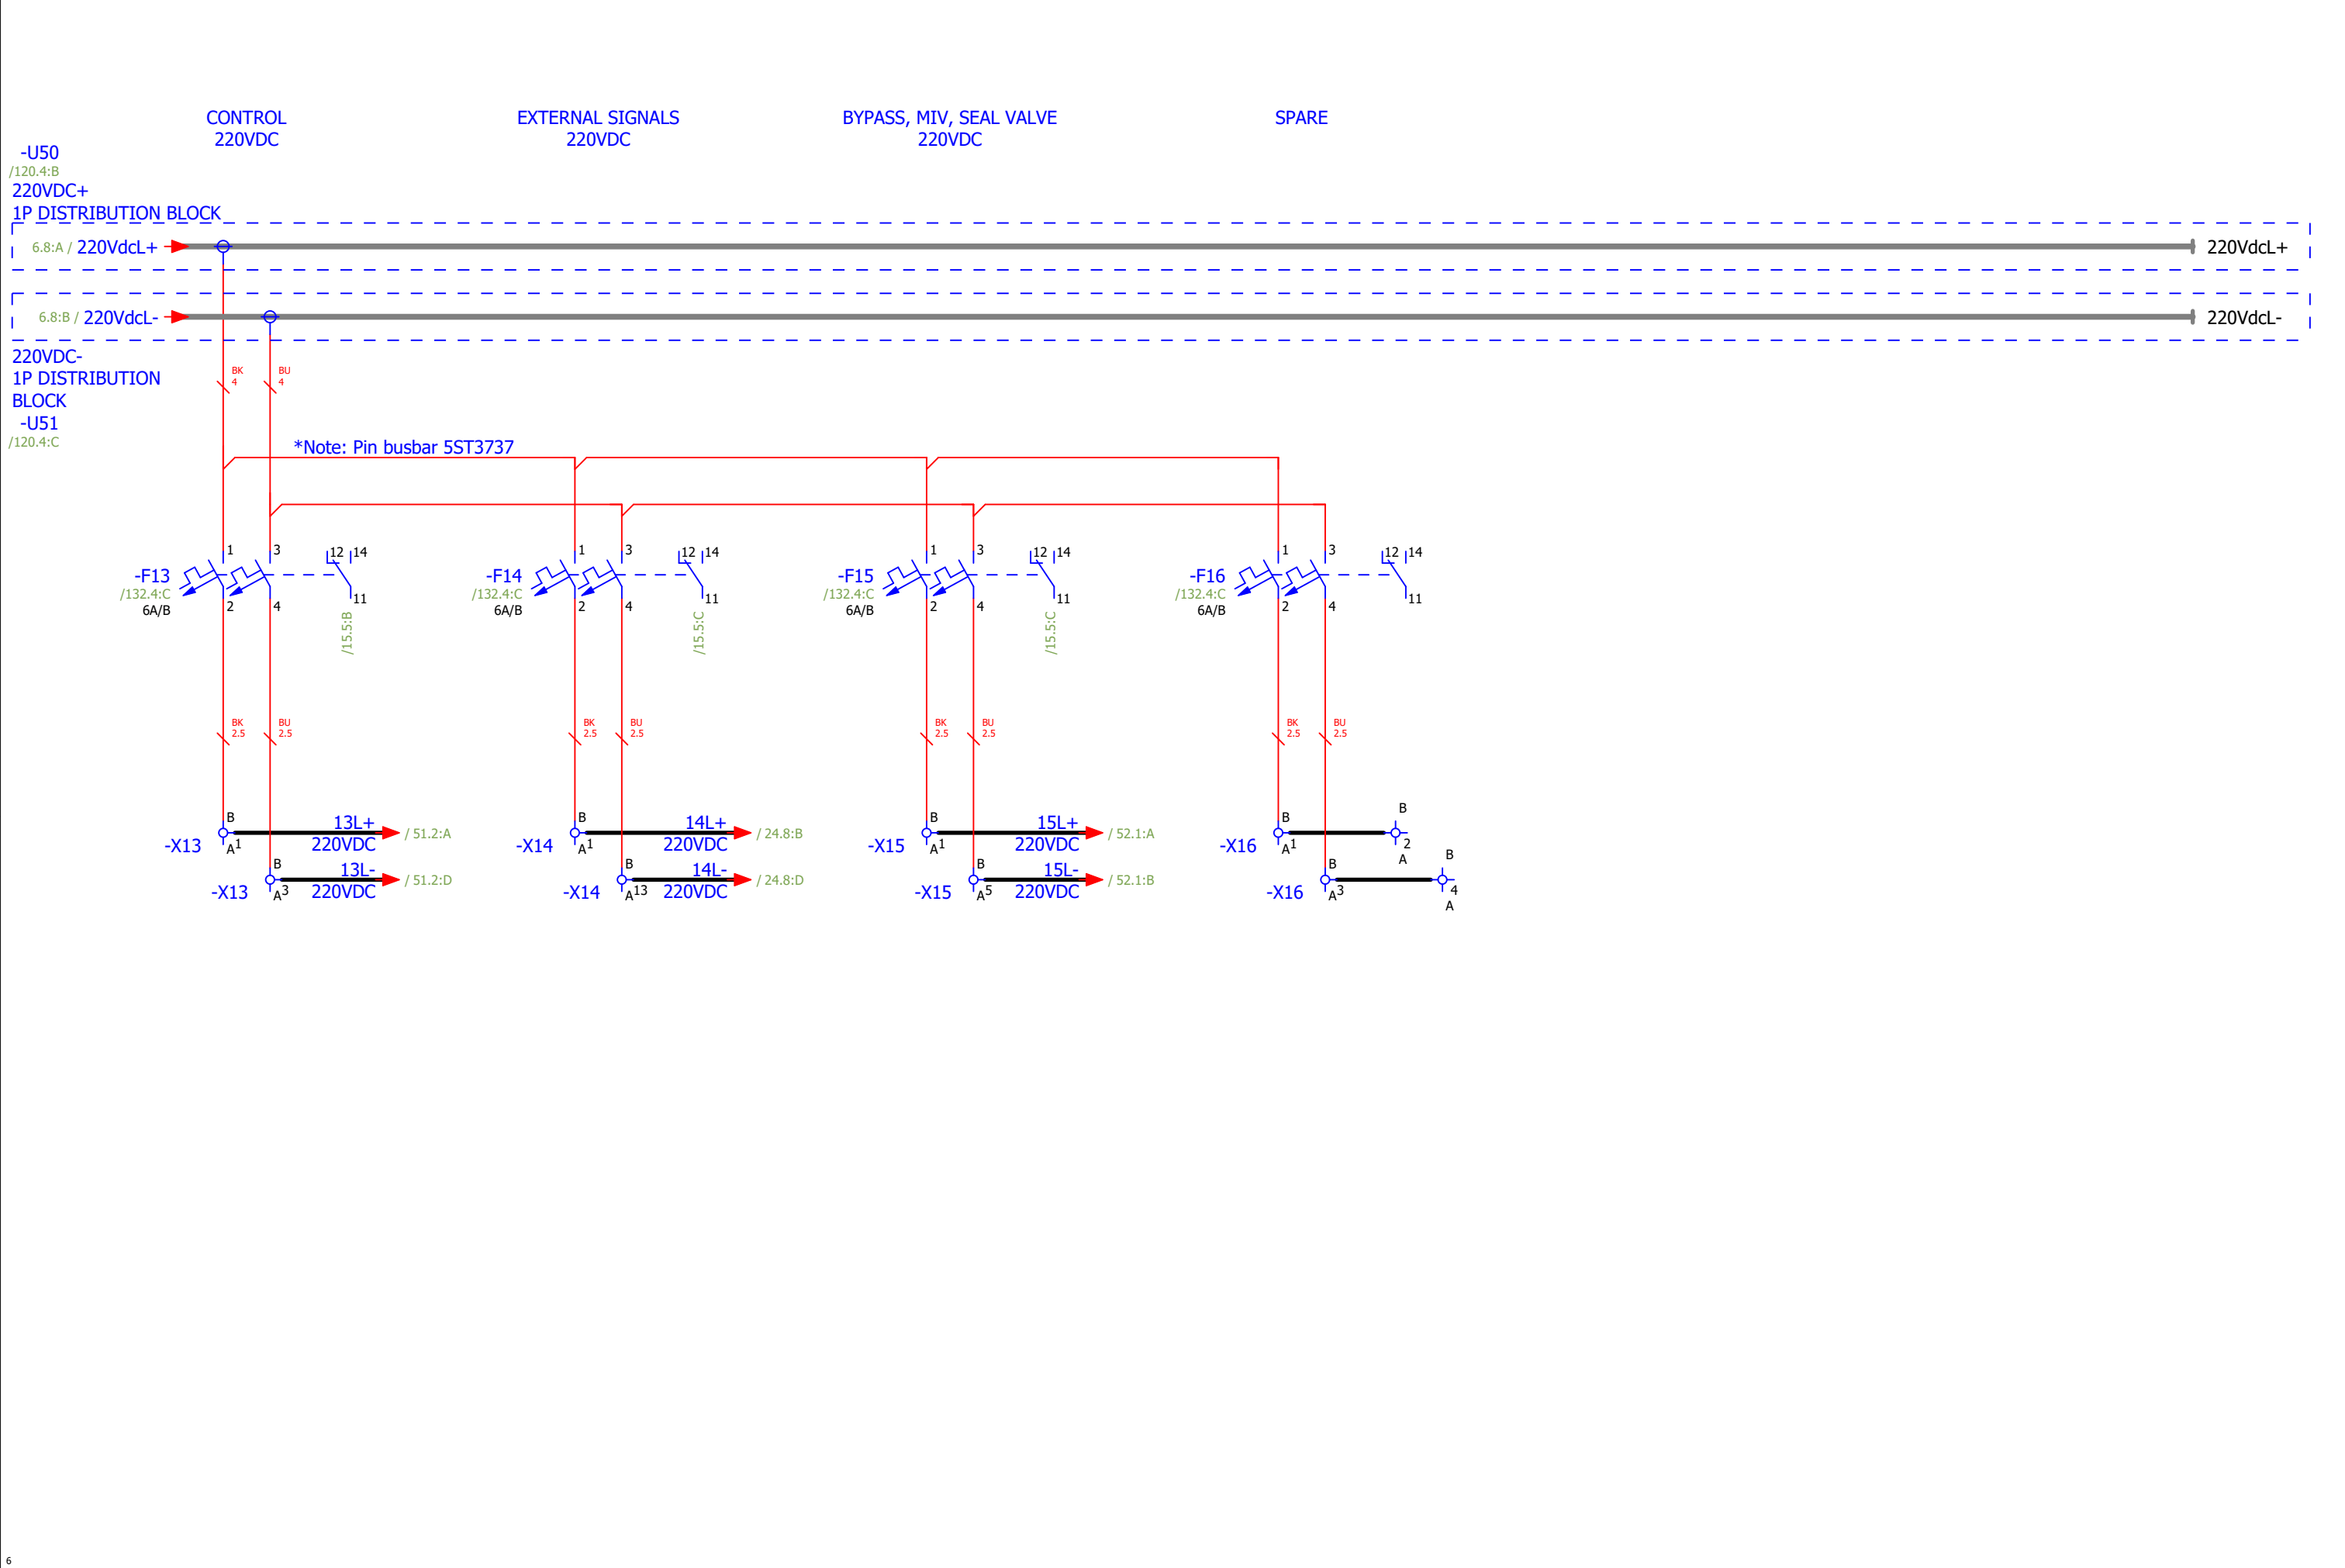

Approved by Contractor			Reconstruction and Modernisation of HPP Perucica - Phase II		 A Voith Company Sintaksa - A Voith Company Ulica Domovinskog rata 104C, 21 000 Split, Hrvatska	Unit KA2 control cubicle circuit diagrams DC DISTRIBUTION 220VDC	DRAWING No.:	REV No.:	= UBCJA10GH100
Approved by Designer	Grga Kolić	01.10.2026.					PERU-01-19-170-31-002	02	+ UBCJA10
Checked by	Antonio Aleksić	01.10.2026.					Designer No.:	SALES No.:	PAGE 7
Drawn by	Tamara Trogrlić	01.10.2026.							PAGE 7 / 157

Format ISO/DIN A3

CONFIDENTIAL, ALL RIGHTS RESERVED DIN 34

Format ISO/DIN A3

8

Approved by Contractor			Reconstruction and Modernisation of HPP Perucica - Phase II		 A Voith Company Sintaksa - A Voith Company Ulica Domovinskog rata 104C, 21 000 Split, Hrvatska	Unit KA2 control cubicle circuit diagrams DC DISTRIBUTION 24VDC	DRAWING No.: PERU-01-19-170-31-002	REV No.: 02	= UBCJA10GH100 + UBCJA10
Approved by Designer	Grga Kolić	01.10.2026.					Designer No.:	SALES No.:	PAGE 9
Checked by	Antonio Aleksić	01.10.2026.							
Drawn by	Tamara Trogrlić	01.10.2026.							PAGE 9 / 157

12345678

A

B

C

D

E

F

A

B

C

D

E

F

10

PLC, COMM, MULTIMETER

OPERATING PANEL

DIGITAL INPUTS,
SPEED MEASUREMENT

DIGITAL OUTPUTS

ANALOG I/O

-U52
/120.4:C
24VDC+
1P DISTRIBUTION BLOCK

8.8:F / 24VdcL1+ 24VdcL1+ / 10.1:A

*Note: Pin busbar 5ST3733

-F131
/130.4:F
6 A/B

-F132
/131.4:B
6 A/B

-F133
/131.4:B
6 A/B

-F134
/131.4:B
6 A/B

-F135
/130.4:E
2 A/B

8.8:F / 24VdcL- 24VdcL- / 10.1:C

-X131 131L+ 24VDC / 12.1:E
-X131 131L- 24VDC / 12.1:F

-X132 -X132 -X132

-X133 133L+ 24VDC / 13.2:E
-X133 133L- 24VDC / 13.2:E

-X134 134L+ 24VDC / 14.1:E
-X134 134L- 24VDC / 14.1:E

-X135 135L+ 24VDC / 14.3:E
-X135 135L- 24VDC / 14.3:F


-U300
SCALANCE
XB008
/107.1:B

-U301
SCALANCE
XB008
/108.1:B

-P101
SENTRON
/106.1:B

-A350
HMI
MPT1500

-B111
DD2503
/113.4:B

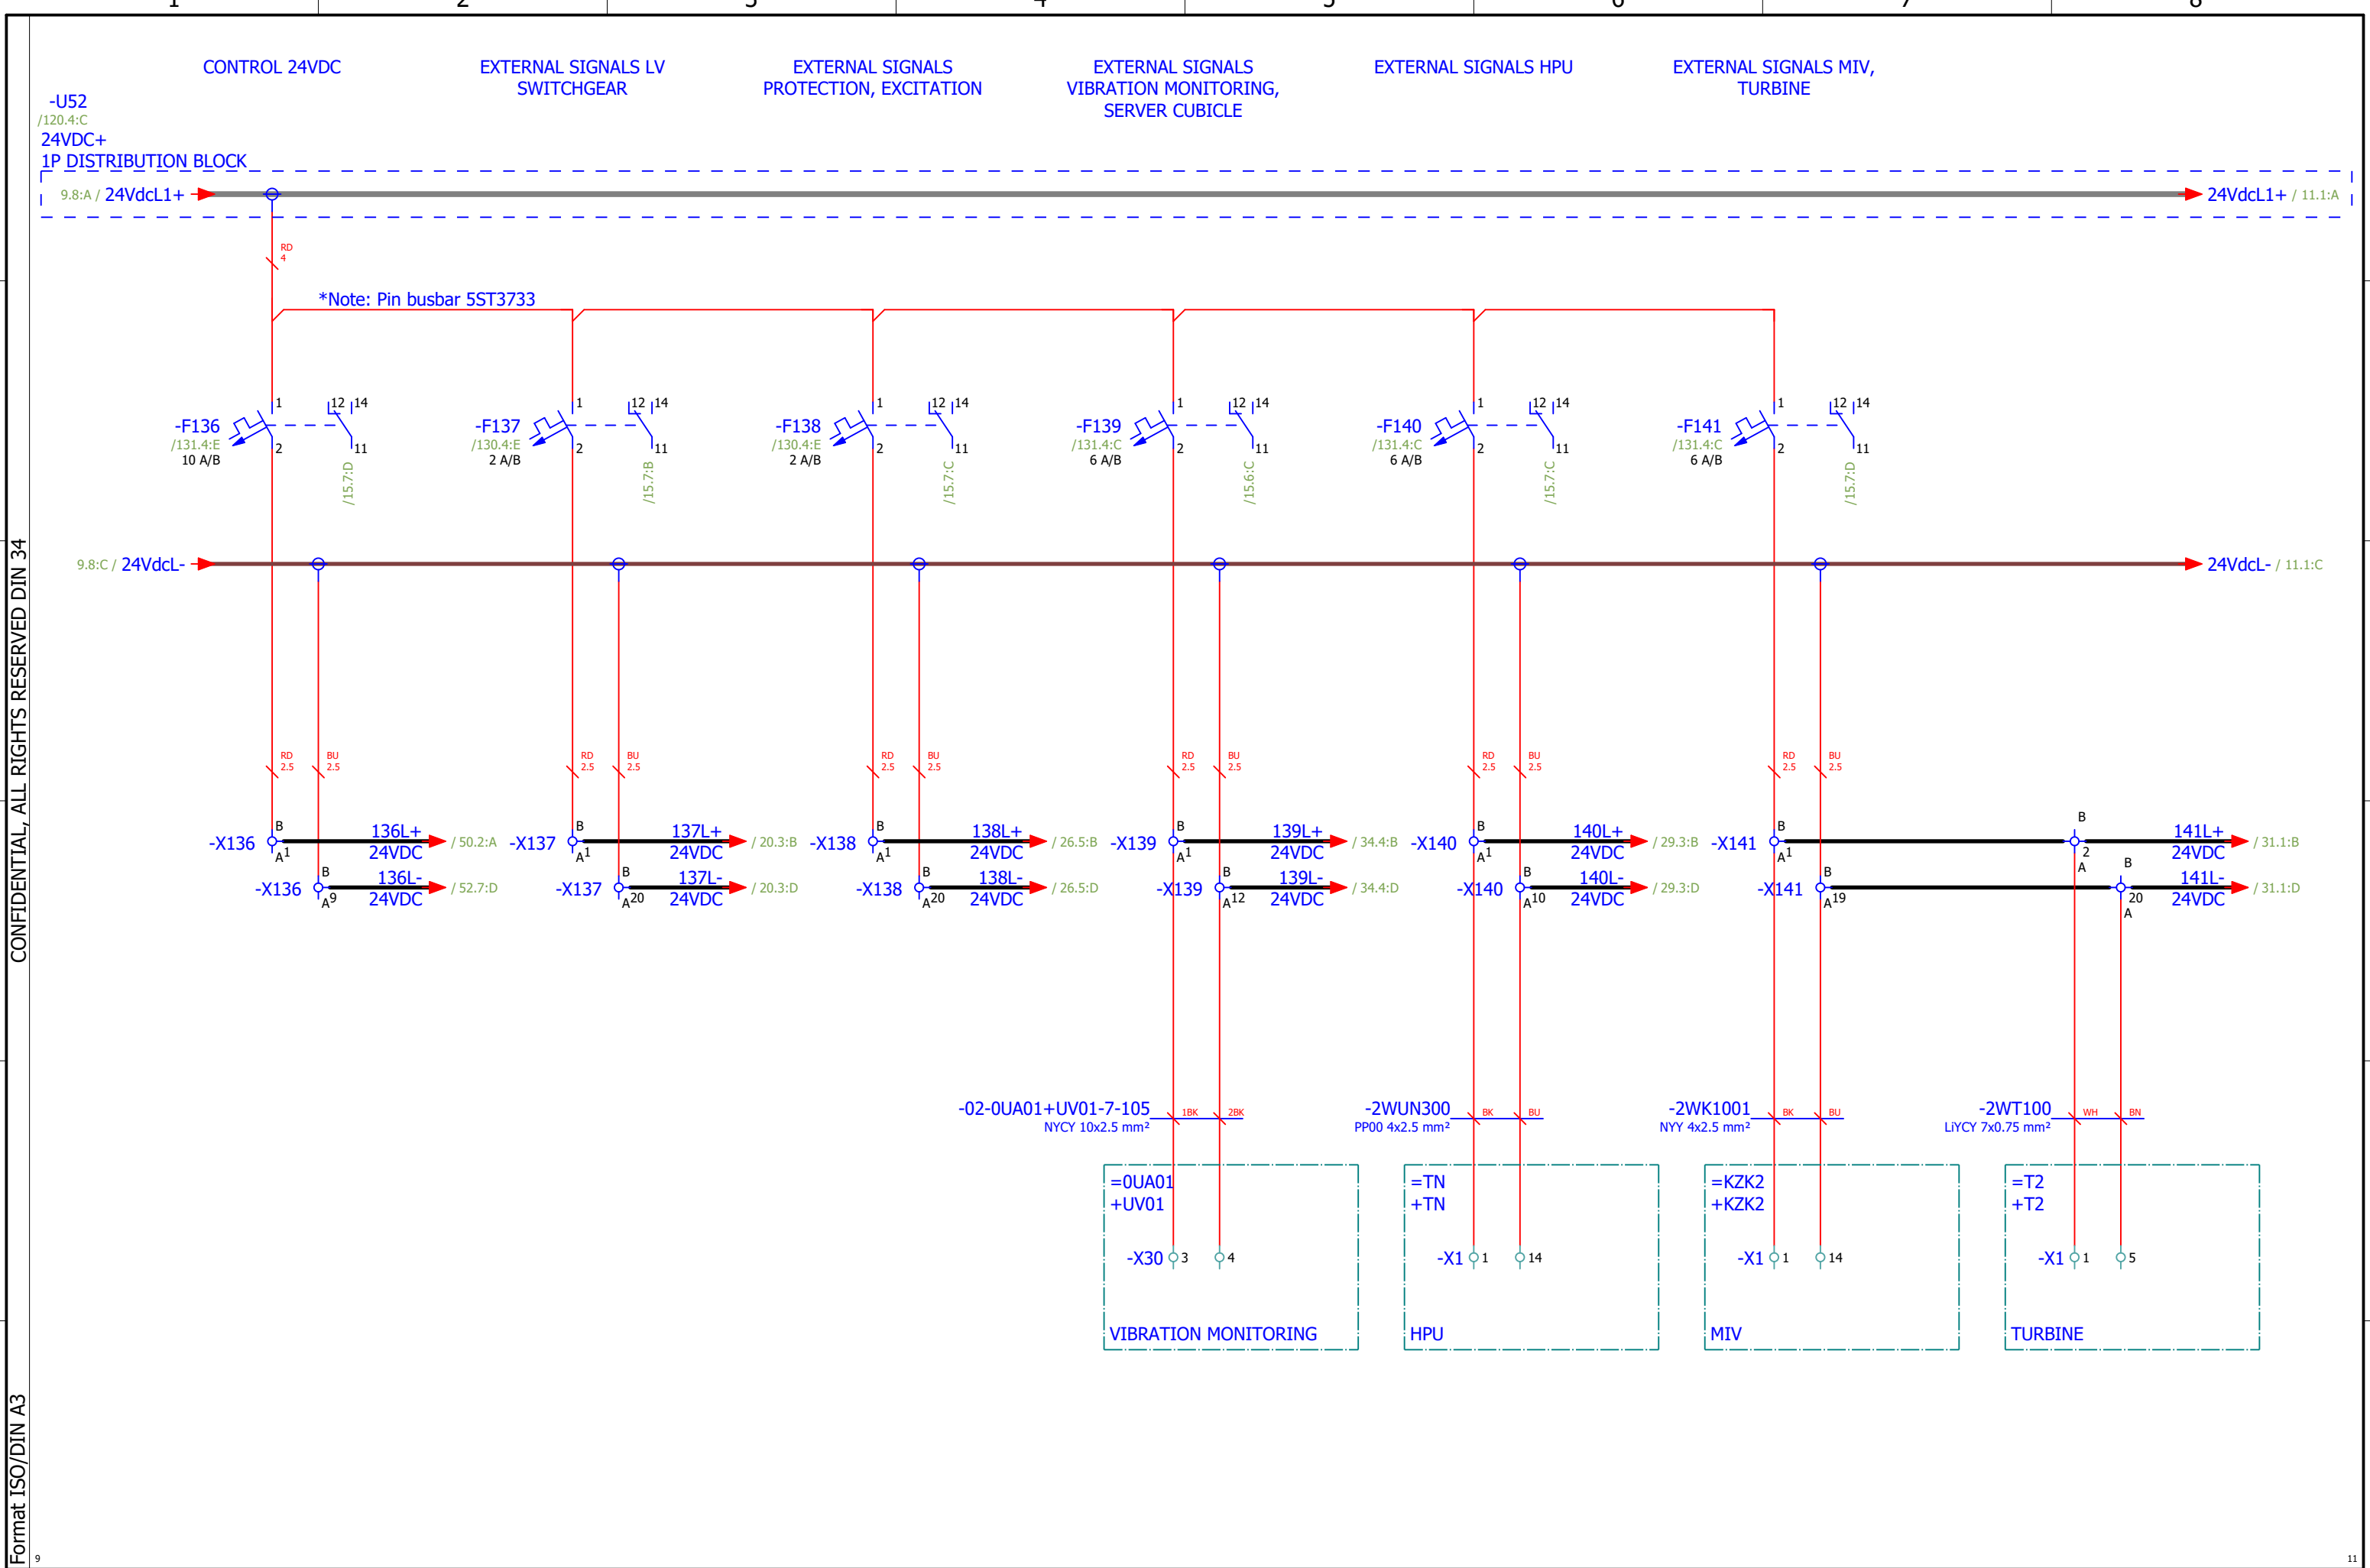

Approved by Contractor			Reconstruction and Modernisation of HPP Perucica - Phase II		 A Voith Company Sintaksa - A Voith Company Ulica Domovinskog rata 104C, 21 000 Split, Hrvatska	Unit KA2 control cubicle circuit diagrams DC DISTRIBUTION 24VDC	DRAWING No.:	REV No.:	= UBCJA10GH100
Approved by Designer	Grga Kolić	01.10.2026.					PERU-01-19-170-31-002	02	+ UBCJA10
Checked by	Antonio Aleksić	01.10.2026.					Designer No.:	SALES No.:	PAGE 10
Drawn by	Tamara Trogrlić	01.10.2026.							PAGE 10 / 157




CONFIDENTIAL, ALL RIGHTS RESERVED DIN 34

Format ISO/DIN A3


11

13

Approved by Contractor			Reconstruction and Modernisation of HPP Perucica - Phase II		 A Voith Company Sintaksa - A Voith Company Ulica Domovinskog rata 104C, 21 000 Split, Hrvatska	Unit KA2 control cubicle circuit diagrams PLC CONFIGURATION	DRAWING No.: PERU-01-19-170-31-002	REV No.: 02	= UBCJA10GH100 + UBCJA10
Approved by Designer	Grga Kolić	01.10.2026.					Designer No.:	SALES No.:	PAGE 12
Checked by	Antonio Aleksić	01.10.2026.							
Drawn by	Tamara Trogrlić	01.10.2026.							PAGE 12 / 157

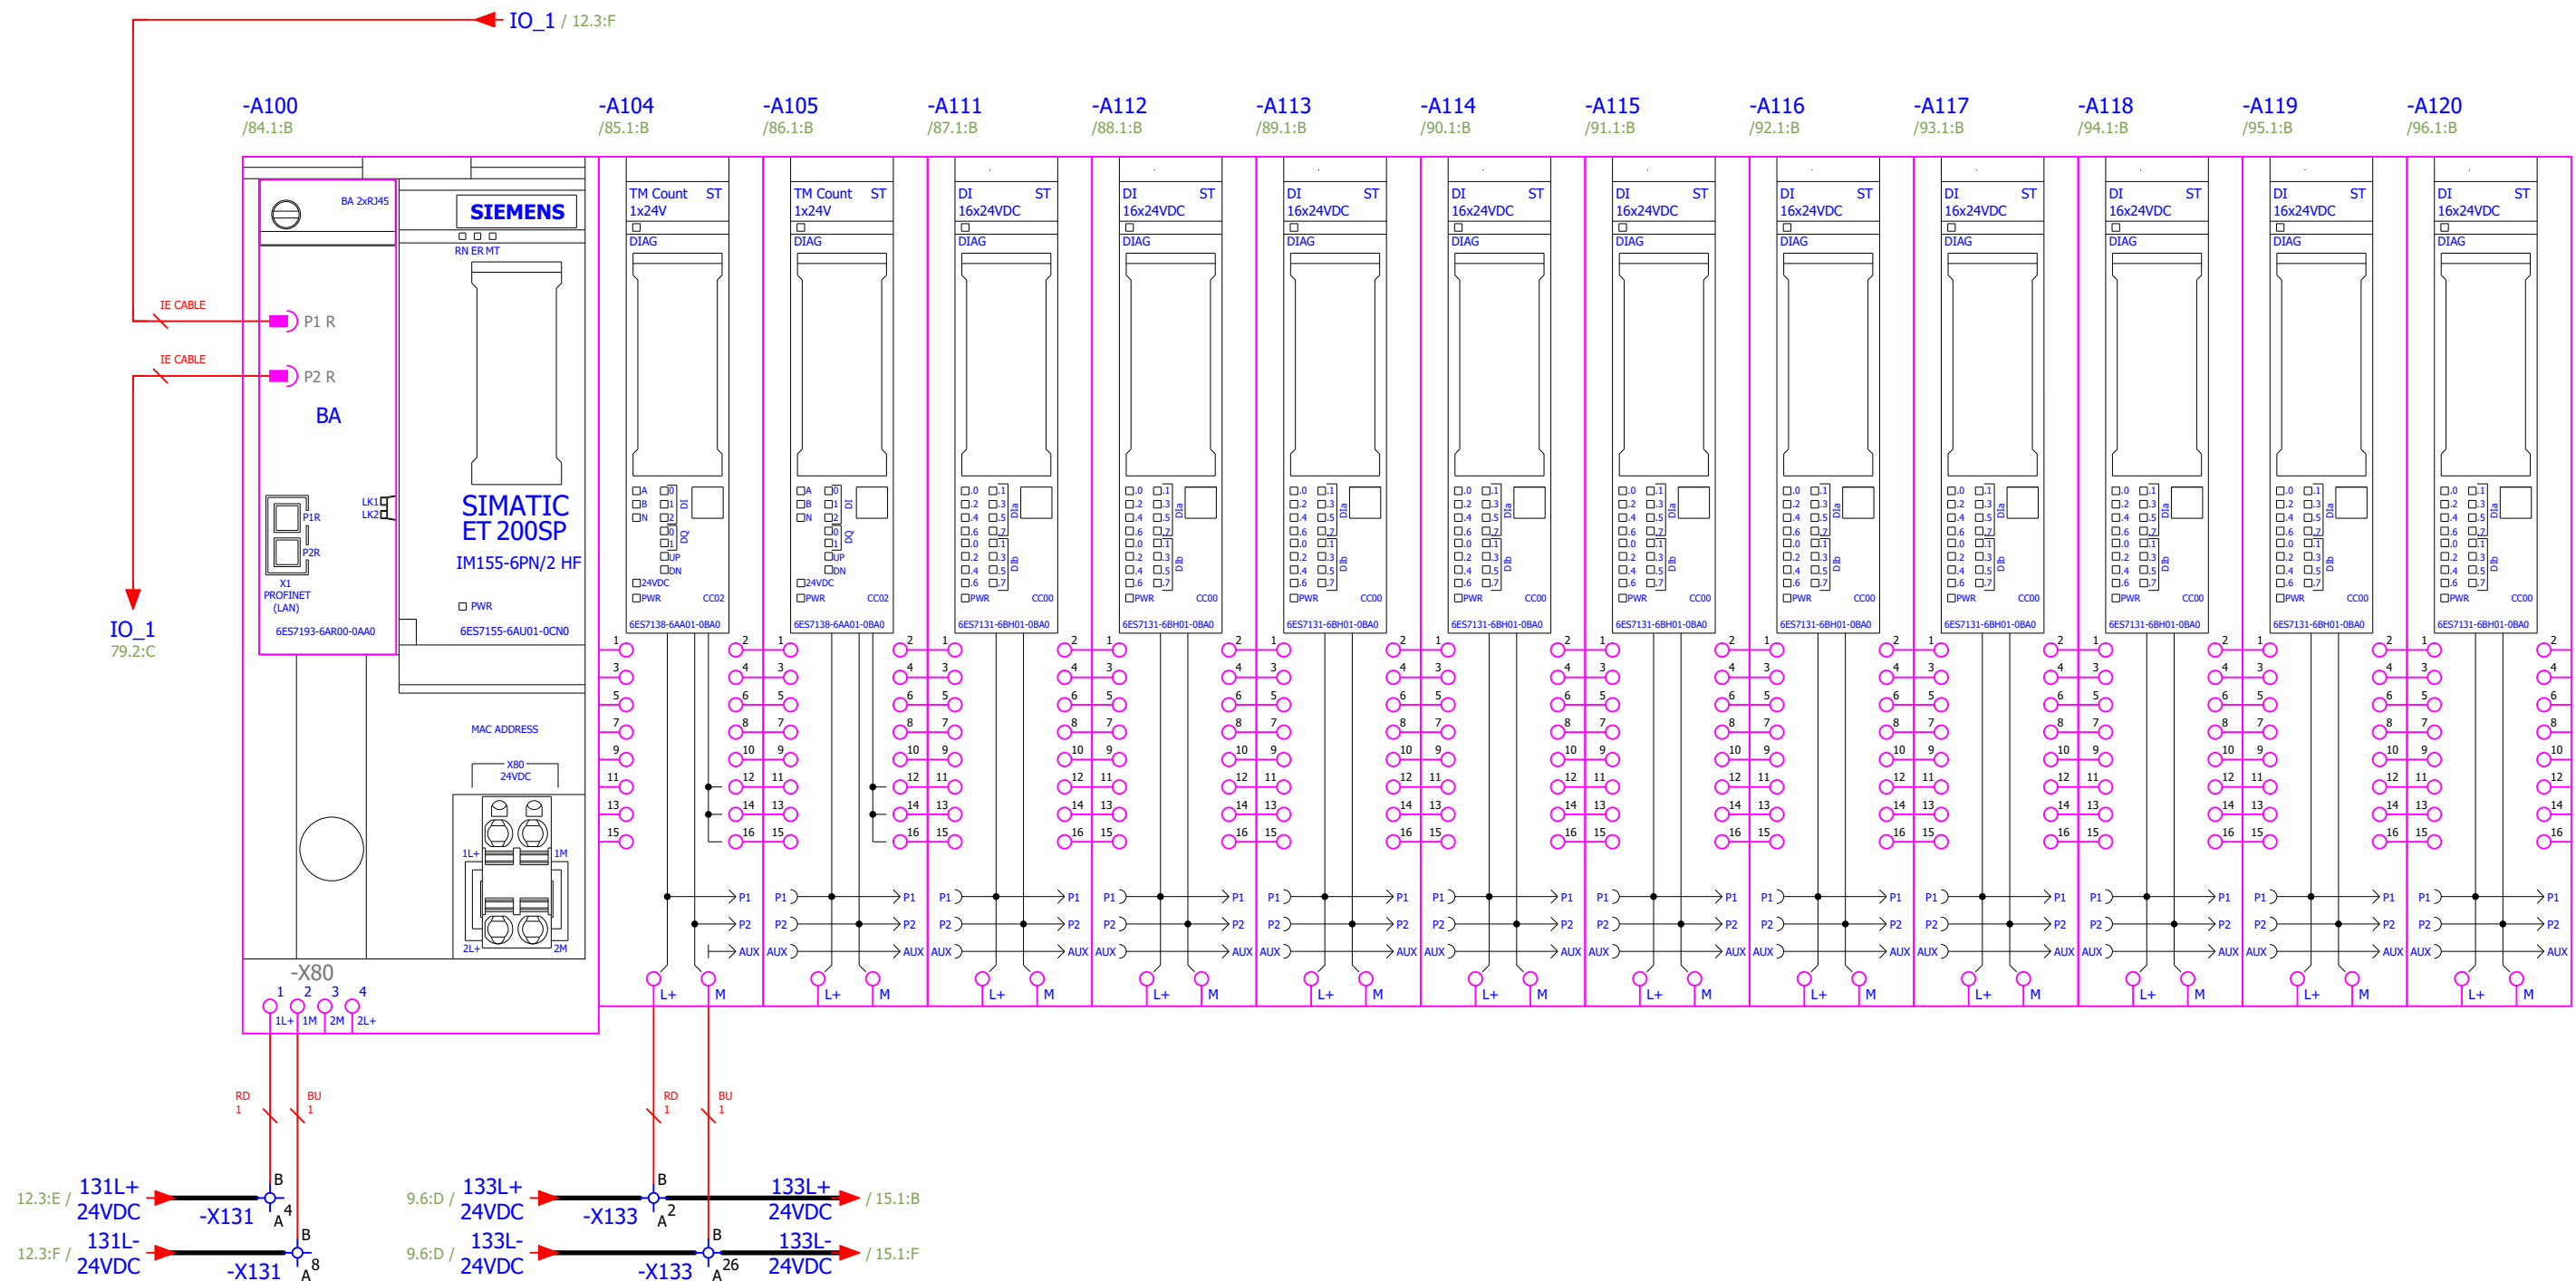


CONFIDENTIAL, ALL RIGHTS RESERVED DIN 34
Format ISO/DIN A3

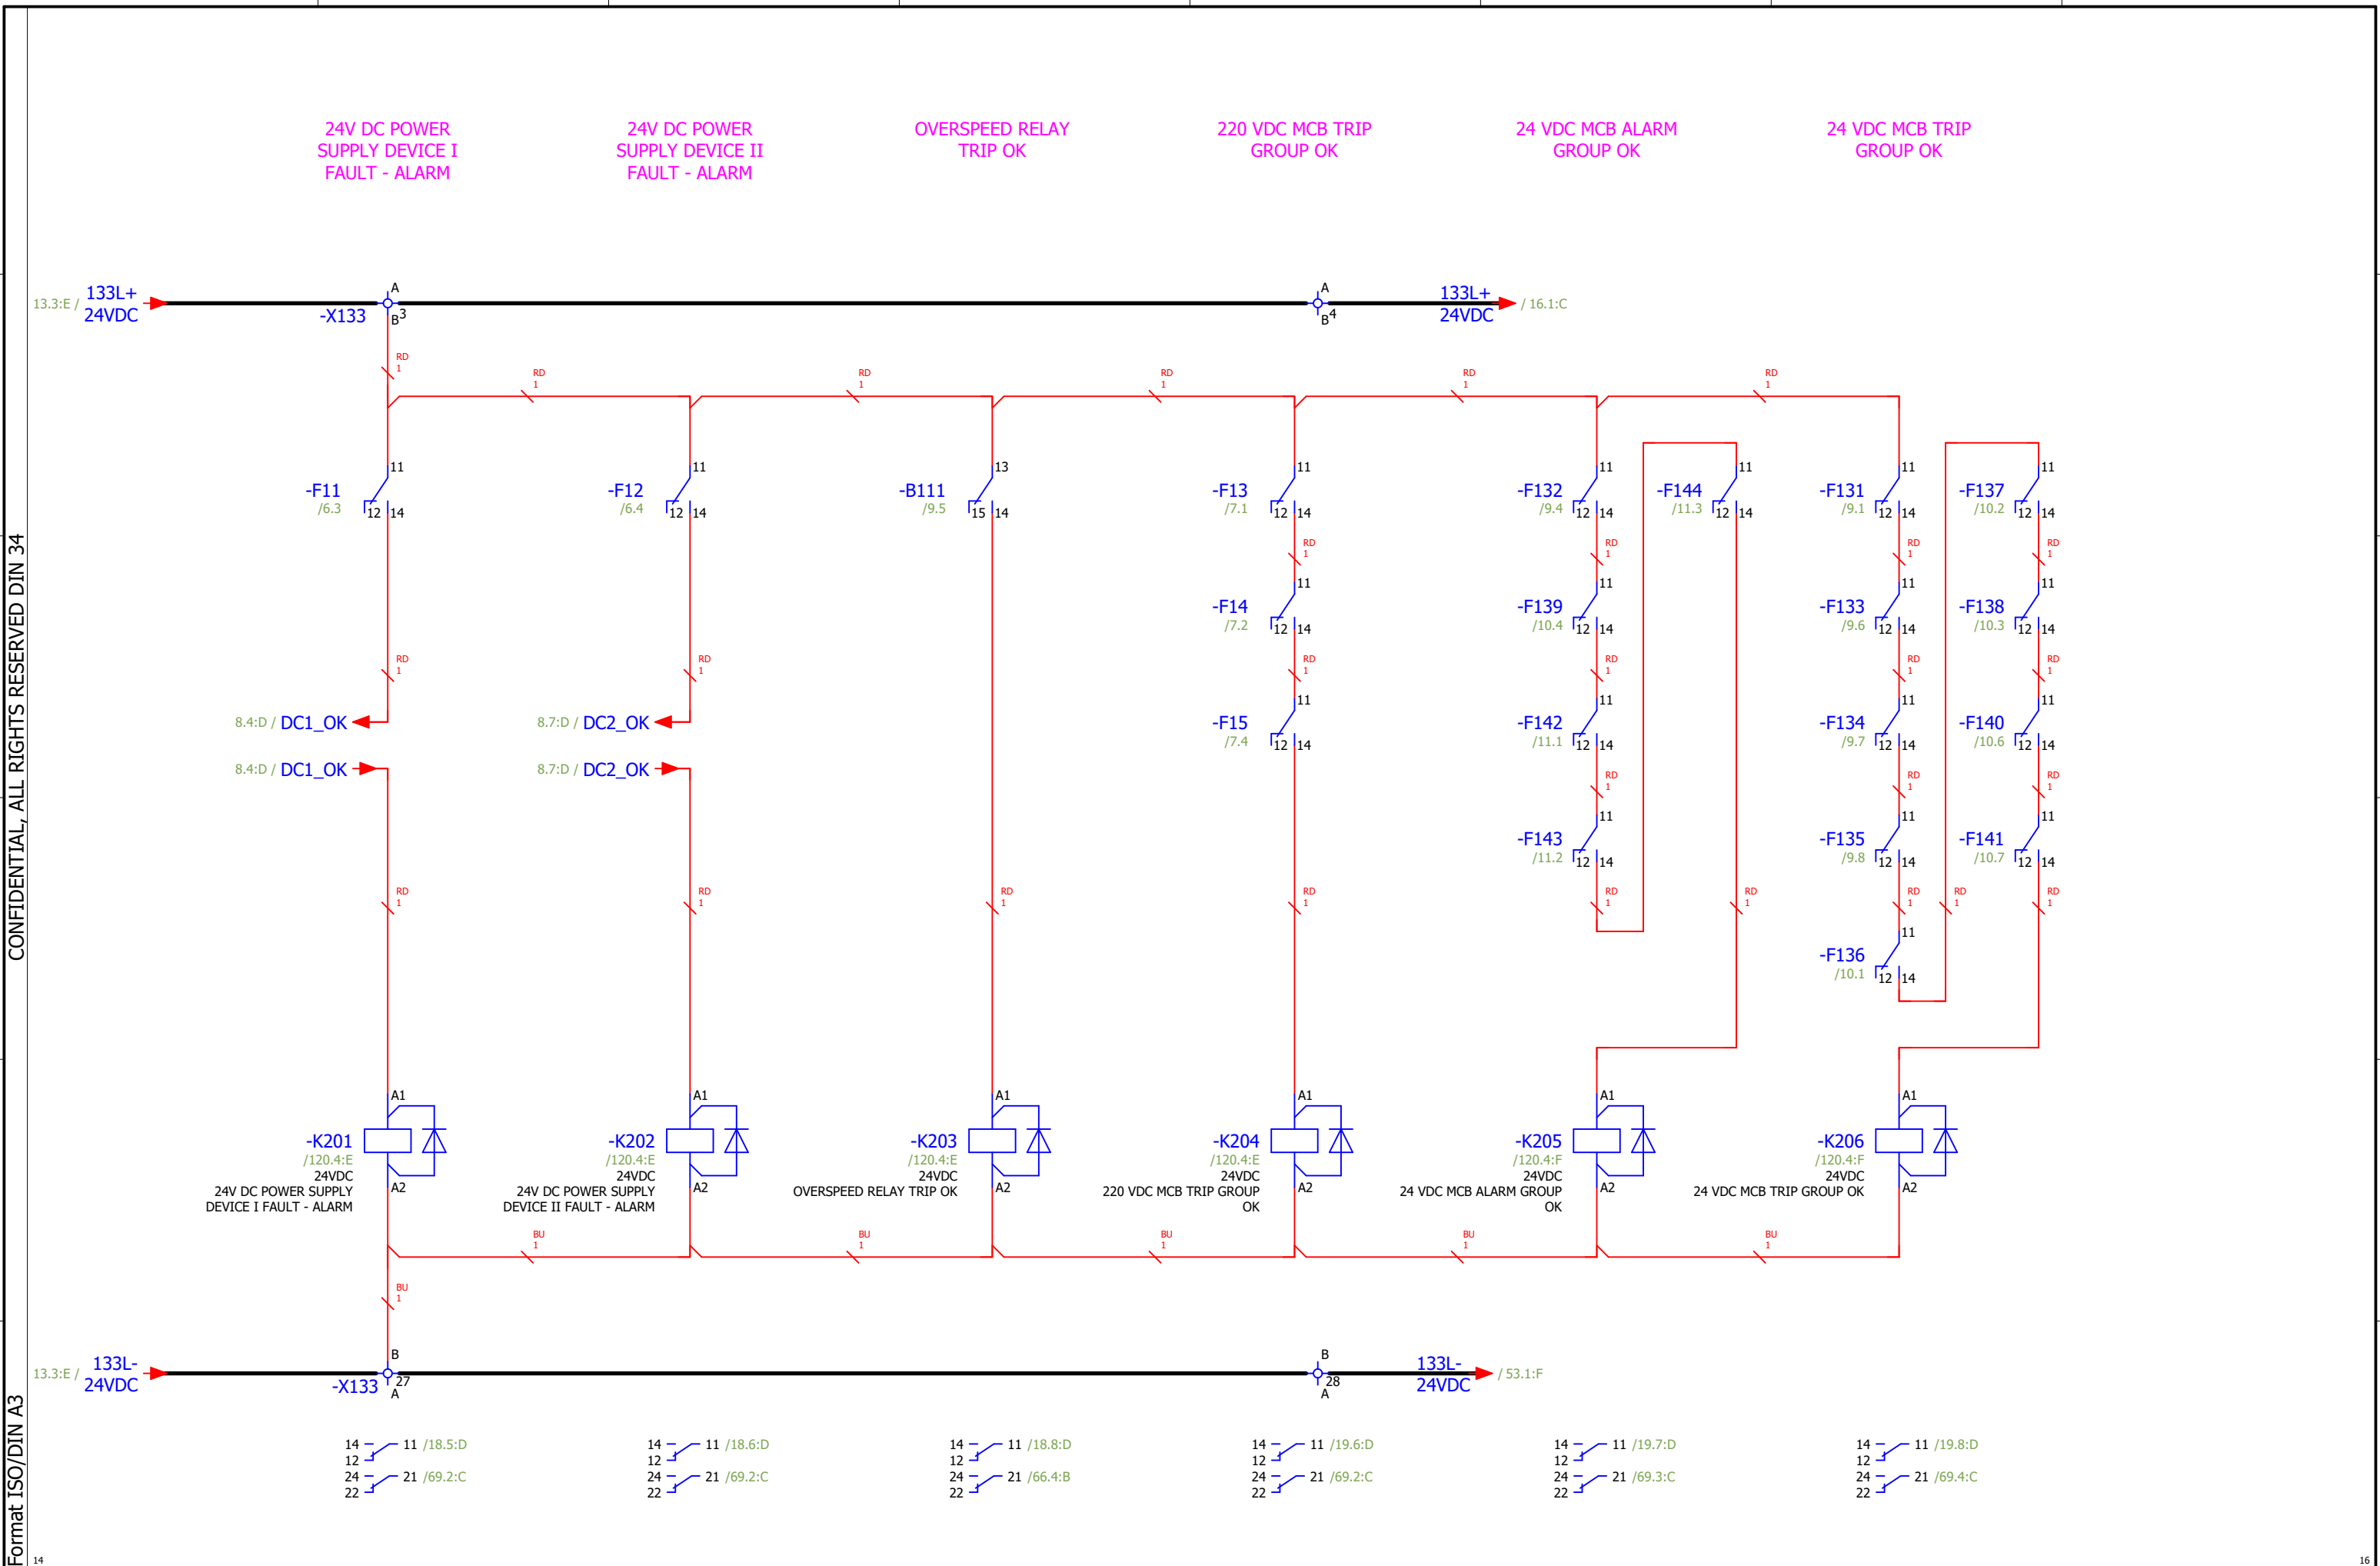

Approved by Contractor			Reconstruction and Modernisation of HPP Perucica - Phase II		 A Voith Company Sintaksa - A Voith Company Ulica Domovinskog rata 104C, 21 000 Split, Hrvatska	Unit KA2 control cubicle circuit diagrams PLC DIGITAL INPUTS: INTERNAL SIGNALS	DRAWING No.: PERU-01-19-170-31-002	REV No.: 02	= UBCJA10GH100 + UBCJA10
Approved by Designer	Grga Kolić	01.10.2026.					Designer No.:	SALES No.:	PAGE 15
Checked by	Antonio Aleksić	01.10.2026.							
Drawn by	Tamara Trogrlić	01.10.2026.							PAGE 15 / 157

CONFIDENTIAL, ALL RIGHTS RESERVED DIN 34

Format ISO/DIN A3

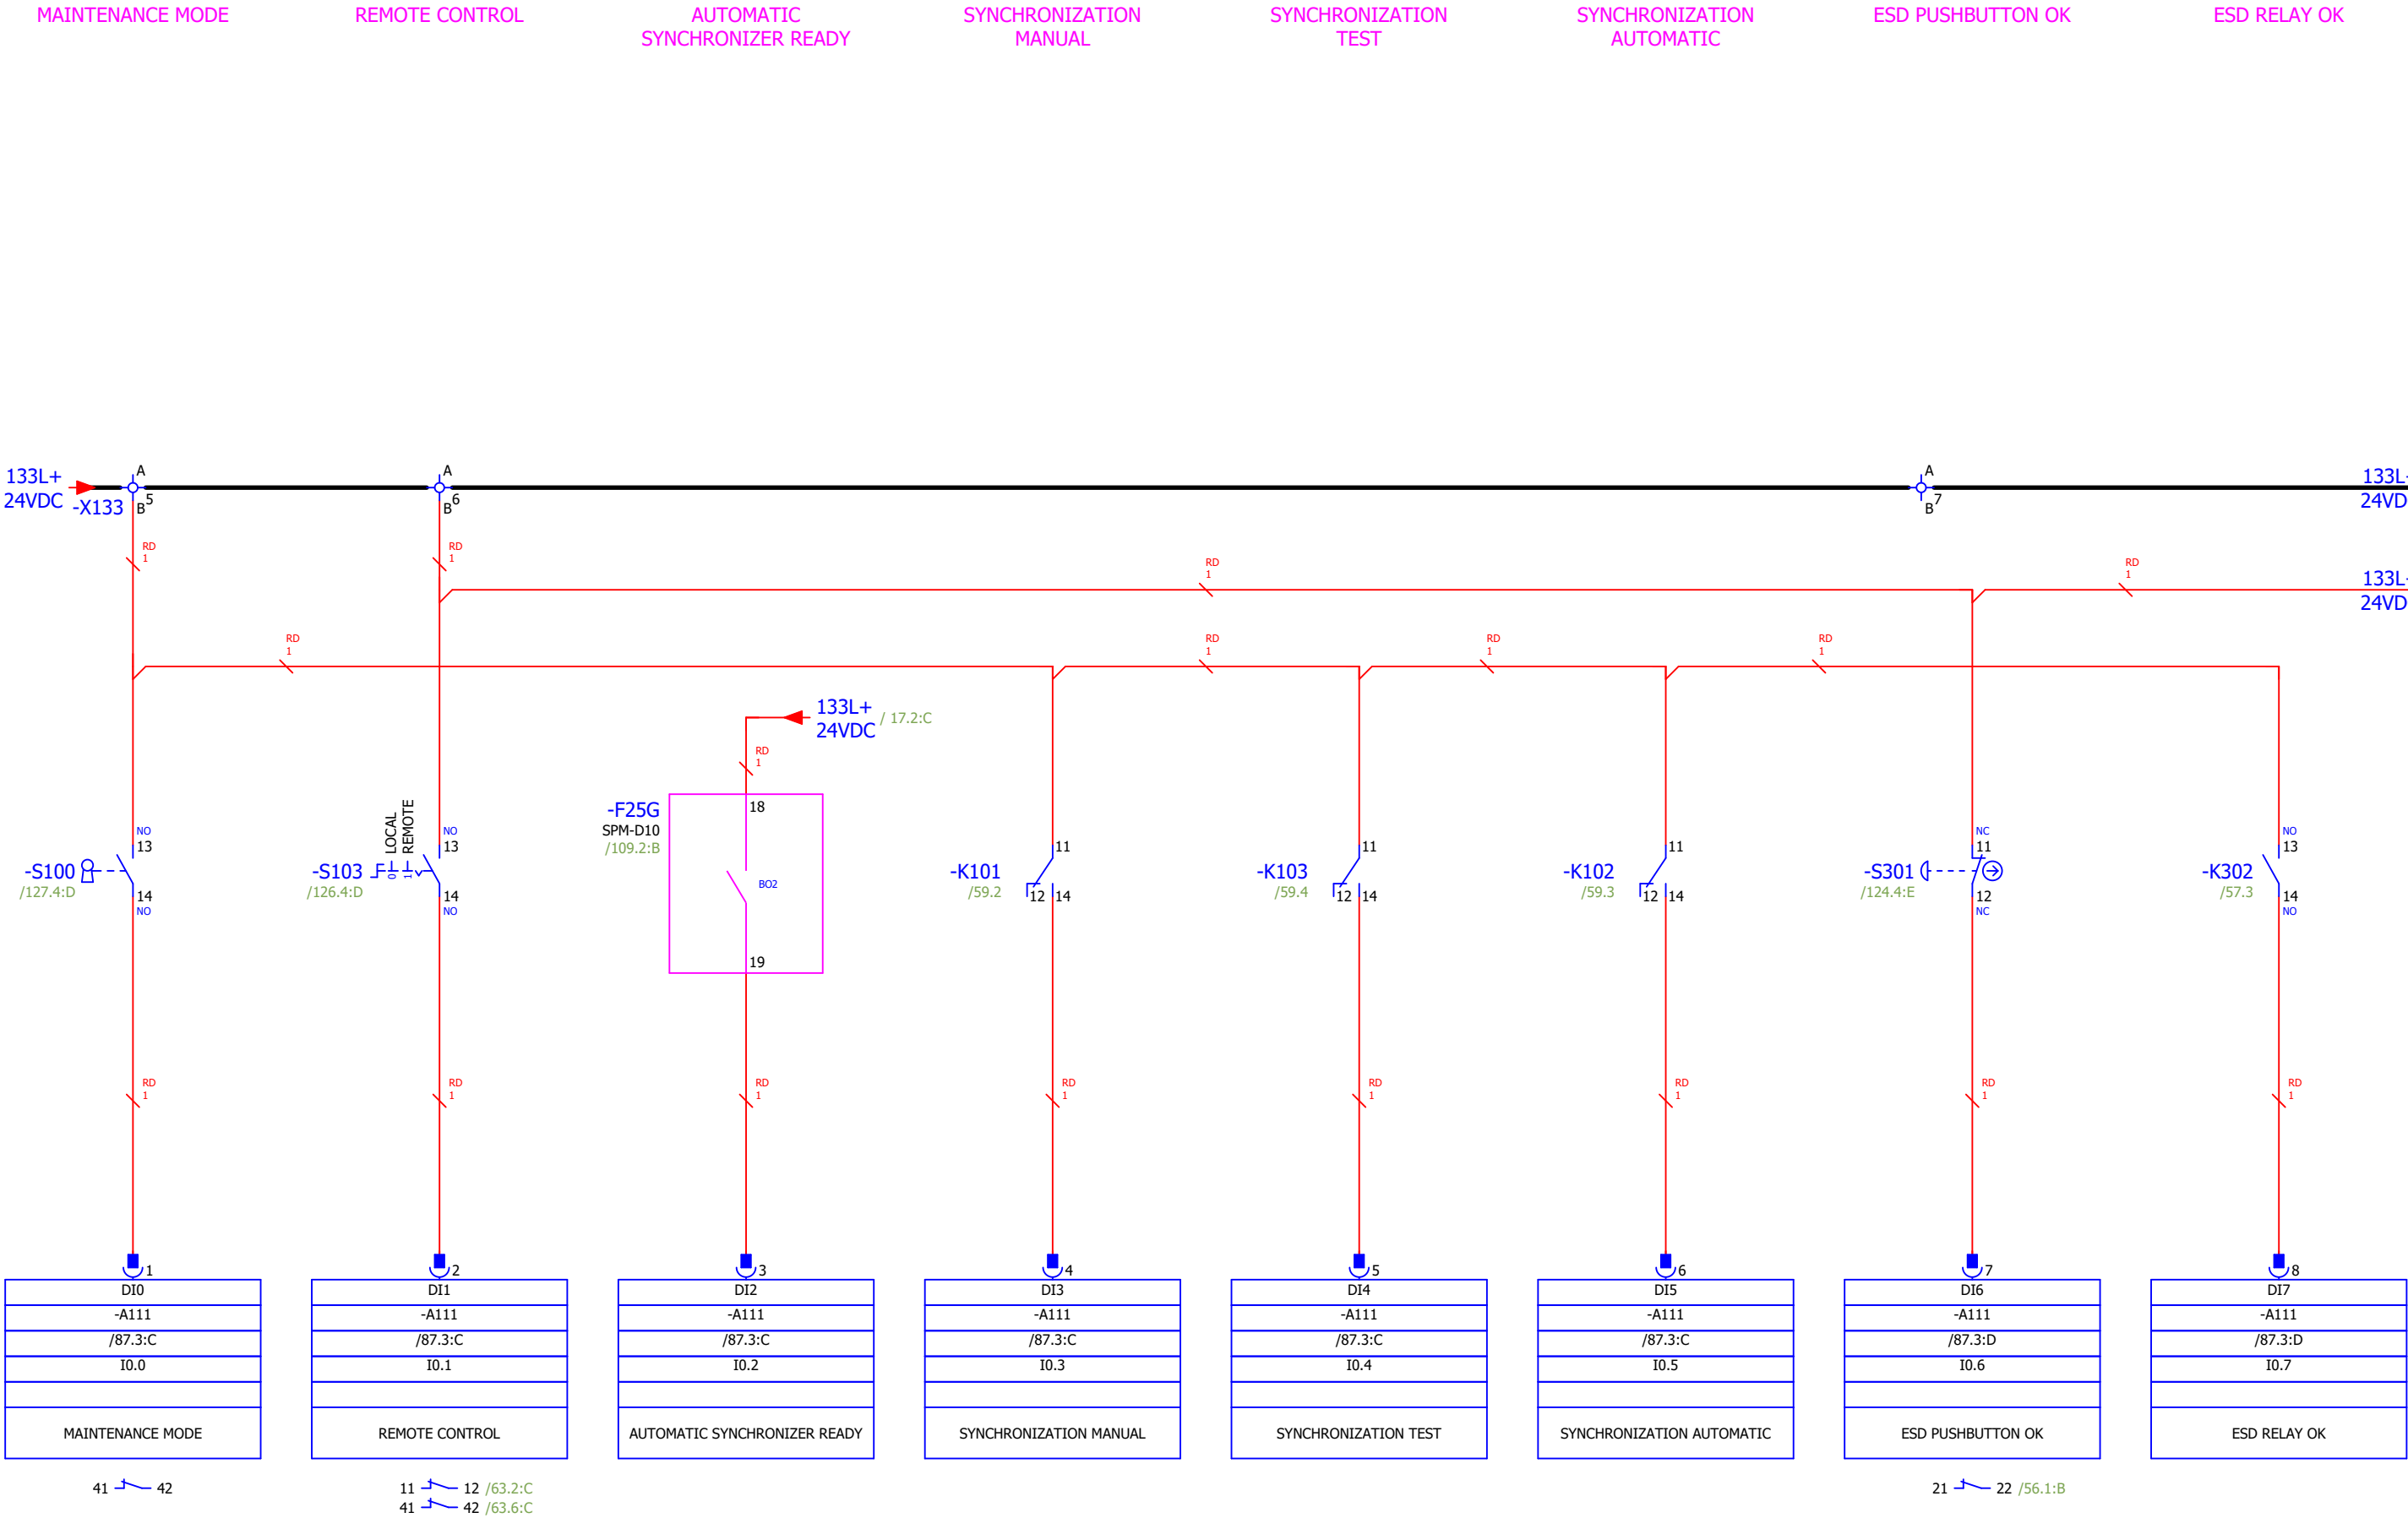

Approved by Contractor			Reconstruction and Modernisation of HPP Perucica - Phase II		 A Voith Company Sintaksa - A Voith Company Ulica Domovinskog rata 104C, 21 000 Split, Hrvatska	Unit KA2 control cubicle circuit diagrams DIGITAL INPUTS: 0.0 - 0.7	DRAWING No.: PERU-01-19-170-31-002	REV No.: 02	= UBCJA10GH100 + UBCJA10
Approved by Designer	Grga Kolić	01.10.2026.					Designer No.:	SALES No.:	PAGE 16
Checked by	Antonio Aleksić	01.10.2026.							
Drawn by	Tamara Trogrlić	01.10.2026.							PAGE 16 / 157

ESD RESET PUSHBUTTON

LAMP TEST PUSHBUTTON

START PUSHBUTTON

STOP PUSHBUTTON

SYNCHRONIZATION
START


SYNCHRONIZATION STOP

EXCITATION OFF

EXCITATION ON

CONFIDENTIAL, ALL RIGHTS RESERVED DIN 34

Format ISO/DIN A3

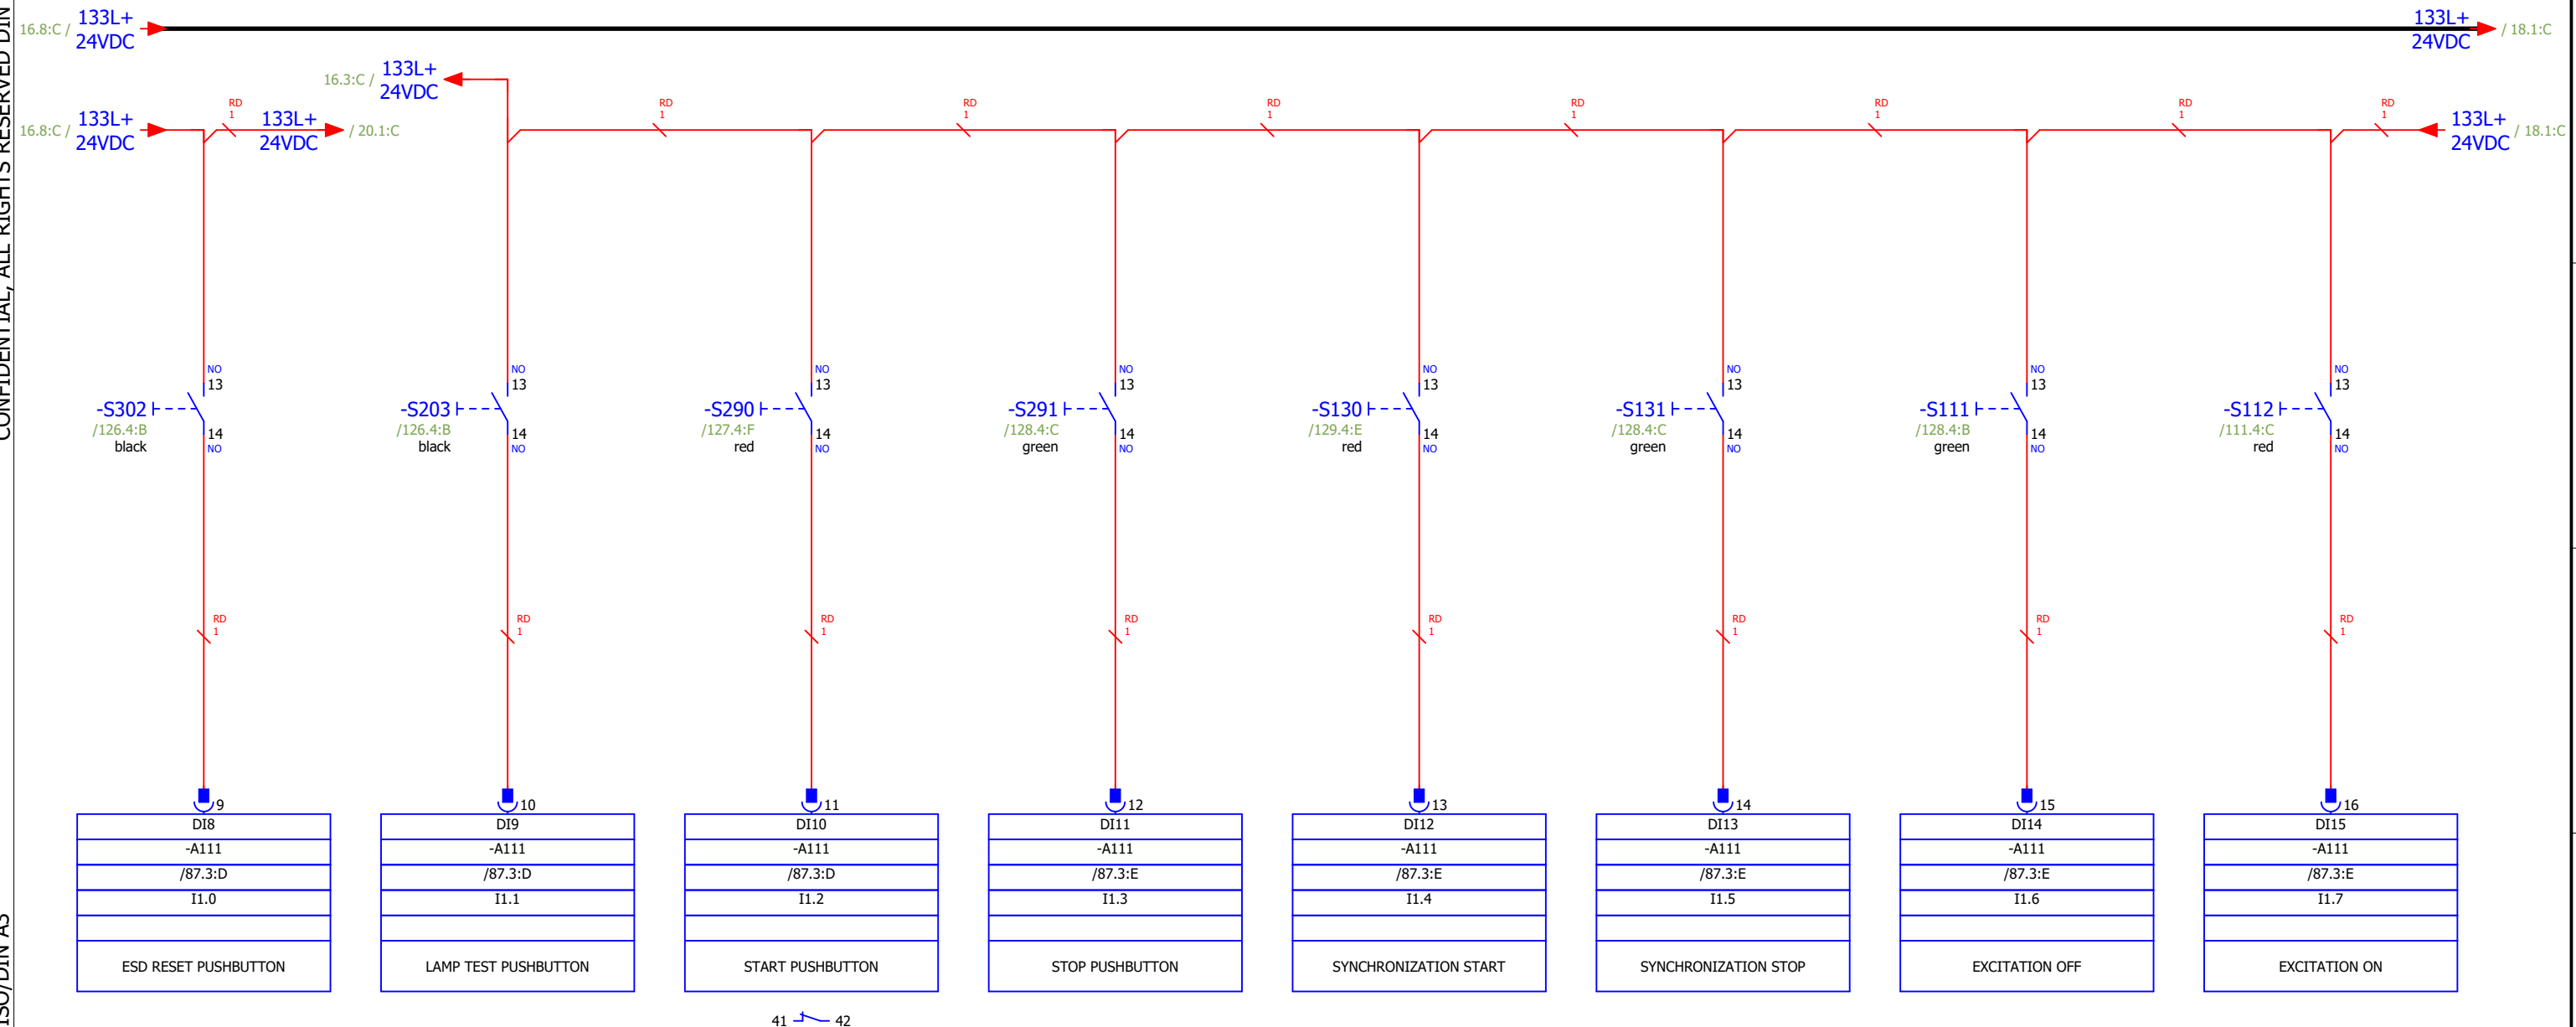

18 |

Approved by Contractor			Reconstruction and Modernisation of HPP Perucica - Phase II		 SINTAKSA A Voith Company Sintaksa - A Voith Company Ulica Domovinskog rata 104C, 21 000 Split, Hrvatska	Unit KA2 control cubicle circuit diagrams	DRAWING No.:	REV No.:	= UBCJA10GH100
Approved by Designer	Grga Kolić	01.10.2026.					PERU-01-19-170-31-002	02	+ UBCJA10
Checked by	Antonio Aleksić	01.10.2026.					Designer No.:	SALES No.:	PAGE 17
Drawn by	Tamara Trogrlić	01.10.2026.	PROJECT NAME	EMPLOYER	DESIGNER	DIGITAL INPUTS: 1.0 - 1.7			PAGE 17 / 157

GCB OFF COMMAND

GCB ON COMMAND

SPEED SETPOINT UP


SPEED SETPOINT DN

DC CONVERTER 1 OK


DC CONVERTER 2 OK

SPARE

OVERSPEED RELAY TRIP
OK

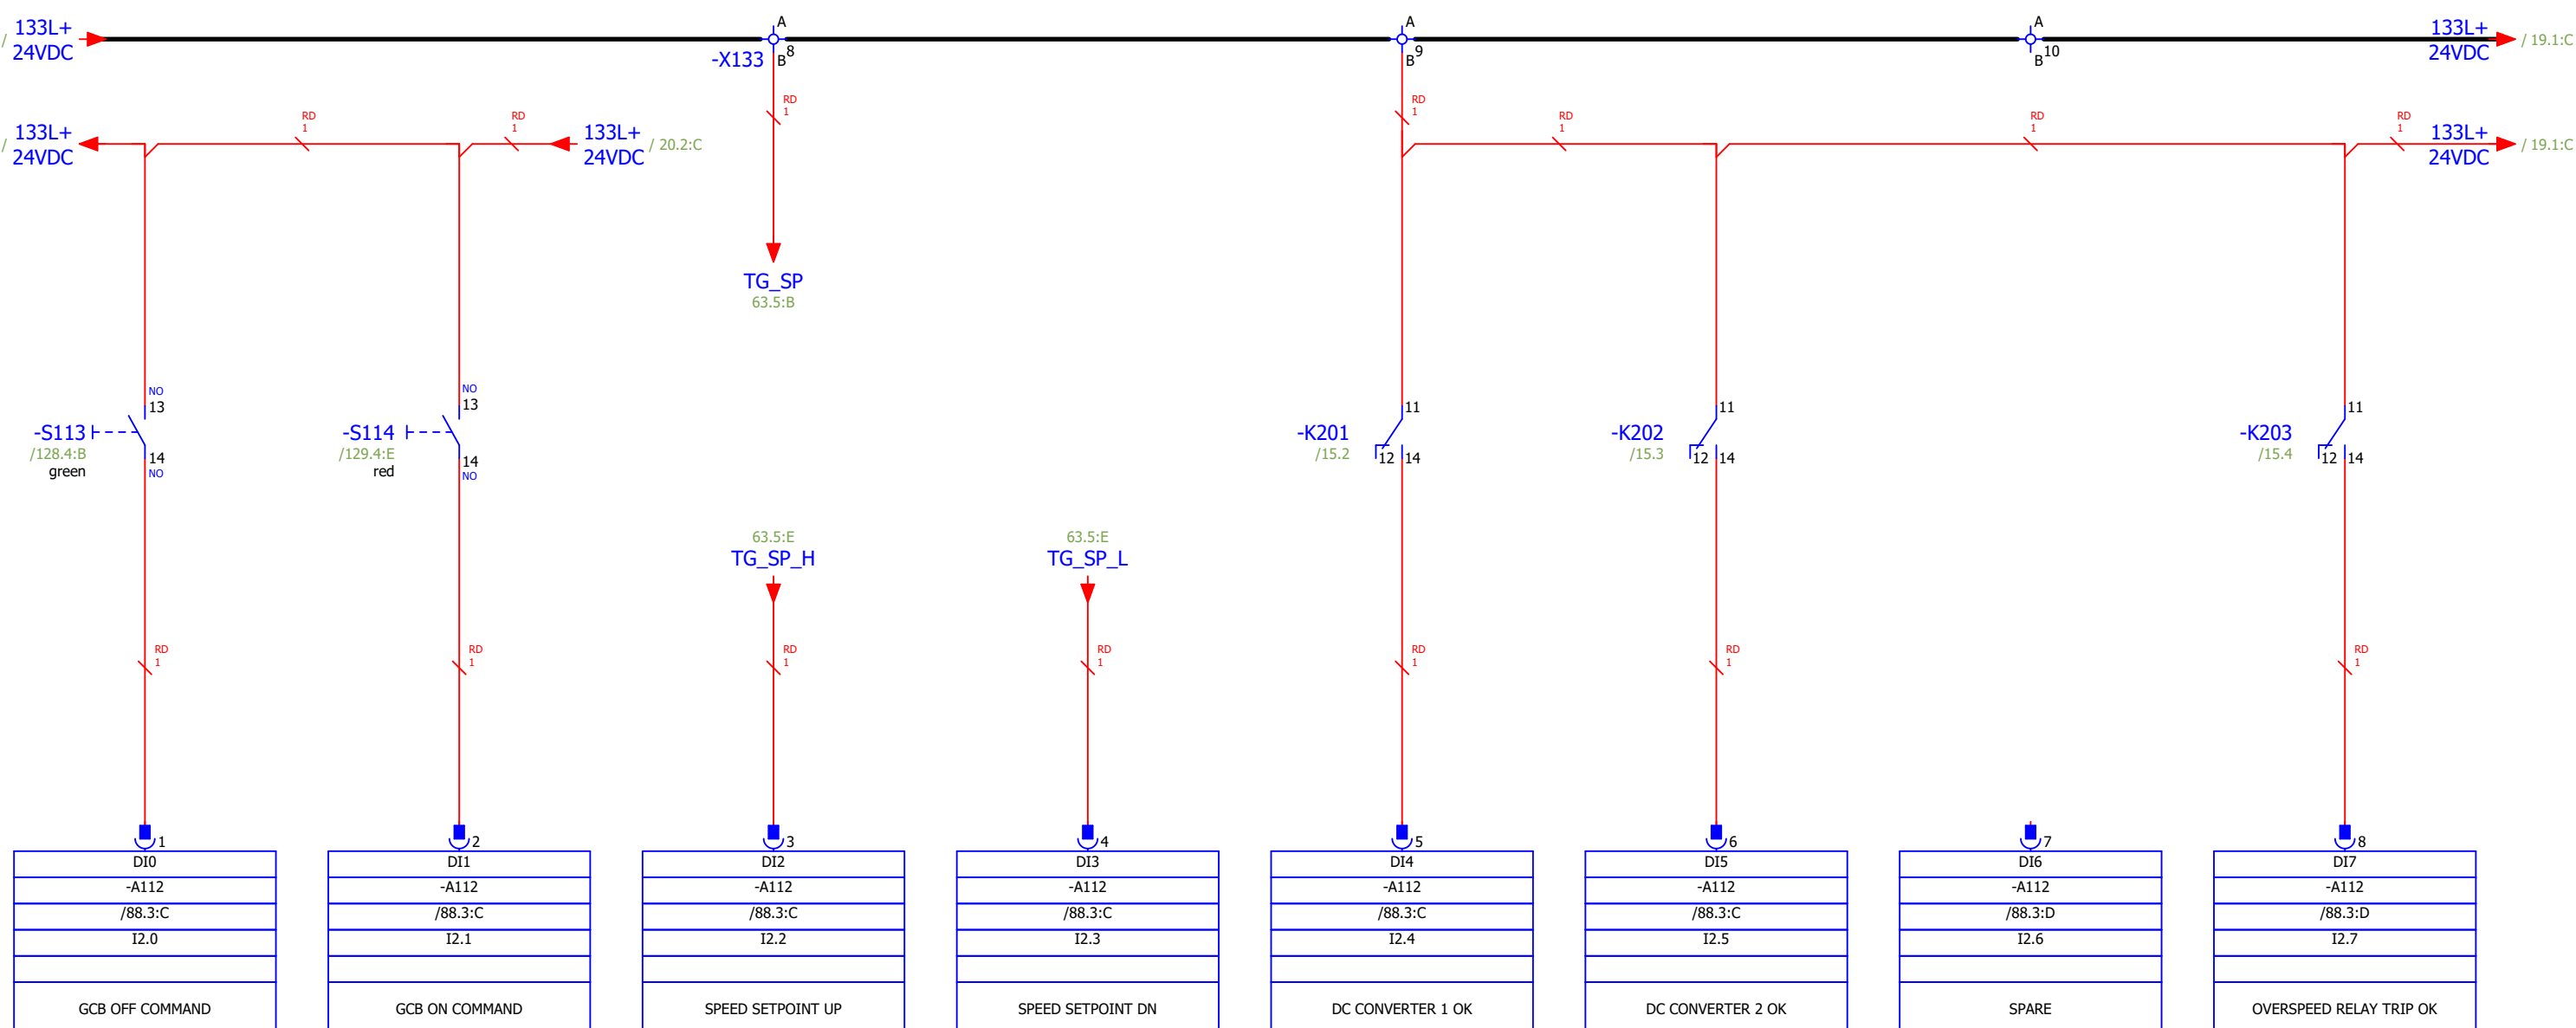

Approved by Contractor			Reconstruction and Modernisation of HPP Perucica - Phase II		 A Voith Company	Unit KA2 control cubicle circuit diagrams	DRAWING No.: PERU-01-19-170-31-002	REV No.: 02	= UBCJA10GH100 + UBCJA10
Approved by Designer	Grga Kolić	01.10.2026.							
Checked by	Antonio Aleksić	01.10.2026.							
Drawn by	Tamara Trogrlić	01.10.2026.	PROJECT NAME	EMPLOYER	DESIGNER	DIGITAL INPUTS: 2.0 - 2.7	Designer No.:	SALES No.:	PAGE 18 / 157

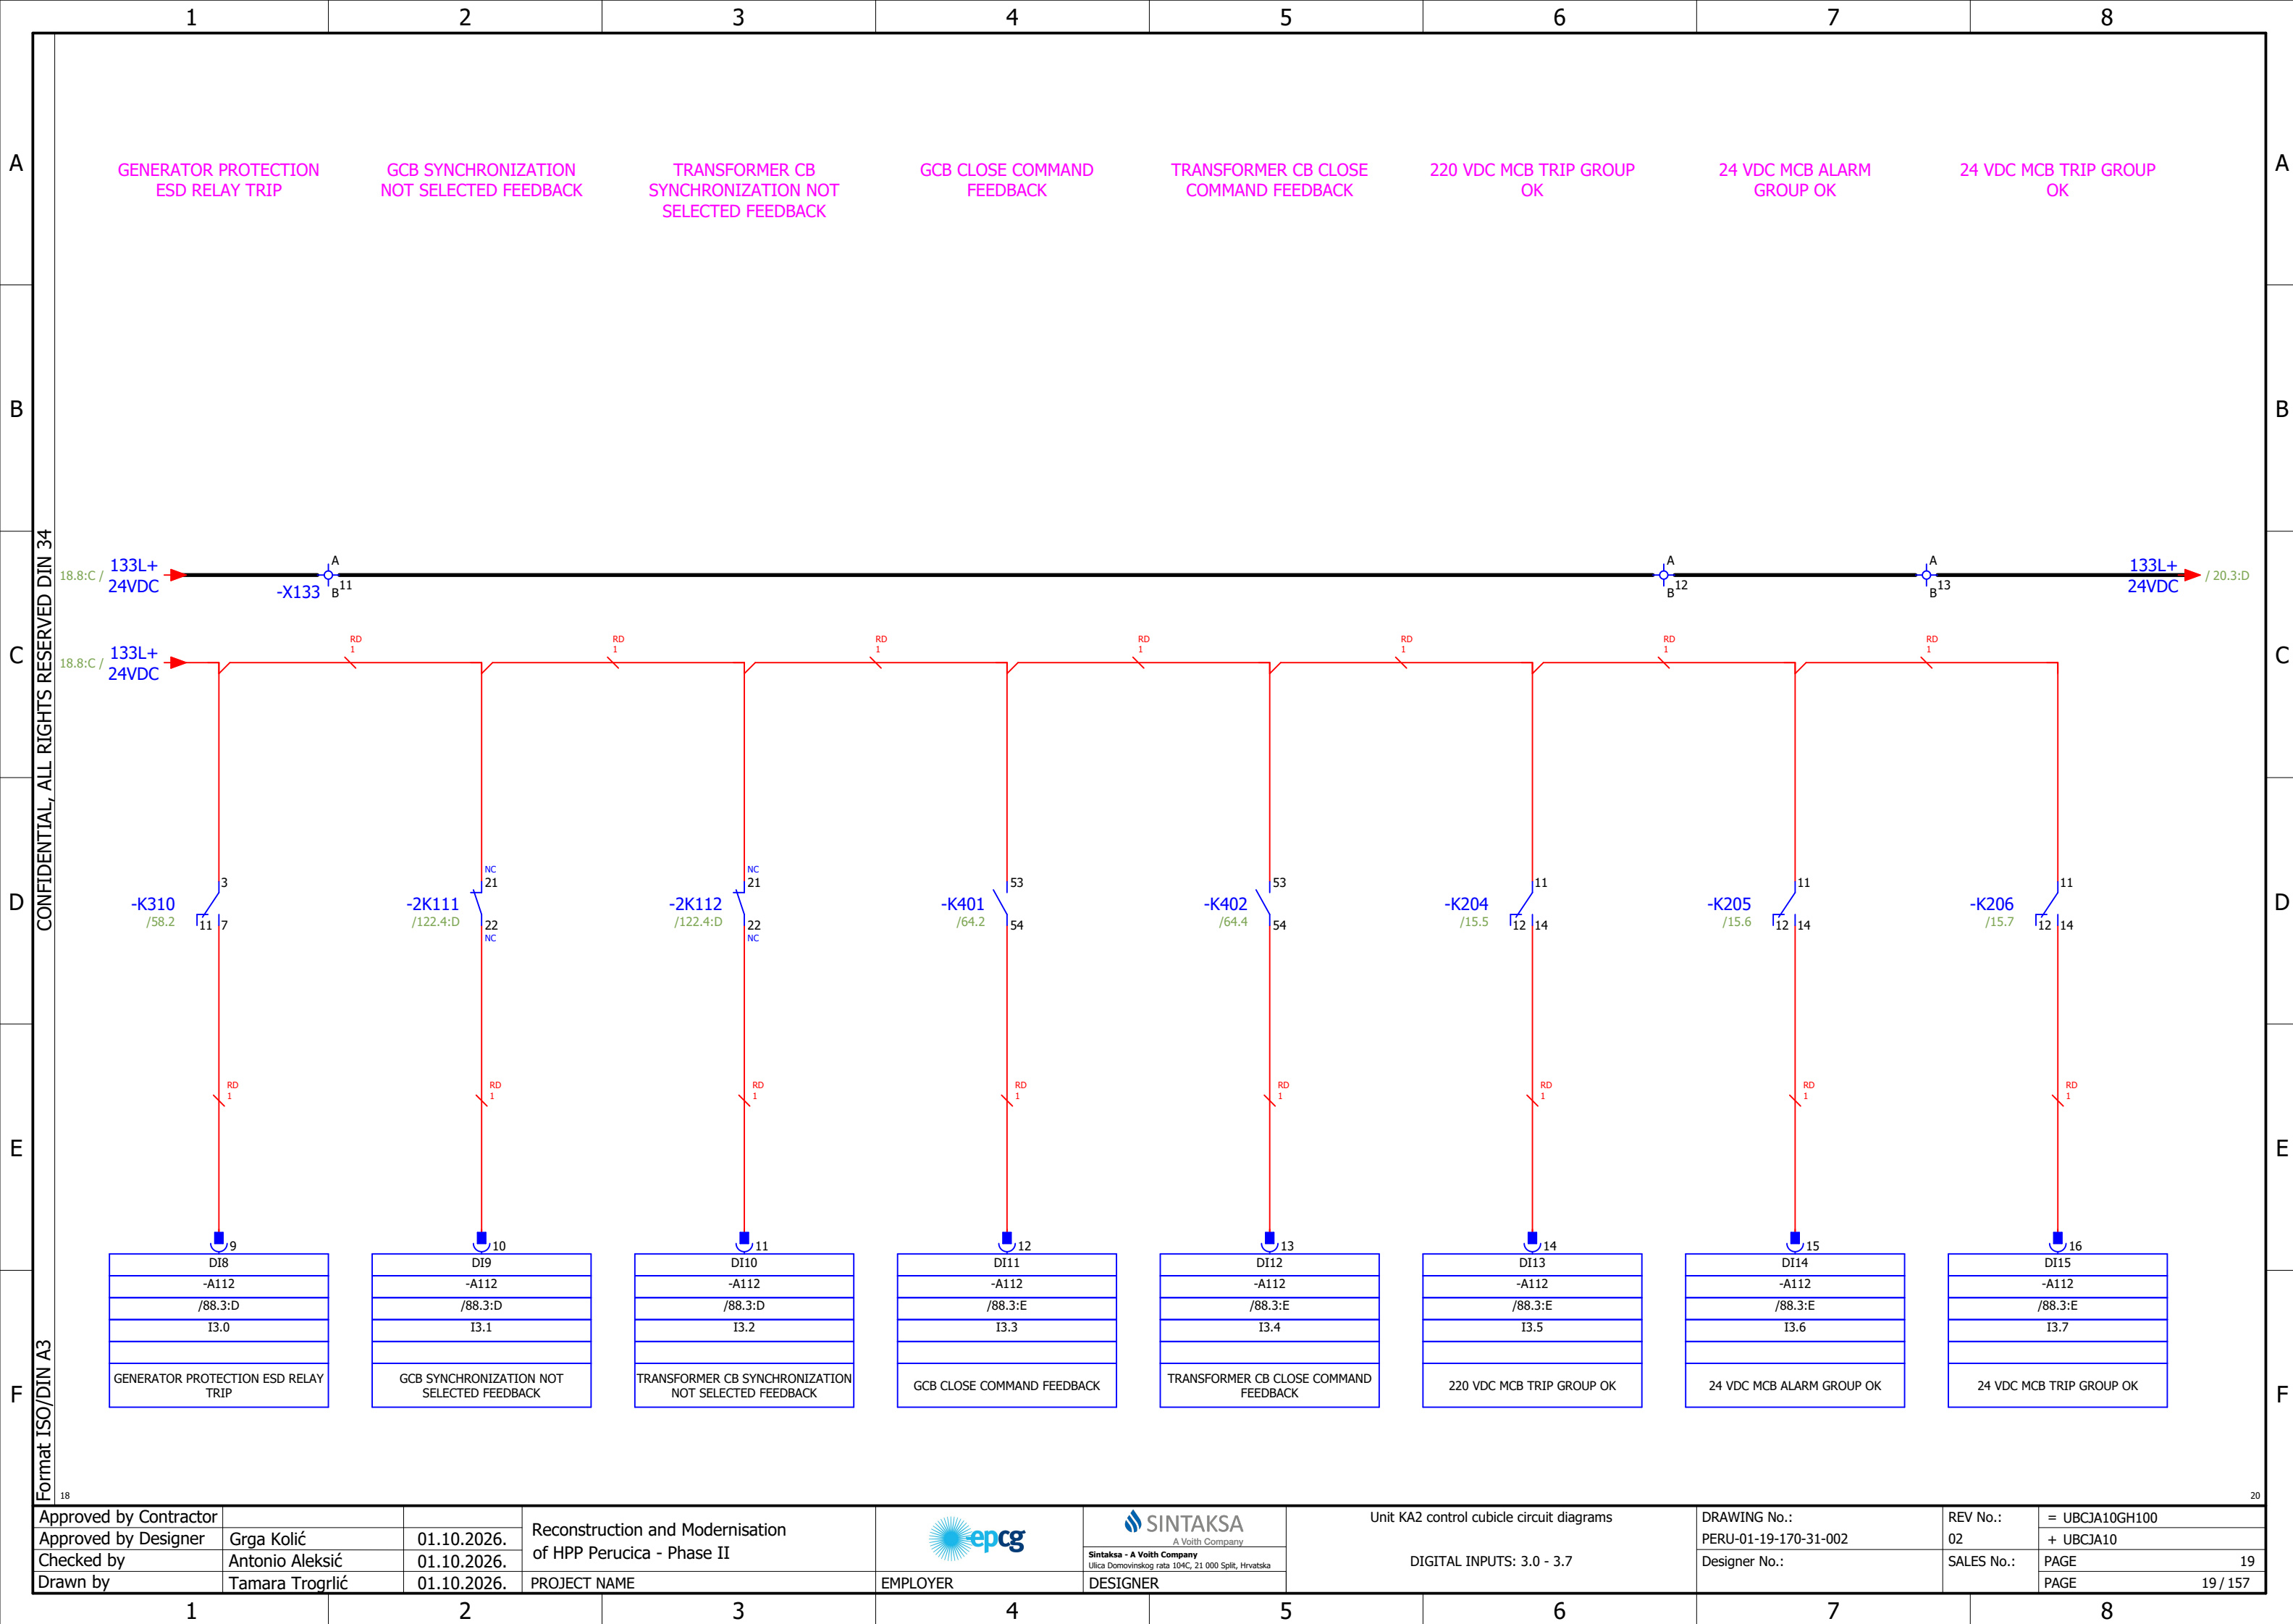

A

1

B

1

C

1

D

1

E


1

F

1

CONFIDENTIAL, ALL RIGHTS RESERVED DIN 34

Format ISO/DIN A3

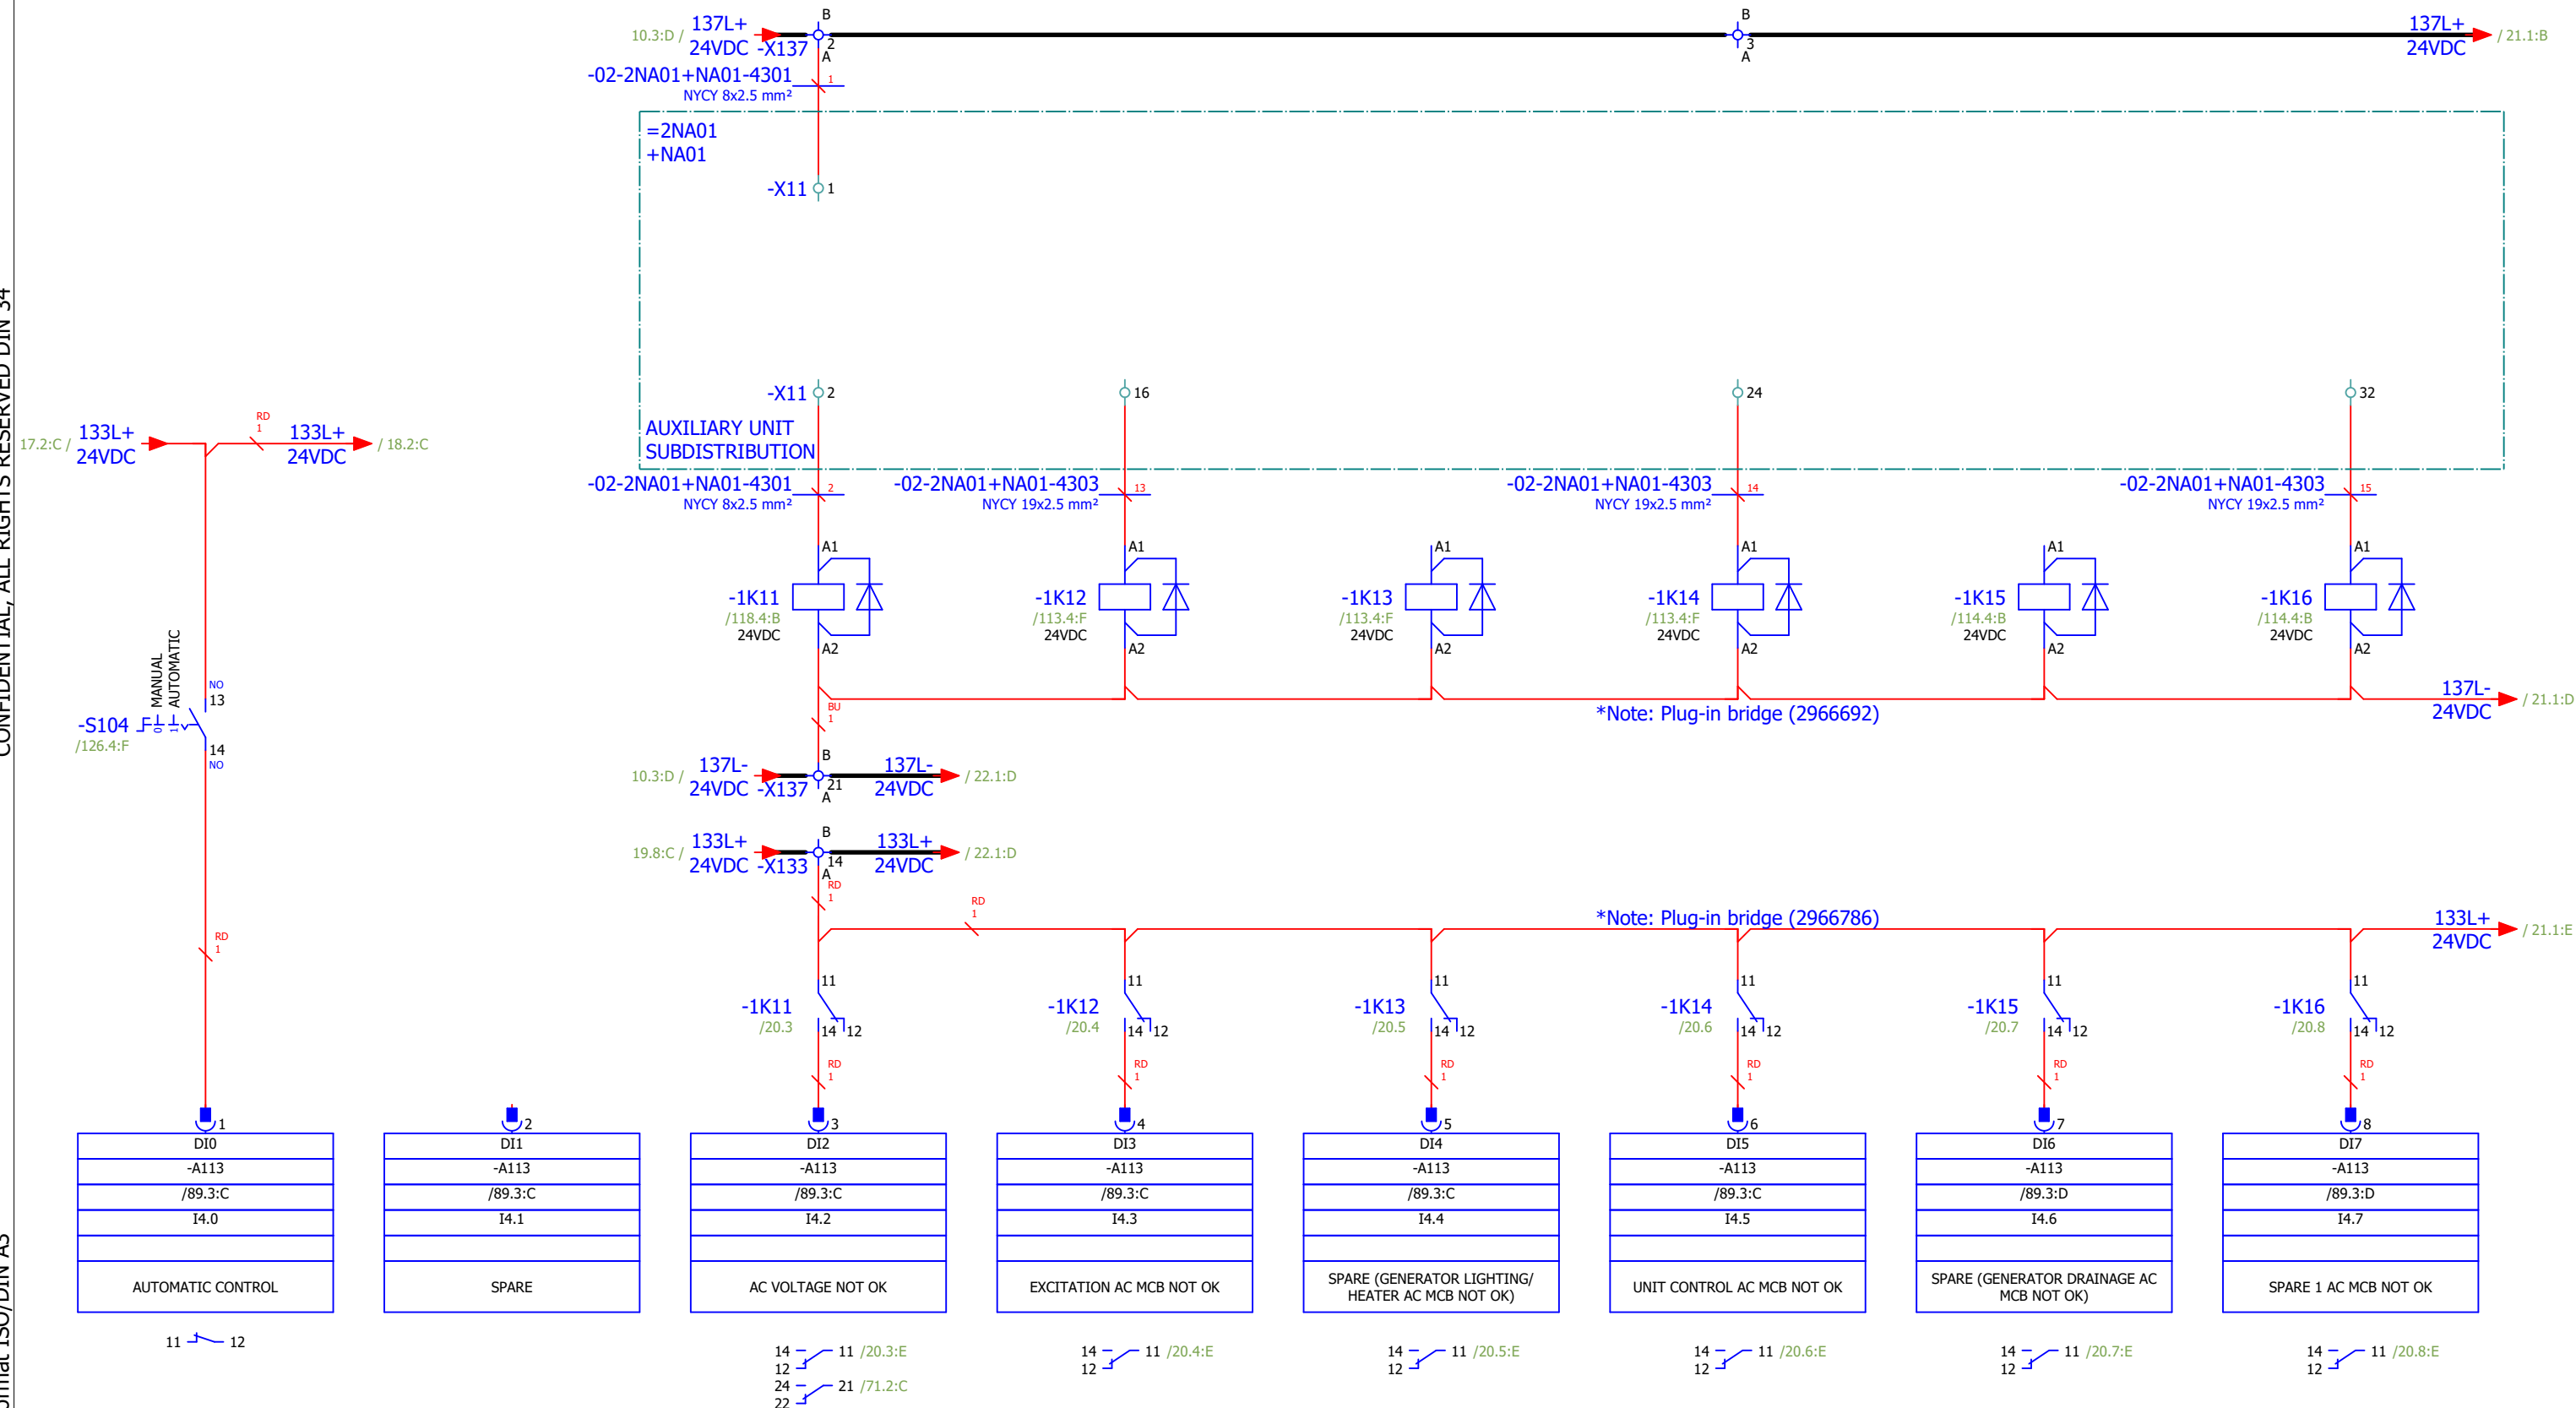

Approved by Contractor			Reconstruction and Modernisation of HPP Perucica - Phase II		 SINTAKSA <i>A Voith Company</i>	Unit KA2 control cubicle circuit diagrams	DRAWING No.: PERU-01-19-170-31-002	REV No.: 02	= UBCJA10GH100 + UBCJA10
Approved by Designer	Grga Kolić	01.10.2026.							
Checked by	Antonio Aleksić	01.10.2026.							
Drawn by	Tamara Trogrlić	01.10.2026.	PROJECT NAME	EMPLOYER	DESIGNER	DIGITAL INPUTS: 4.0 - 4.7	Designer No.:	SALES No.:	PAGE 20 / 157

A

A

B

B

C

C

D

D

E


E

F


F

CONFIDENTIAL, ALL RIGHTS RESERVED DIN 34

Format ISO/DIN A3

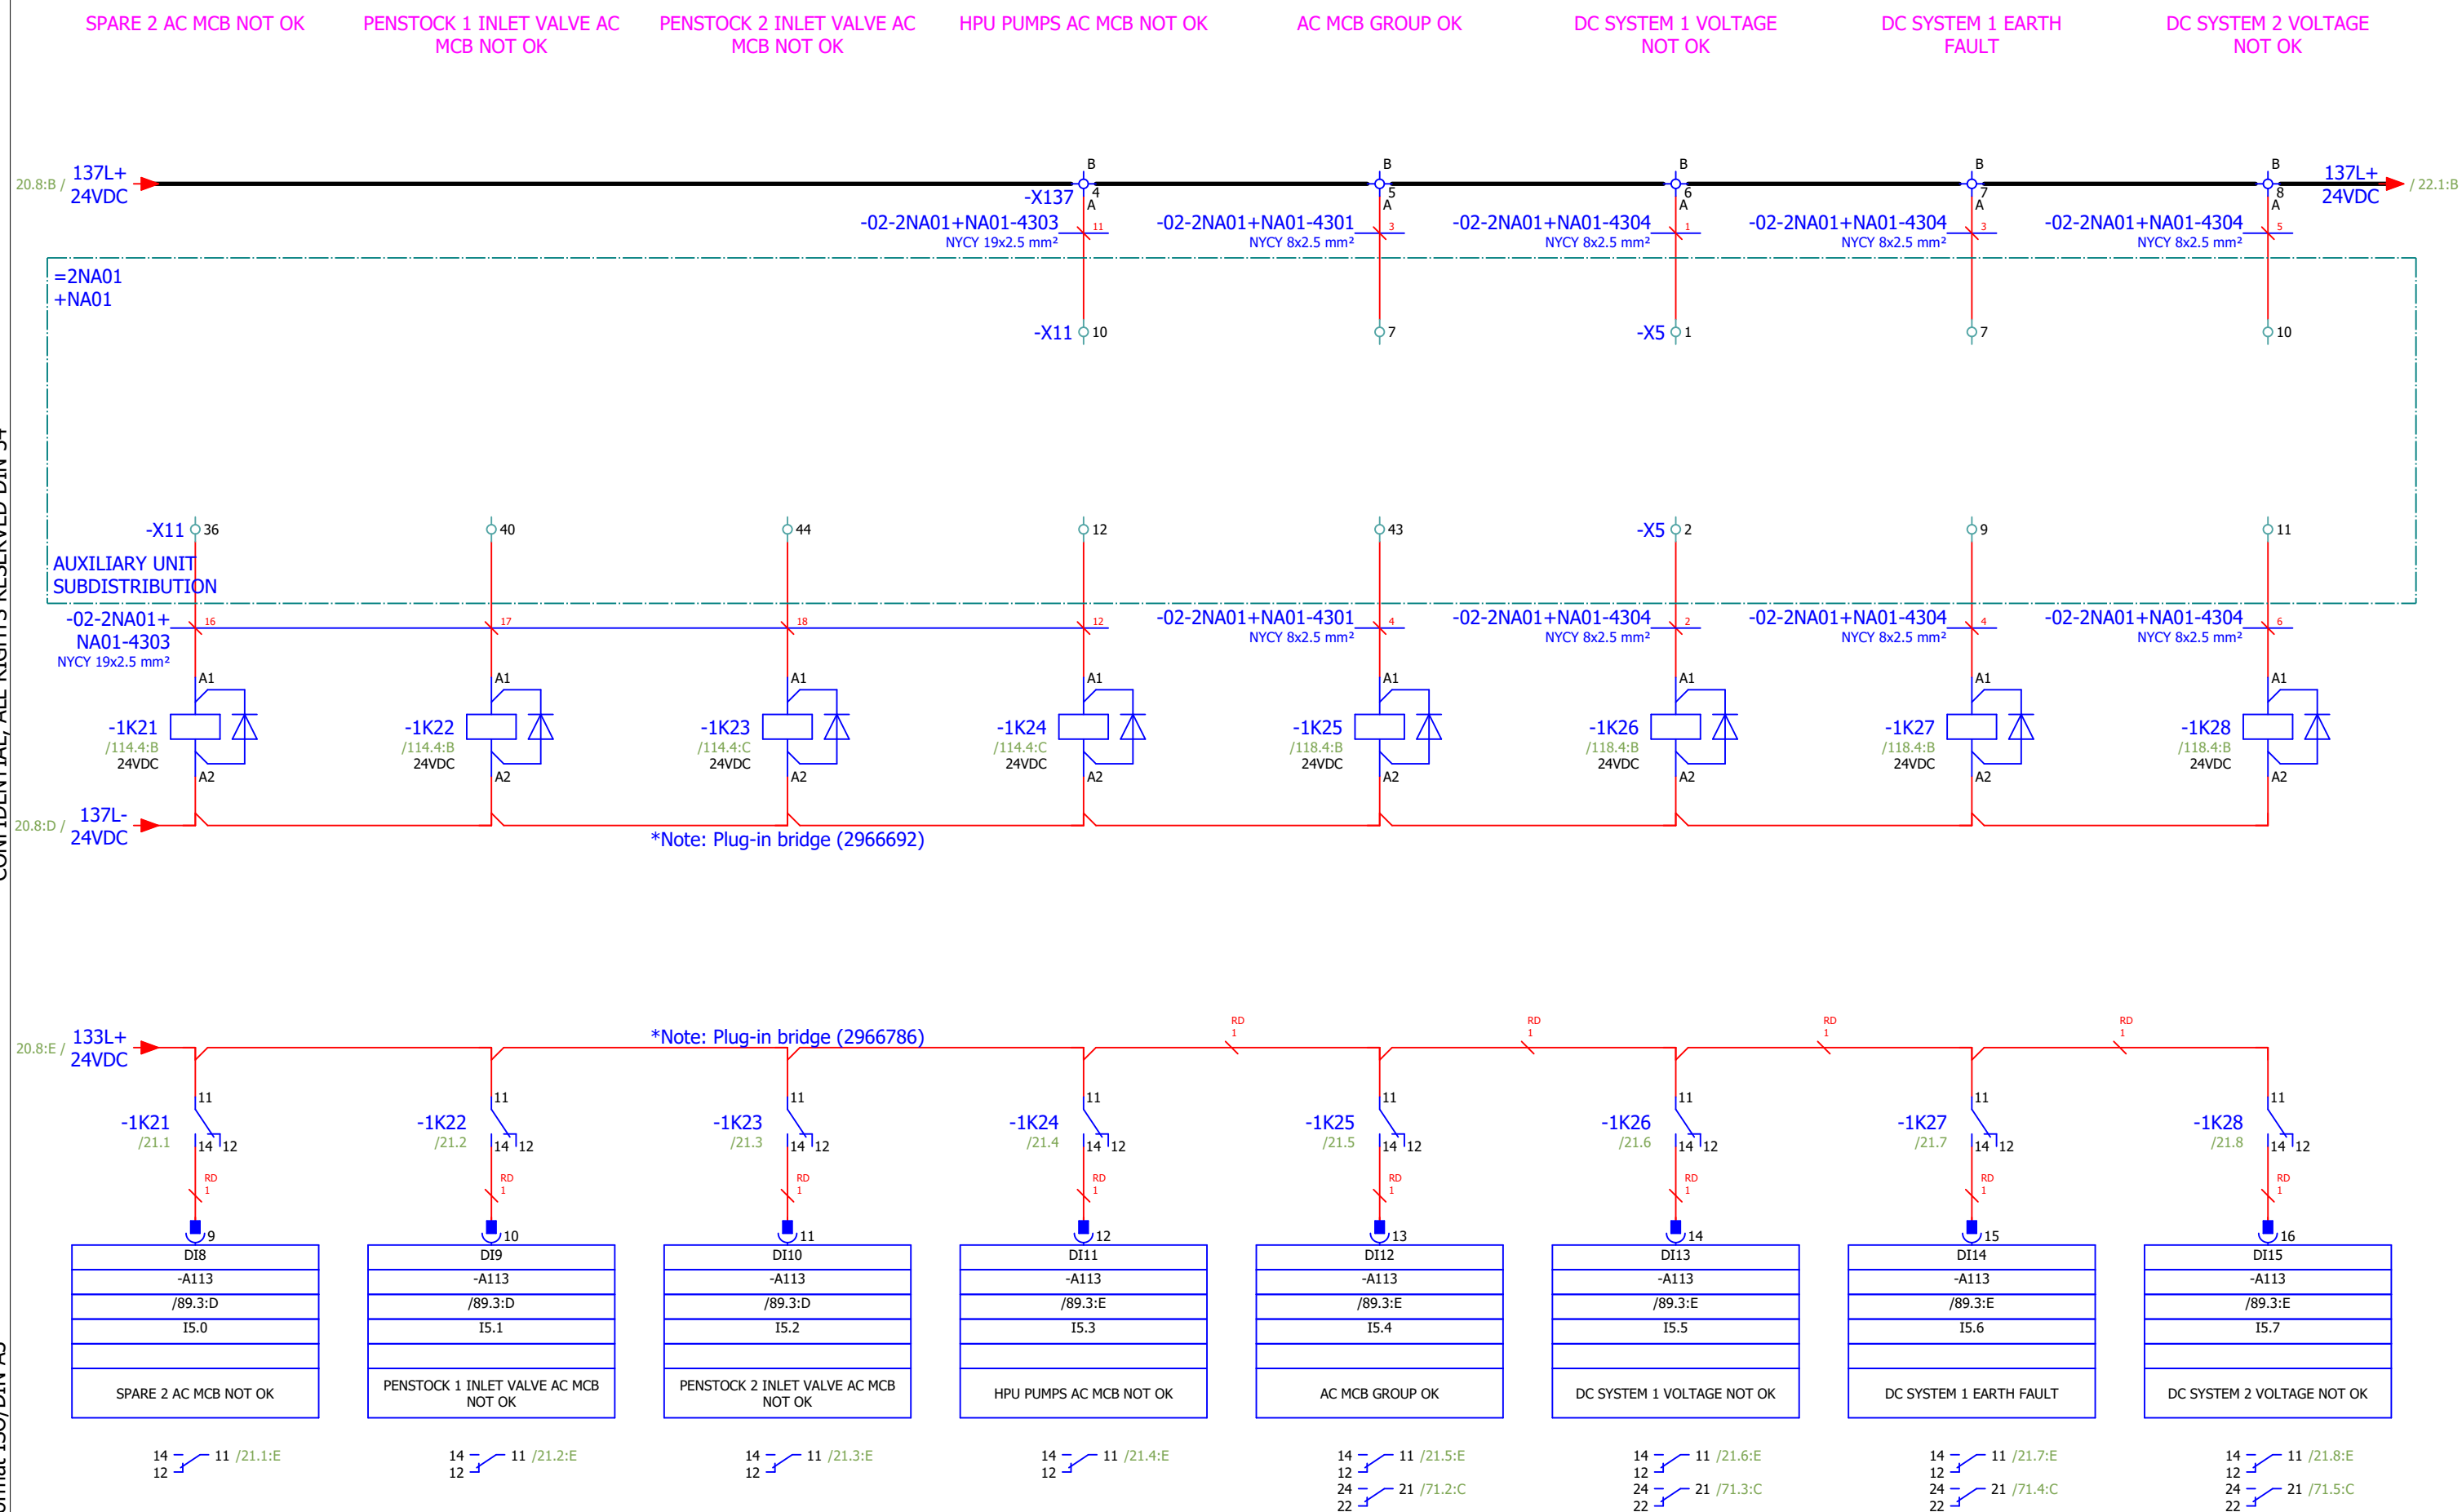

Approved by Contractor			Reconstruction and Modernisation of HPP Perucica - Phase II		 SINTAKSA A Voith Company Sintaksa - A Voith Company Ulica Domovinskog rata 104C, 21 000 Split, Hrvatska	Unit KA2 control cubicle circuit diagrams	DRAWING No.:	REV No.:	= UBCJA10GH100
Approved by Designer	Grga Kolić	01.10.2026.					PERU-01-19-170-31-002	02	+ UBCJA10
Checked by	Antonio Aleksić	01.10.2026.					Designer No.:	SALES No.:	PAGE 21
Drawn by	Tamara Trogrlić	01.10.2026.	PROJECT NAME	EMPLOYER	DESIGNER				PAGE 21 / 157

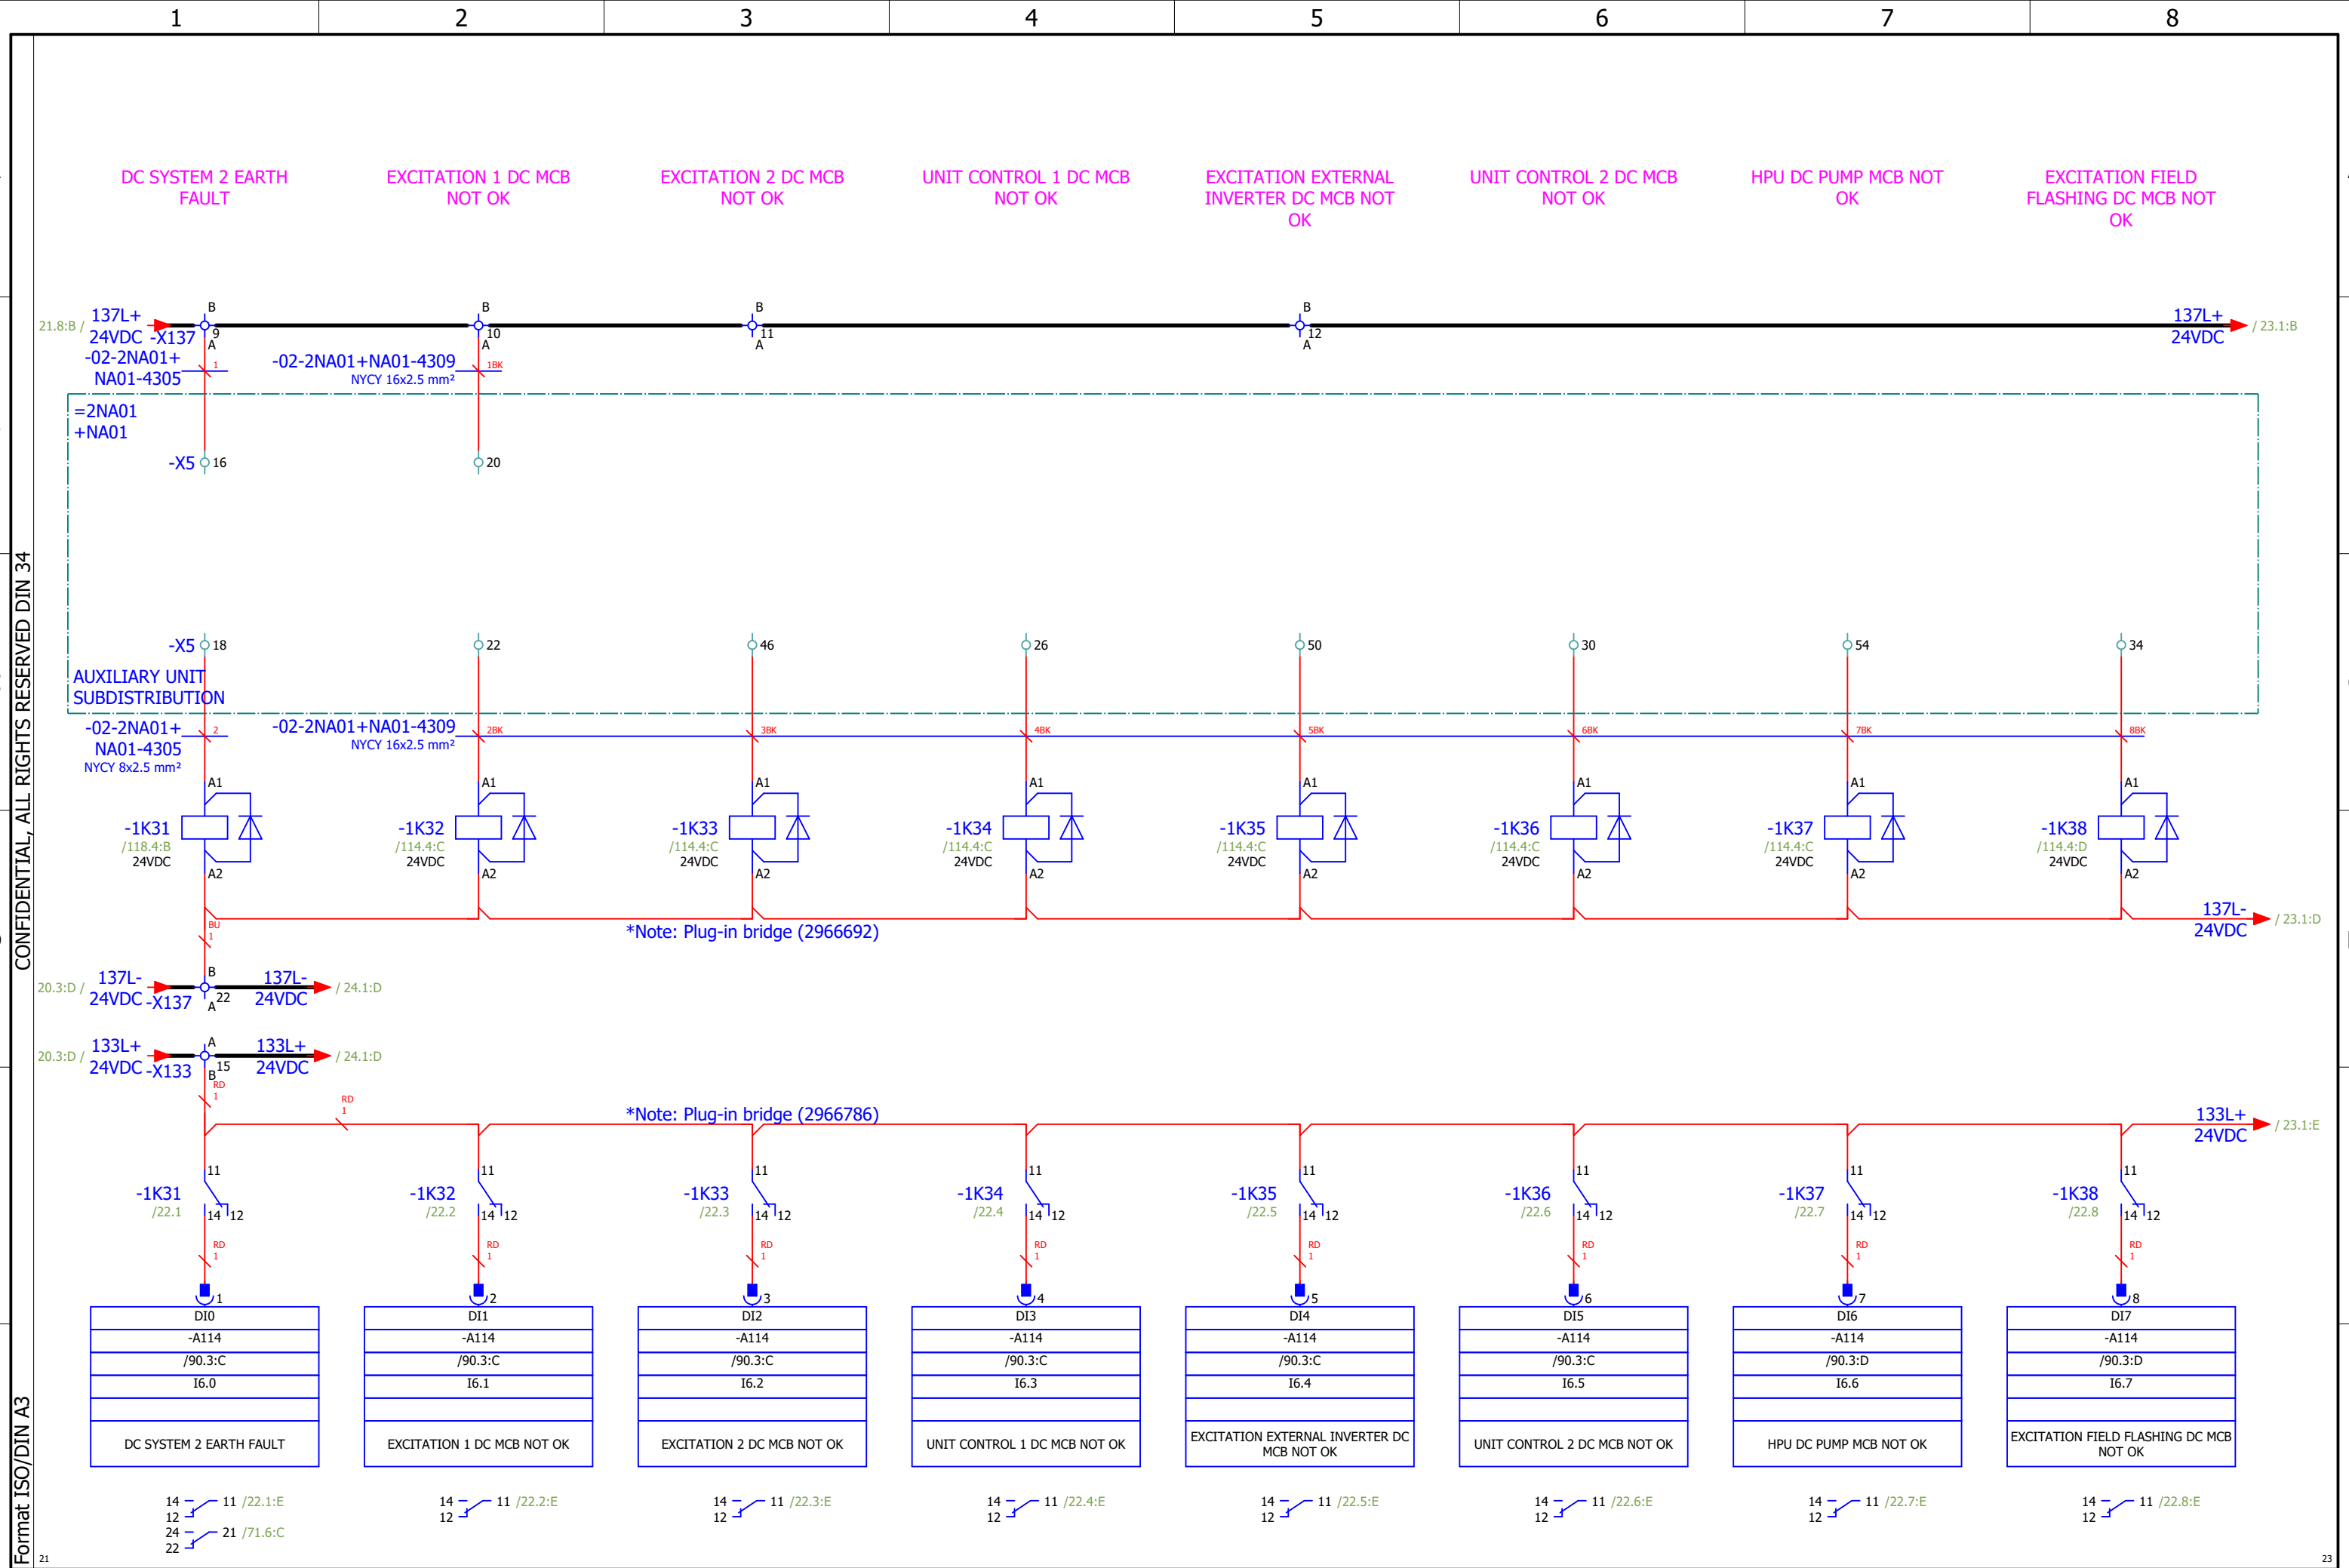

Approved by Contractor			Reconstruction and Modernisation of HPP Perucica - Phase II		 A Voith Company	Unit KA2 control cubicle circuit diagrams	DRAWING No.: PERU-01-19-170-31-002	REV No.: 02	= UBCJA10GH100
Approved by Designer	Grga Kolić	01.10.2026.			Sintaksa - A Voith Company Ulica Domovinskog rata 104C, 21 000 Split, Hrvatska	DIGITAL INPUTS: 6.0 - 6.7	Designer No.:	SALES No.:	+ UBCJA10
Checked by	Antonio Aleksić	01.10.2026.	PROJECT NAME	EMPLOYER	DESIGNER				PAGE 22
Drawn by	Tamara Trogrlić	01.10.2026.							PAGE 22 / 157

A

1

B

1

C

1

D

1

E


1

F

1

CONFIDENTIAL, ALL RIGHTS RESERVED DIN 34

Format ISO/DIN A3

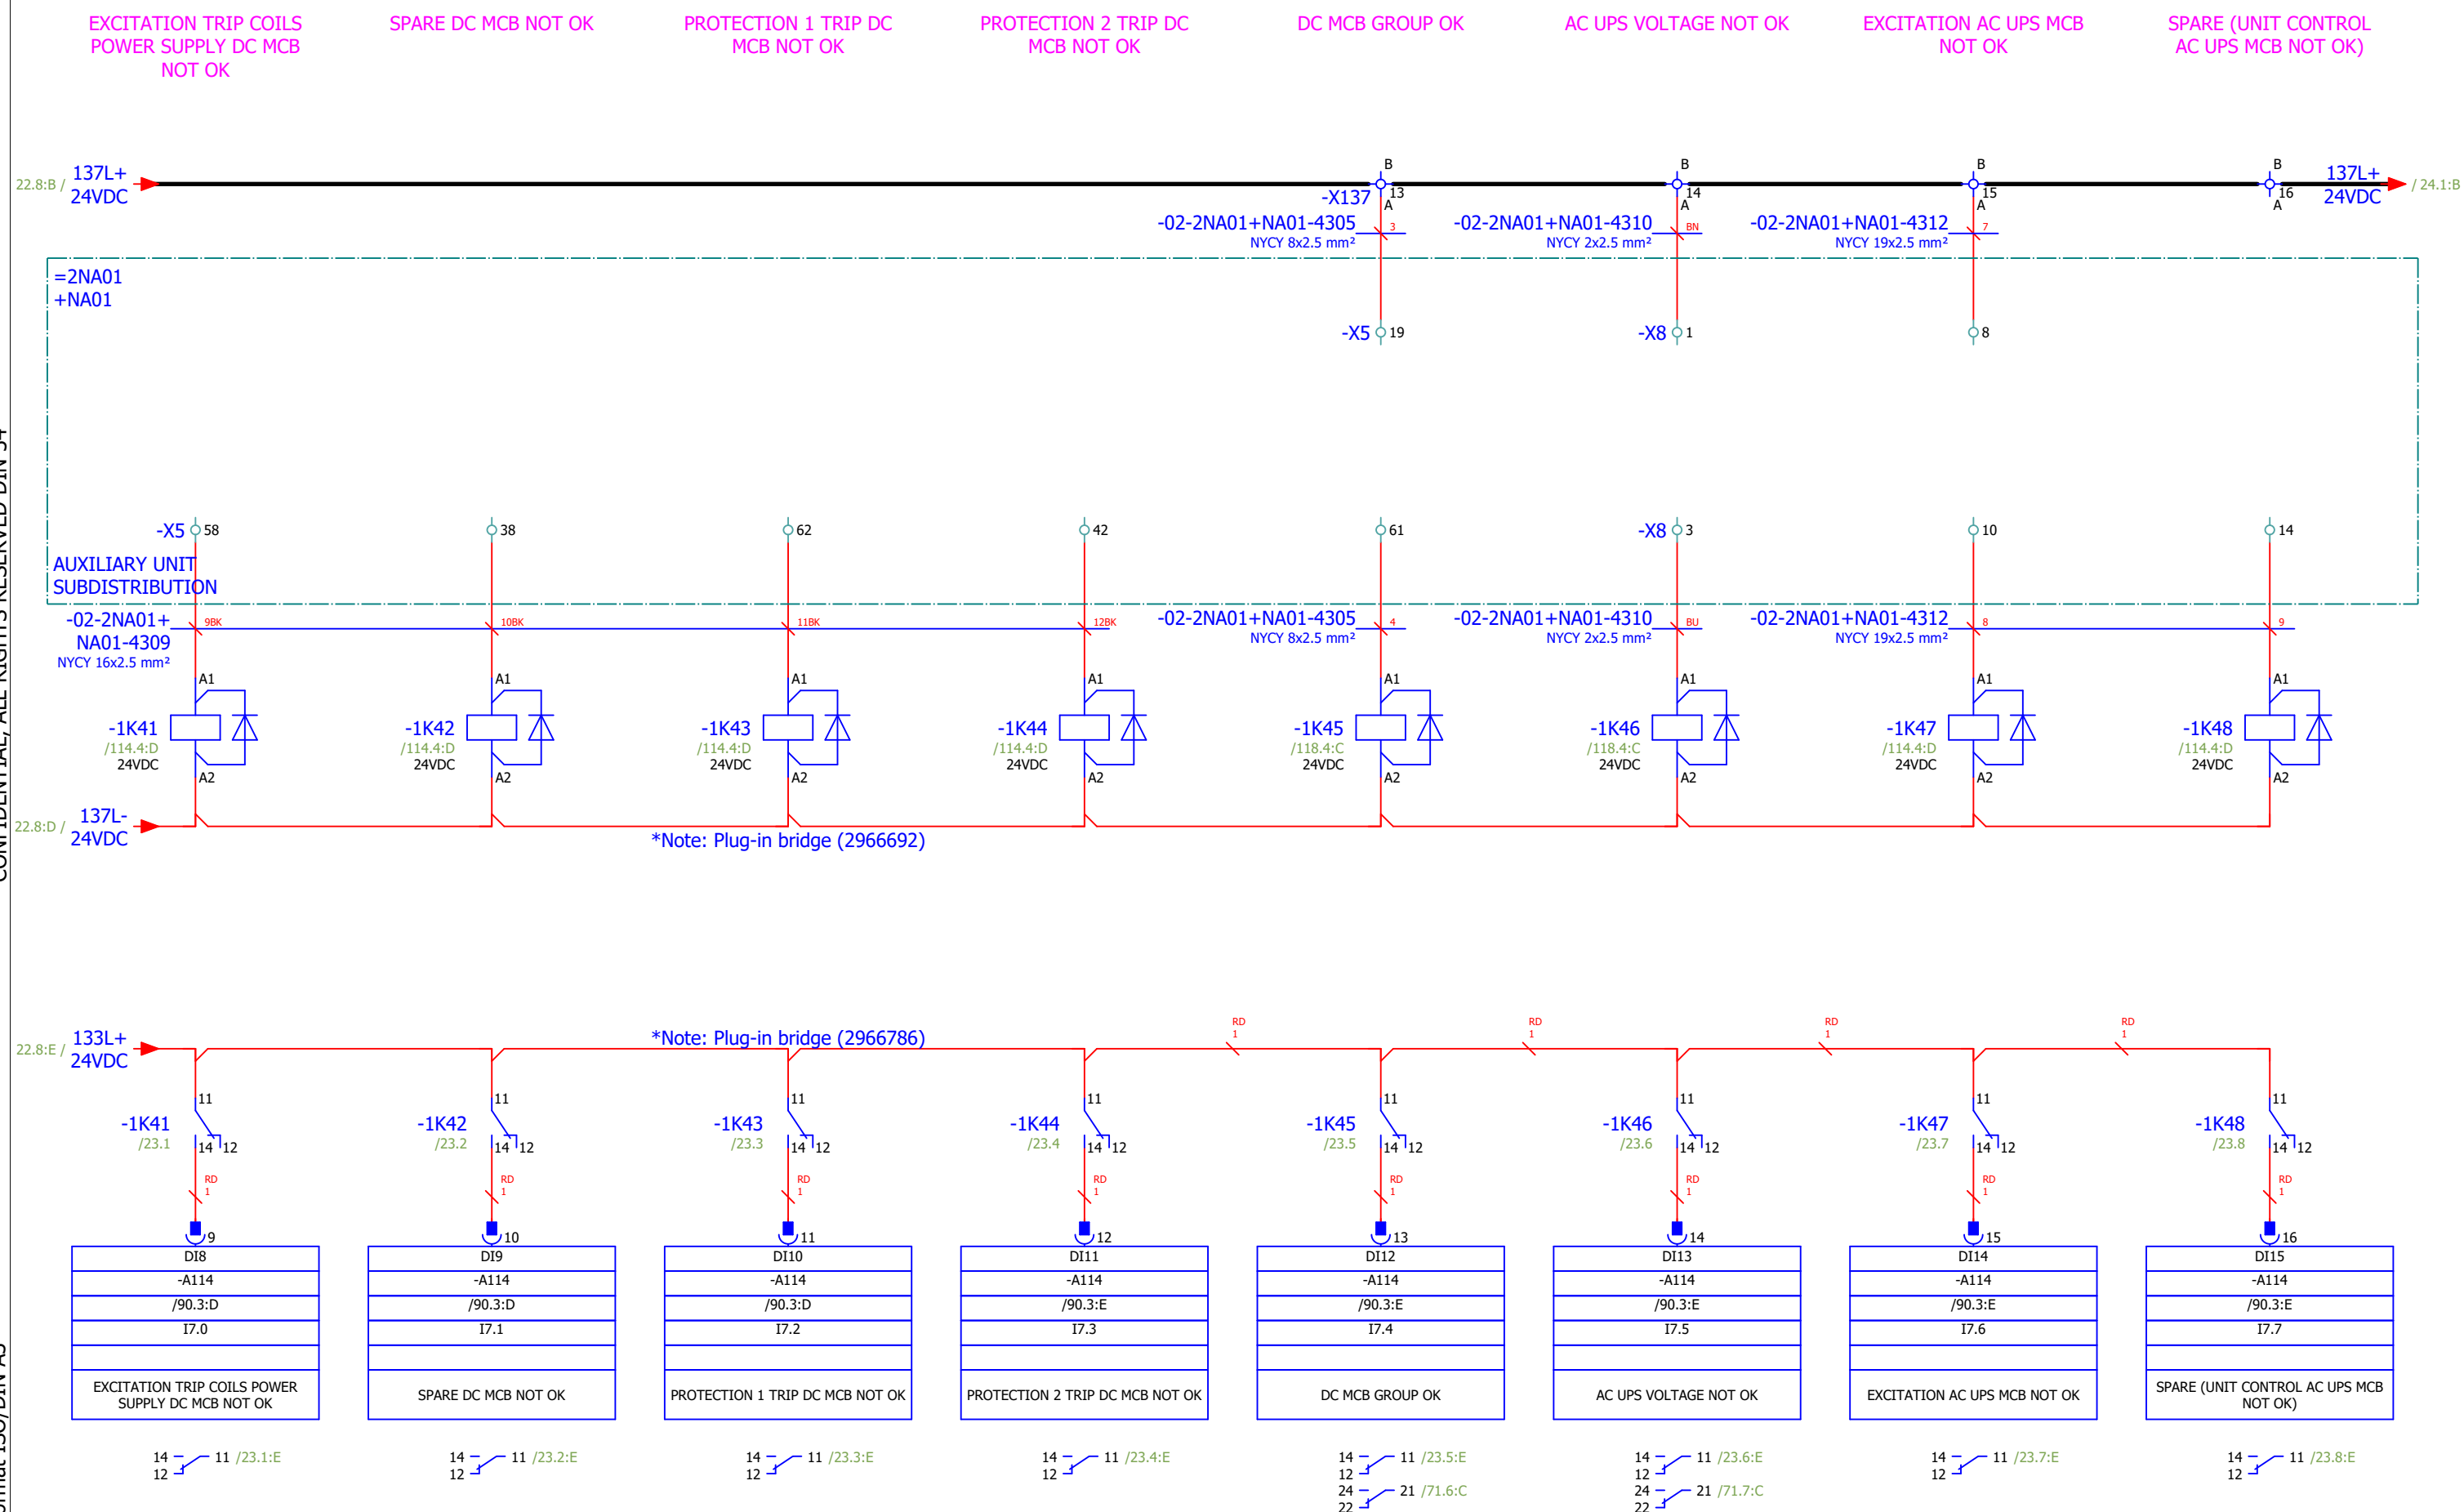

Approved by Contractor			Reconstruction and Modernisation of HPP Perucica - Phase II		 SINTAKSA <i>A Voith Company</i>	Unit KA2 control cubicle circuit diagrams	DRAWING No.: PERU-01-19-170-31-002	REV No.: 02	= UBCJA10GH100 + UBCJA10
Approved by Designer	Grga Kolić	01.10.2026.							
Checked by	Antonio Aleksić	01.10.2026.							
Drawn by	Tamara Trogrlić	01.10.2026.	PROJECT NAME	EMPLOYER	DESIGNER	DIGITAL INPUTS: 7.0 - 7.7	Designer No.:	SALES No.:	PAGE 23 / 157


CONFIDENTIAL, ALL RIGHTS RESERVED DIN 34


Format ISO/DIN A3

23

25

Approved by Contractor			Reconstruction and Modernisation of HPP Perucica - Phase II		 A Voith Company	Unit KA2 control cubicle circuit diagrams	DRAWING No.: PERU-01-19-170-31-002	REV No.: 02	= UBCJA10GH100
Approved by Designer	Grga Kolić	01.10.2026.			Sintaksa - A Voith Company Ulica Domovinskog rata 104C, 21 000 Split, Hrvatska	DIGITAL INPUTS: 8.0 - 8.7	Designer No.:	SALES No.:	+ UBCJA10
Checked by	Antonio Aleksić	01.10.2026.	PROJECT NAME	EMPLOYER	DESIGNER				PAGE 24
Drawn by	Tamara Trogrlić	01.10.2026.							PAGE 24 / 157

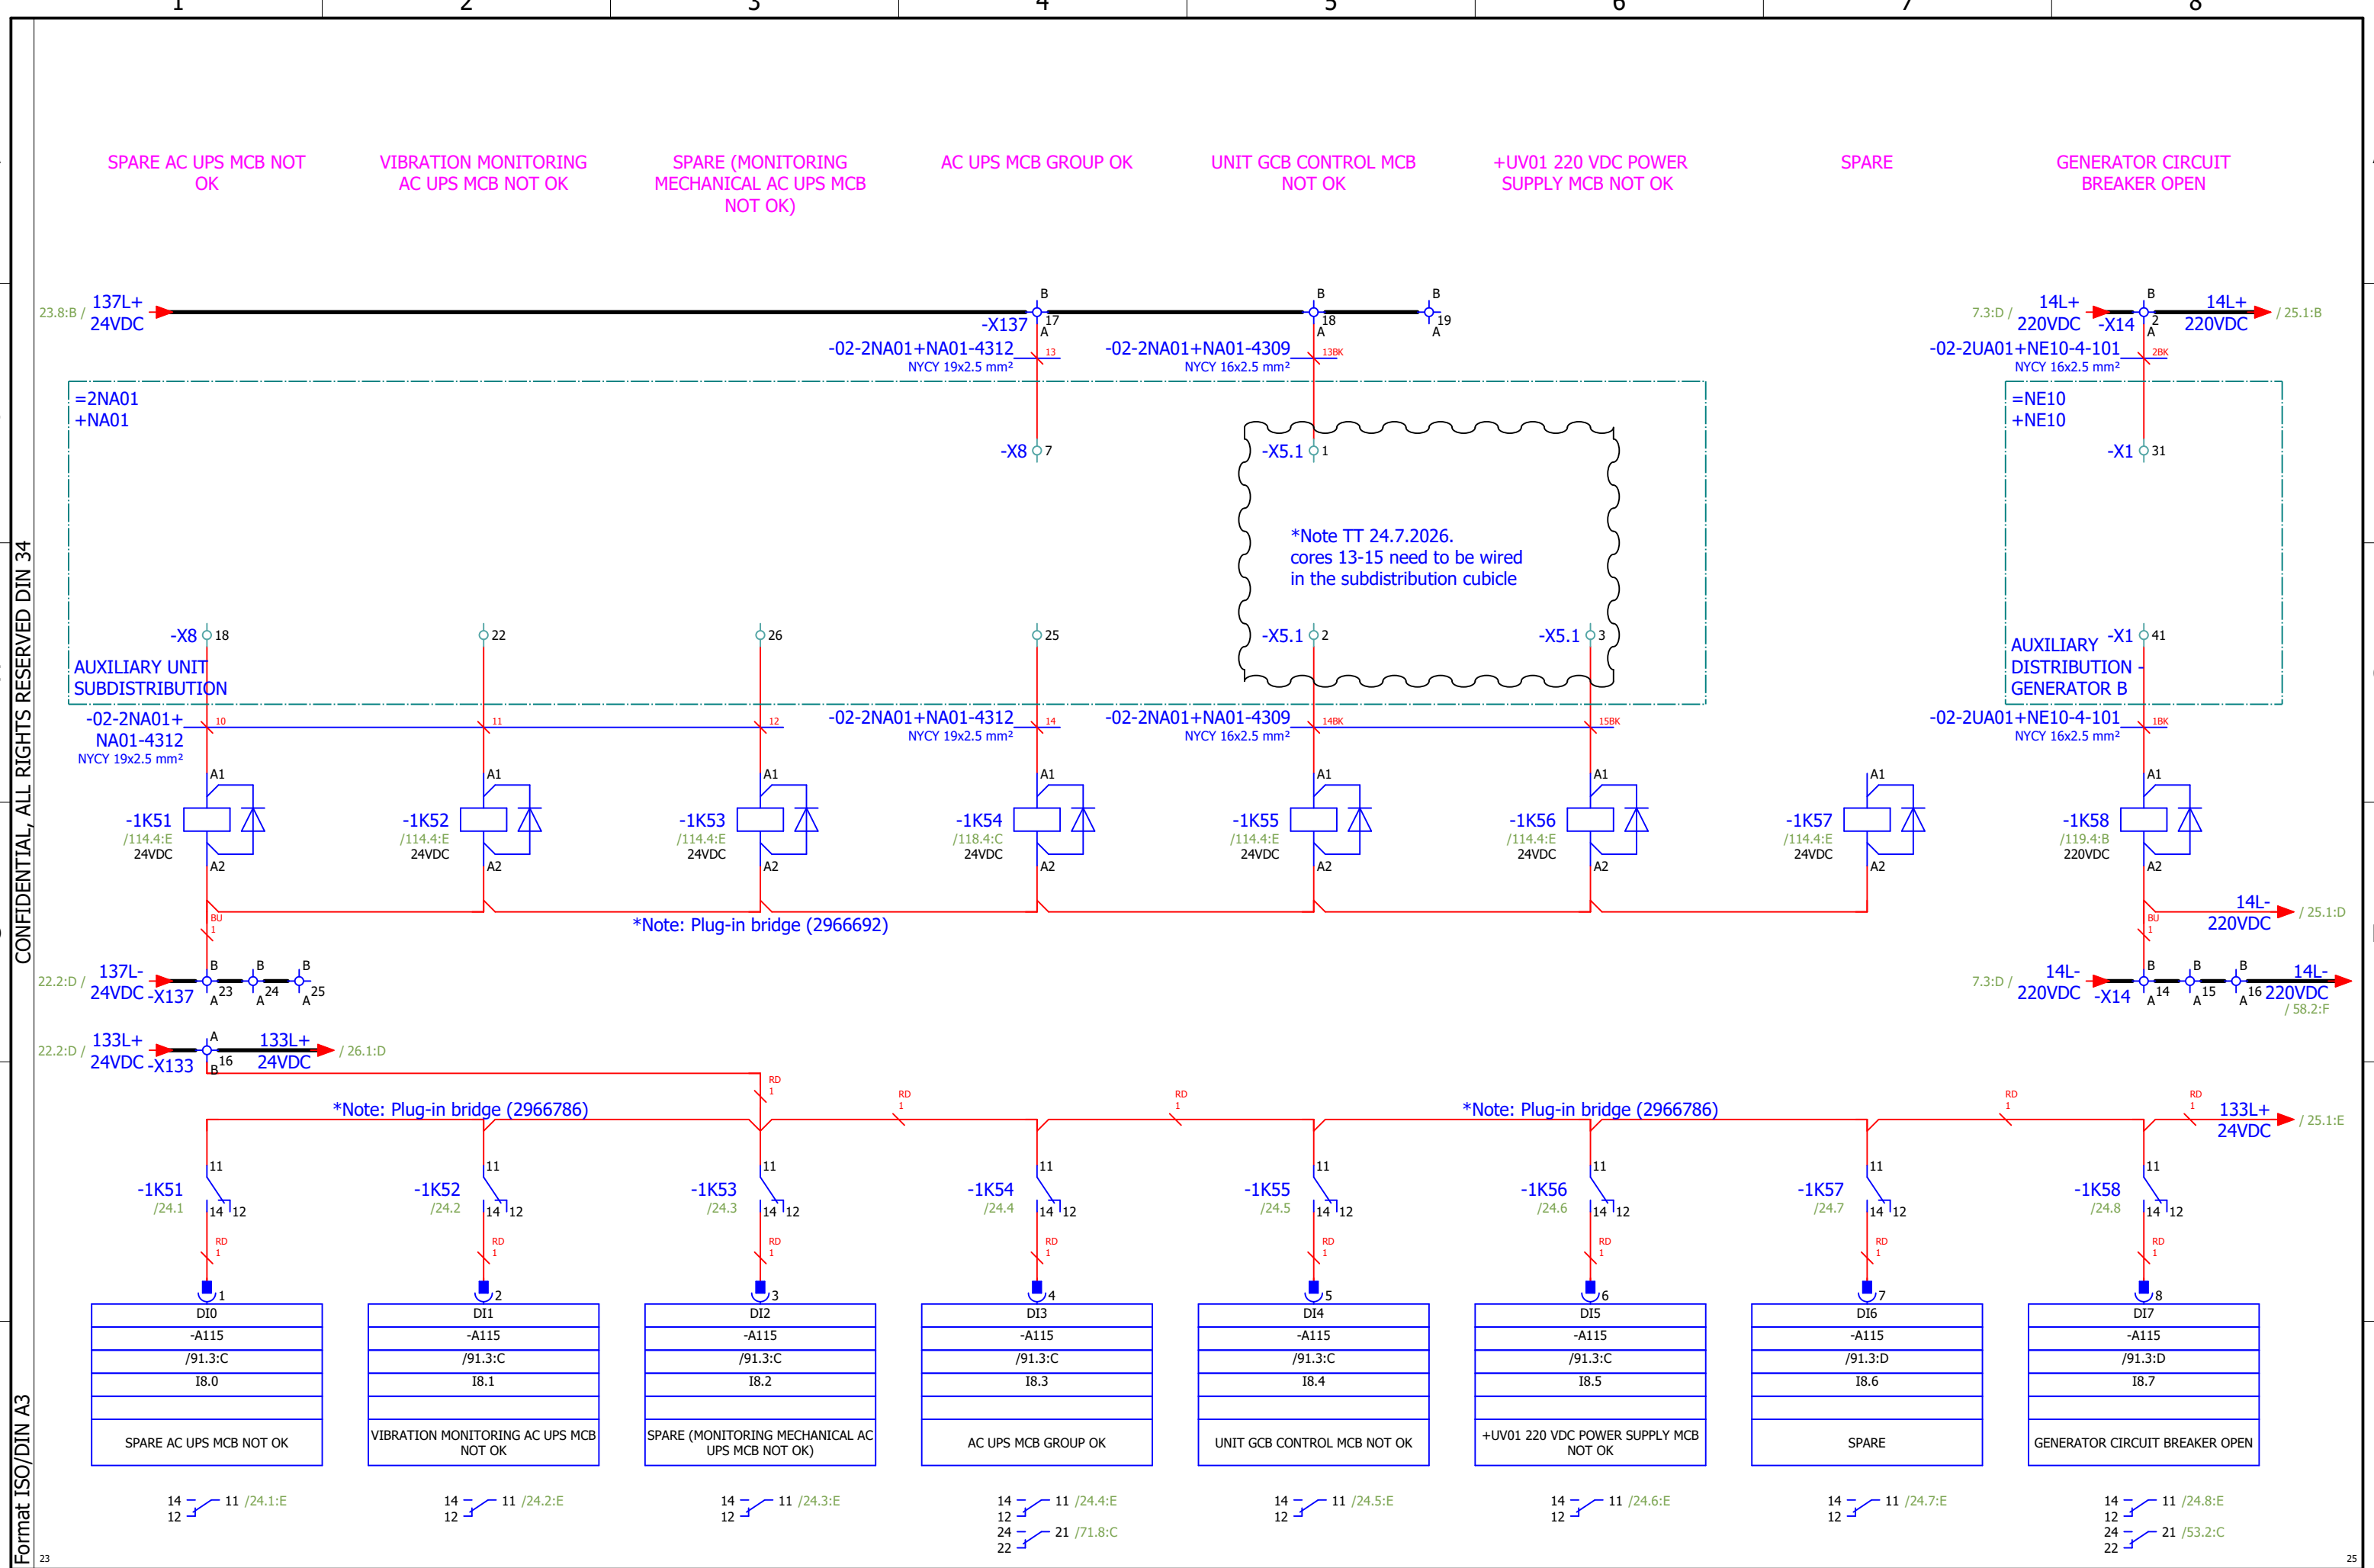

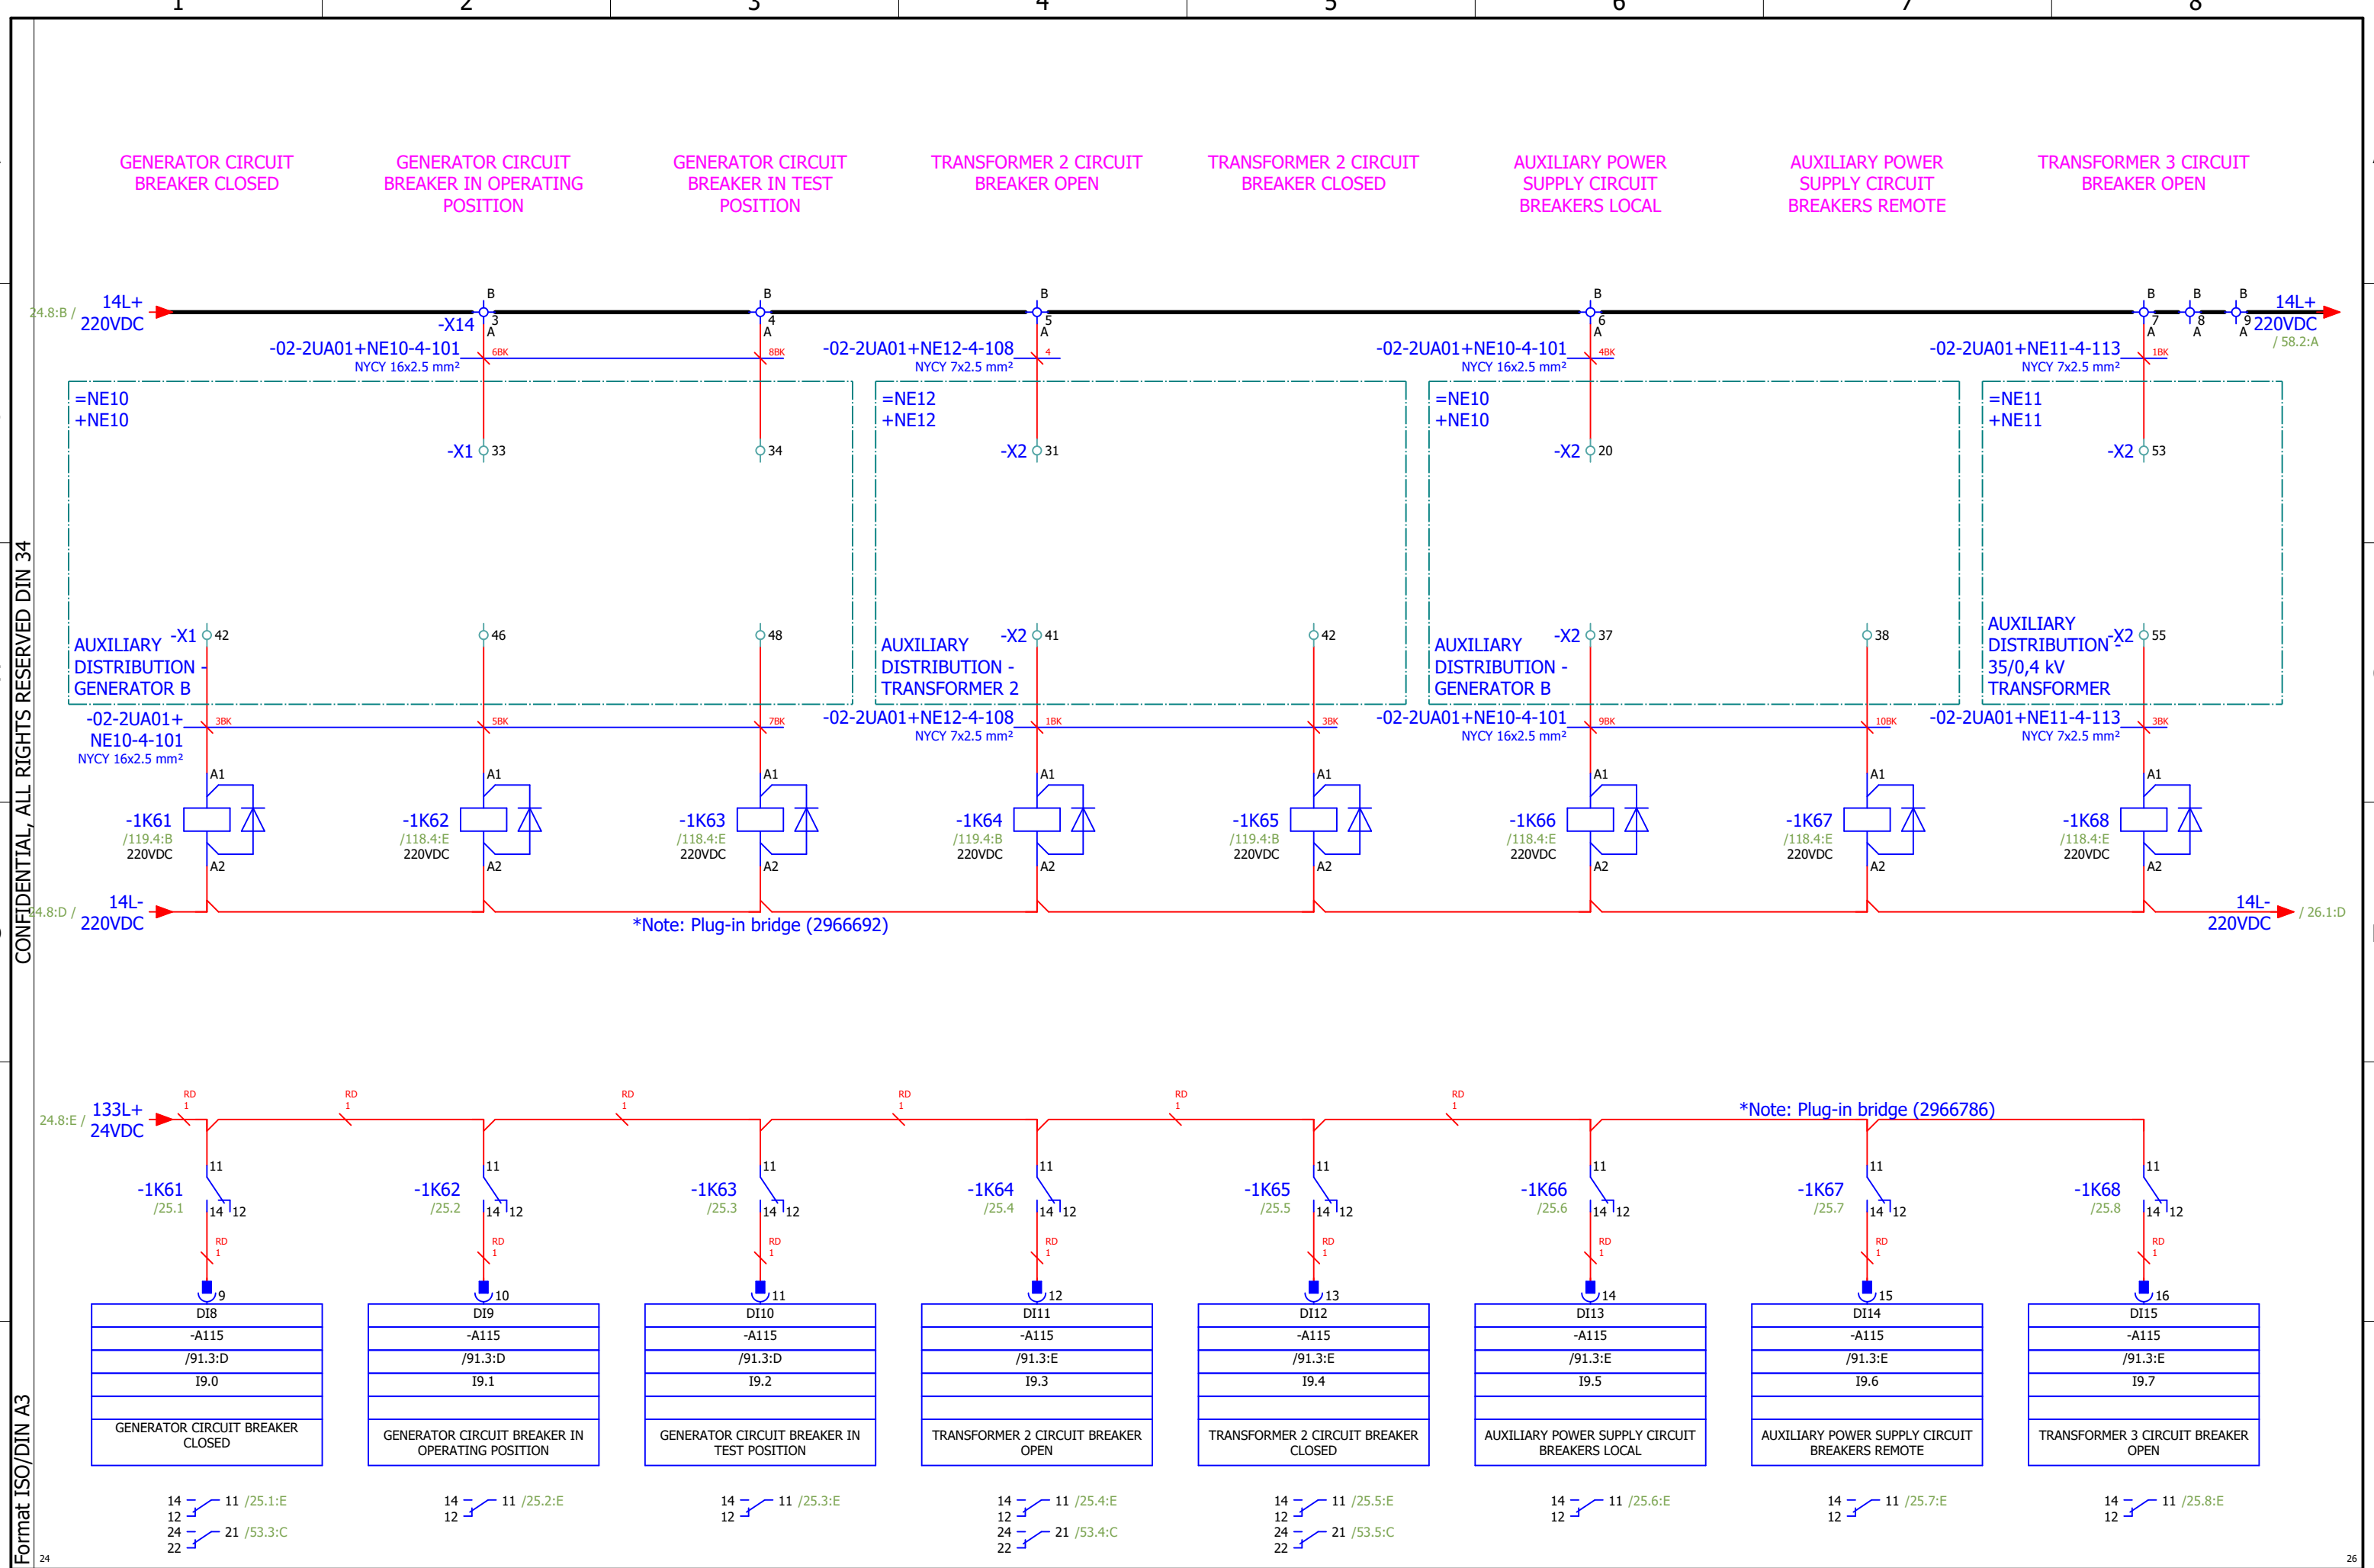

Approved by Contractor			Reconstruction and Modernisation of HPP Perucica - Phase II		SINTAKSA A Voith Company	Unit KA2 control cubicle circuit diagrams	DRAWING No.: PERU-01-19-170-31-002	REV No.: 02	= UBCJA10GH100
Approved by Designer	Grga Kolić	01.10.2026.			Sintaksa - A Voith Company Ulica Domovinskog rata 104C, 21 000 Split, Hrvatska	DIGITAL INPUTS: 9.0 - 9.7	Designer No.:	SALES No.:	+ UBCJA10
Checked by	Antonio Aleksić	01.10.2026.							PAGE 25
Drawn by	Tamara Trogrlić	01.10.2026.	PROJECT NAME	EMPLOYER	DESIGNER				PAGE 25 / 157

CONFIDENTIAL, ALL RIGHTS RESERVED DIN 34

Format ISO/DIN A3

25

Approved by Contractor			Reconstruction and Modernisation of HPP Perucica - Phase II		 A Voith Company	Unit KA2 control cubicle circuit diagrams	DRAWING No.: PERU-01-19-170-31-002	REV No.: 02	= UBCJA10GH100
Approved by Designer	Grga Kolić	01.10.2026.			Sintaksa - A Voith Company Ulica Domovinskog rata 104C, 21 000 Split, Hrvatska	DIGITAL INPUTS: 10.0 - 10.7	Designer No.:	SALES No.:	+ UBCJA10
Checked by	Antonio Aleksić	01.10.2026.							PAGE 26
Drawn by	Tamara Trogrlić	01.10.2026.	PROJECT NAME	EMPLOYER	DESIGNER				PAGE 26 / 157

1 2 3 4 5 6 7 8

A

B

C

D

E

F

A

B

C

D

E

F

TRANSFORMER 3 CIRCUIT
BREAKER CLOSED

SPARE

SPARE




SPARE

GENERATOR PROTECTION
TRIP EXCITATION

GENERATOR PROTECTION
SYSTEM FAULT

GENERATOR CIRCUIT
BREAKER PRIMARY
PROTECTION TRIP

GCB TCS NOT OK

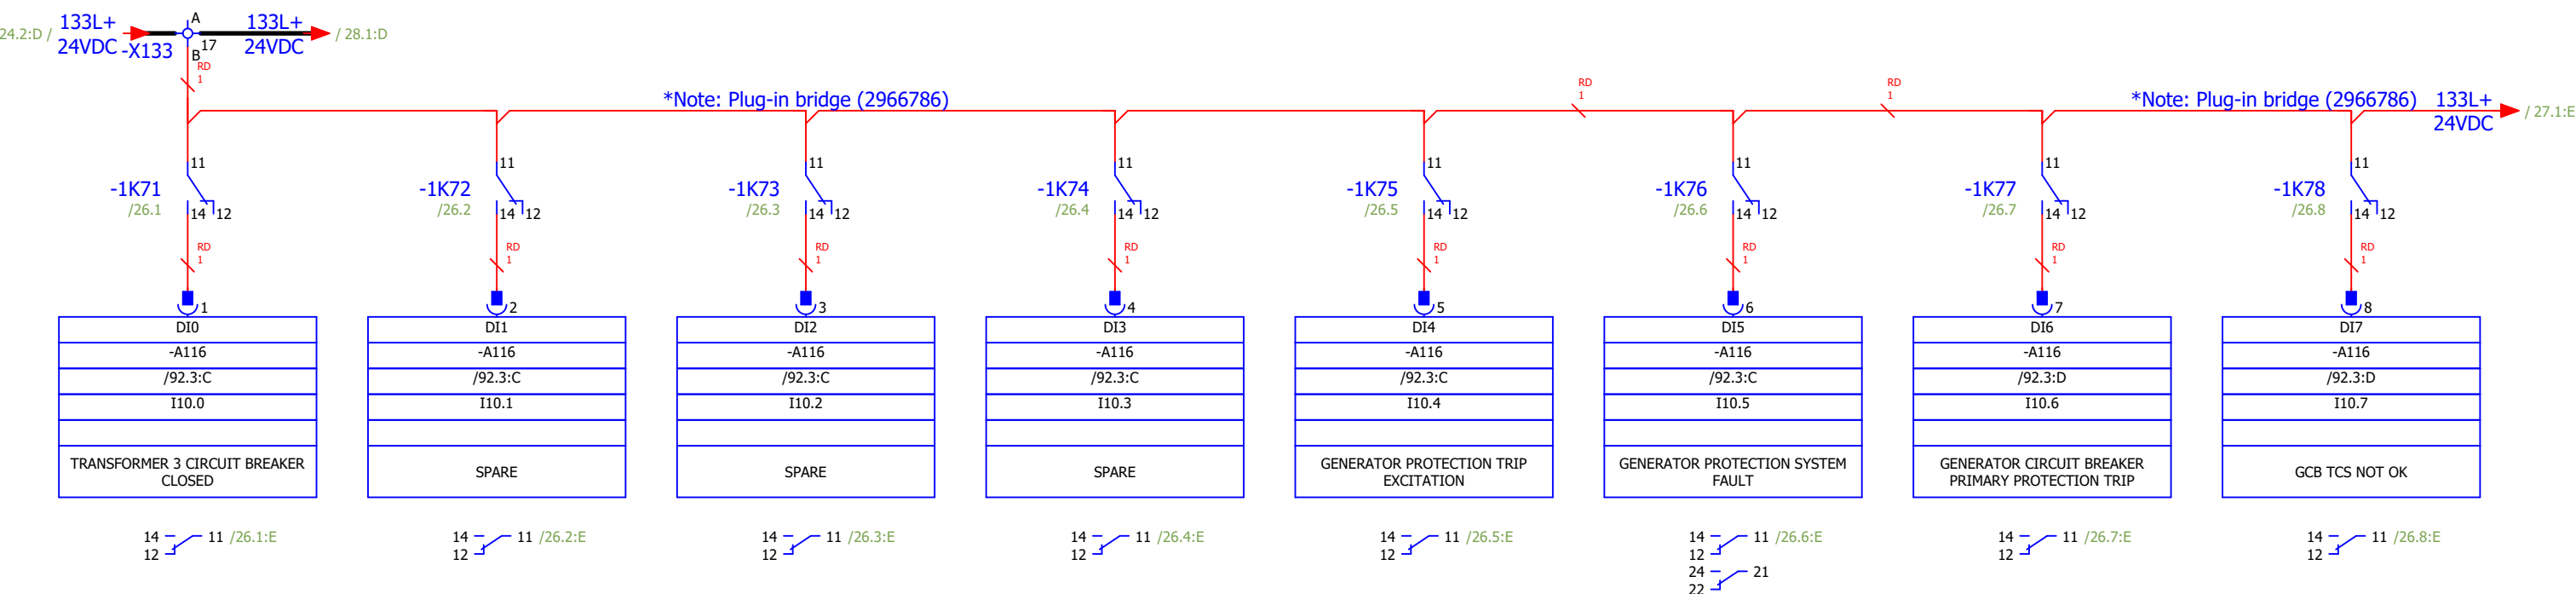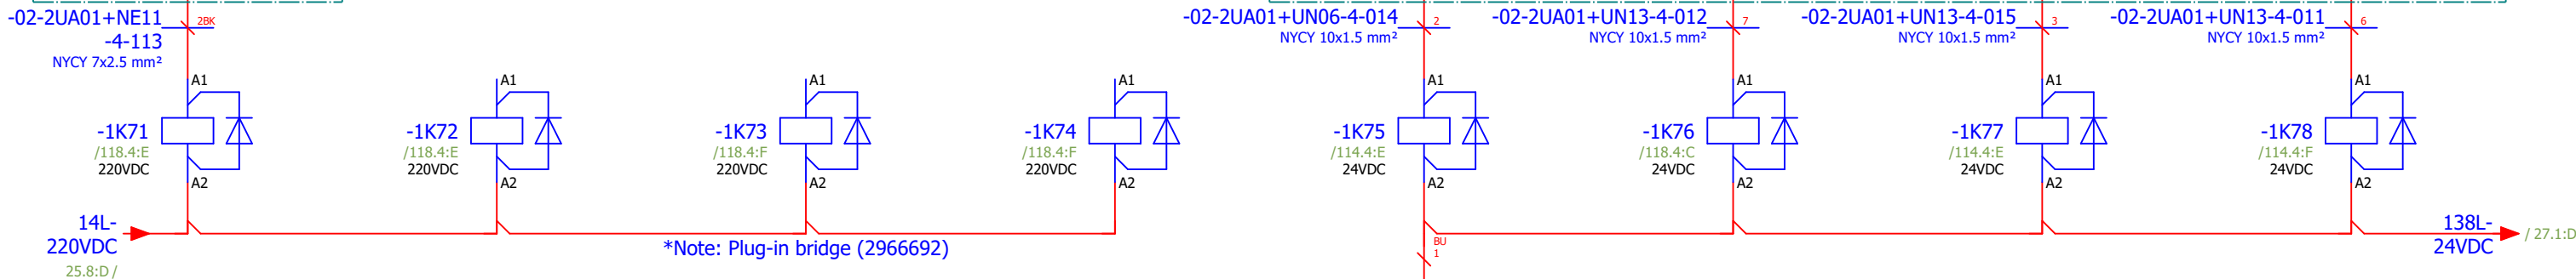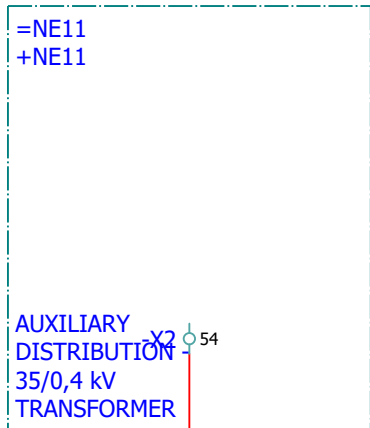

27


CONFIDENTIAL, ALL RIGHTS RESERVED DIN 34

Format ISO/DIN A3

26

28

Approved by Contractor			Reconstruction and Modernisation of HPP Perucica - Phase II		 A Voith Company Sintaksa - A Voith Company Ulica Domovinskog rata 104C, 21 000 Split, Hrvatska	Unit KA2 control cubicle circuit diagrams DIGITAL INPUTS: 11.0 - 11.7	DRAWING No.: PERU-01-19-170-31-002	REV No.: 02	= UBCJA10GH100 + UBCJA10
Approved by Designer	Grga Kolić	01.10.2026.					Designer No.:	SALES No.:	PAGE 27
Checked by	Antonio Aleksić	01.10.2026.							
Drawn by	Tamara Trogrlić	01.10.2026.							PAGE 27 / 157

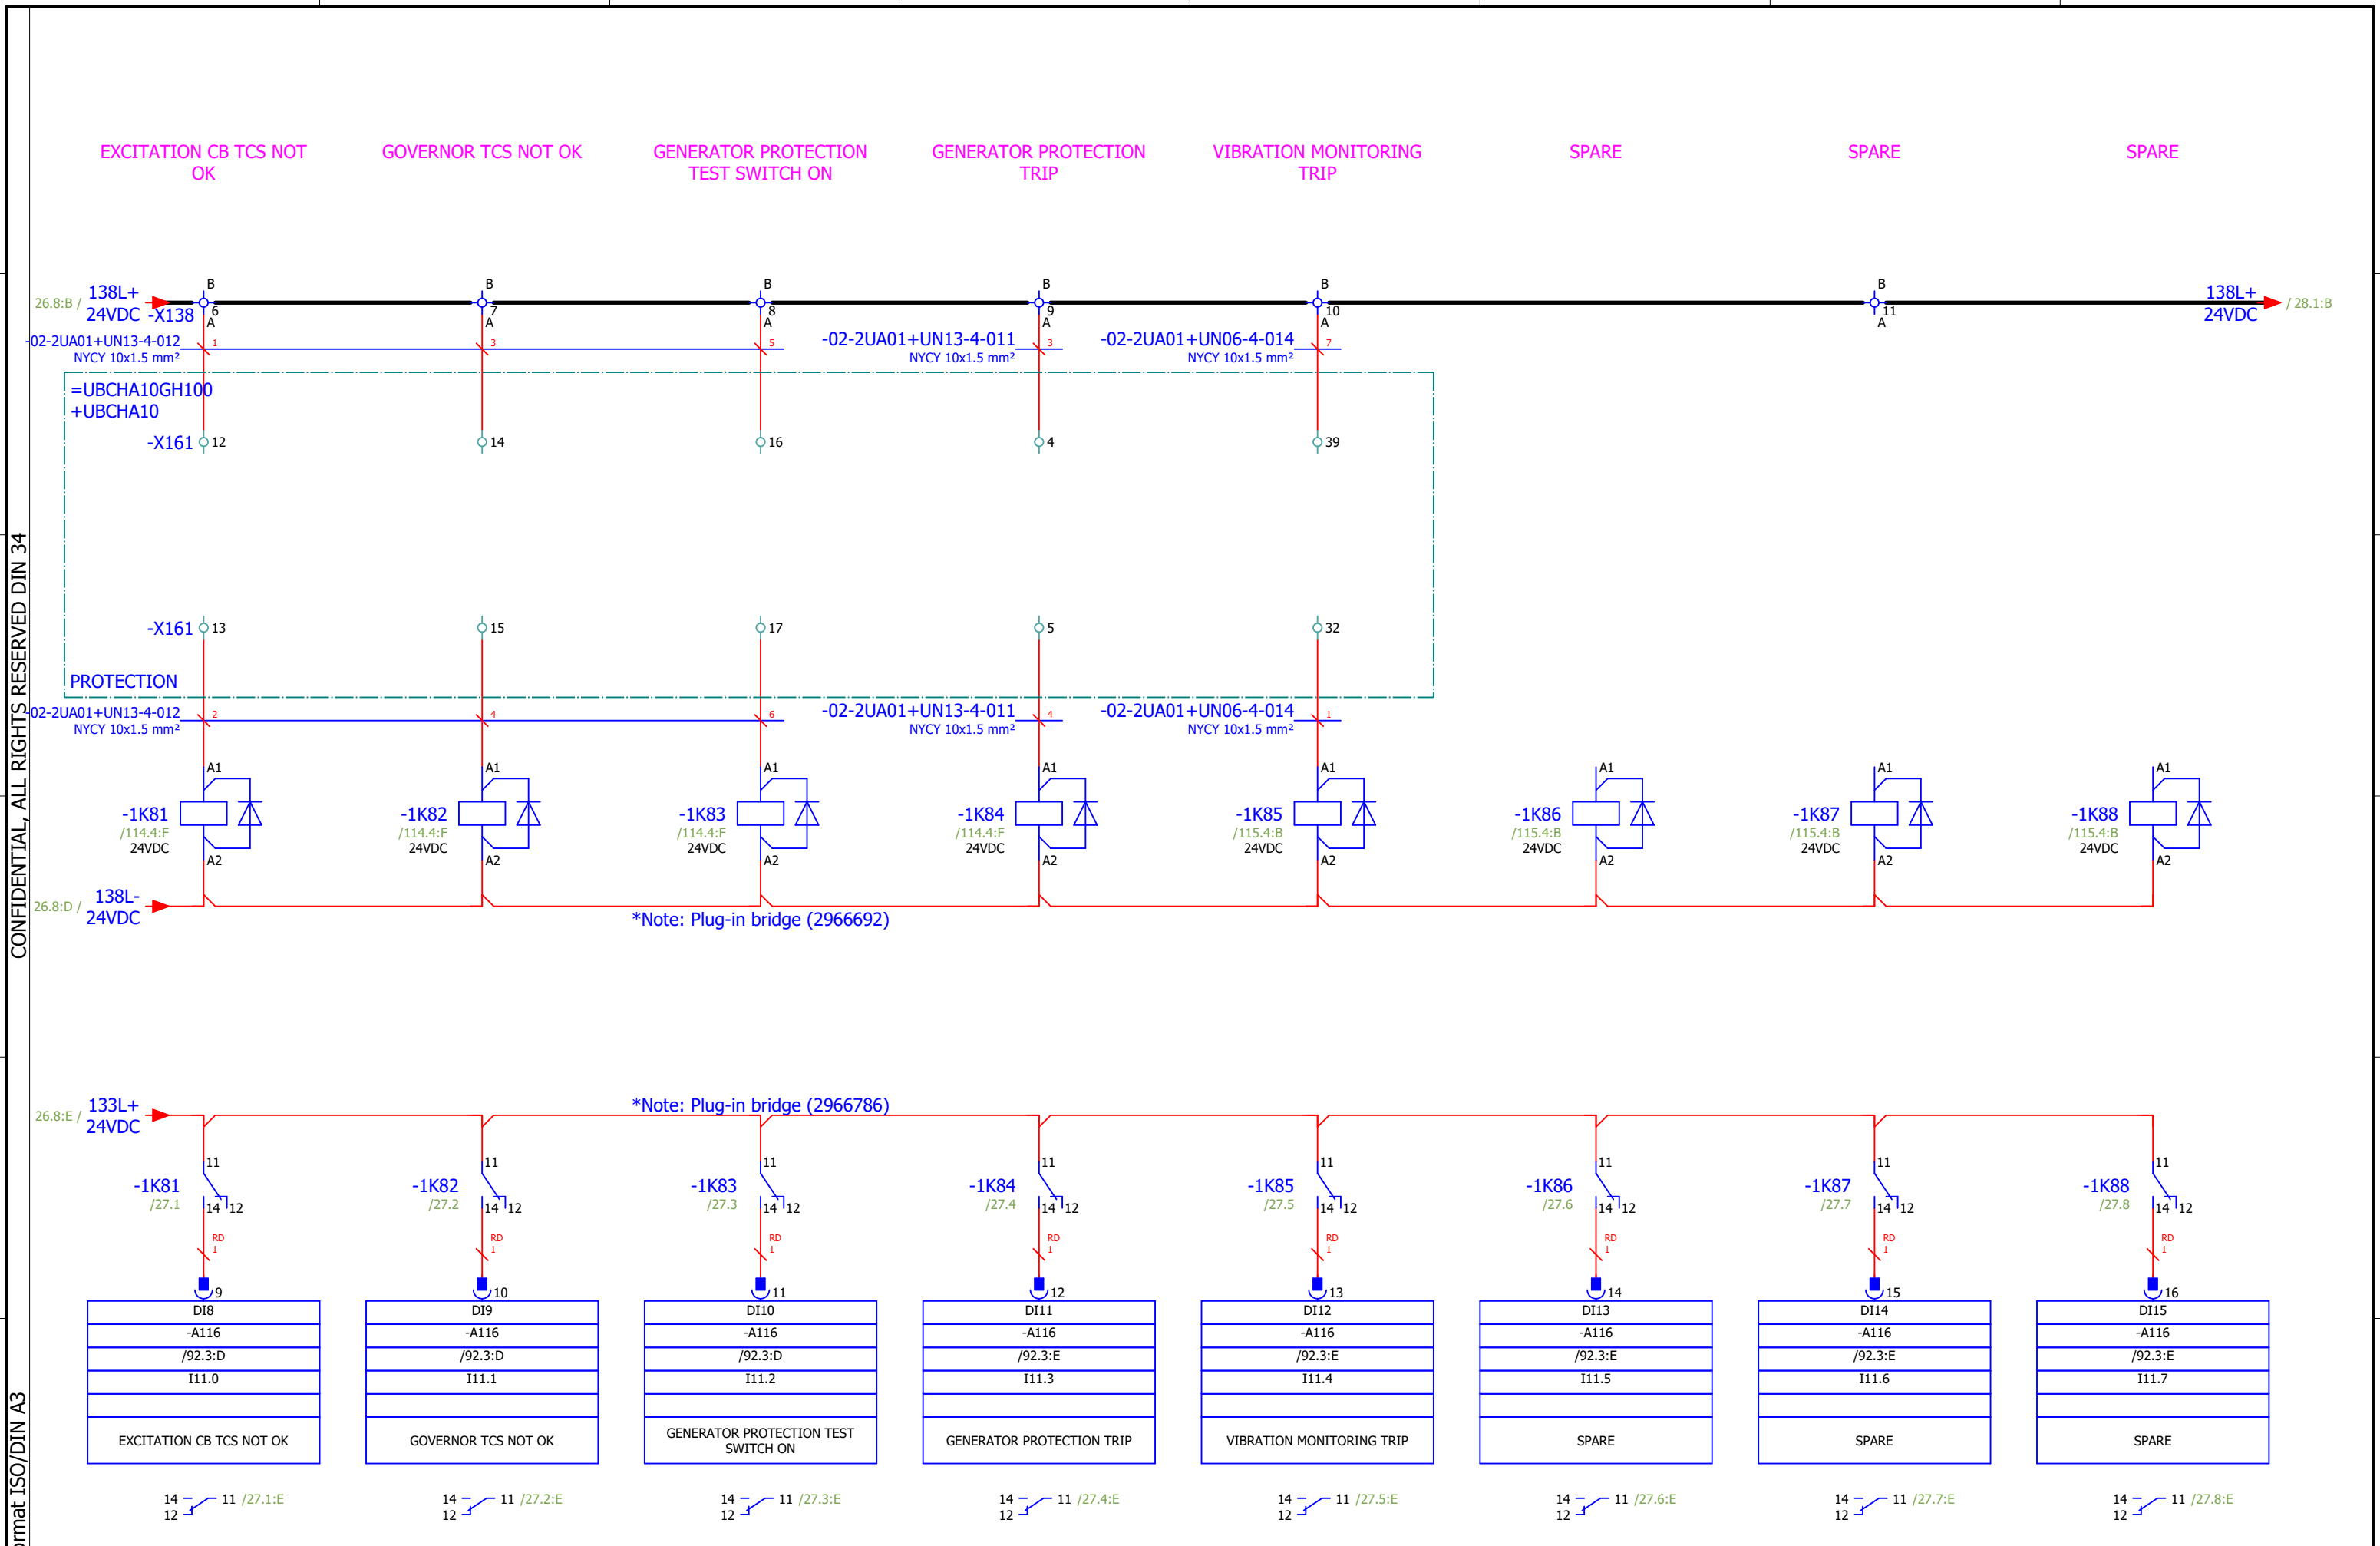

CONFIDENTIAL, ALL RIGHTS RESERVED DIN 34

Format ISO/DIN A3

27

29

Approved by Contractor			Reconstruction and Modernisation of HPP Perucica - Phase II		 A Voith Company	Unit KA2 control cubicle circuit diagrams	DRAWING No.: PERU-01-19-170-31-002	REV No.: 02	= UBCJA10GH100
Approved by Designer	Grga Kolić	01.10.2026.			Sintaksa - A Voith Company Ulica Domovinskog rata 104C, 21 000 Split, Hrvatska	DIGITAL INPUTS: 12.0 - 12.7	Designer No.:	SALES No.:	+ UBCJA10
Checked by	Antonio Aleksić	01.10.2026.							PAGE
Drawn by	Tamara Trogrlić	01.10.2026.	PROJECT NAME	EMPLOYER	DESIGNER				PAGE

1	2	3	4	5	6	7	8
---	---	---	---	---	---	---	---

A

B

C

D

E

F

A


B

C

D

E

F

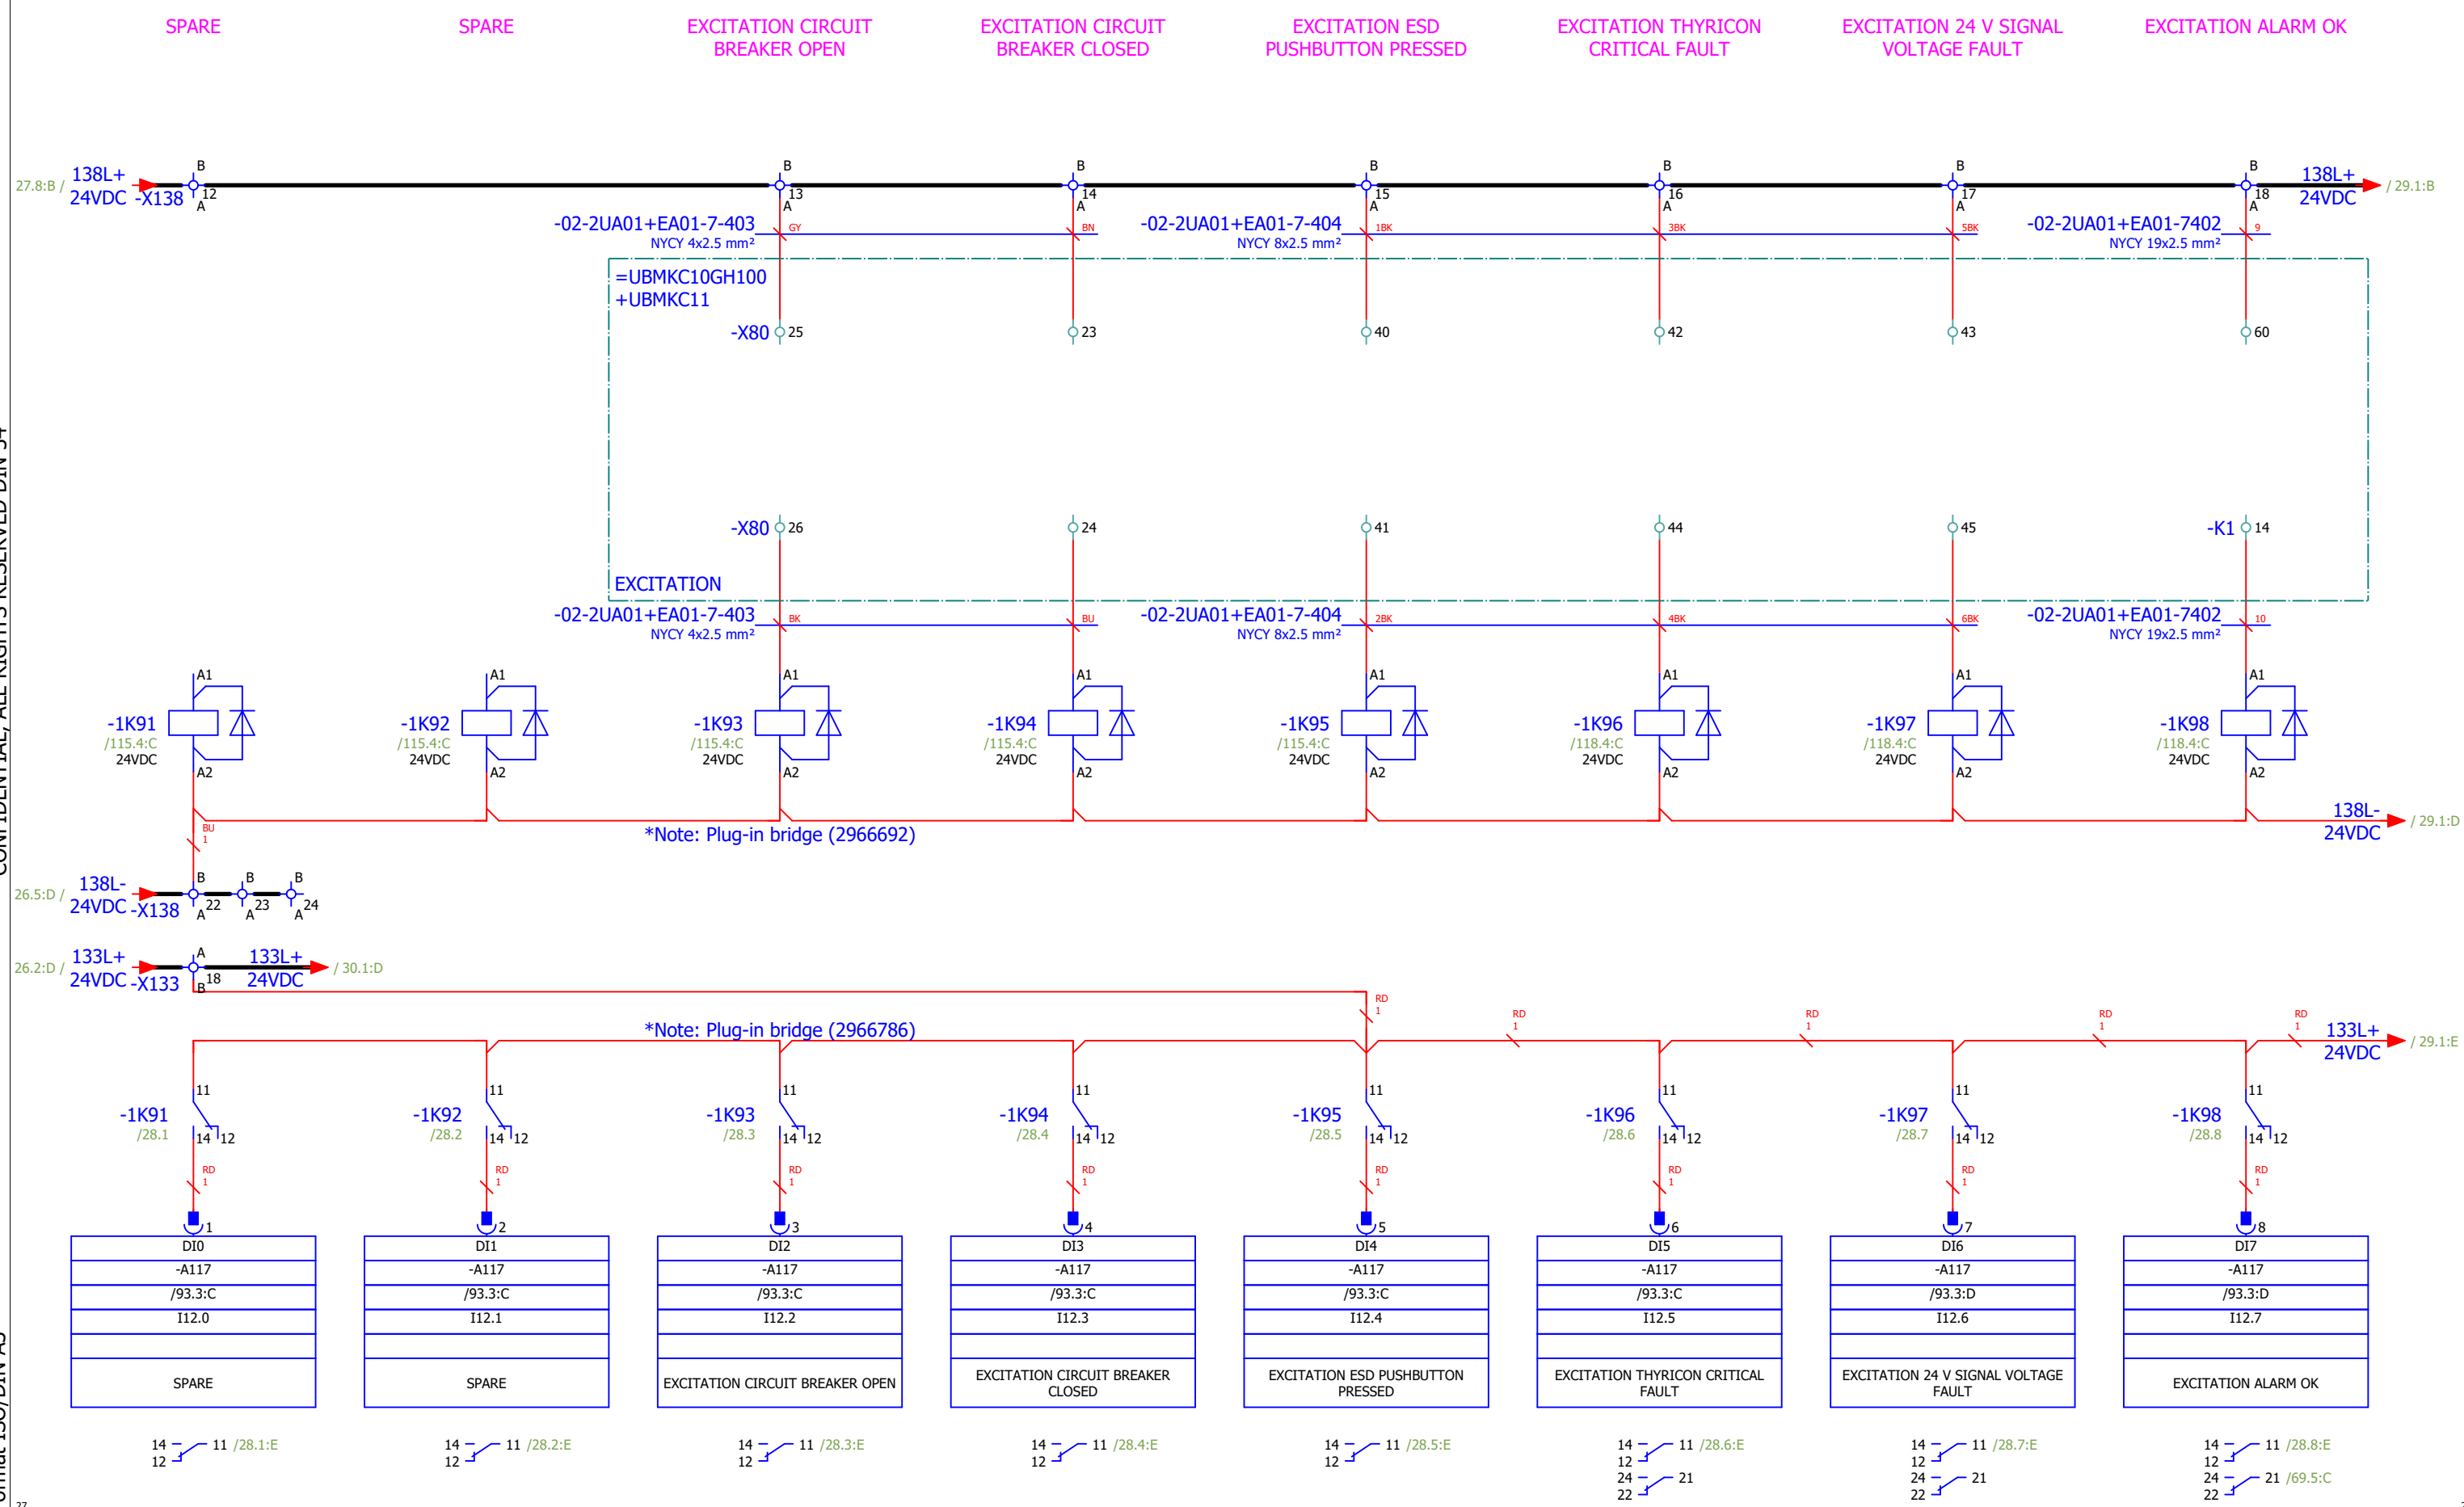

CONFIDENTIAL, ALL RIGHTS RESERVED DIN 34

Format ISO/DIN A3

28

Approved by Contractor			Reconstruction and Modernisation of HPP Perucica - Phase II		 A Voith Company Sintaksa - A Voith Company Ulica Domovinskog rata 104C, 21 000 Split, Hrvatska	Unit KA2 control cubicle circuit diagrams DIGITAL INPUTS: 13.0 - 13.7	DRAWING No.: PERU-01-19-170-31-002	REV No.: 02	= UBCJA10GH100
Approved by Designer	Grga Kolić	01.10.2026.					Designer No.:	SALES No.:	+ UBCJA10
Checked by	Antonio Aleksić	01.10.2026.							PAGE 29
Drawn by	Tamara Trogrlić	01.10.2026.							PAGE 29 / 157

1	2	3	4	5	6	7	8
---	---	---	---	---	---	---	---

A

B

C

D

E

F

A


B

C

D

E

F

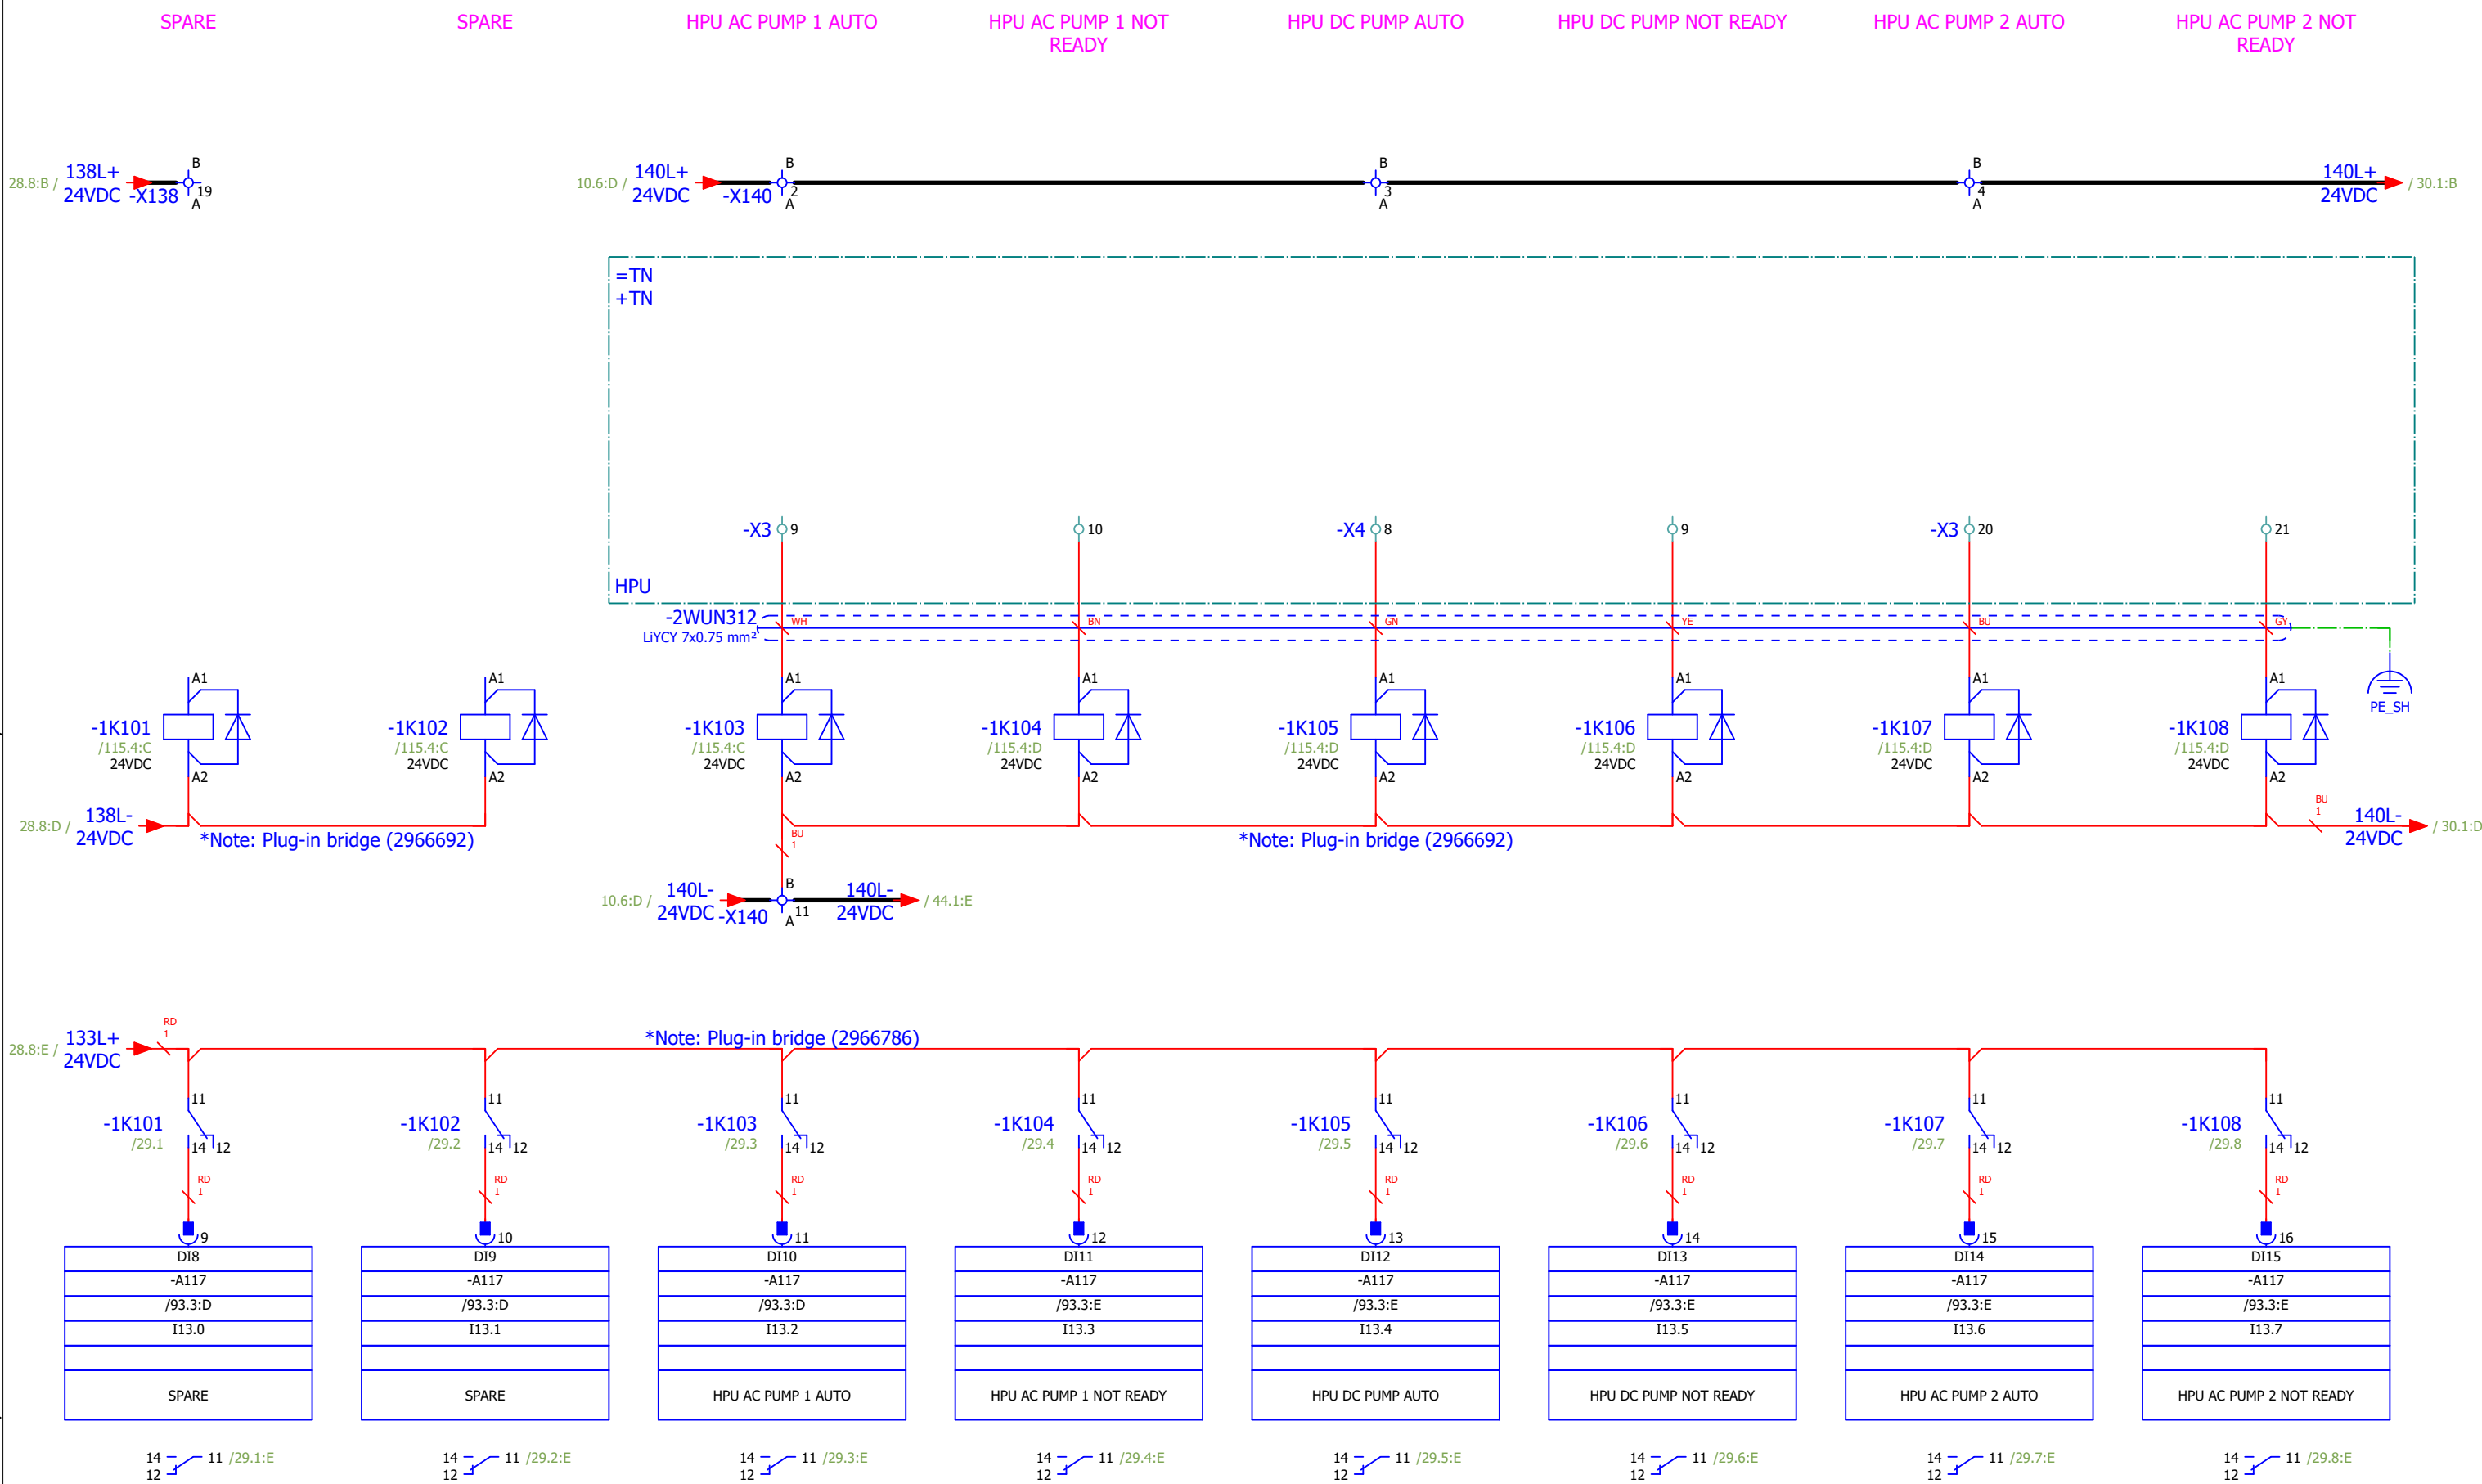


30

CONFIDENTIAL, ALL RIGHTS RESERVED DIN 34

Format ISO/DIN A3

29

31

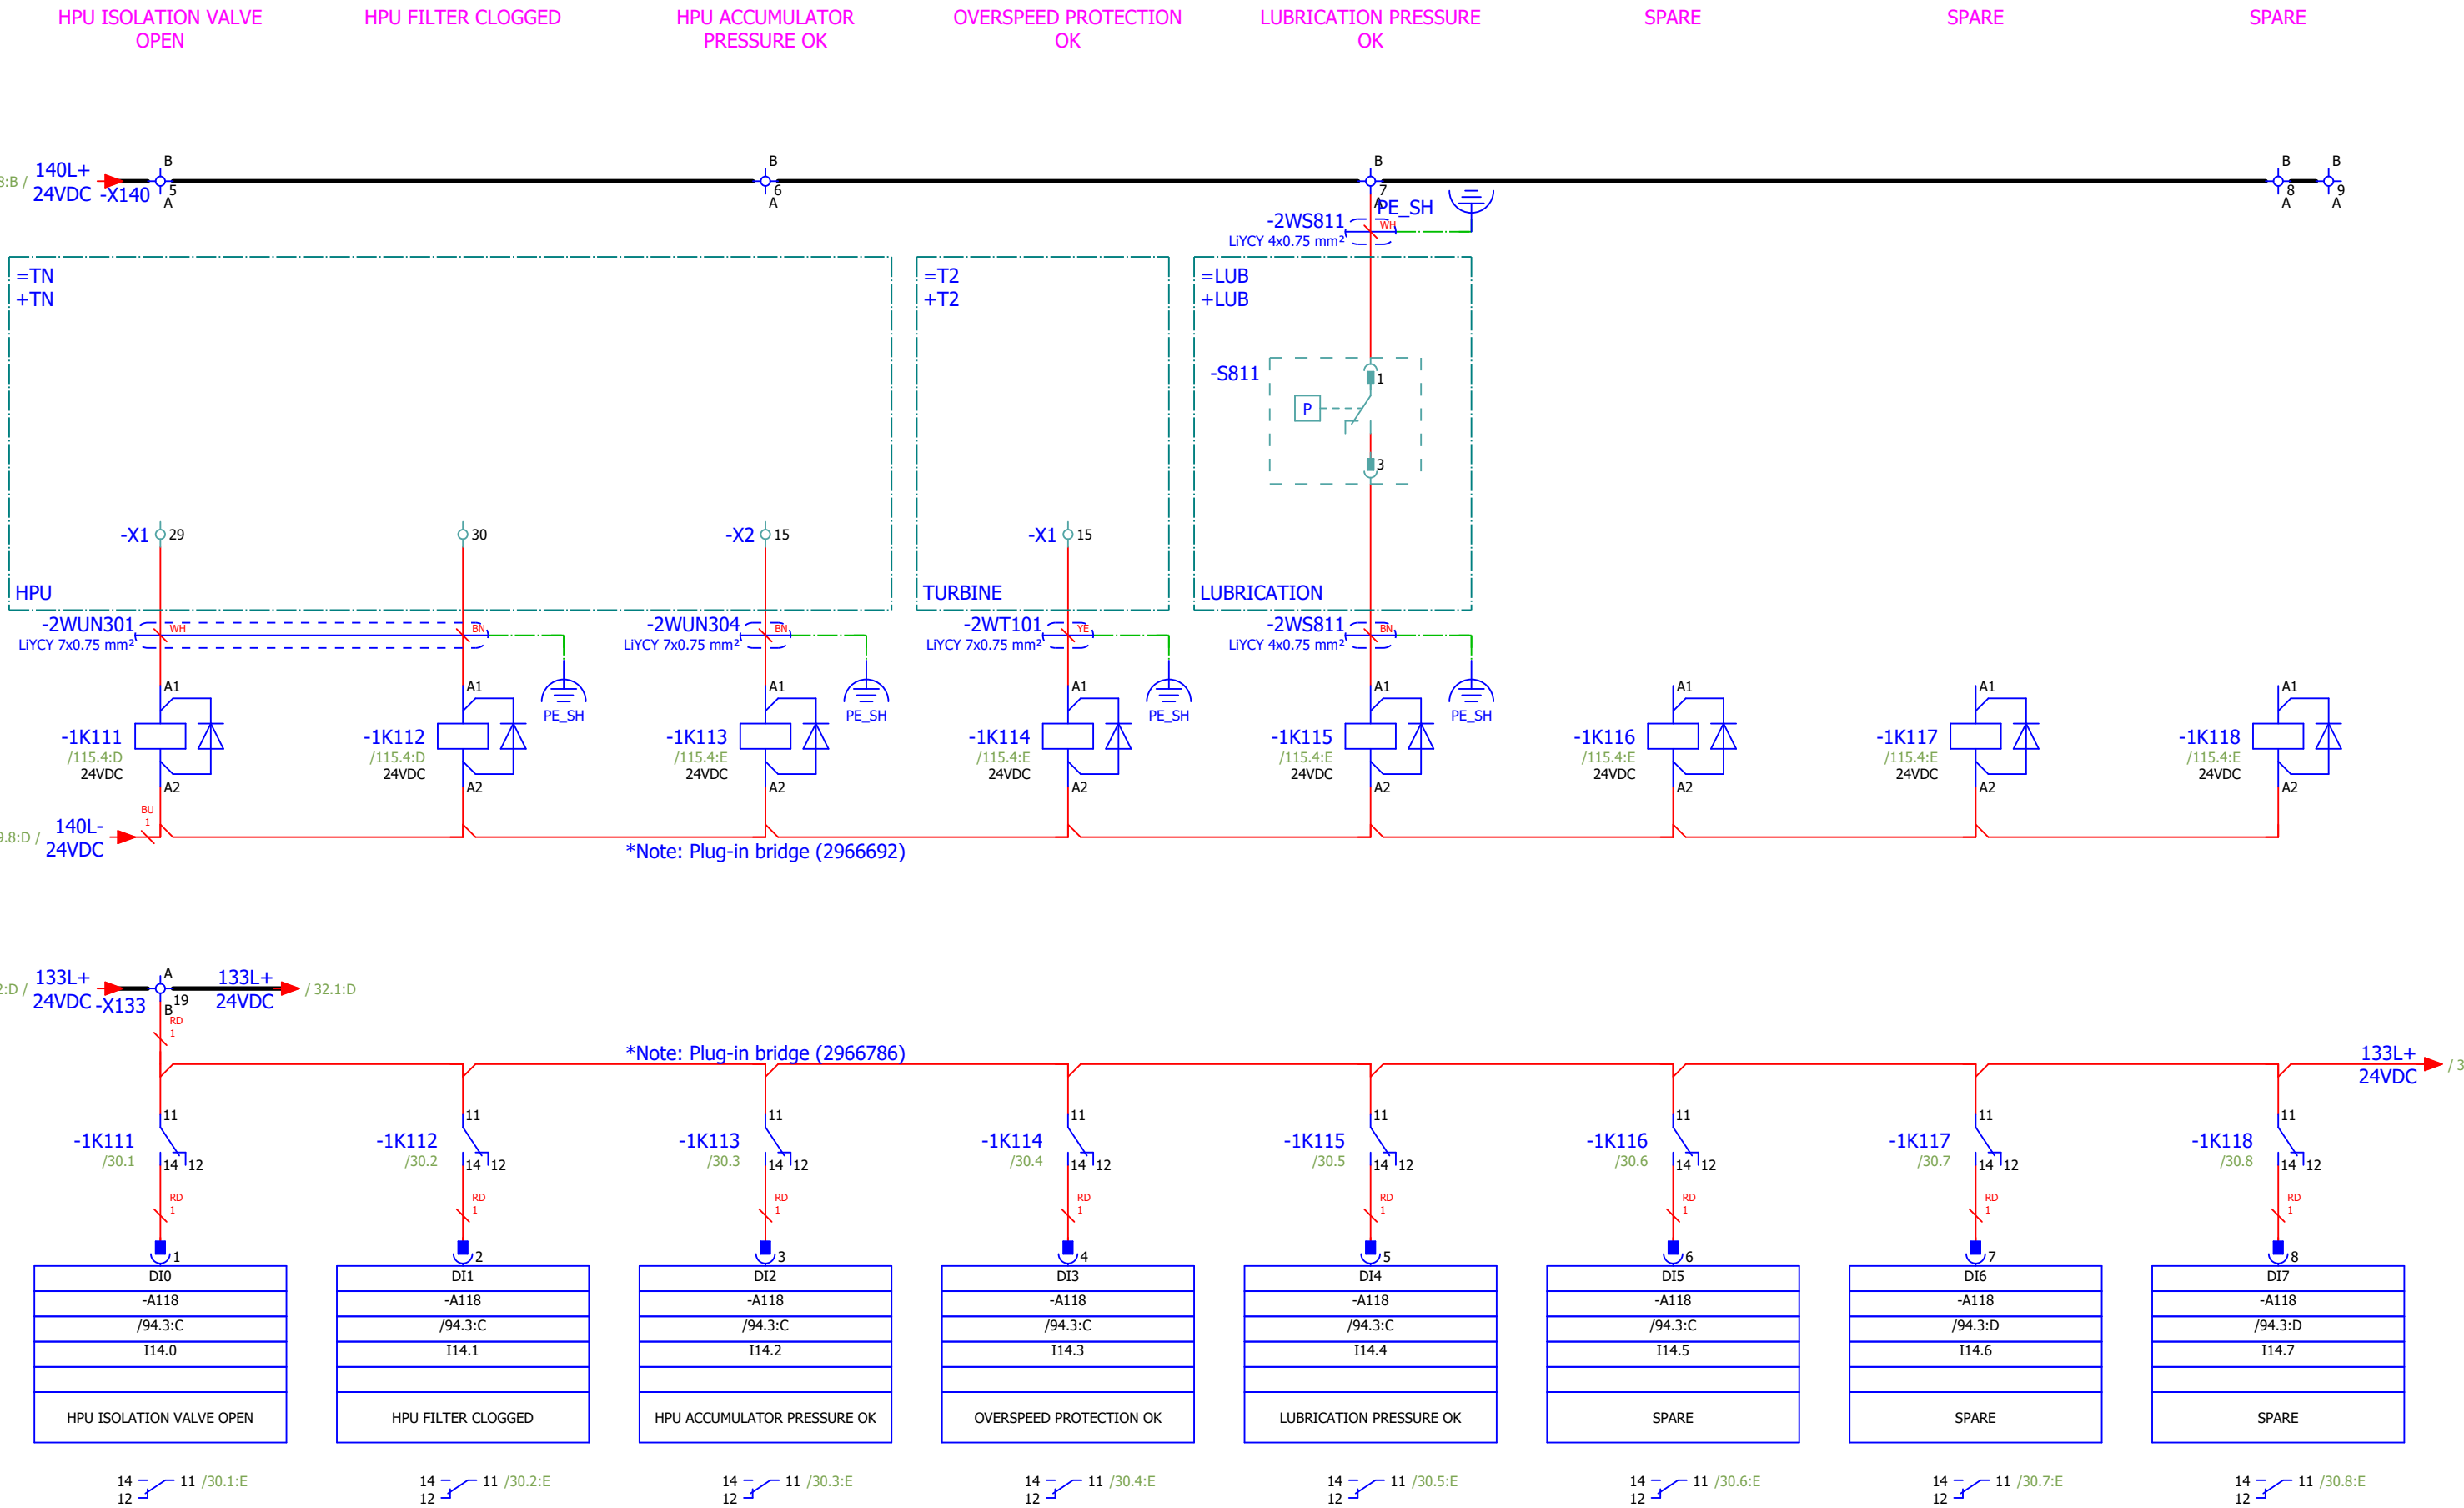

Approved by Contractor			Reconstruction and Modernisation of HPP Perucica - Phase II		SINTAKSA A Voith Company	Unit KA2 control cubicle circuit diagrams	DRAWING No.: PERU-01-19-170-31-002	REV No.: 02	= UBCJA10GH100
Approved by Designer	Grga Kolić	01.10.2026.			Sintaksa - A Voith Company Ulica Domovinskog rata 104C, 21 000 Split, Hrvatska	DIGITAL INPUTS: 14.0 - 14.7	Designer No.:	SALES No.:	+ UBCJA10
Checked by	Antonio Aleksić	01.10.2026.							PAGE 30
Drawn by	Tamara Trogrlić	01.10.2026.	PROJECT NAME	EMPLOYER	DESIGNER				PAGE 30 / 157

CONFIDENTIAL, ALL RIGHTS RESERVED DIN 34

Format ISO/DIN A3

30

32

Approved by Contractor			Reconstruction and Modernisation of HPP Perucica - Phase II		 A Voith Company Sintaksa - A Voith Company Ulica Domovinskog rata 104C, 21 000 Split, Hrvatska	Unit KA2 control cubicle circuit diagrams DIGITAL INPUTS: 15.0 - 15.7	DRAWING No.: PERU-01-19-170-31-002	REV No.: 02	= UBCJA10GH100
Approved by Designer	Grga Kolić	01.10.2026.					Designer No.:	SALES No.:	+ UBCJA10
Checked by	Antonio Aleksić	01.10.2026.							PAGE 31
Drawn by	Tamara Trogrlić	01.10.2026.							PAGE 31 / 157

1	2	3	4	5	6	7	8
---	---	---	---	---	---	---	---

A

B

C

D

E

F

A

B

C

D

E

F

SPARE

MIV CLOSED

MIV OPEN




BYPASS VALVE OPEN

BYPASS VALVE CLOSED

SEAL PRESSURE OK

FILTER CLOGGED 75%

FILTER CLOGGED 100%

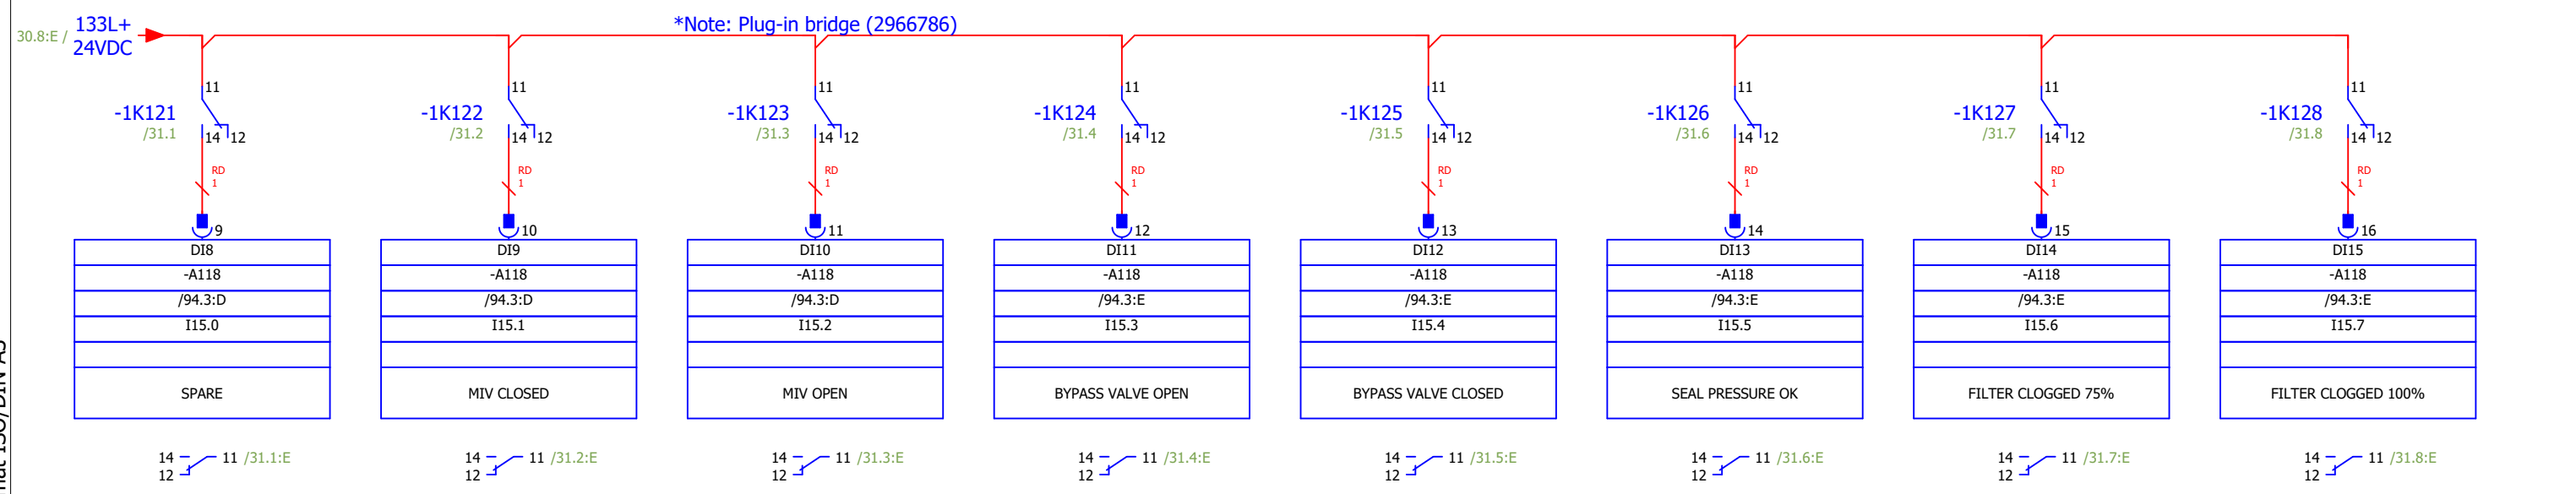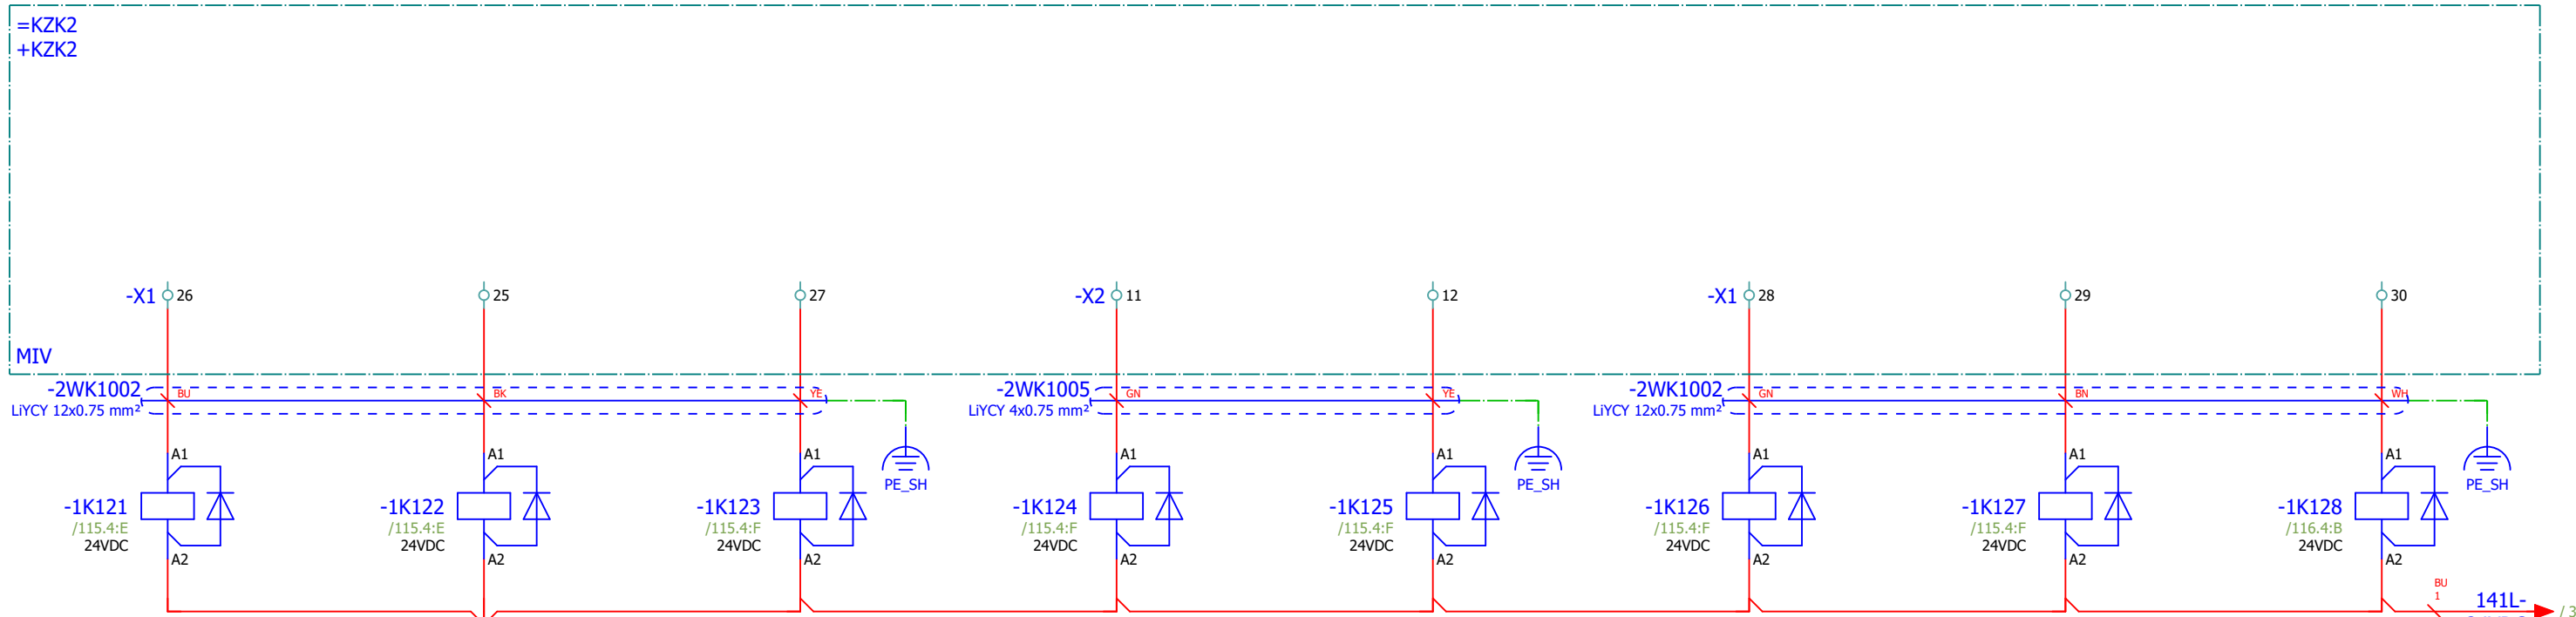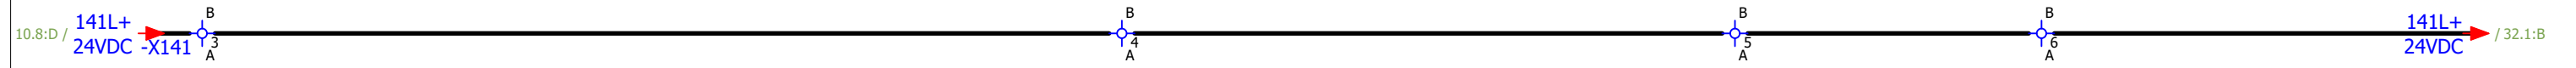

Approved by Contractor			Reconstruction and Modernisation of HPP Perucica - Phase II		 A Voith Company Sintaksa - A Voith Company Ulica Domovinskog rata 104C, 21 000 Split, Hrvatska	Unit KA2 control cubicle circuit diagrams DIGITAL INPUTS: 15.0 - 15.7	DRAWING No.: PERU-01-19-170-31-002	REV No.: 02	= UBCJA10GH100
Approved by Designer	Grga Kolić	01.10.2026.					Designer No.:	SALES No.:	+ UBCJA10
Checked by	Antonio Aleksić	01.10.2026.							PAGE 31
Drawn by	Tamara Trogrlić	01.10.2026.							PAGE 31 / 157

1	2	3	4	5	6	7	8
---	---	---	---	---	---	---	---

CONFIDENTIAL, ALL RIGHTS RESERVED DIN 34


Format ISO/DIN A3

31

33

Approved by Contractor			Reconstruction and Modernisation of HPP Perucica - Phase II		 A Voith Company Sintaksa - A Voith Company Ulica Domovinskog rata 104C, 21 000 Split, Hrvatska	Unit KA2 control cubicle circuit diagrams DIGITAL INPUTS: 16.0 - 16.7	DRAWING No.: PERU-01-19-170-31-002	REV No.: 02	= UBCJA10GH100
Approved by Designer	Grga Kolić	01.10.2026.					Designer No.:	SALES No.:	+ UBCJA10
Checked by	Antonio Aleksić	01.10.2026.							PAGE
Drawn by	Tamara Trogrlić	01.10.2026.							32
			PROJECT NAME	EMPLOYER	DESIGNER				PAGE

1	2	3	4	5	6	7	8
---	---	---	---	---	---	---	---

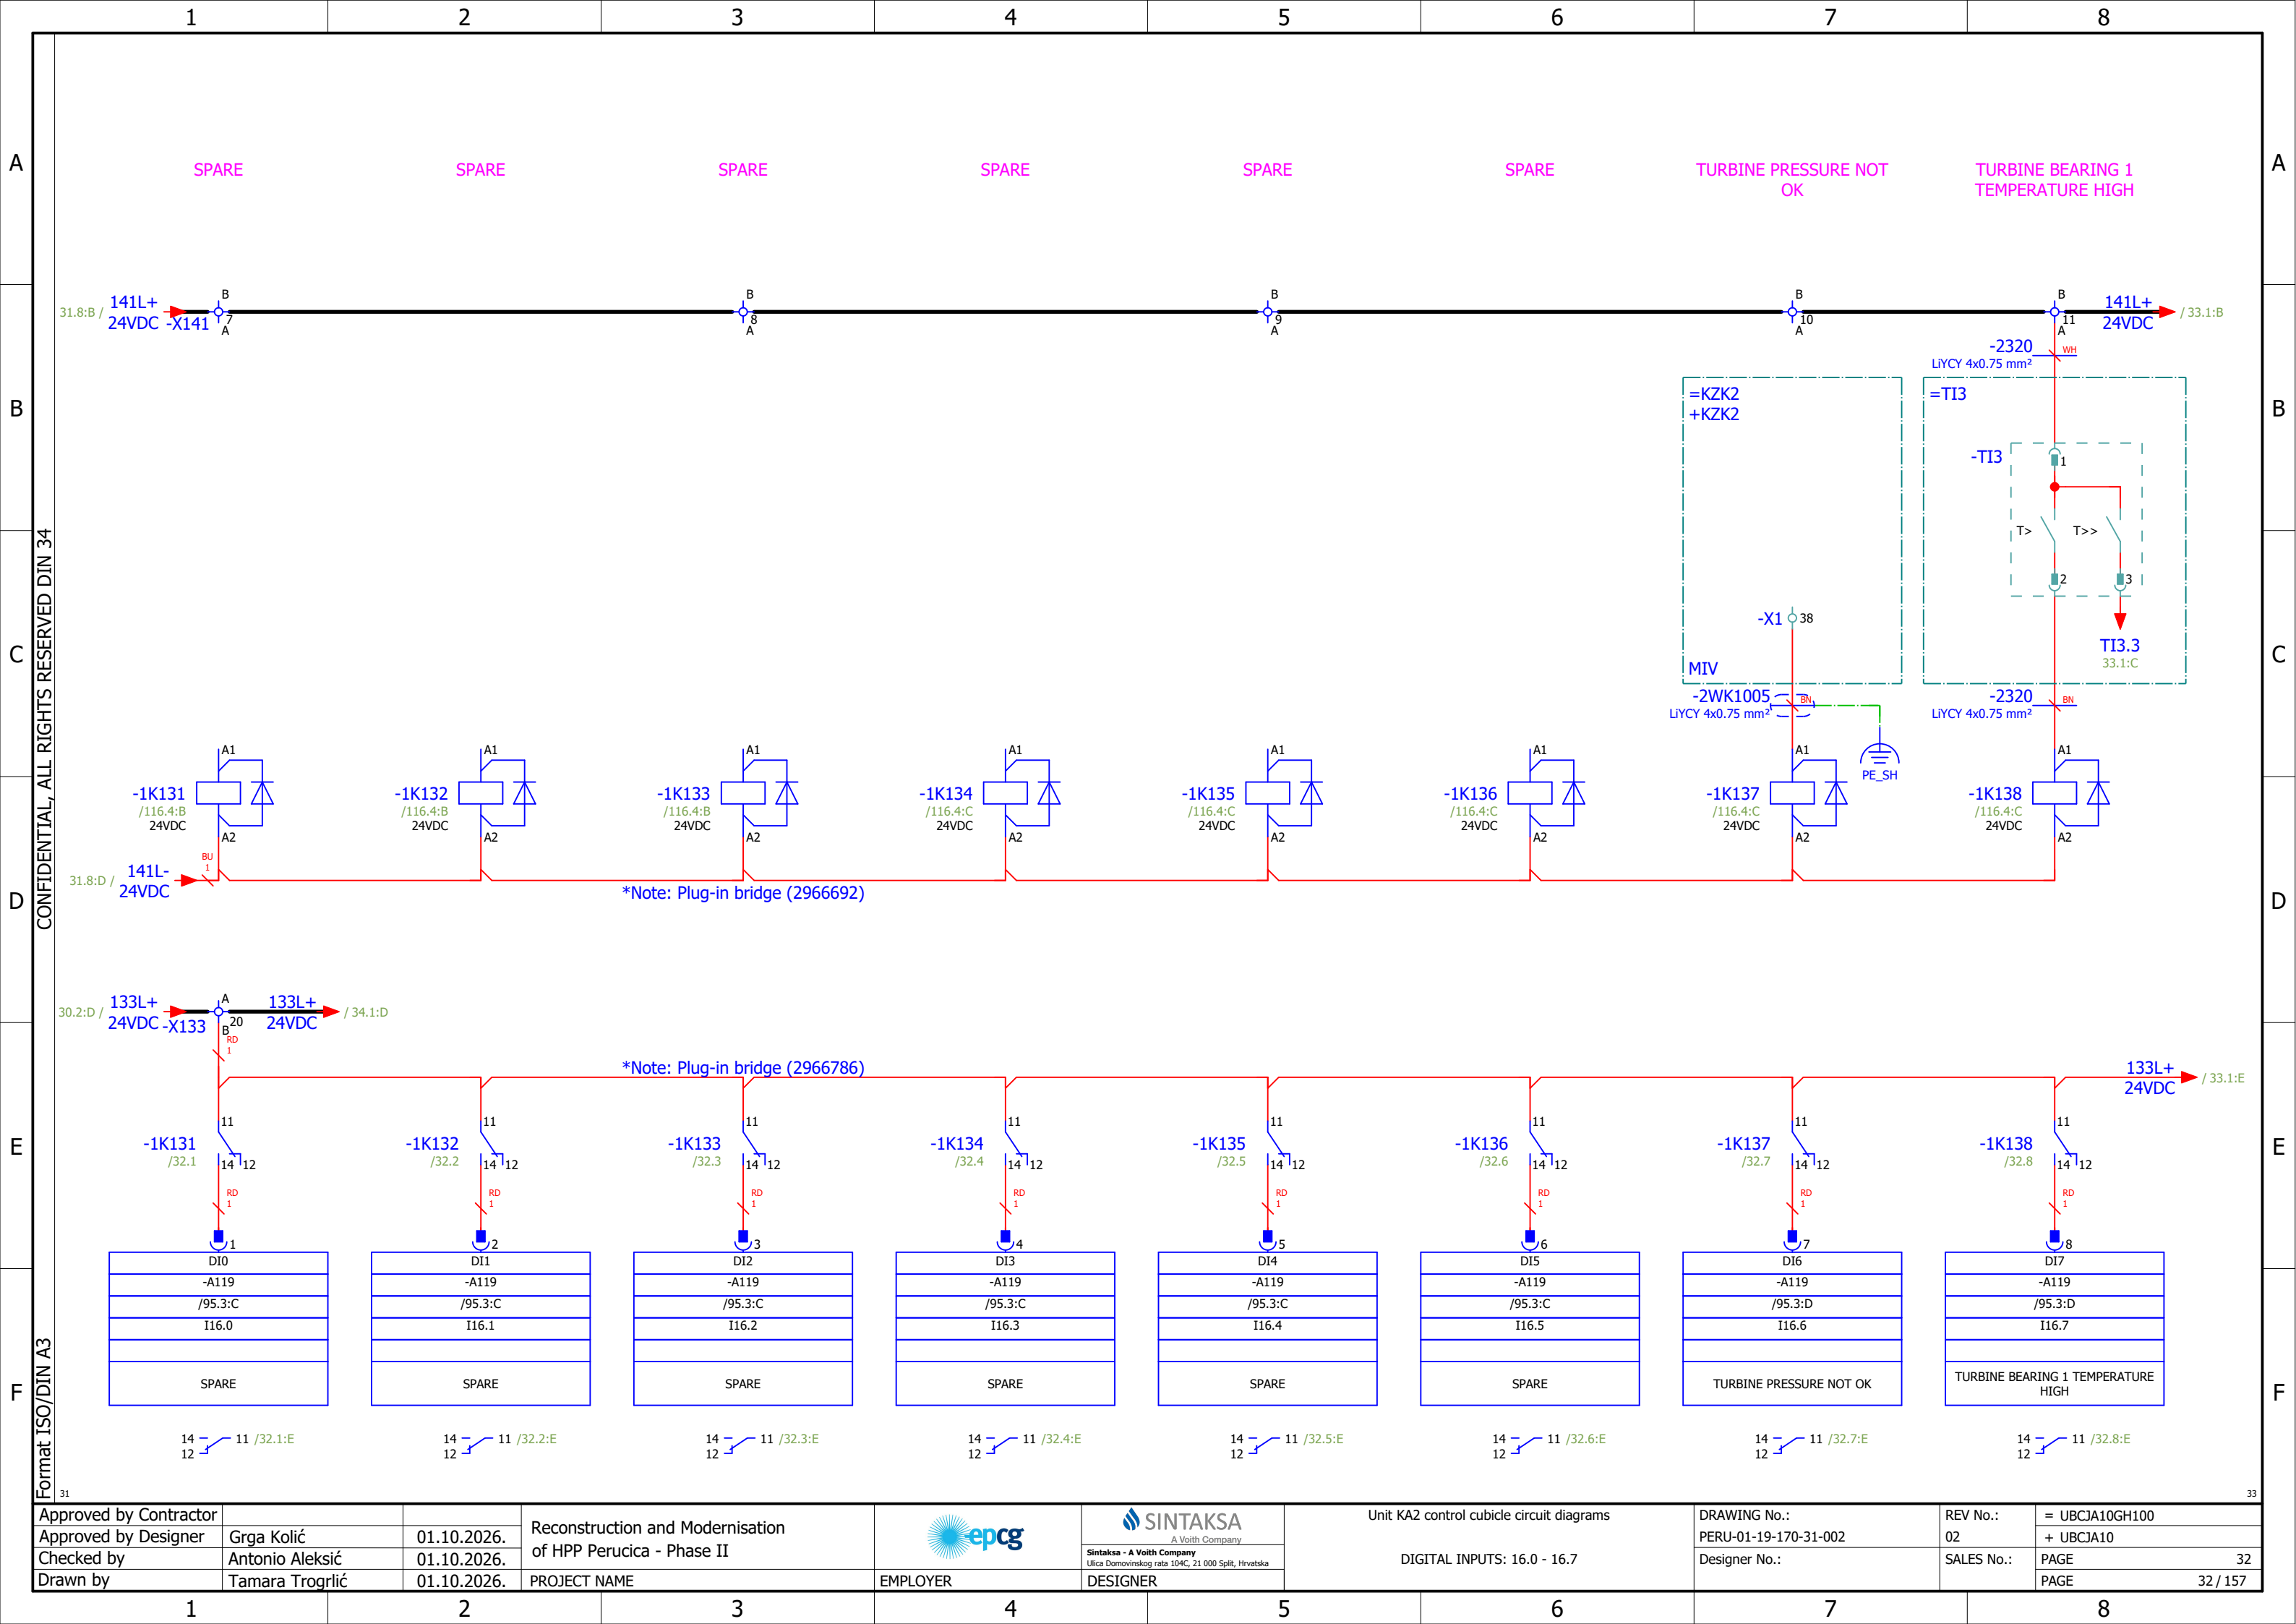


CONFIDENTIAL, ALL RIGHTS RESERVED DIN 34

Format ISO/DIN A3

32

34

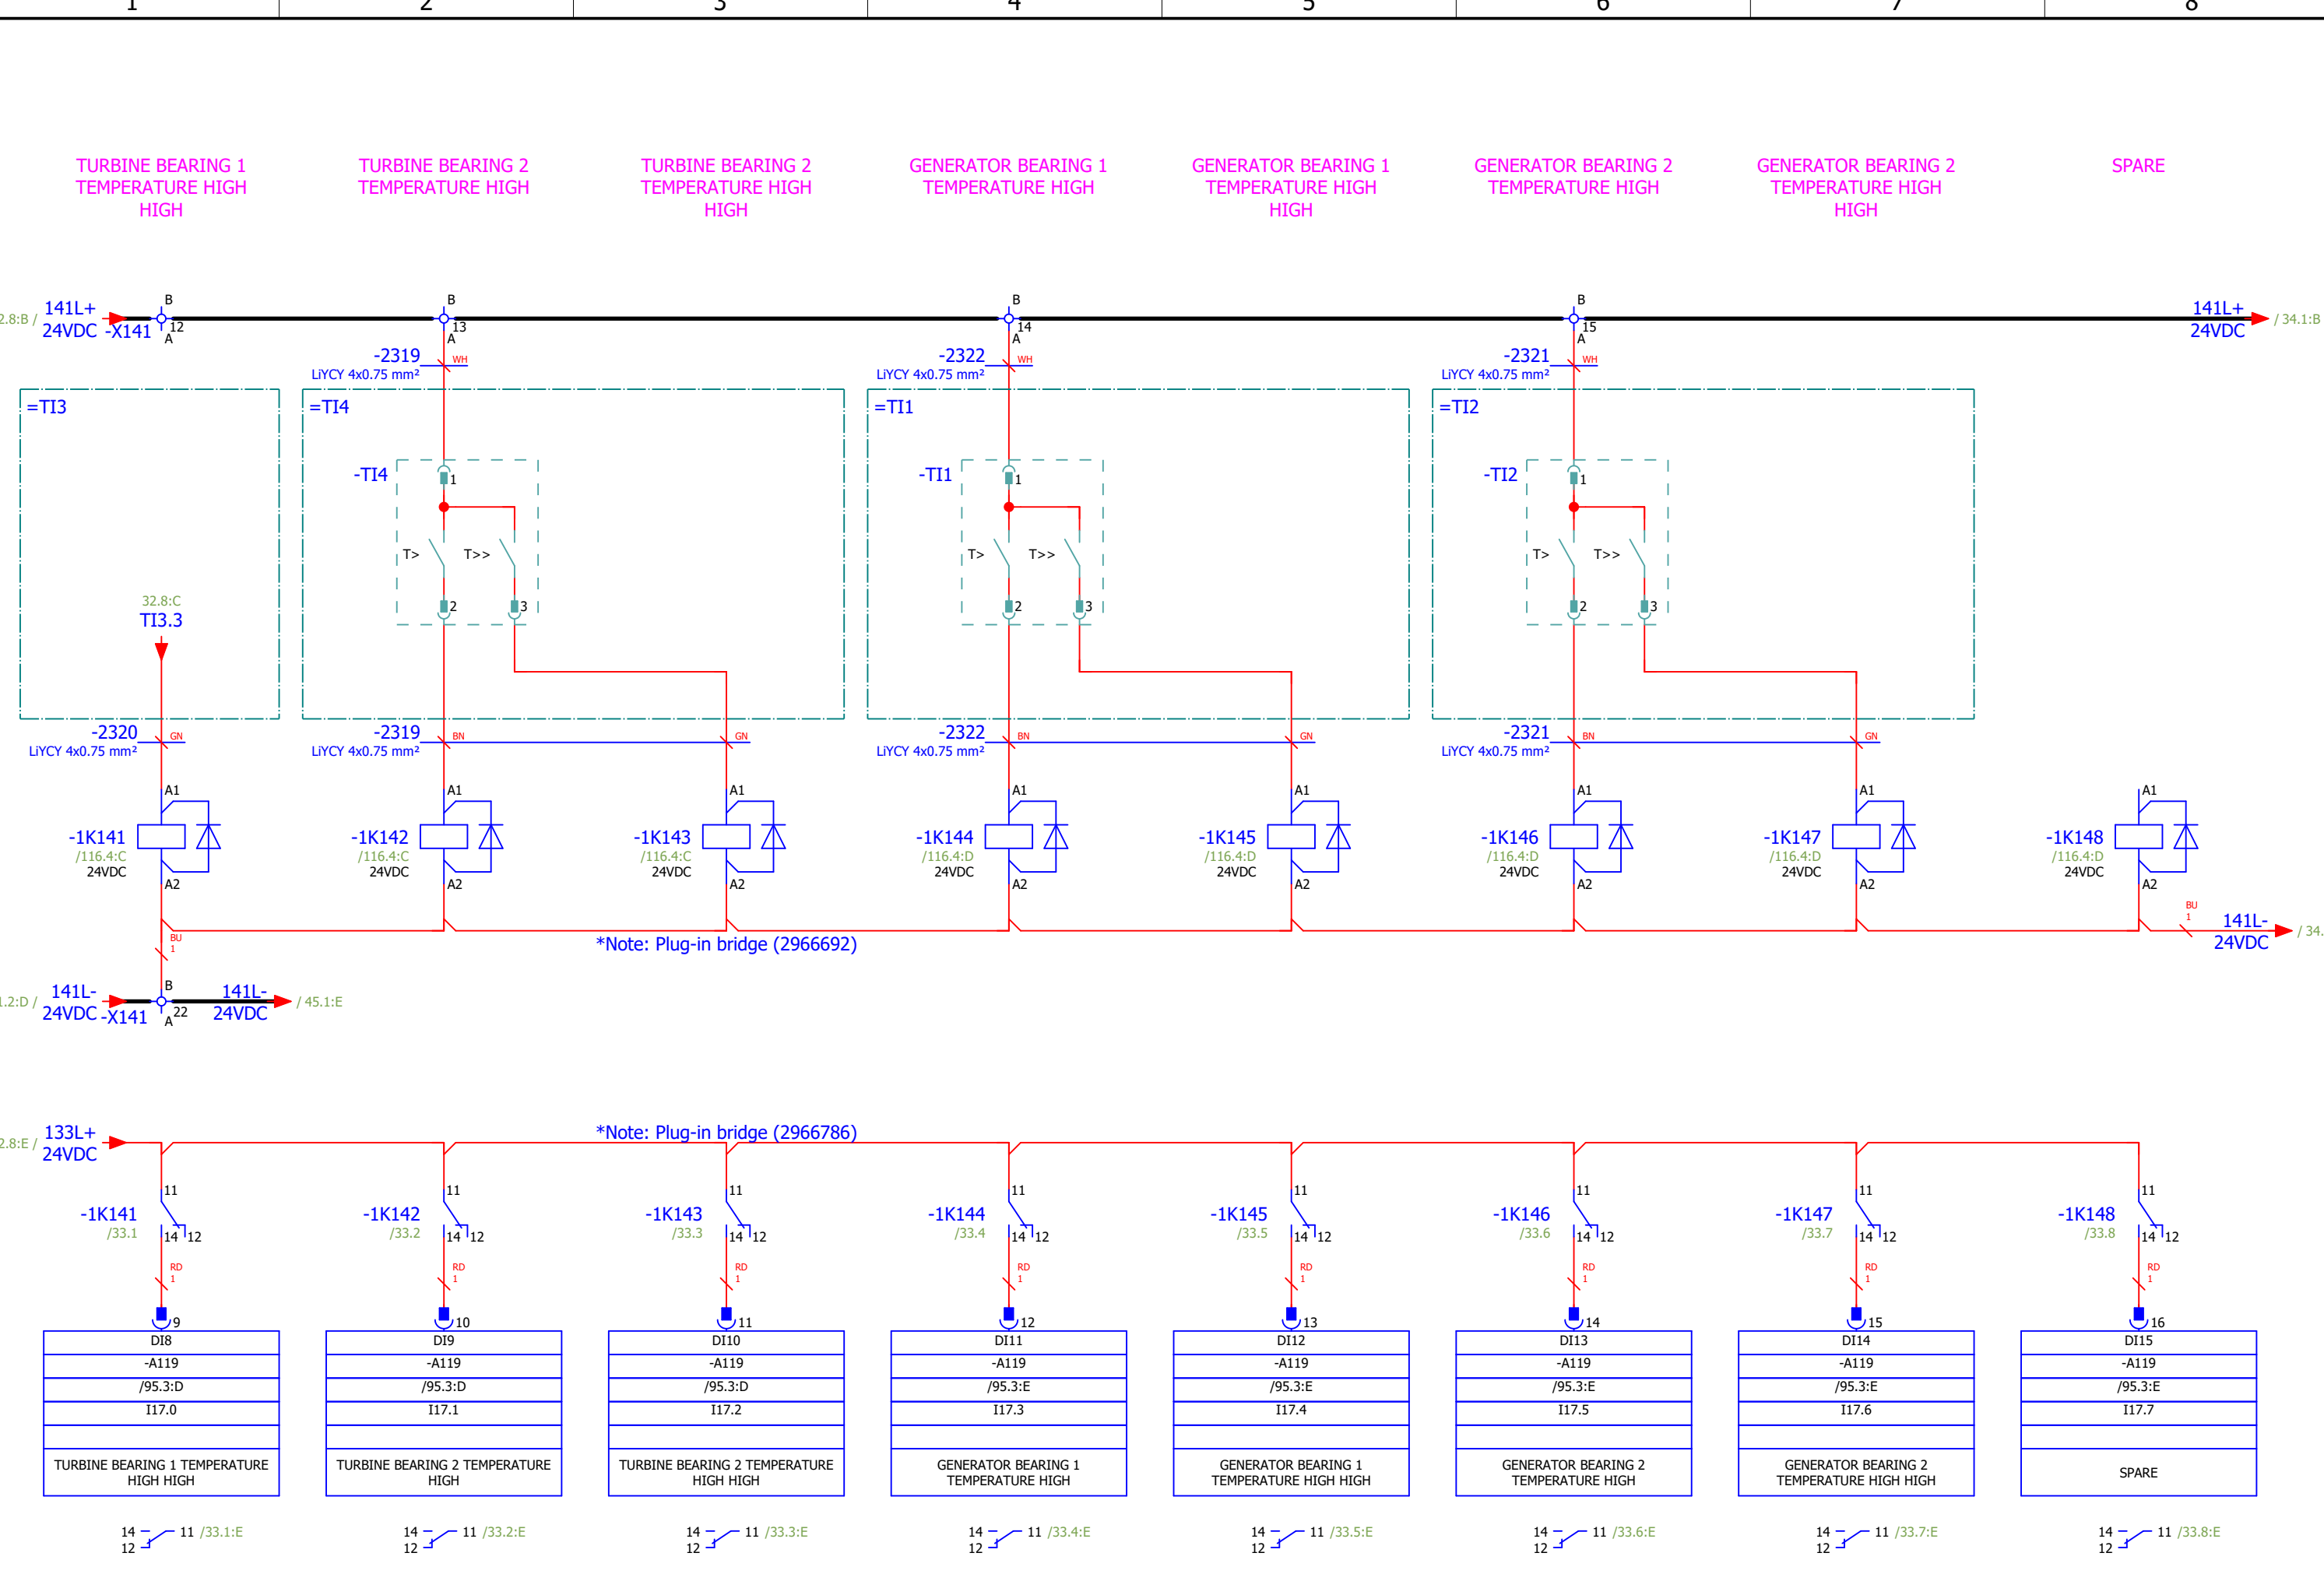

Approved by Contractor			Reconstruction and Modernisation of HPP Perucica - Phase II			Unit KA2 control cubicle circuit diagrams	DRAWING No.: PERU-01-19-170-31-002	REV No.: 02	= UBCJA10GH100
Approved by Designer	Grga Kolić	01.10.2026.							+ UBCJA10
Checked by	Antonio Aleksić	01.10.2026.				DIGITAL INPUTS: 17.0 - 17.7	Designer No.:	SALES No.:	PAGE 33
Drawn by	Tamara Trogrlić	01.10.2026.	PROJECT NAME	EMPLOYER	DESIGNER				PAGE 33 / 157



F

CONFIDENTIAL, ALL RIGHTS RESERVED DIN 34

Format ISO/DIN A3

35

37

Approved by Contractor			Reconstruction and Modernisation of HPP Perucica - Phase II		 A Voith Company Sintaksa - A Voith Company Ulica Domovinskog rata 104C, 21 000 Split, Hrvatska	Unit KA2 control cubicle circuit diagrams DIGITAL OUTPUTS: 0.0 - 0.7	DRAWING No.: PERU-01-19-170-31-002	REV No.: 02	= UBCJA10GH100 + UBCJA10
Approved by Designer	Grga Kolić	01.10.2026.					Designer No.:	SALES No.:	PAGE 36
Checked by	Antonio Aleksić	01.10.2026.	PROJECT NAME	EMPLOYER	DESIGNER				PAGE 36 / 157
Drawn by	Tamara Trogrlić	01.10.2026.							

C

D

E

F

35

37

Approved by Contractor			Reconstruction and Modernisation of HPP Perucica - Phase II		 A Voith Company Sintaksa - A Voith Company Ulica Domovinskog rata 104C, 21 000 Split, Hrvatska	Unit KA2 control cubicle circuit diagrams DIGITAL OUTPUTS: 0.0 - 0.7	DRAWING No.: PERU-01-19-170-31-002	REV No.: 02	= UBCJA10GH100 + UBCJA10
Approved by Designer	Grga Kolić	01.10.2026.					Designer No.:	SALES No.:	PAGE 36
Checked by	Antonio Aleksić	01.10.2026.	PROJECT NAME	EMPLOYER	DESIGNER				PAGE 36 / 157
Drawn by	Tamara Trogrlić	01.10.2026.							

CONFIDENTIAL, ALL RIGHTS RESERVED DIN 34

Format ISO/DIN A3

35

37

Approved by Contractor			Reconstruction and Modernisation of HPP Perucica - Phase II		 A Voith Company Sintaksa - A Voith Company Ulica Domovinskog rata 104C, 21 000 Split, Hrvatska	Unit KA2 control cubicle circuit diagrams DIGITAL OUTPUTS: 0.0 - 0.7	DRAWING No.: PERU-01-19-170-31-002	REV No.: 02	= UBCJA10GH100 + UBCJA10
Approved by Designer	Grga Kolić	01.10.2026.					Designer No.:	SALES No.:	PAGE 36
Checked by	Antonio Aleksić	01.10.2026.	PROJECT NAME	EMPLOYER	DESIGNER				PAGE 36 / 157
Drawn by	Tamara Trogrlić	01.10.2026.							

CONFIDENTIAL, ALL RIGHTS RESERVED DIN 34

Format ISO/DIN A3

36

38

Approved by Contractor			Reconstruction and Modernisation of HPP Perucica - Phase II		 A Voith Company Sintaksa - A Voith Company Ulica Domovinskog rata 104C, 21 000 Split, Hrvatska	Unit KA2 control cubicle circuit diagrams DIGITAL OUTPUTS: 1.0 - 1.7	DRAWING No.: PERU-01-19-170-31-002	REV No.: 02	= UBCJA10GH100
Approved by Designer	Grga Kolić	01.10.2026.					Designer No.:	SALES No.:	+ UBCJA10
Checked by	Antonio Aleksić	01.10.2026.						PAGE	37
Drawn by	Tamara Trogrlić	01.10.2026.						PAGE	37 / 157

HPU ISOLATION VALVE
CLOSE COMMAND

HPU LOAD VALVE ON
COMMAND

NOZZLE CLOSE
COMMAND

NOZZLE OPEN
COMMAND

ACTIVATE ESD VALVE

BYPASS VALVE OPEN
COMMAND

BYPASS VALVE CLOSE
COMMAND

MIV OPEN COMMAND

HPU ISOLATION VALVE CLOSE COMMAND
Q1.0
/97.3:D
-A131
DQ8

HPU LOAD VALVE ON COMMAND
Q1.1
/97.3:D
-A131
DQ9

NOZZLE CLOSE COMMAND
Q1.2
/97.3:D
-A131
DQ10


NOZZLE OPEN COMMAND
Q1.3
/97.3:E
-A131
DQ11

ACTIVATE ESD VALVE
Q1.4
/97.3:E
-A131
DQ12

BYPASS VALVE OPEN COMMAND
Q1.5
/97.3:E
-A131
DQ13

BYPASS VALVE CLOSE COMMAND
Q1.6
/97.3:E
-A131
DQ14

MIV OPEN COMMAND
Q1.7
/97.3:E
-A131
DQ15

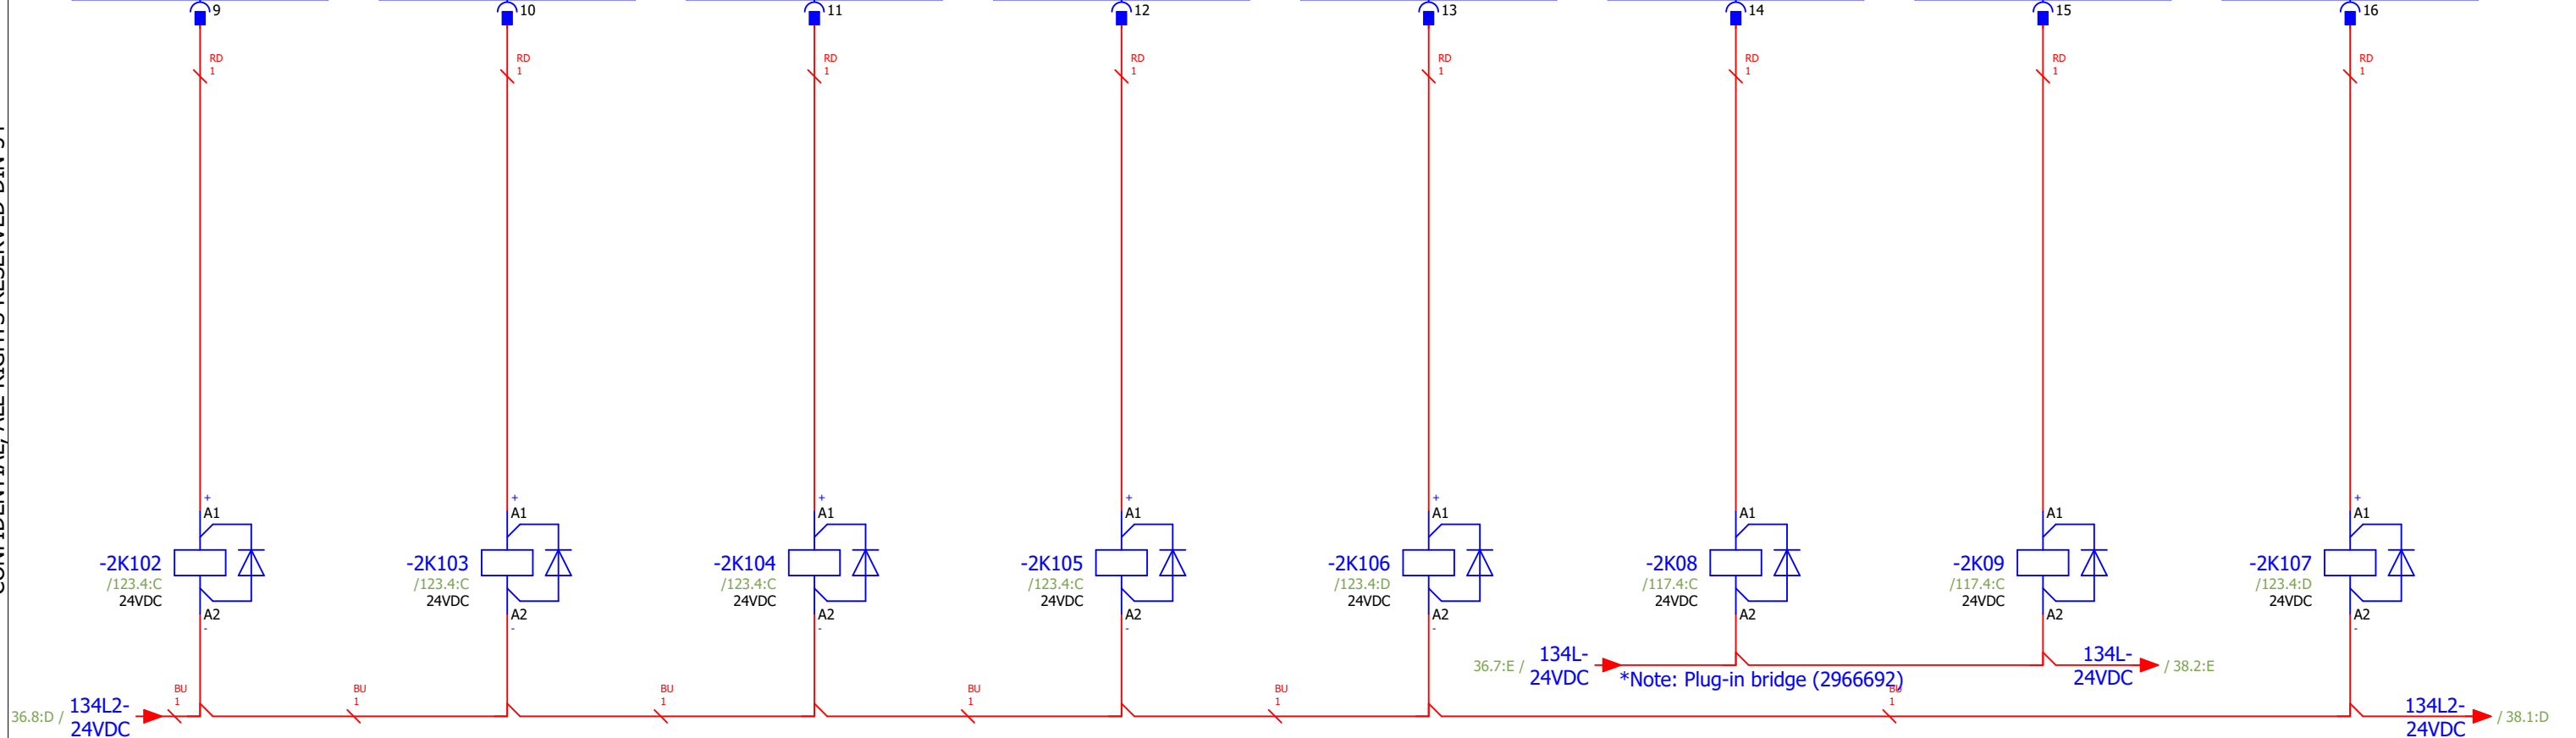

13 — 14 /50.3:B
23 — 24 /50.3:C
33 — 34 /50.3:C
43 — 44

13 — 14 /50.4:B
23 — 24 /50.4:C
33 — 34 /50.4:C
43 — 44

13 — 14 /50.5:B
23 — 24 /50.5:C
33 — 34 /50.5:C
43 — 44

13 — 14 /50.6:B
23 — 24 /50.6:C
33 — 34 /50.6:C
43 — 44

13 — 14 /51.3:B
23 — 24 /51.3:C
33 — 34 /51.3:C
43 — 44

14 — 11 /52.7:B
12 — 11 /52.7:B

14 — 11 /52.8:B
12 — 11 /52.8:B

13 — 14 /52.4:B
23 — 24 /52.4:C
33 — 34 /52.4:C
43 — 44

CONFIDENTIAL, ALL RIGHTS RESERVED DIN 34

Format ISO/DIN A3

37

Approved by Contractor			Reconstruction and Modernisation of HPP Perucica - Phase II		 A Voith Company Sintaksa - A Voith Company Ulica Domovinskog rata 104C, 21 000 Split, Hrvatska	Unit KA2 control cubicle circuit diagrams DIGITAL OUTPUTS: 2.0 - 2.7	DRAWING No.: PERU-01-19-170-31-002	REV No.: 02	= UBCJA10GH100
Approved by Designer	Grga Kolić	01.10.2026.					Designer No.:	SALES No.:	+ UBCJA10
Checked by	Antonio Aleksić	01.10.2026.	PROJECT NAME	EMPLOYER	DESIGNER				PAGE 38
Drawn by	Tamara Trogrlić	01.10.2026.							PAGE 38 / 157

C

D

E

F

39

A

B

C

D

E

F

A


B

C

D

E

F

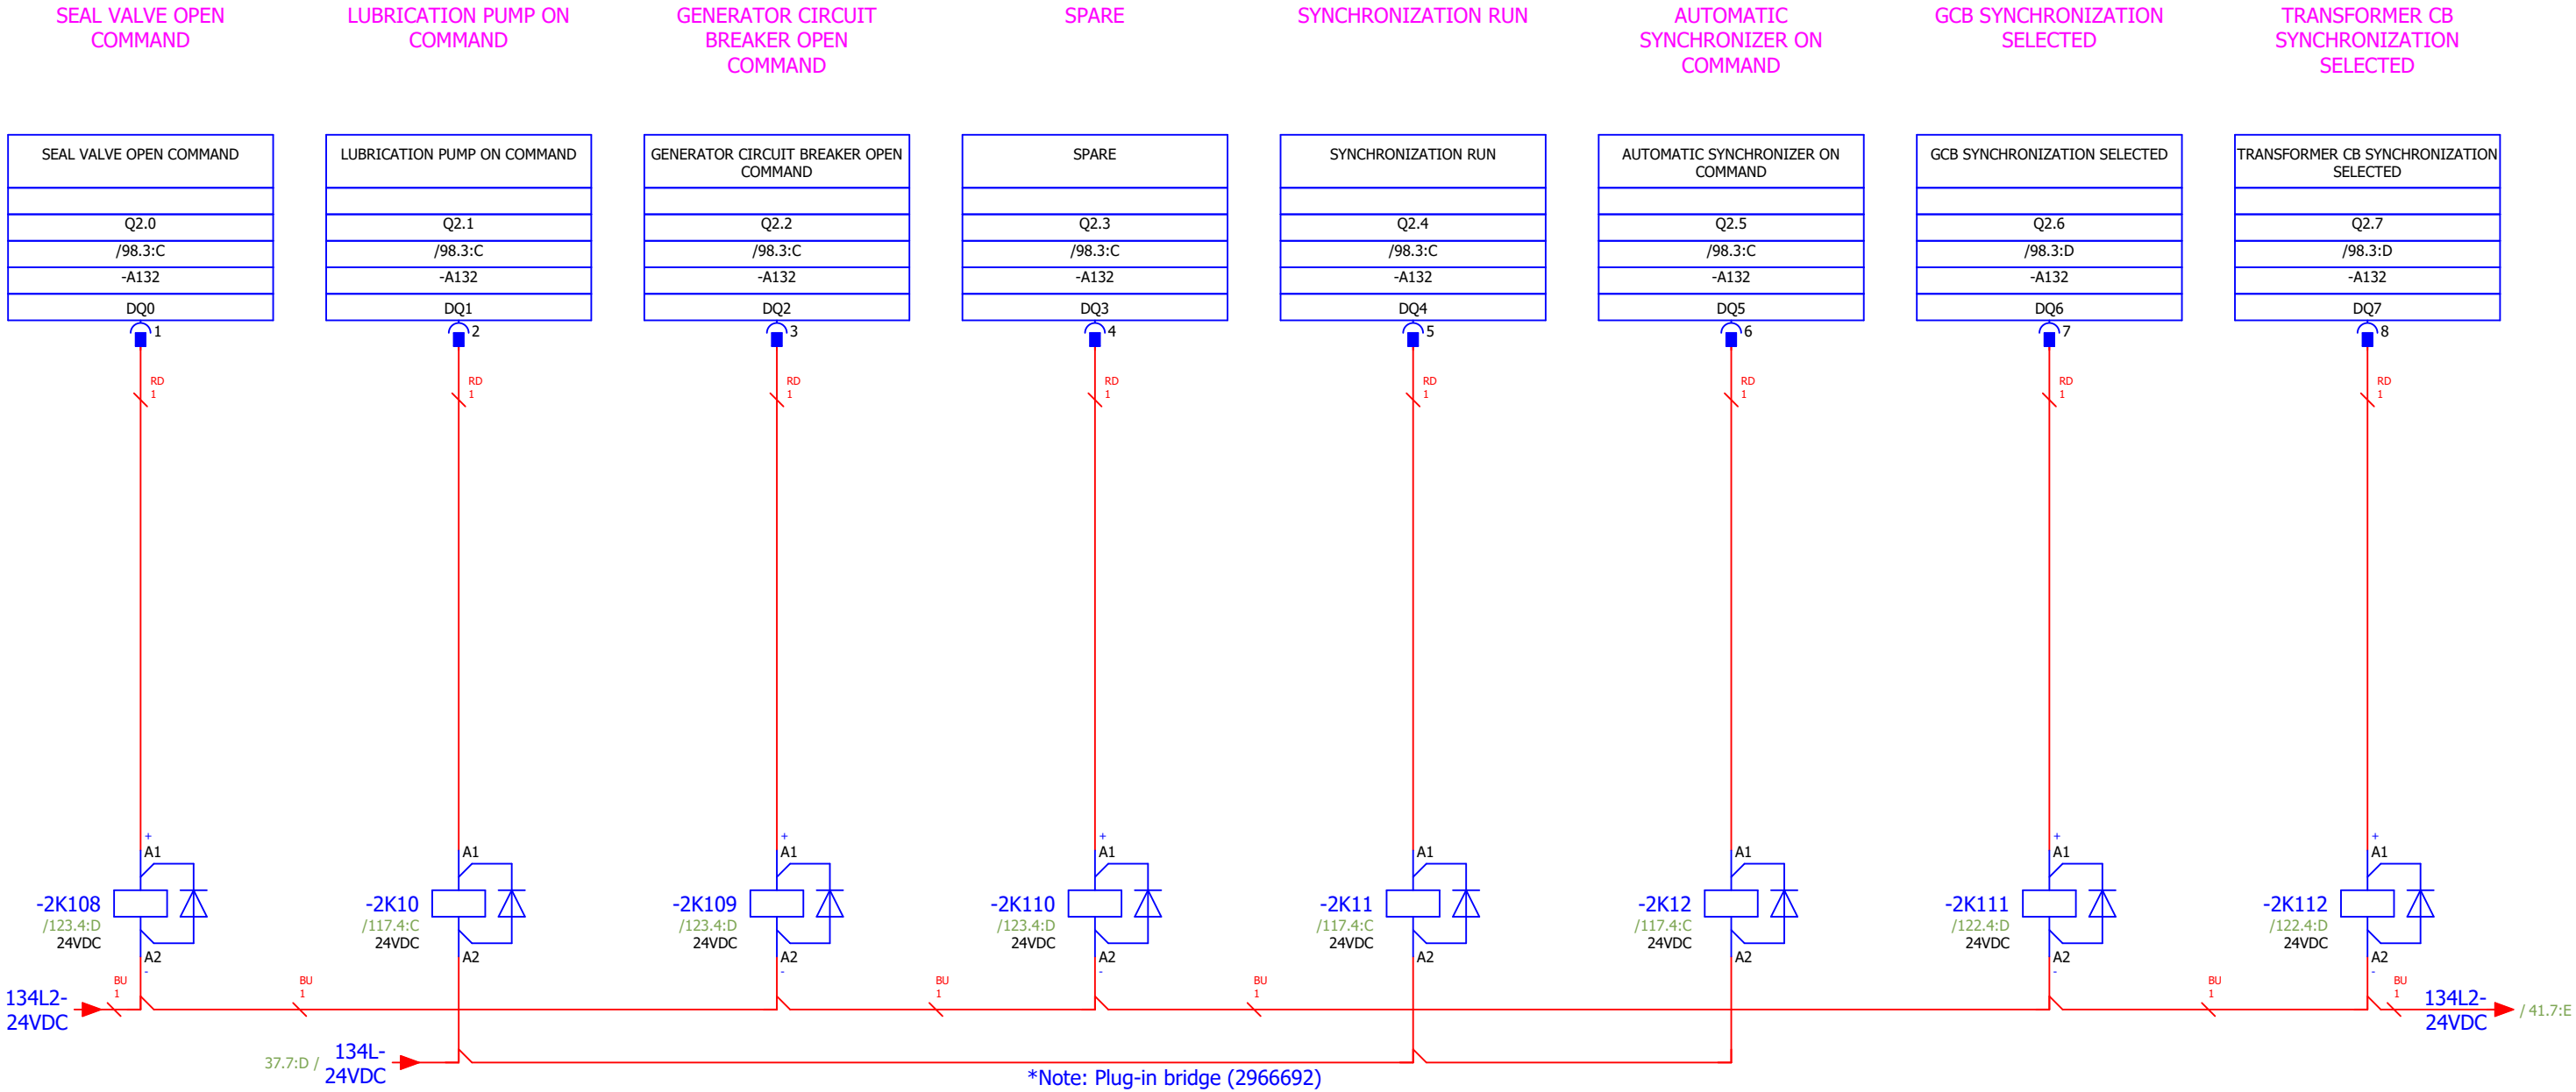


CONFIDENTIAL, ALL RIGHTS RESERVED DIN 34


Format ISO/DIN A3


38

40


Approved by Contractor			Reconstruction and Modernisation of HPP Perucica - Phase II		 A Voith Company Sintaksa - A Voith Company Ulica Domovinskog rata 104C, 21 000 Split, Hrvatska	Unit KA2 control cubicle circuit diagrams DIGITAL OUTPUTS: 3.0 -3.7	DRAWING No.: PERU-01-19-170-31-002	REV No.: 02	= UBCJA10GH100 + UBCJA10
Approved by Designer	Grga Kolić	01.10.2026.					Designer No.:	SALES No.:	PAGE 39
Checked by	Antonio Aleksić	01.10.2026.	PROJECT NAME	EMPLOYER	DESIGNER				PAGE 39 / 157
Drawn by	Tamara Trogrlić	01.10.2026.							

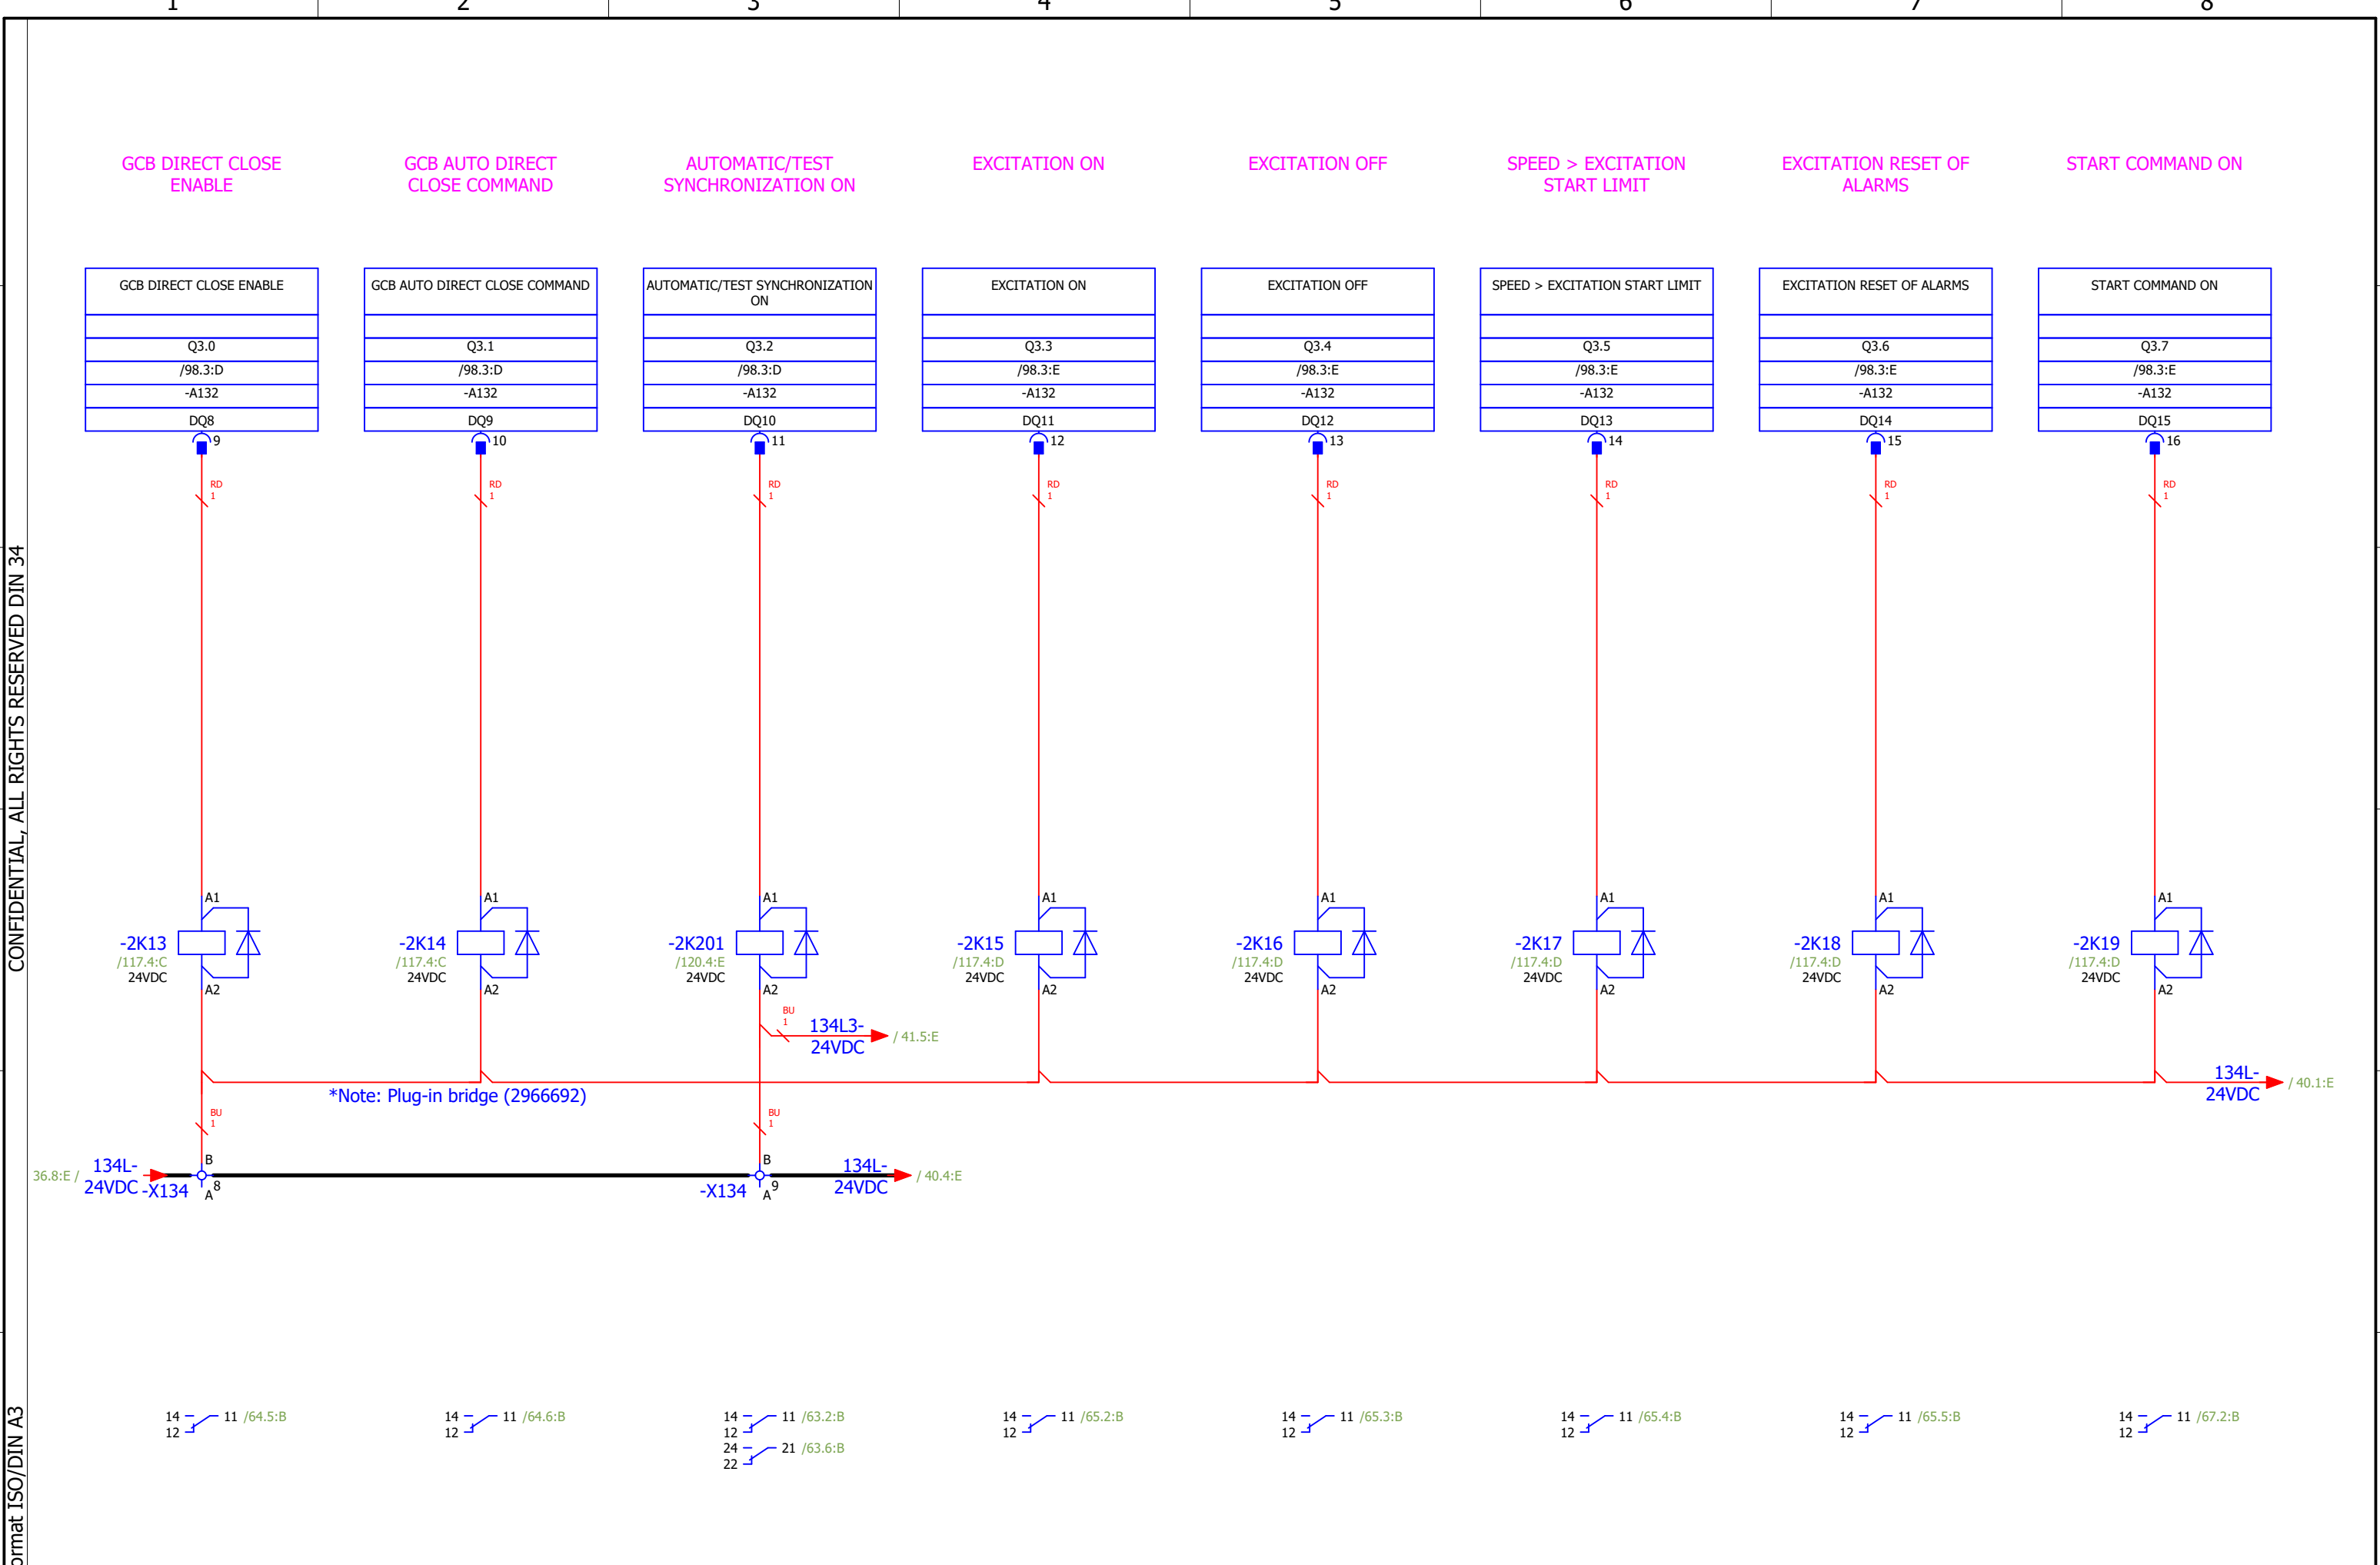

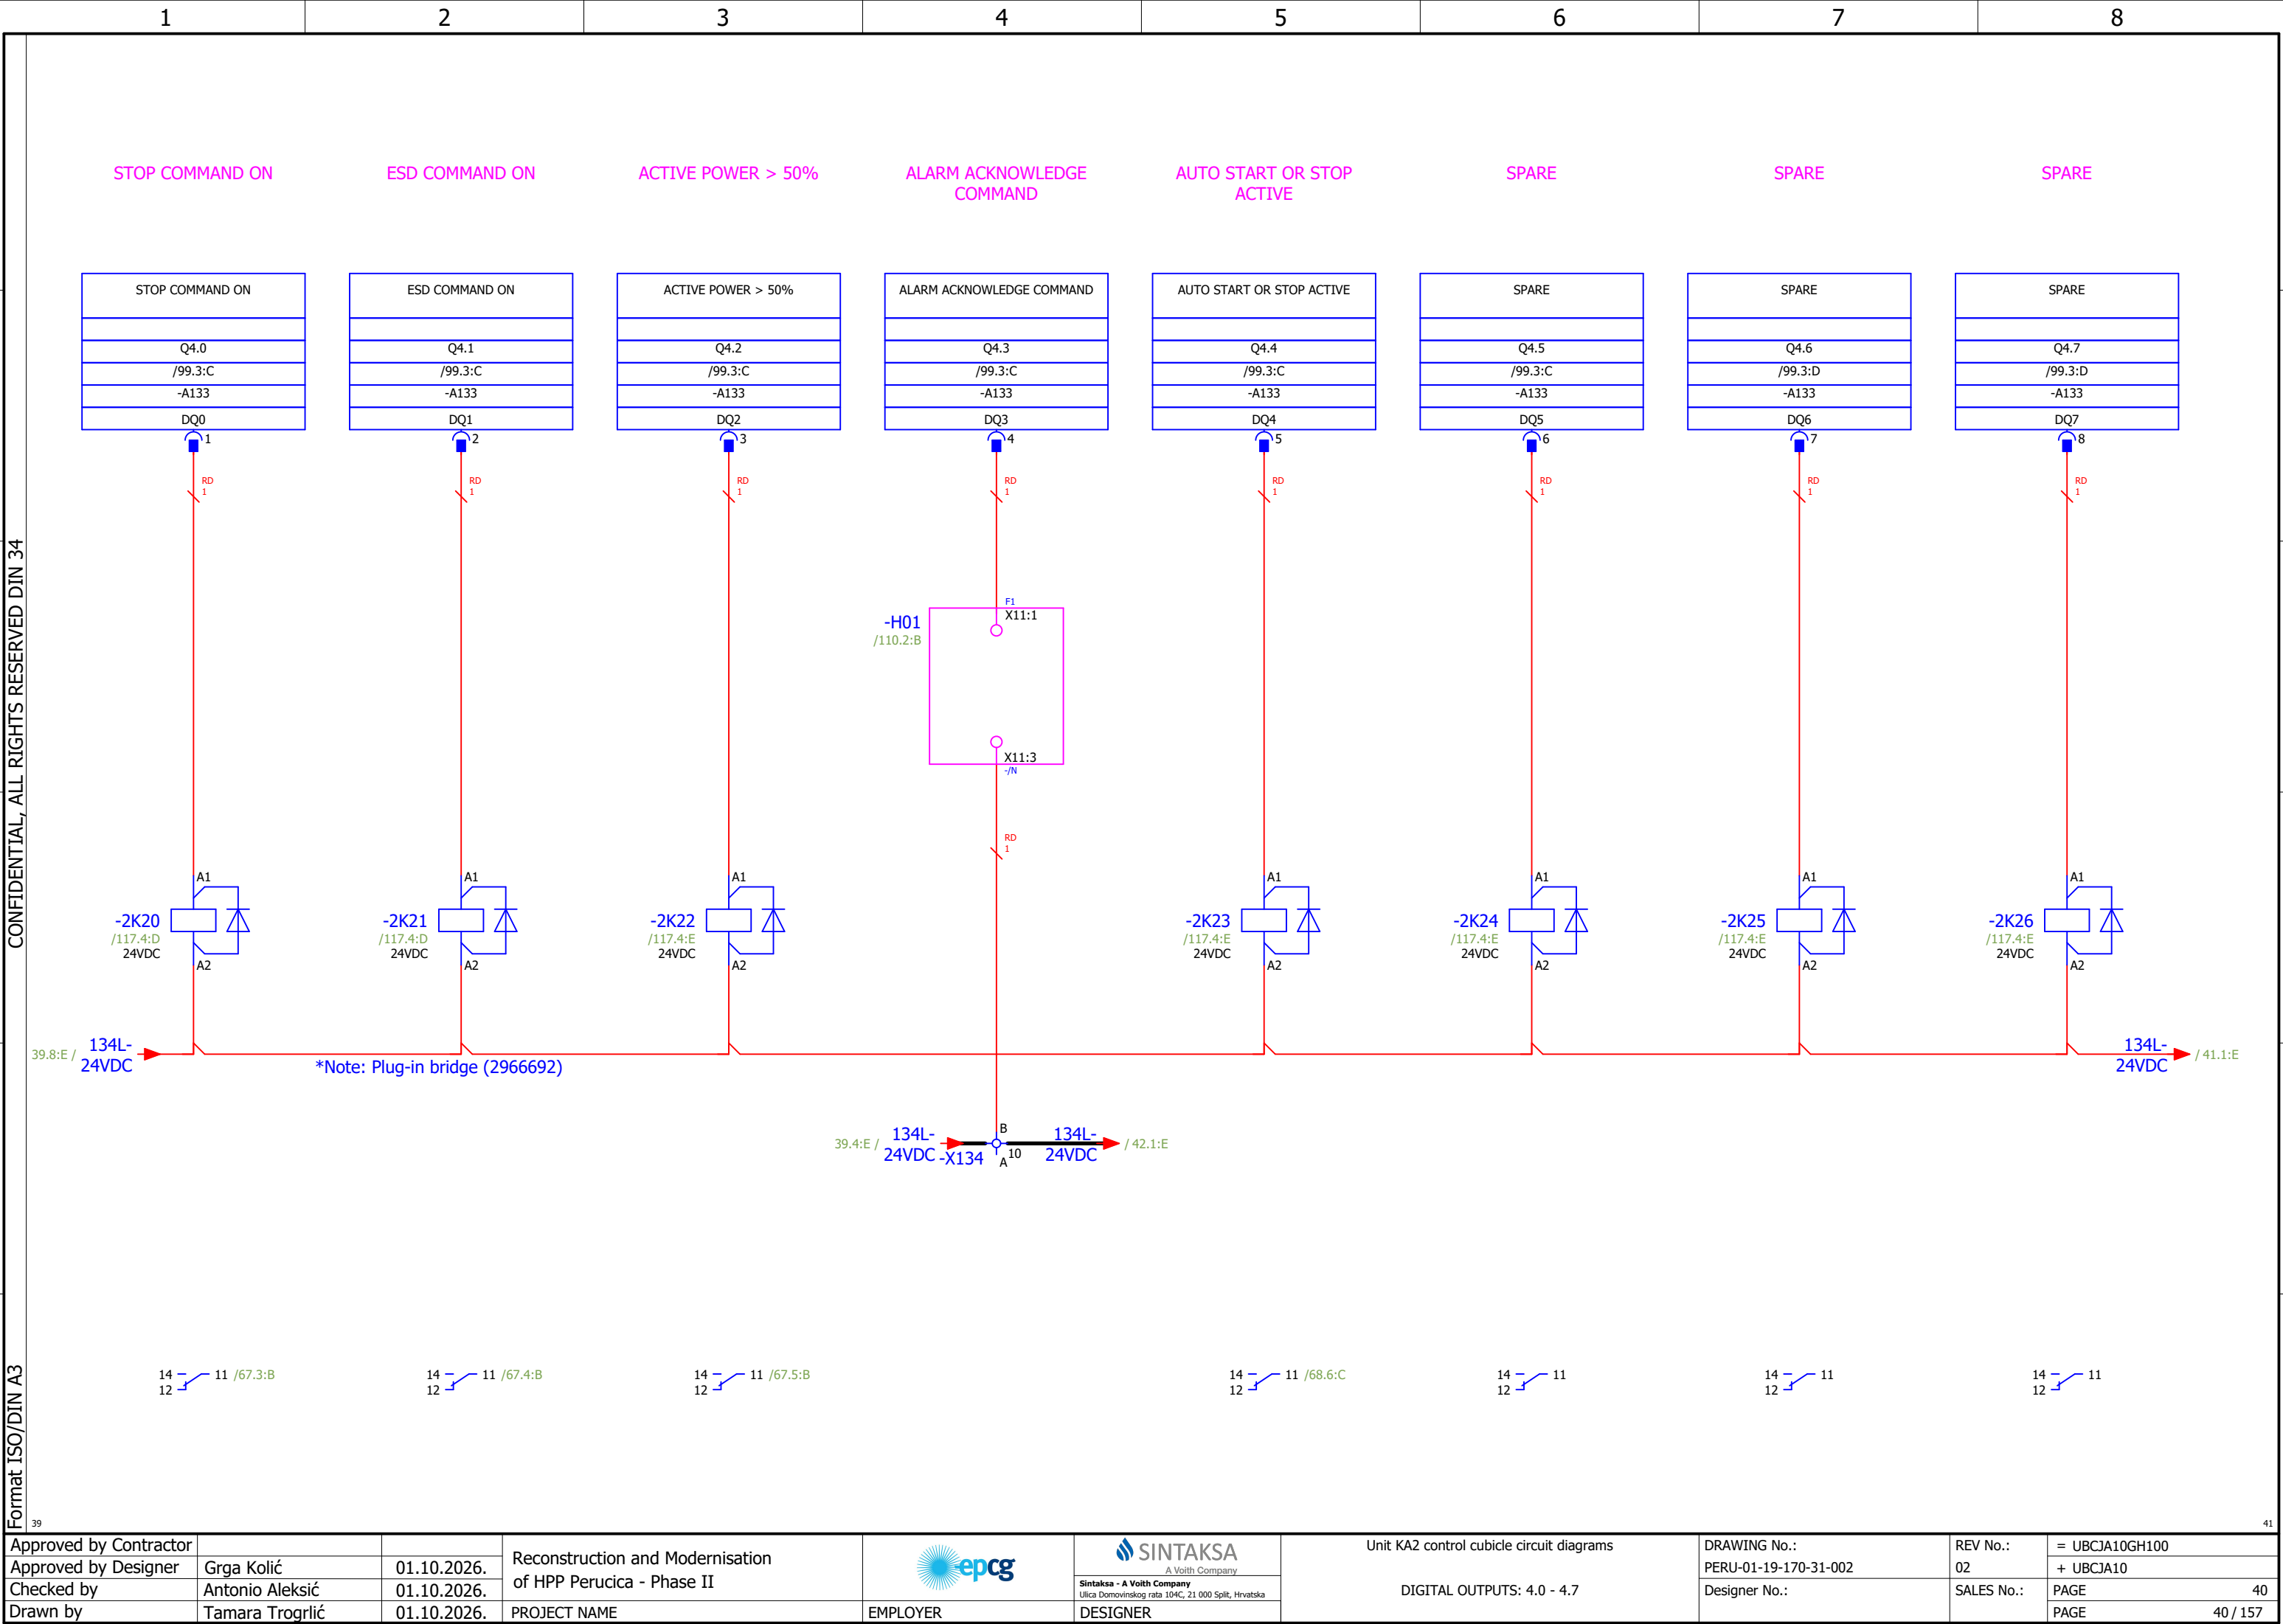


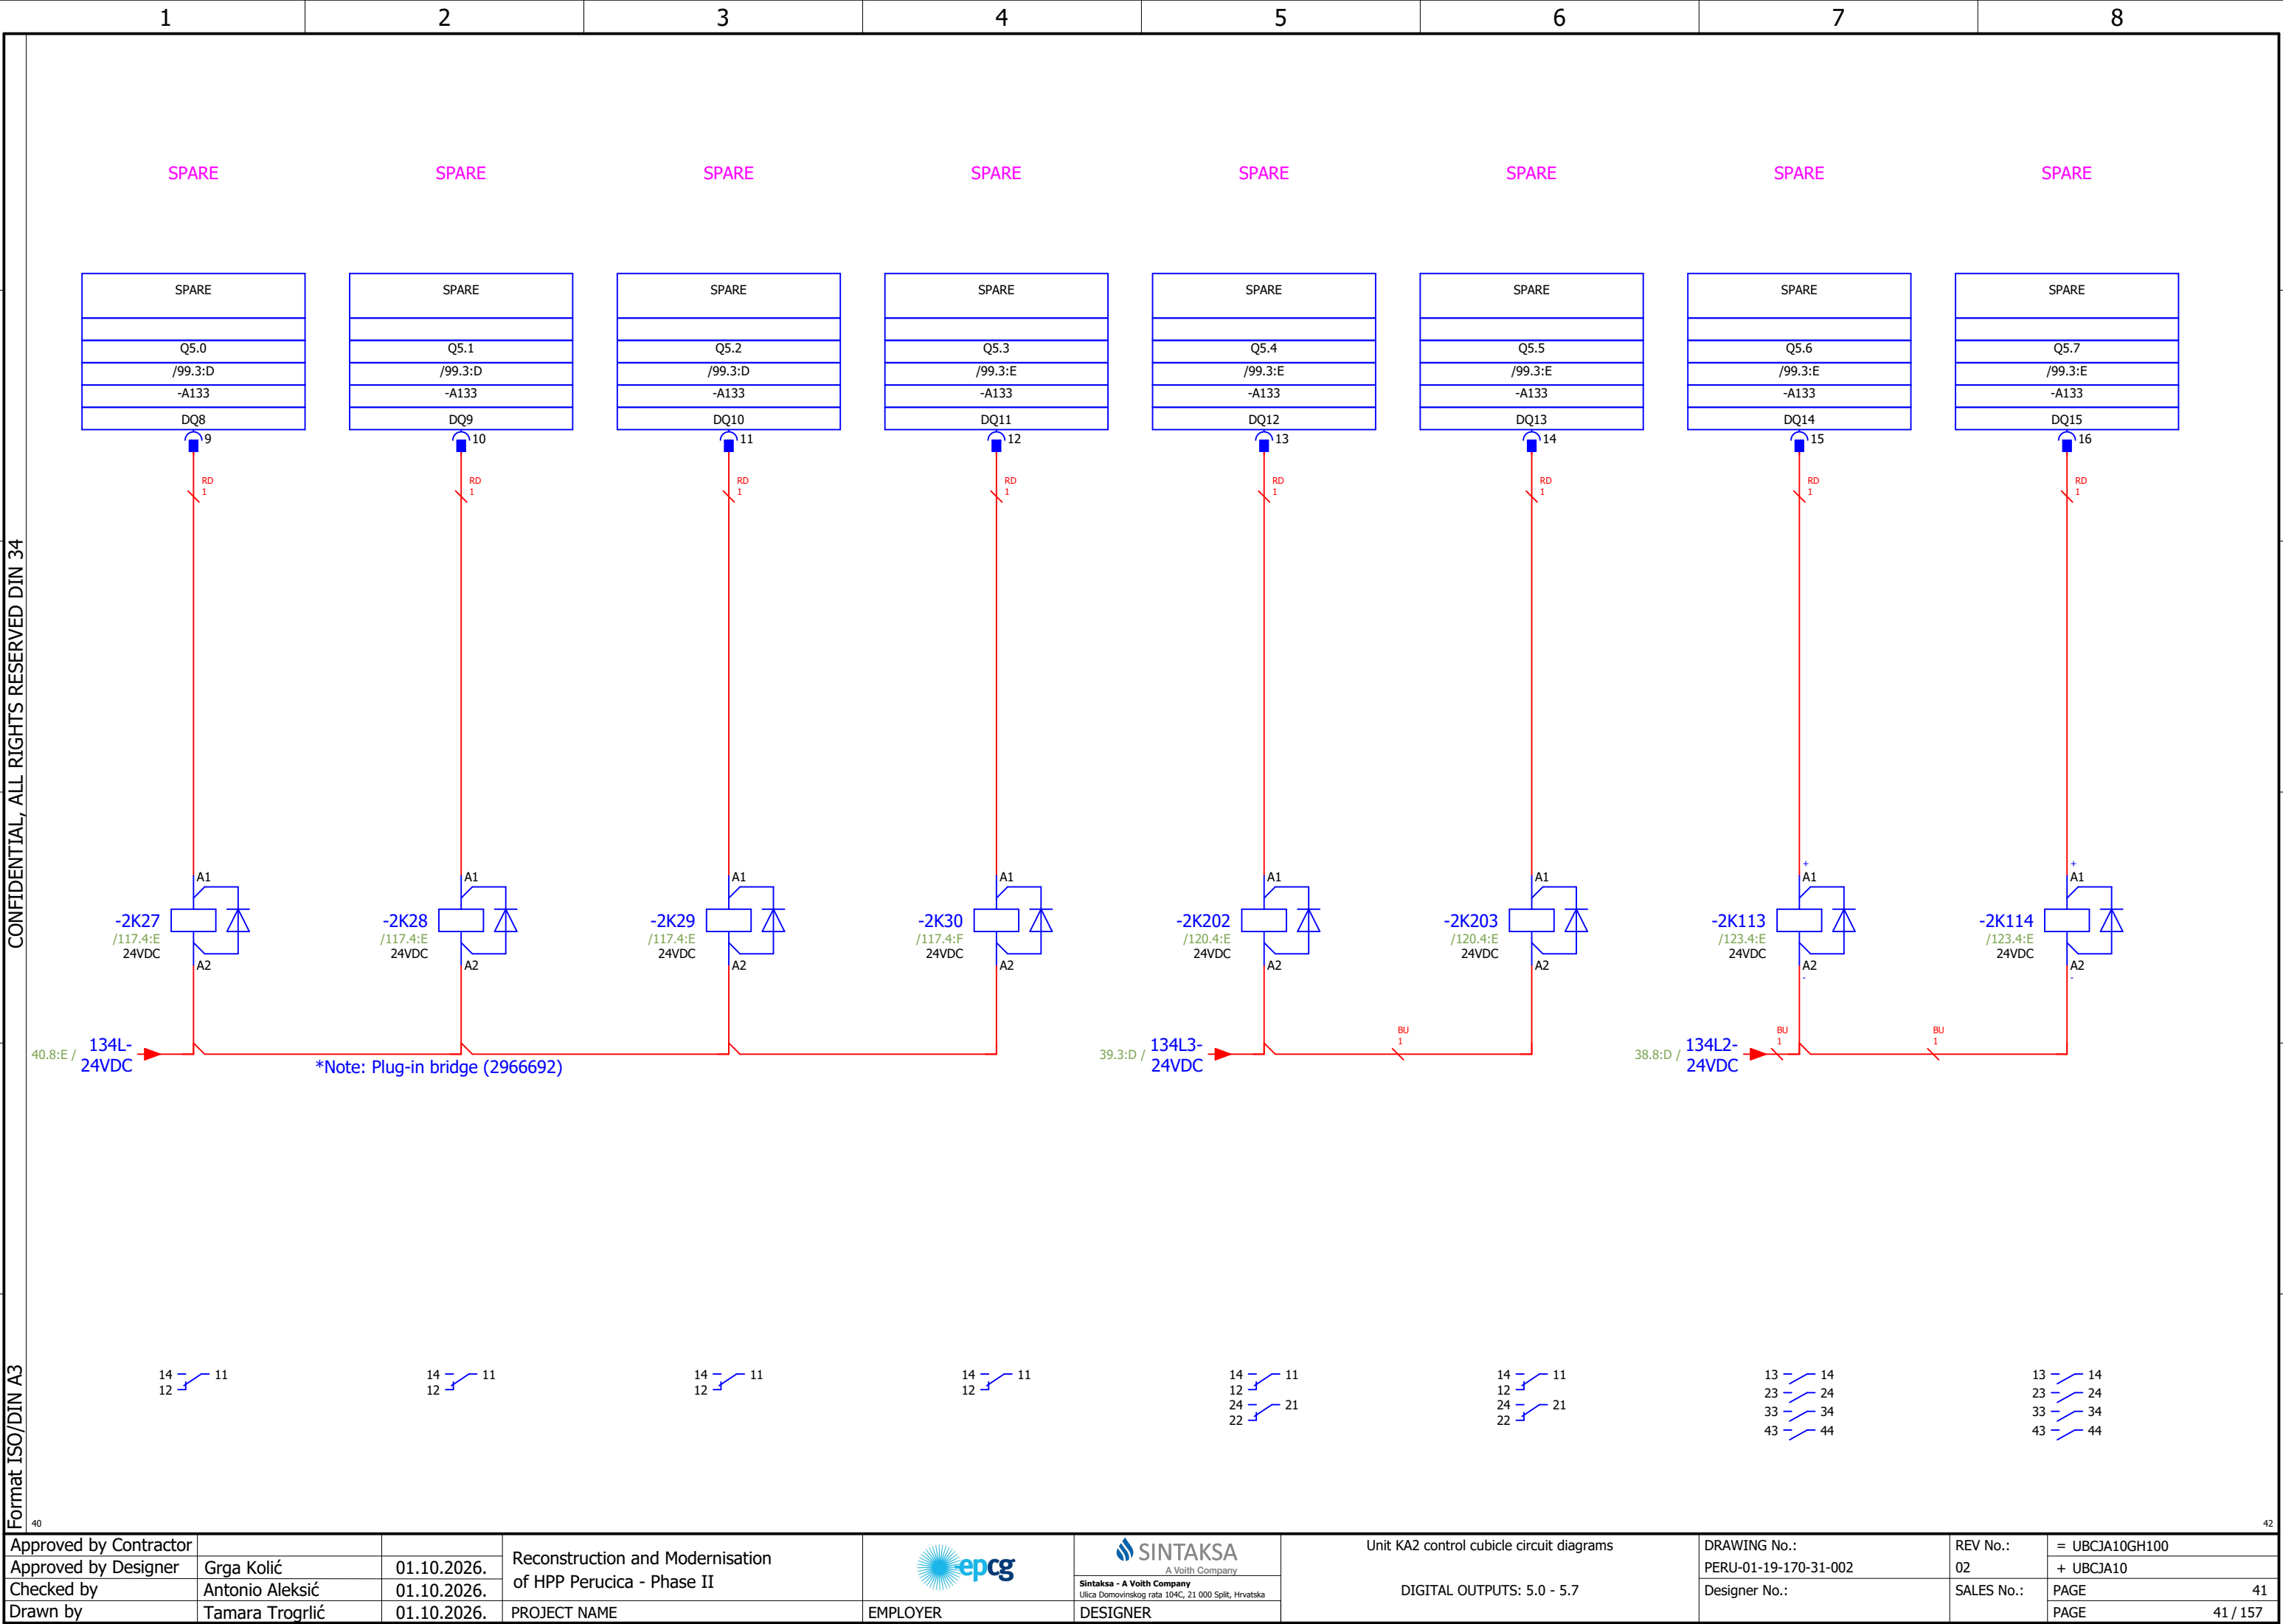

Approved by Contractor			Reconstruction and Modernisation of HPP Perucica - Phase II		 A Voith Company Sintaksa - A Voith Company Ulica Domovinskog rata 104C, 21 000 Split, Hrvatska	Unit KA2 control cubicle circuit diagrams	DRAWING No.:	REV No.:	= UBCJA10GH100
Approved by Designer	Grga Kolić	01.10.2026.					PERU-01-19-170-31-002	02	+ UBCJA10
Checked by	Antonio Aleksić	01.10.2026.					Designer No.:	SALES No.:	PAGE 41
Drawn by	Tamara Trogrlić	01.10.2026.					PROJECT NAME	EMPLOYER	DESIGNER

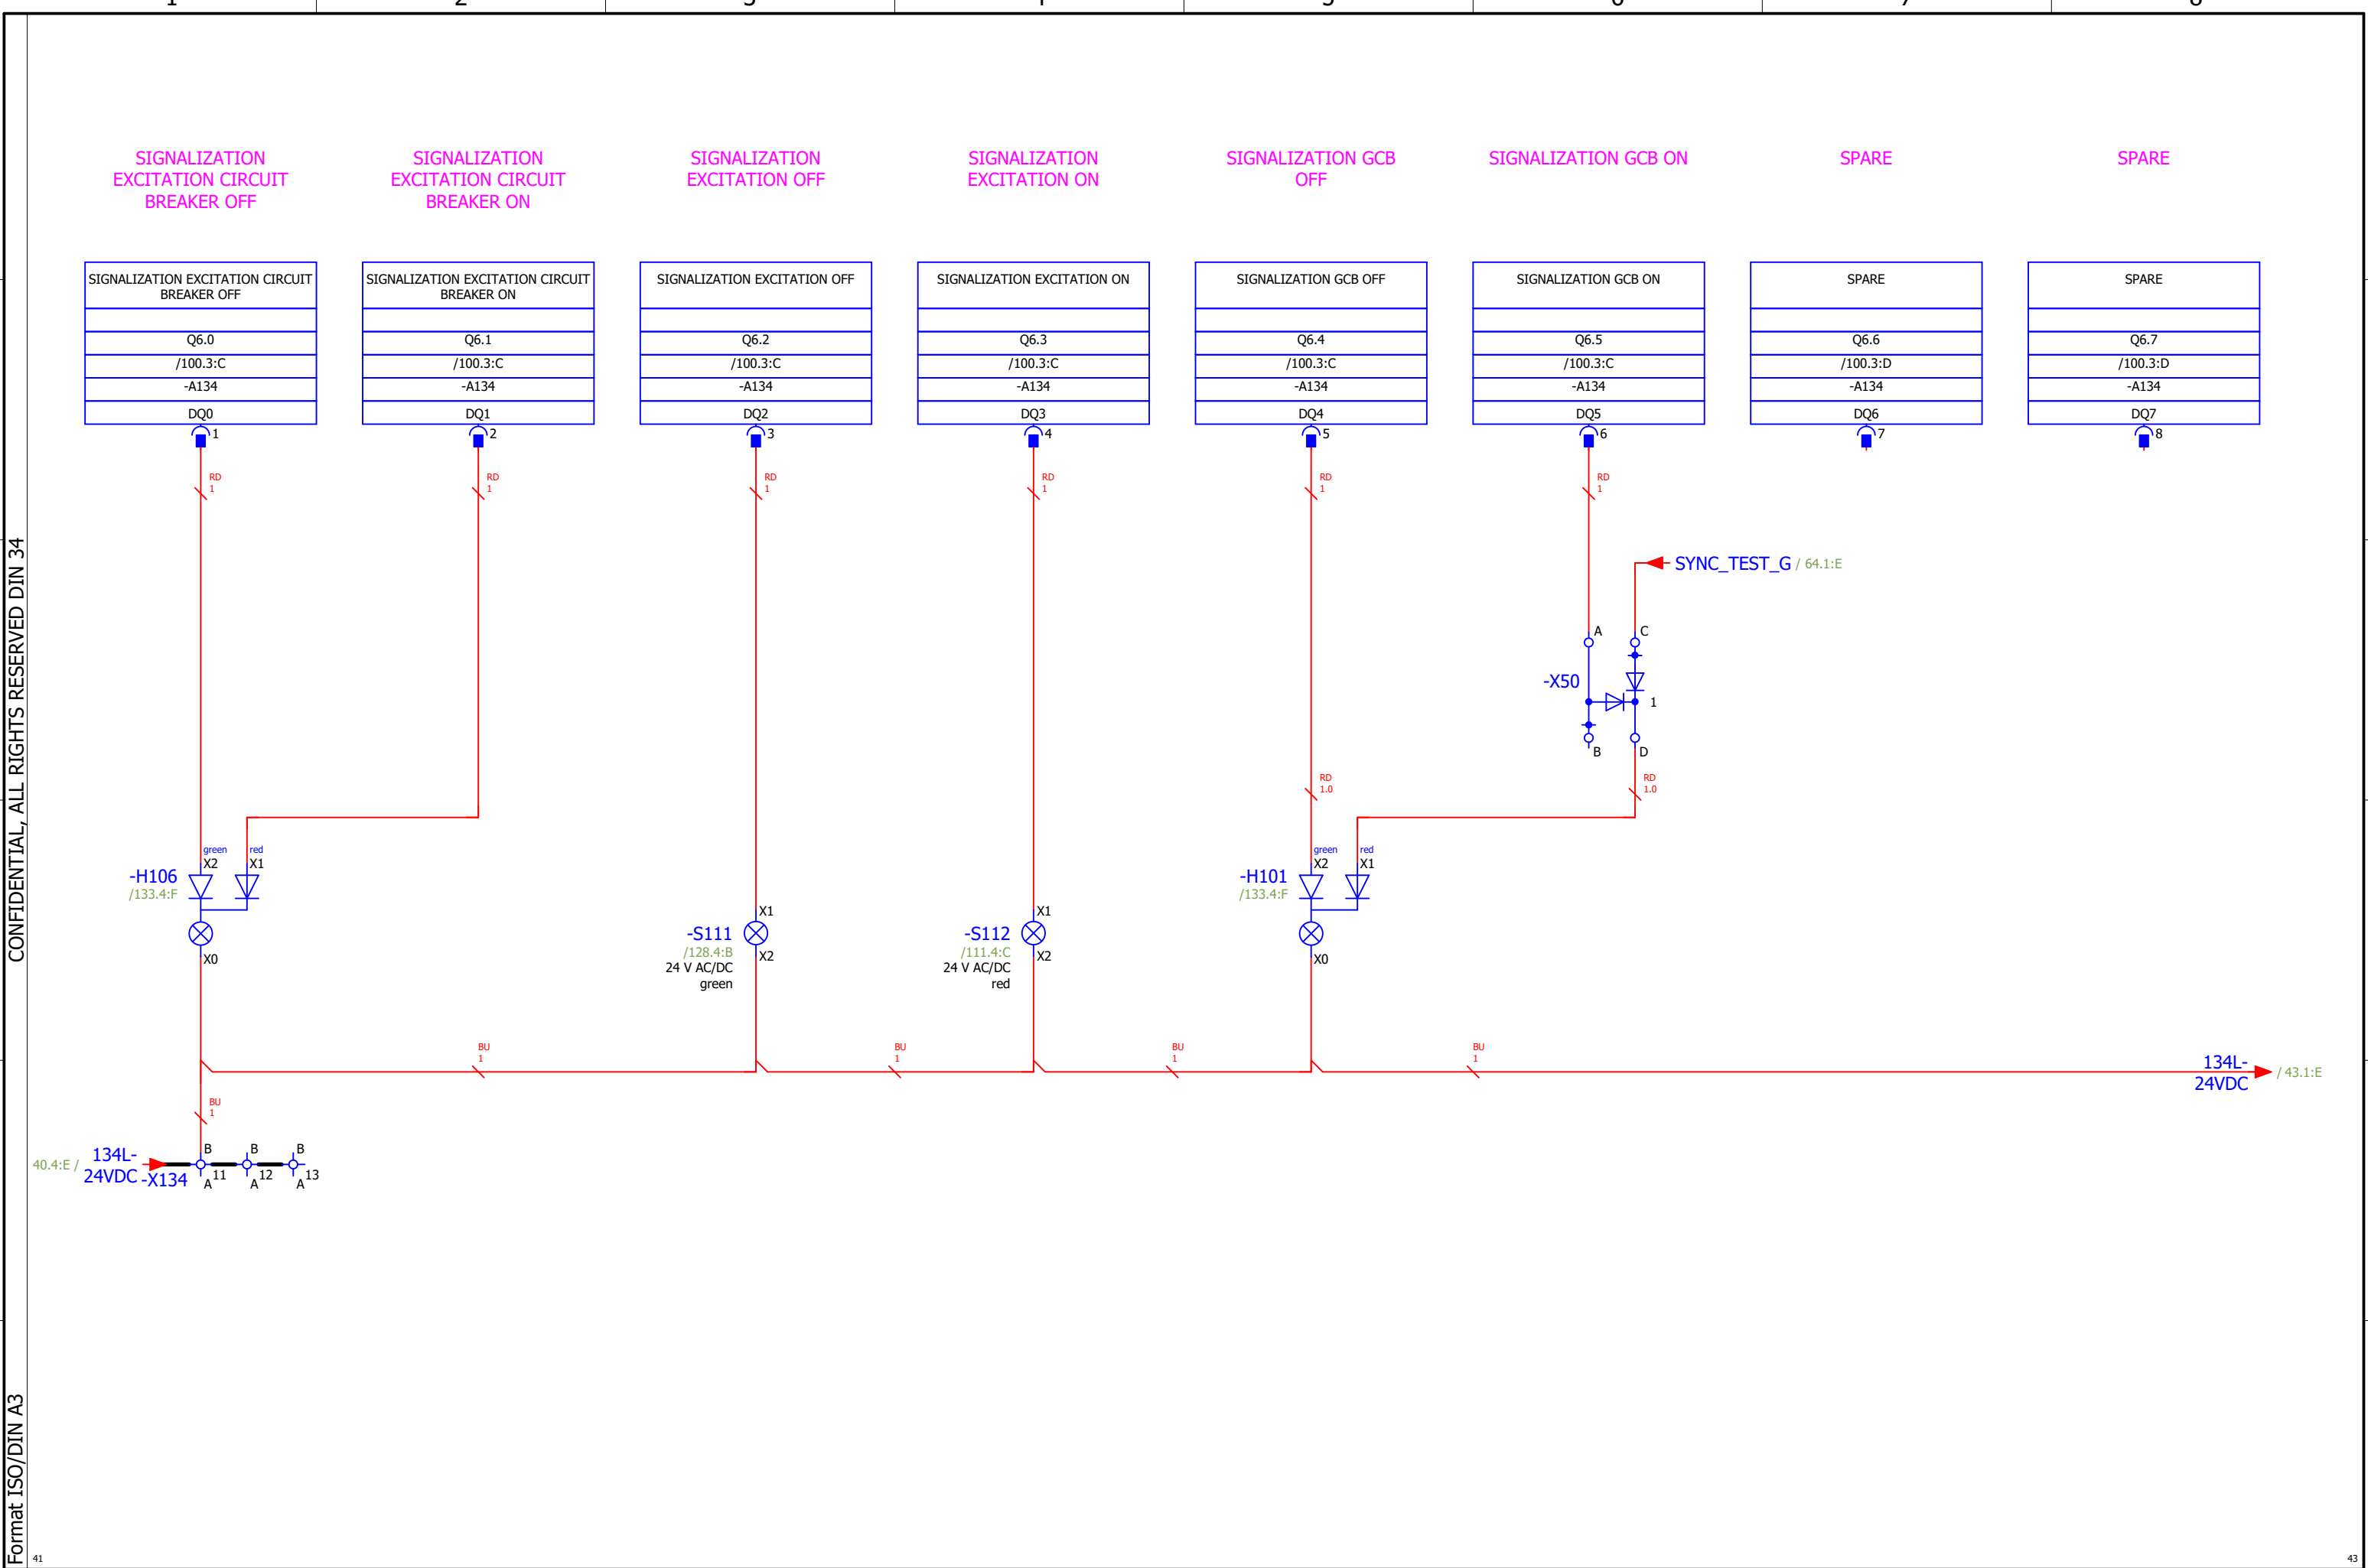


Approved by Contractor			Reconstruction and Modernisation of HPP Perucica - Phase II		 A Voith Company Sintaksa - A Voith Company Ulica Domovinskog rata 104C, 21 000 Split, Hrvatska	Unit KA2 control cubicle circuit diagrams DIGITAL OUTPUTS: 6.0 - 6.7	DRAWING No.: PERU-01-19-170-31-002	REV No.: 02	= UBCJA10GH100 + UBCJA10
Approved by Designer	Grga Kolić	01.10.2026.					Designer No.:	SALES No.:	PAGE 42
Checked by	Antonio Aleksić	01.10.2026.							
Drawn by	Tamara Trogrlić	01.10.2026.							PAGE 42 / 157

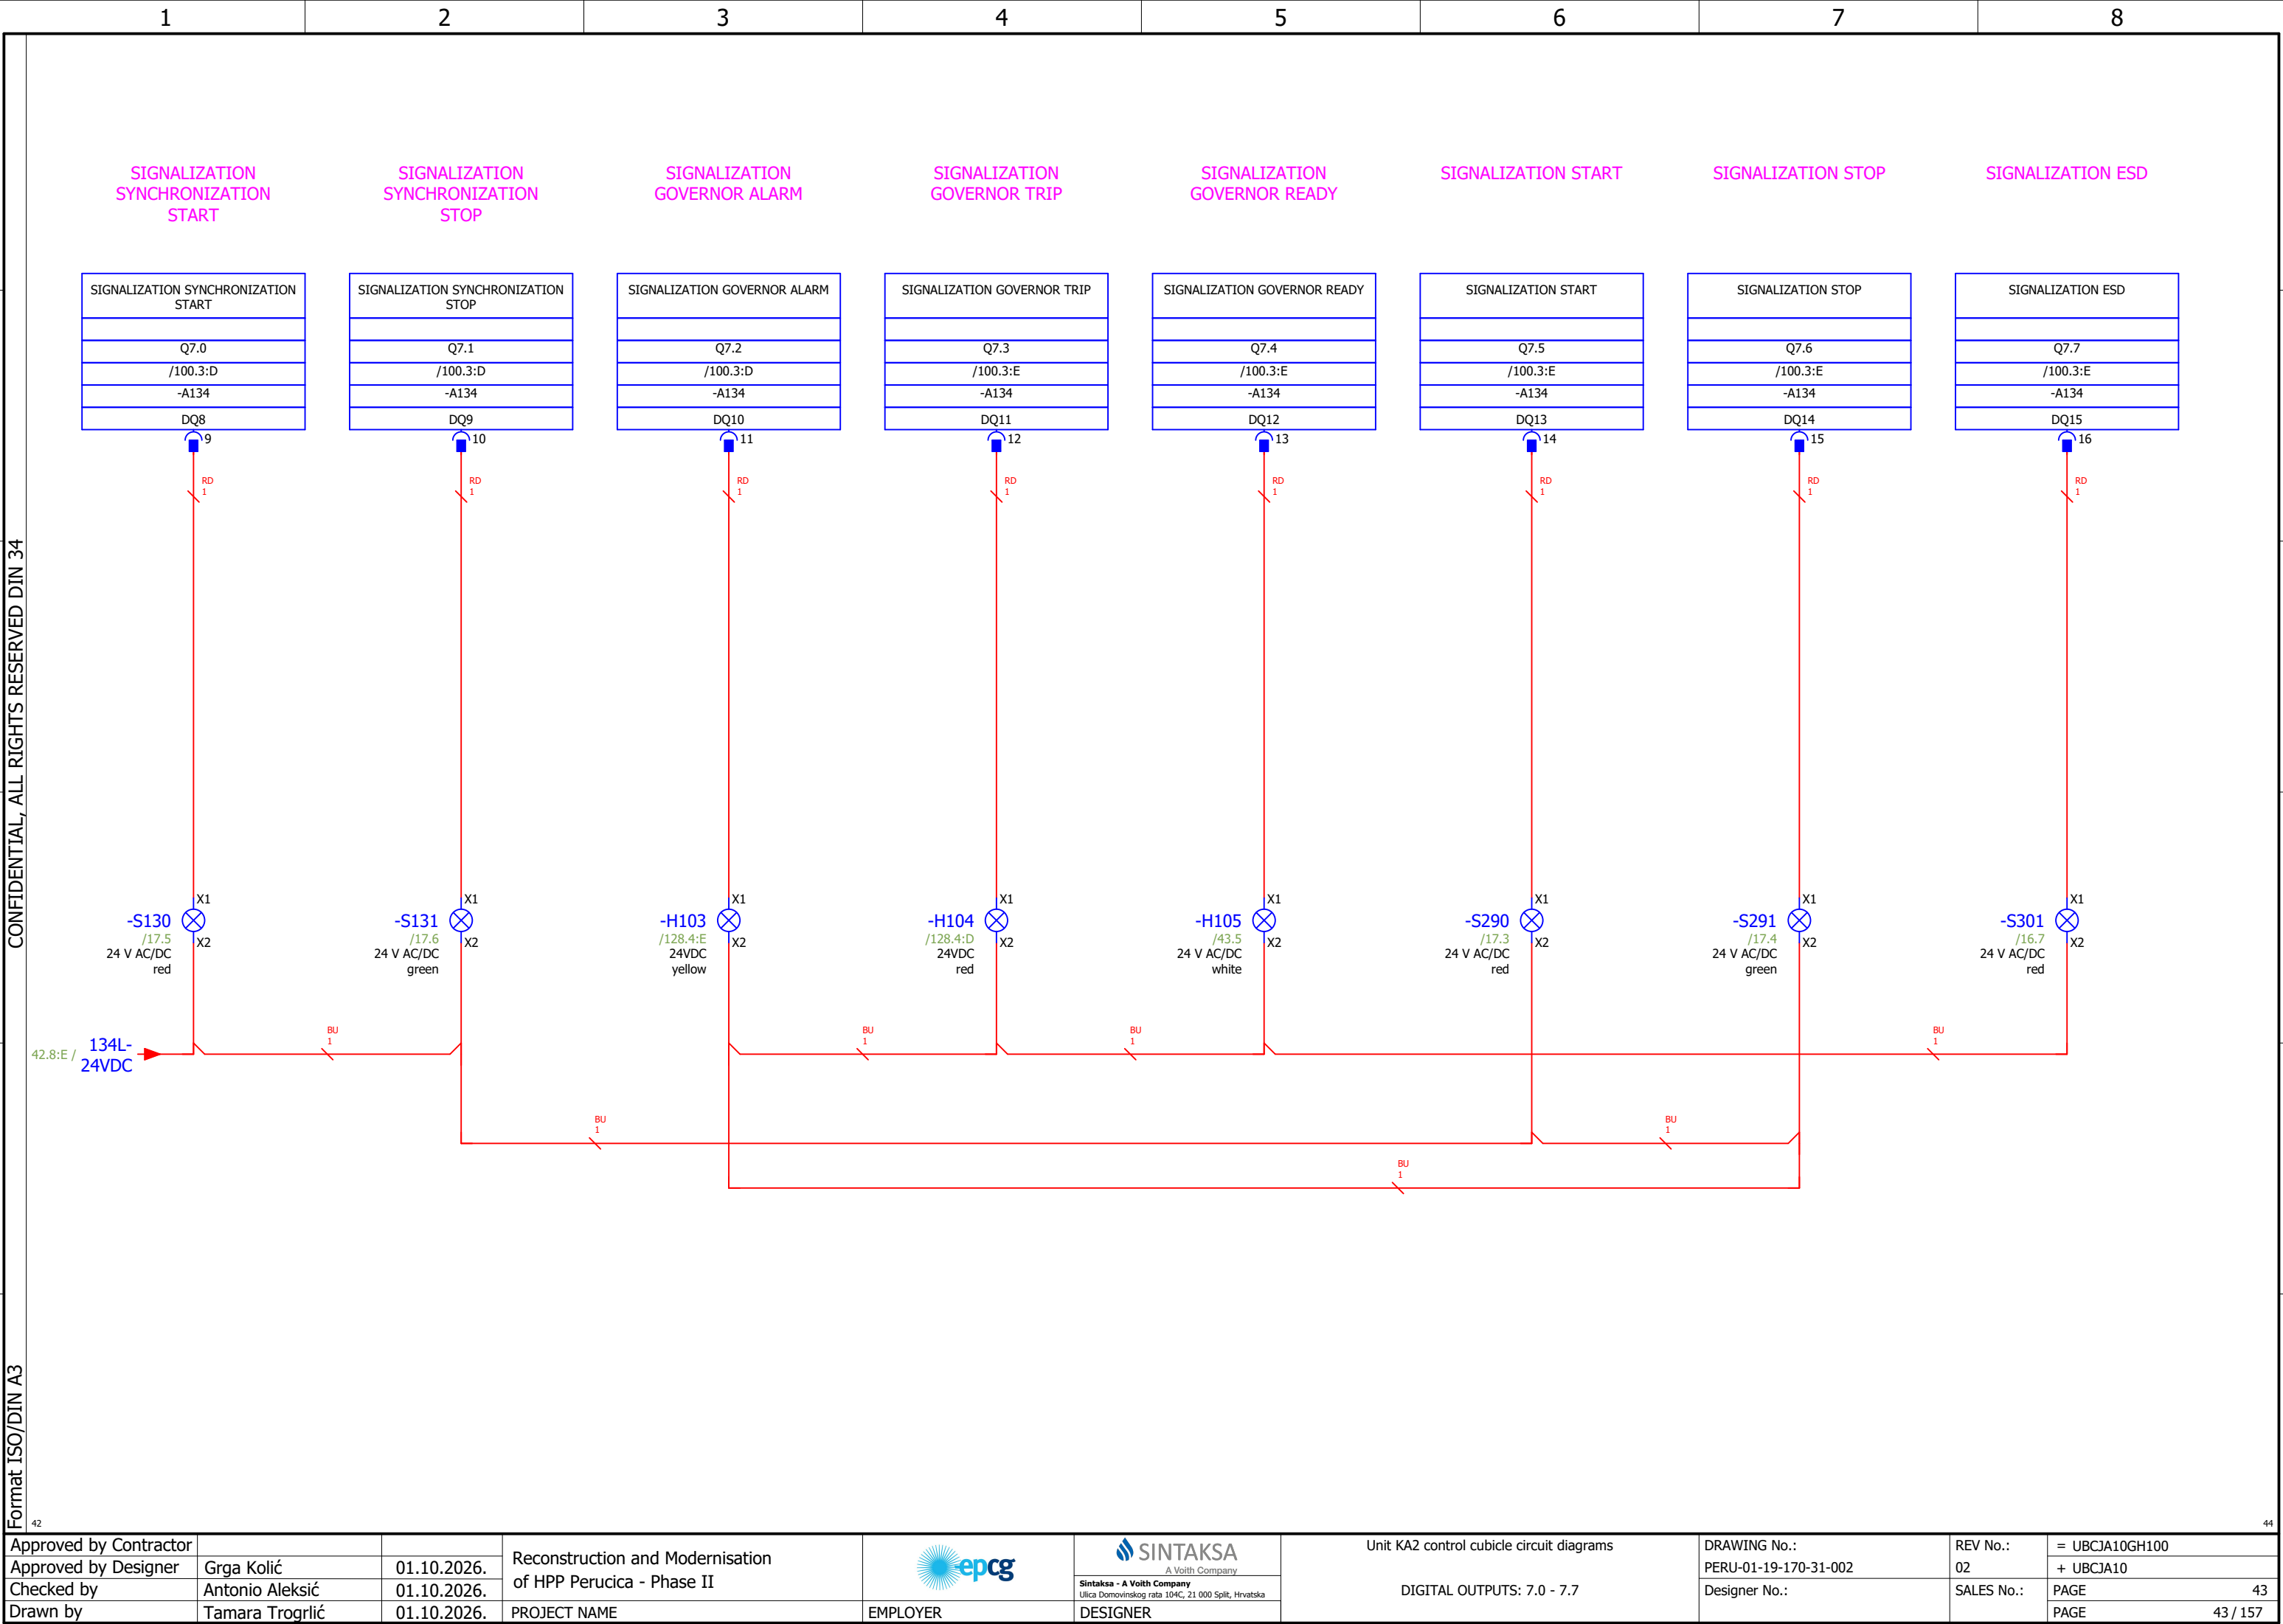

CONFIDENTIAL, ALL RIGHTS RESERVED DIN 34

Format ISO/DIN A3

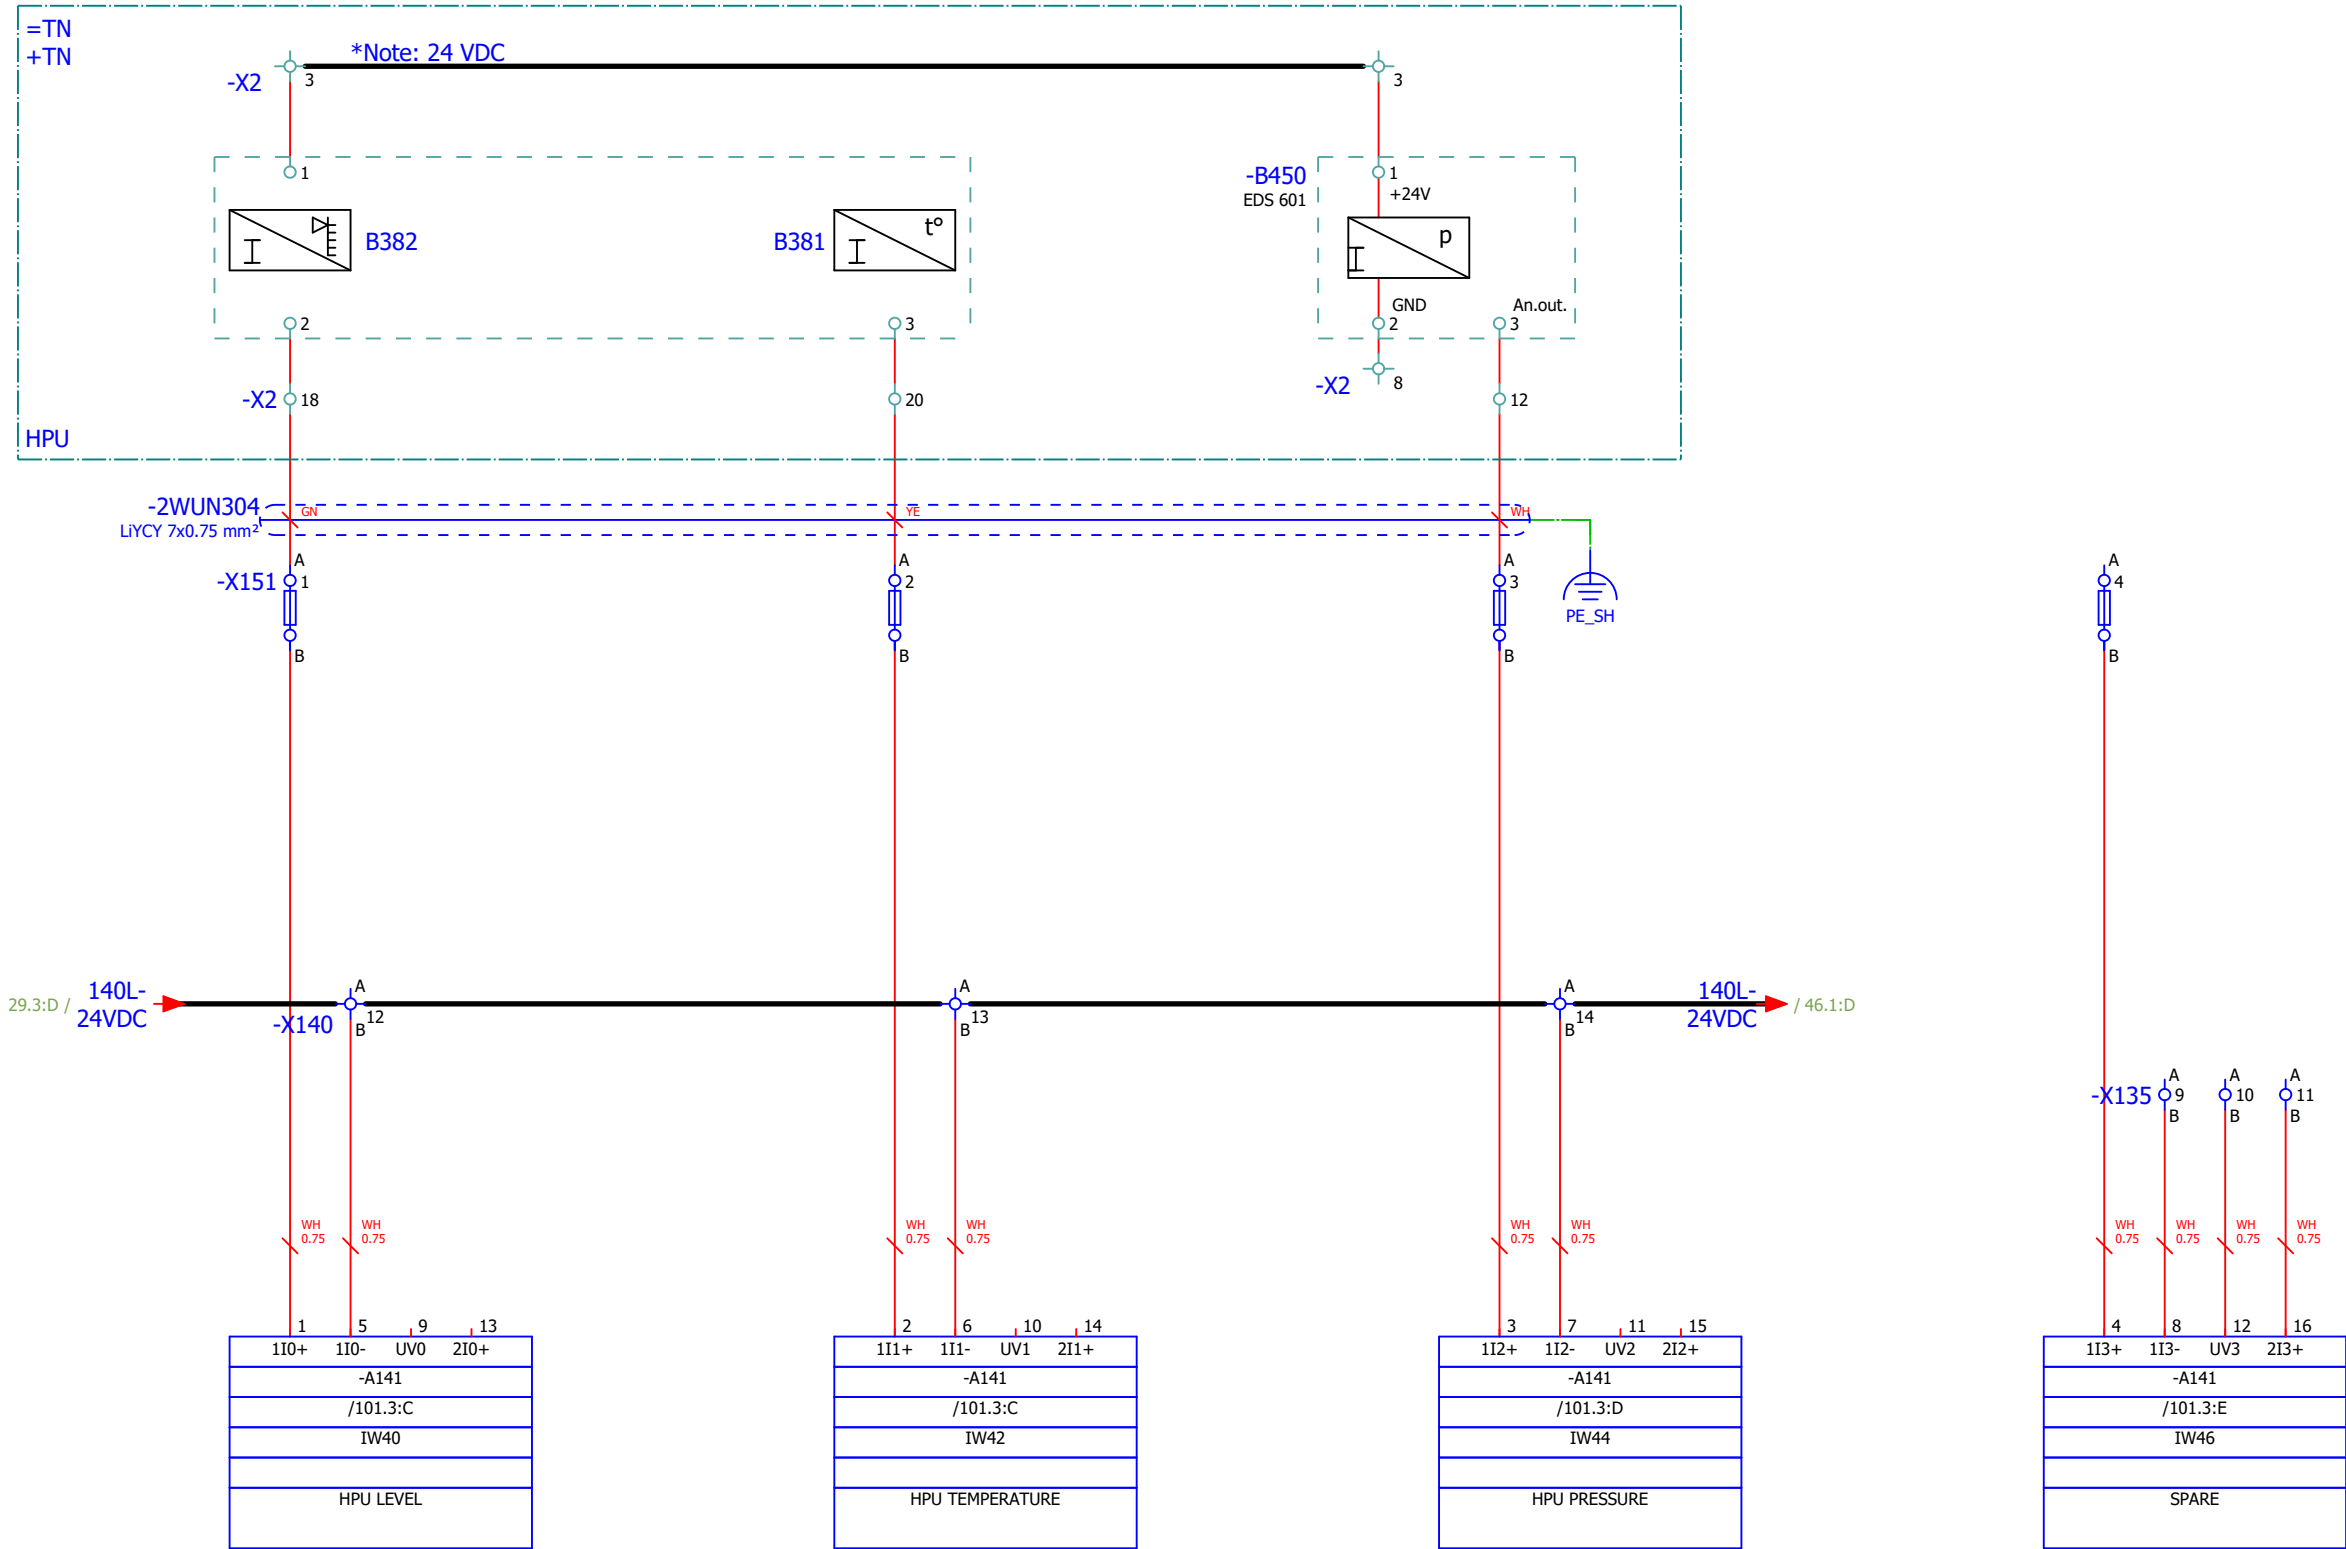

Approved by Contractor			Reconstruction and Modernisation of HPP Perucica - Phase II		 A Voith Company Sintaksa - A Voith Company Ulica Domovinskog rata 104C, 21 000 Split, Hrvatska	Unit KA2 control cubicle circuit diagrams	DRAWING No.:	REV No.:	= UBCJA10GH100	
Approved by Designer	Grga Kolić	01.10.2026.					PERU-01-19-170-31-002	02	+ UBCJA10	
Checked by	Antonio Aleksić	01.10.2026.					ANALOG INPUTS: 1 - 4	Designer No.:	SALES No.:	PAGE 44
Drawn by	Tamara Trogrlić	01.10.2026.						PAGE 44 / 157		
PROJECT NAME			EMPLOYER			DESIGNER				

CONFIDENTIAL, ALL RIGHTS RESERVED DIN 34

Format ISO/DIN A3

44








45 / 157

PENSTOCK PRESSURE

NOZZLE POSITION

SPEED MEASUREMENT 3

SPARE

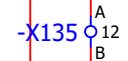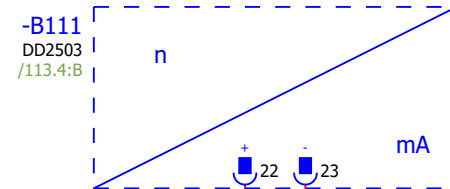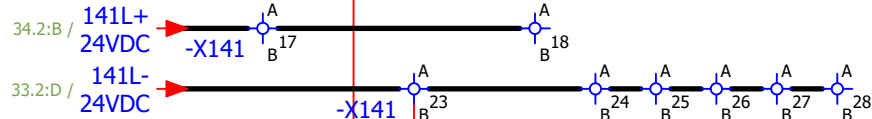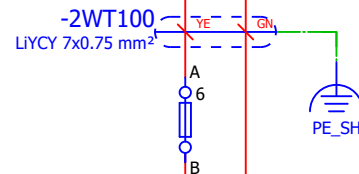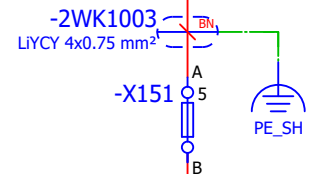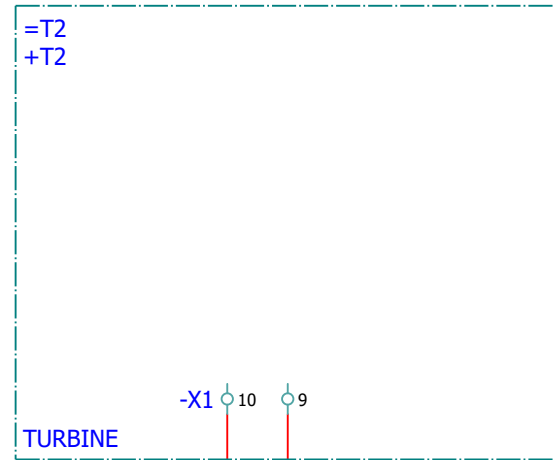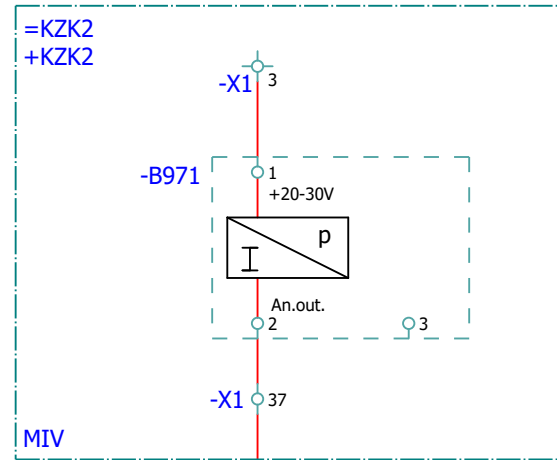

5	10+
7	10-
9	1UV0
13	2UV0
15	2M0
-A151	
/102.3:C	
IW48	
PENSTOCK PRESSURE	



6	11+
8	11-
10	1UV1
14	2UV1
16	2M1
-A151	
/102.3:D	
IW50	
NOZZLE POSITION	

5	10+
7	10-
9	1UV0
13	2UV0
15	2M0
-A152	
/103.3:C	
IW52	
SPEED MEASUREMENT 3	

6	11+
8	11-
10	1UV1
14	2UV1
16	2M1
-A152	
/103.3:D	
IW54	
SPARE	

Approved by Contractor			Reconstruction and Modernisation of HPP Perucica - Phase II		 A Voith Company Sintaksa - A Voith Company Ulica Domovinskog rata 104C, 21 000 Split, Hrvatska	Unit KA2 control cubicle circuit diagrams ANALOG INPUTS: 5 - 8	DRAWING No.: PERU-01-19-170-31-002	REV No.: 02	= UBCJA10GH100 + UBCJA10
Approved by Designer	Grga Kolić	01.10.2026.					Designer No.:	SALES No.:	PAGE 45
Checked by	Antonio Aleksić	01.10.2026.							
Drawn by	Tamara Trogrlić	01.10.2026.							PAGE 45 / 157

TURBINE SPEED

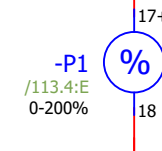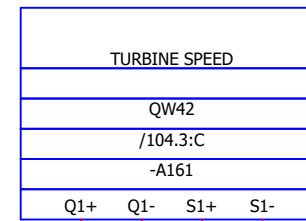

Approved by Contractor			Reconstruction and Modernisation of HPP Perucica - Phase II		 A Voith Company Sintaksa - A Voith Company Ulica Domovinskog rata 104C, 21 000 Split, Hrvatska	Unit KA2 control cubicle circuit diagrams	DRAWING No.:	REV No.:	= UBCJA10GH100
Approved by Designer	Grga Kolić	01.10.2026.					PERU-01-19-170-31-002	02	+ UBCJA10
Checked by	Antonio Aleksić	01.10.2026.					ANALOG OUTPUTS: 1 - 2	Designer No.:	SALES No.:
Drawn by	Tamara Trogrlić	01.10.2026.	PROJECT NAME	EMPLOYER	DESIGNER				PAGE 46 / 157

CONFIDENTIAL, ALL RIGHTS RESERVED DIN 34

Format ISO/DIN A3

46

48

Approved by Contractor			Reconstruction and Modernisation of HPP Perucica - Phase II		 A Voith Company Sintaksa - A Voith Company Ulica Domovinskog rata 104C, 21 000 Split, Hrvatska	Unit KA2 control cubicle circuit diagrams ANALOG OUTPUTS: 3 - 4	DRAWING No.: PERU-01-19-170-31-002	REV No.: 02	= UBCJA10GH100 + UBCJA10
Approved by Designer	Grga Kolić	01.10.2026.					Designer No.:	SALES No.:	PAGE 47
Checked by	Antonio Aleksić	01.10.2026.							
Drawn by	Tamara Trogrlić	01.10.2026.	PROJECT NAME	EMPLOYER	DESIGNER				PAGE 47 / 157

CONFIDENTIAL, ALL RIGHTS RESERVED DIN 34

Format ISO/DIN A3

47

Approved by Contractor			Reconstruction and Modernisation of HPP Perucica - Phase II		 A Voith Company Sintaksa - A Voith Company Ulica Domovinskog rata 104C, 21 000 Split, Hrvatska	Unit KA2 control cubicle circuit diagrams SPEED MEASUREMENT	DRAWING No.: PERU-01-19-170-31-002		REV No.: 02	= UBCJA10GH100 + UBCJA10	
Approved by Designer	Grga Kolić	01.10.2026.					Designer No.:		SALES No.:	PAGE	48
Checked by	Antonio Aleksić	01.10.2026.								PAGE	48 / 157
Drawn by	Tamara Trogrlić	01.10.2026.									

12345678

A

B

C

D

E

F

A

B

C

D


E

F

SPEED
MEASUREMENT 1

SPEED
MEASUREMENT 2


SPEED
MEASUREMENT 3

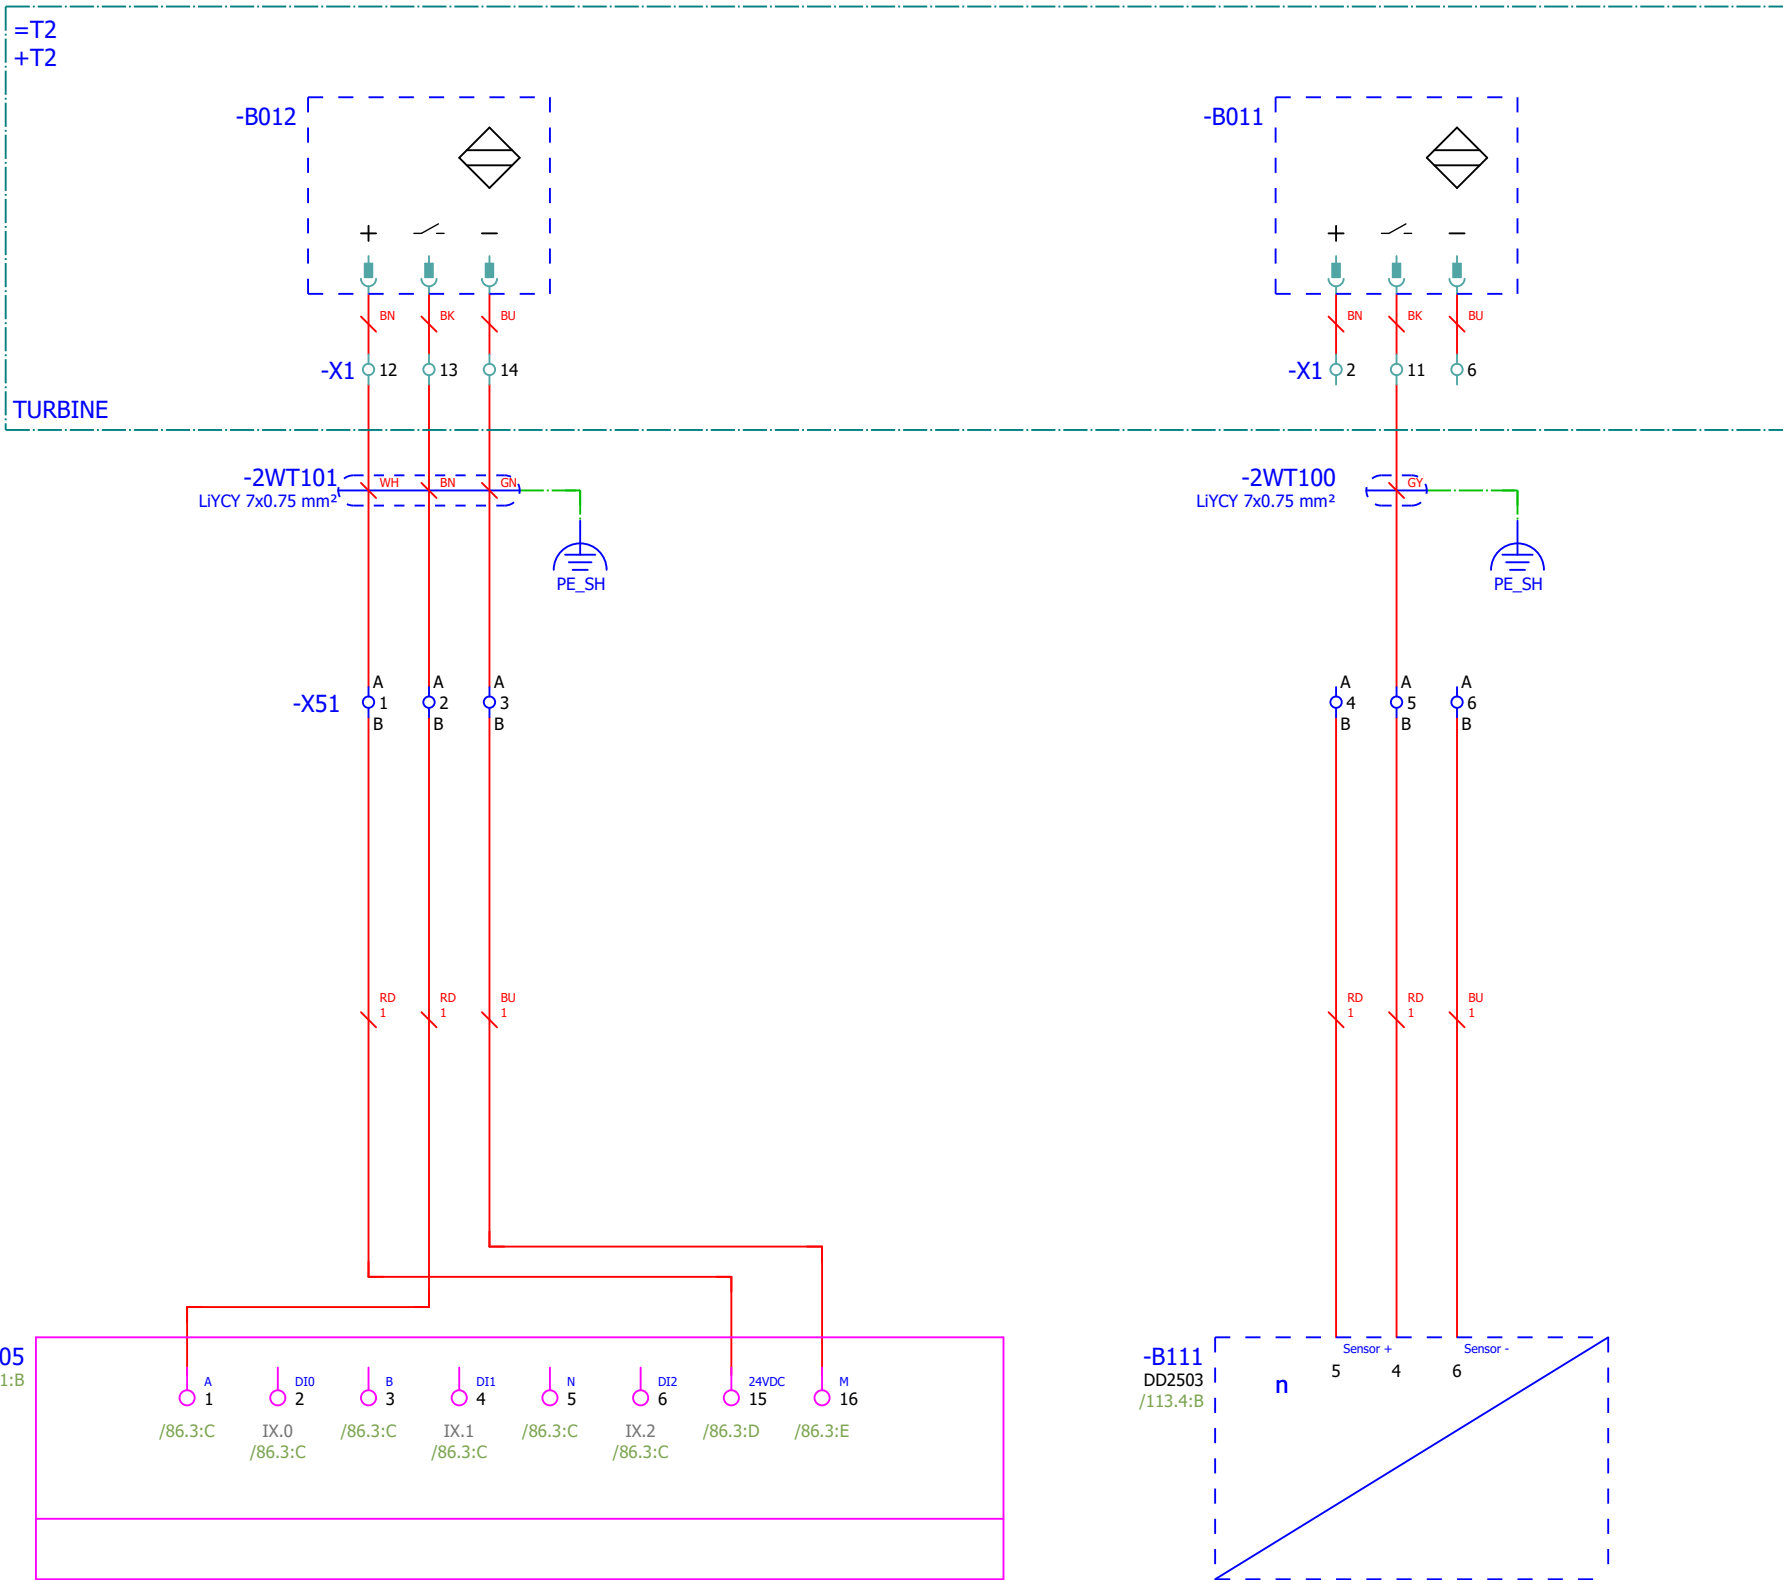

Format ISO/DIN A3



CONFIDENTIAL, ALL RIGHTS RESERVED DIN 34
Format ISO/DIN A3

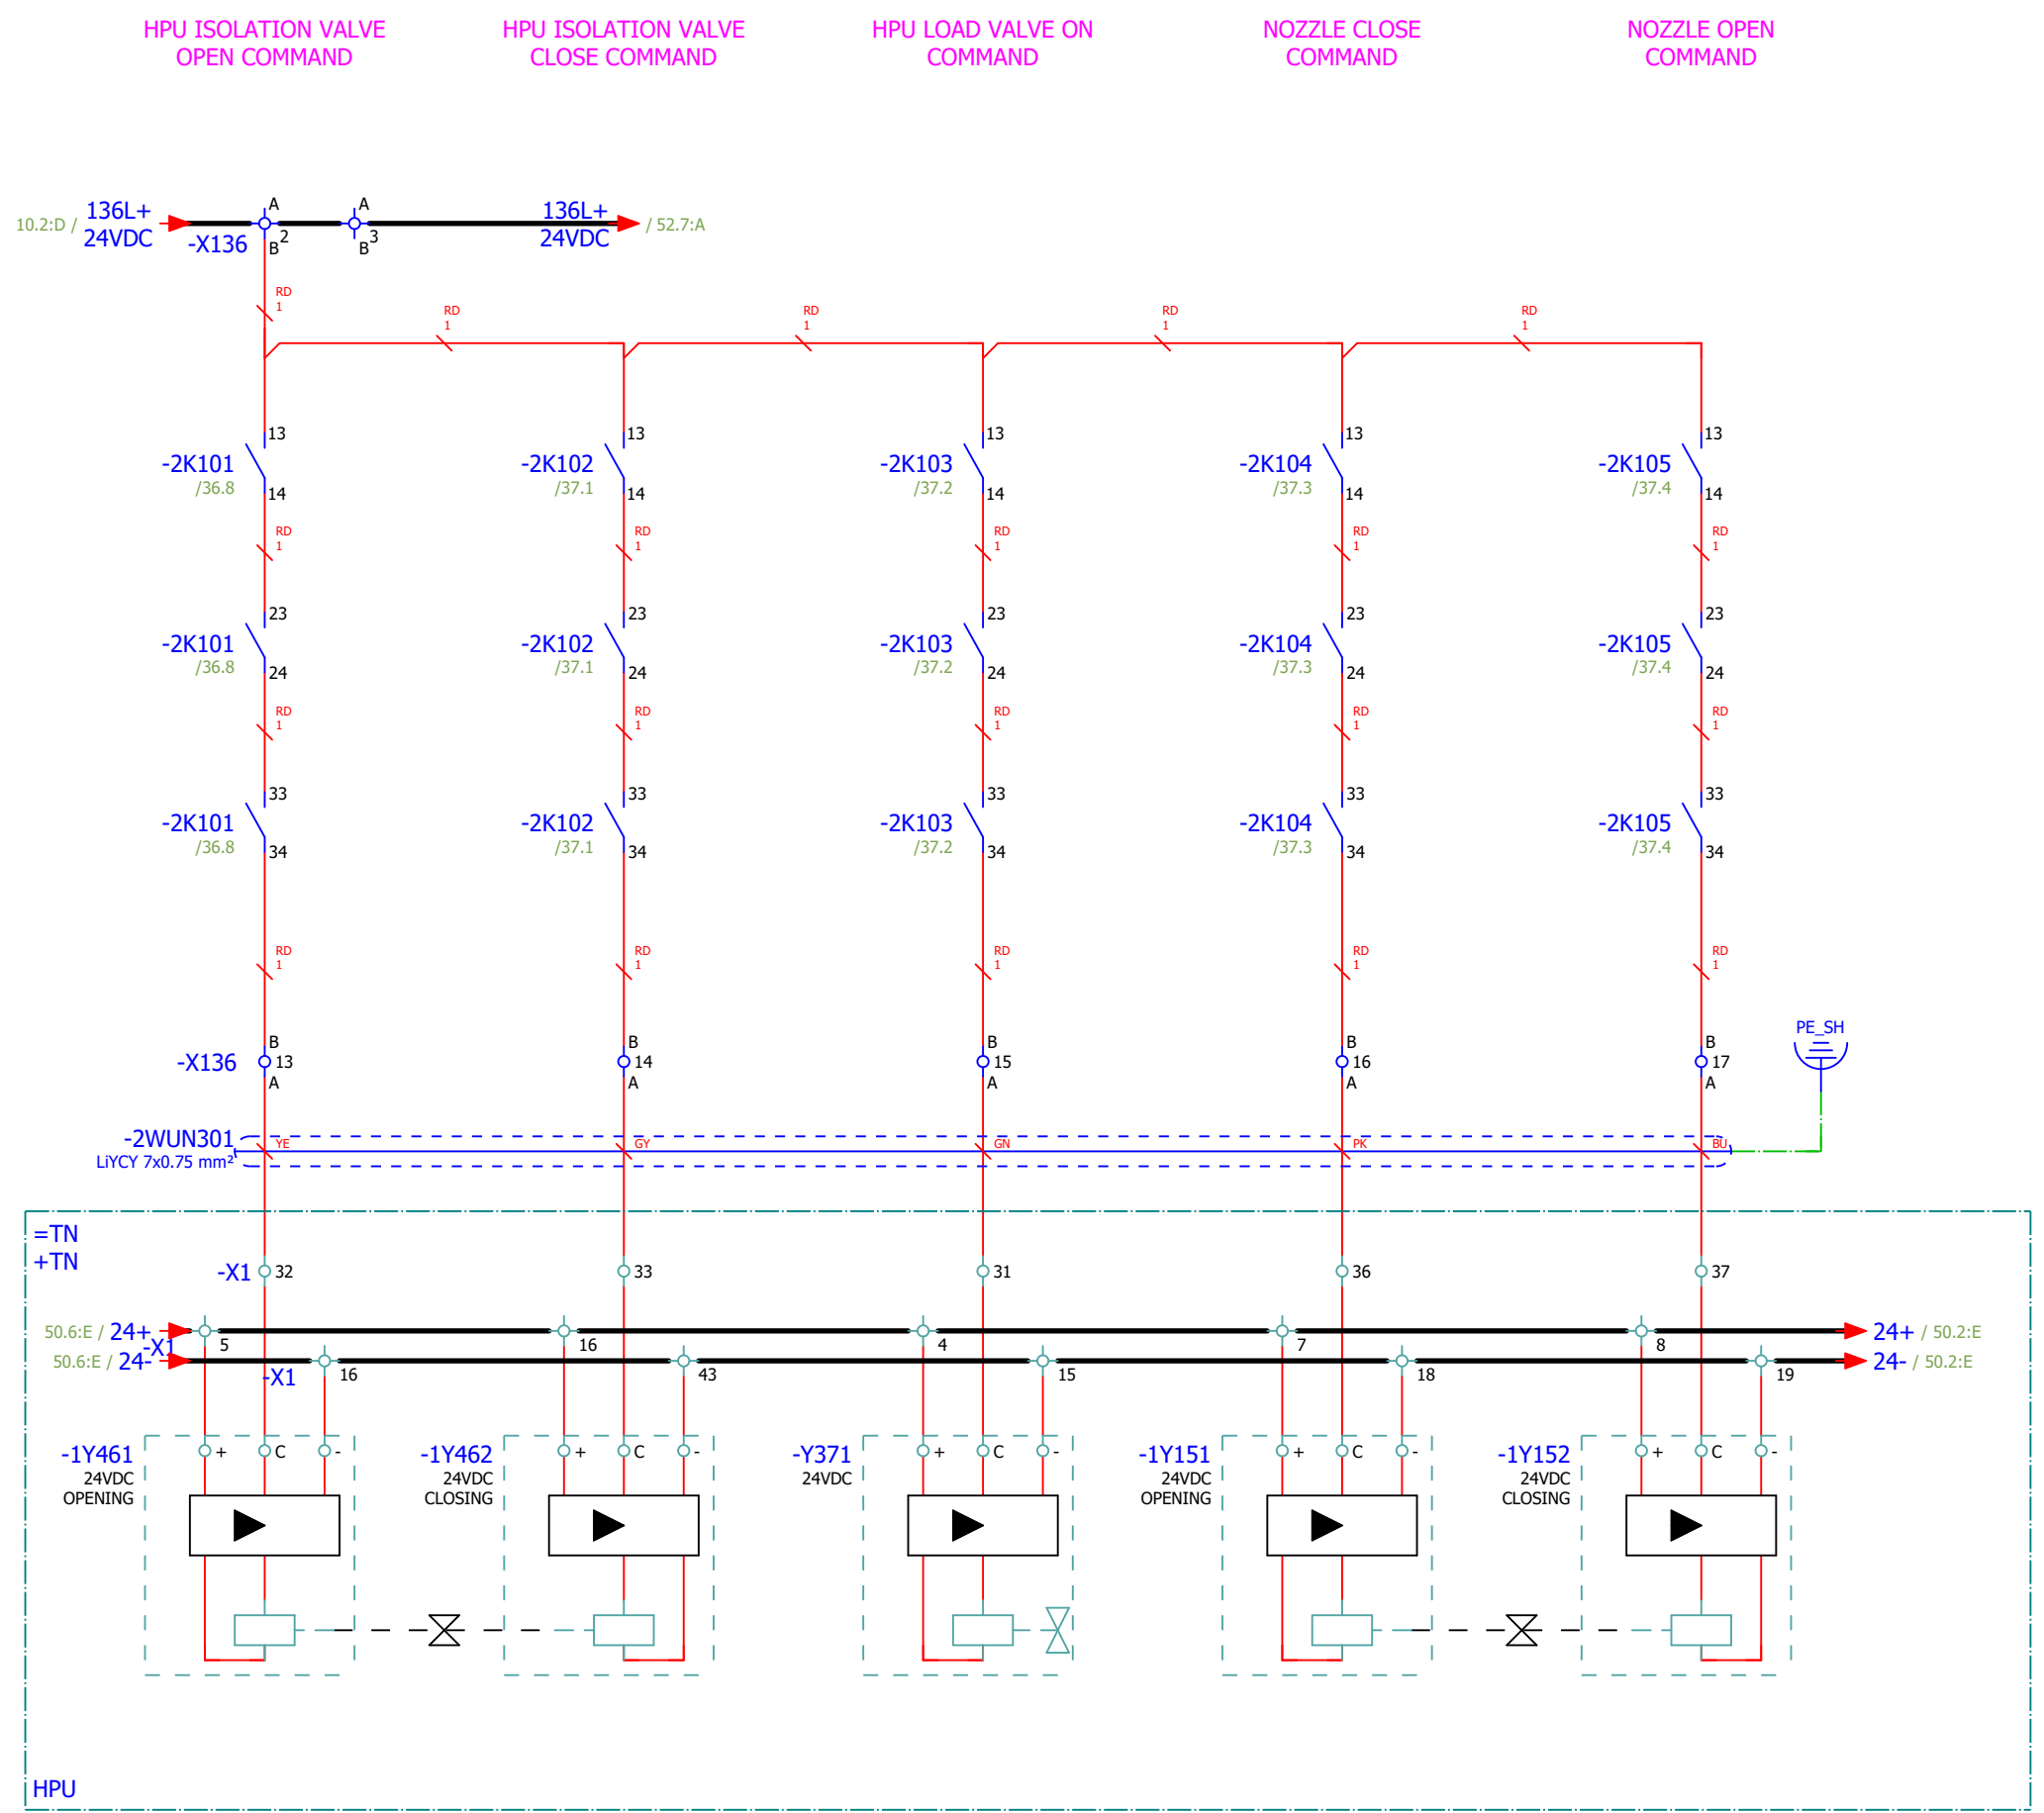

Approved by Contractor			Reconstruction and Modernisation of HPP Perucica - Phase II		 A Voith Company Sintaksa - A Voith Company Ulica Domovinskog rata 104C, 21 000 Split, Hrvatska	Unit KA2 control cubicle circuit diagrams HPU CONTROL	DRAWING No.: PERU-01-19-170-31-002	REV No.: 02	= UBCJA10GH100 + UBCJA10
Approved by Designer	Grga Kolić	01.10.2026.					Designer No.:	SALES No.:	PAGE 50
Checked by	Antonio Aleksić	01.10.2026.							
Drawn by	Tamara Trogrlić	01.10.2026.							PAGE 50 / 157


CONFIDENTIAL, ALL RIGHTS RESERVED DIN 34

Format ISO/DIN A3

50


Approved by Contractor			Reconstruction and Modernisation of HPP Perucica - Phase II		 A Voith Company Sintaksa - A Voith Company Ulica Domovinskog rata 104C, 21 000 Split, Hrvatska	Unit KA2 control cubicle circuit diagrams ESD VALVE CONTROL	DRAWING No.: PERU-01-19-170-31-002	REV No.: 02	= UBCJA10GH100 + UBCJA10
Approved by Designer	Grga Kolić	01.10.2026.					Designer No.:	SALES No.:	PAGE 51
Checked by	Antonio Aleksić	01.10.2026.							
Drawn by	Tamara Trogrlić	01.10.2026.							PAGE 51 / 157

12345678

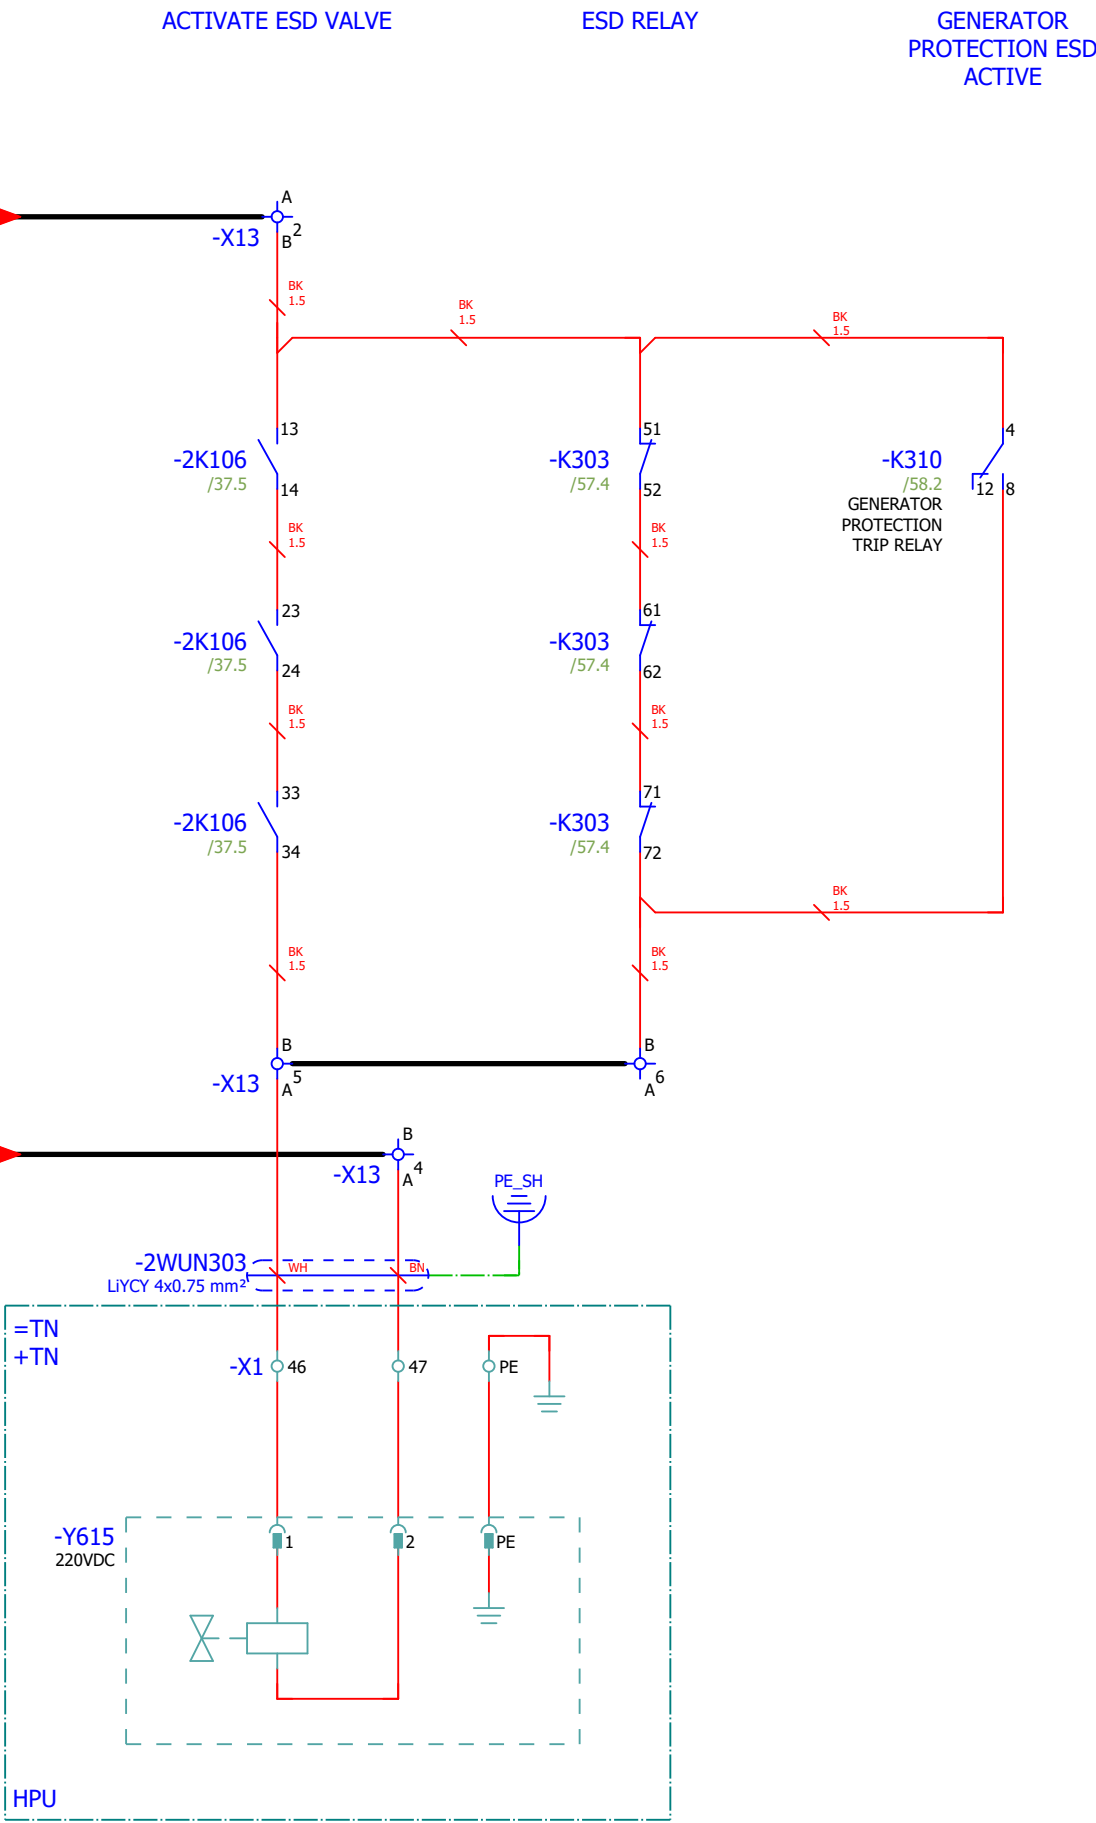

52


CONFIDENTIAL, ALL RIGHTS RESERVED DIN 34
Format ISO/DIN A3

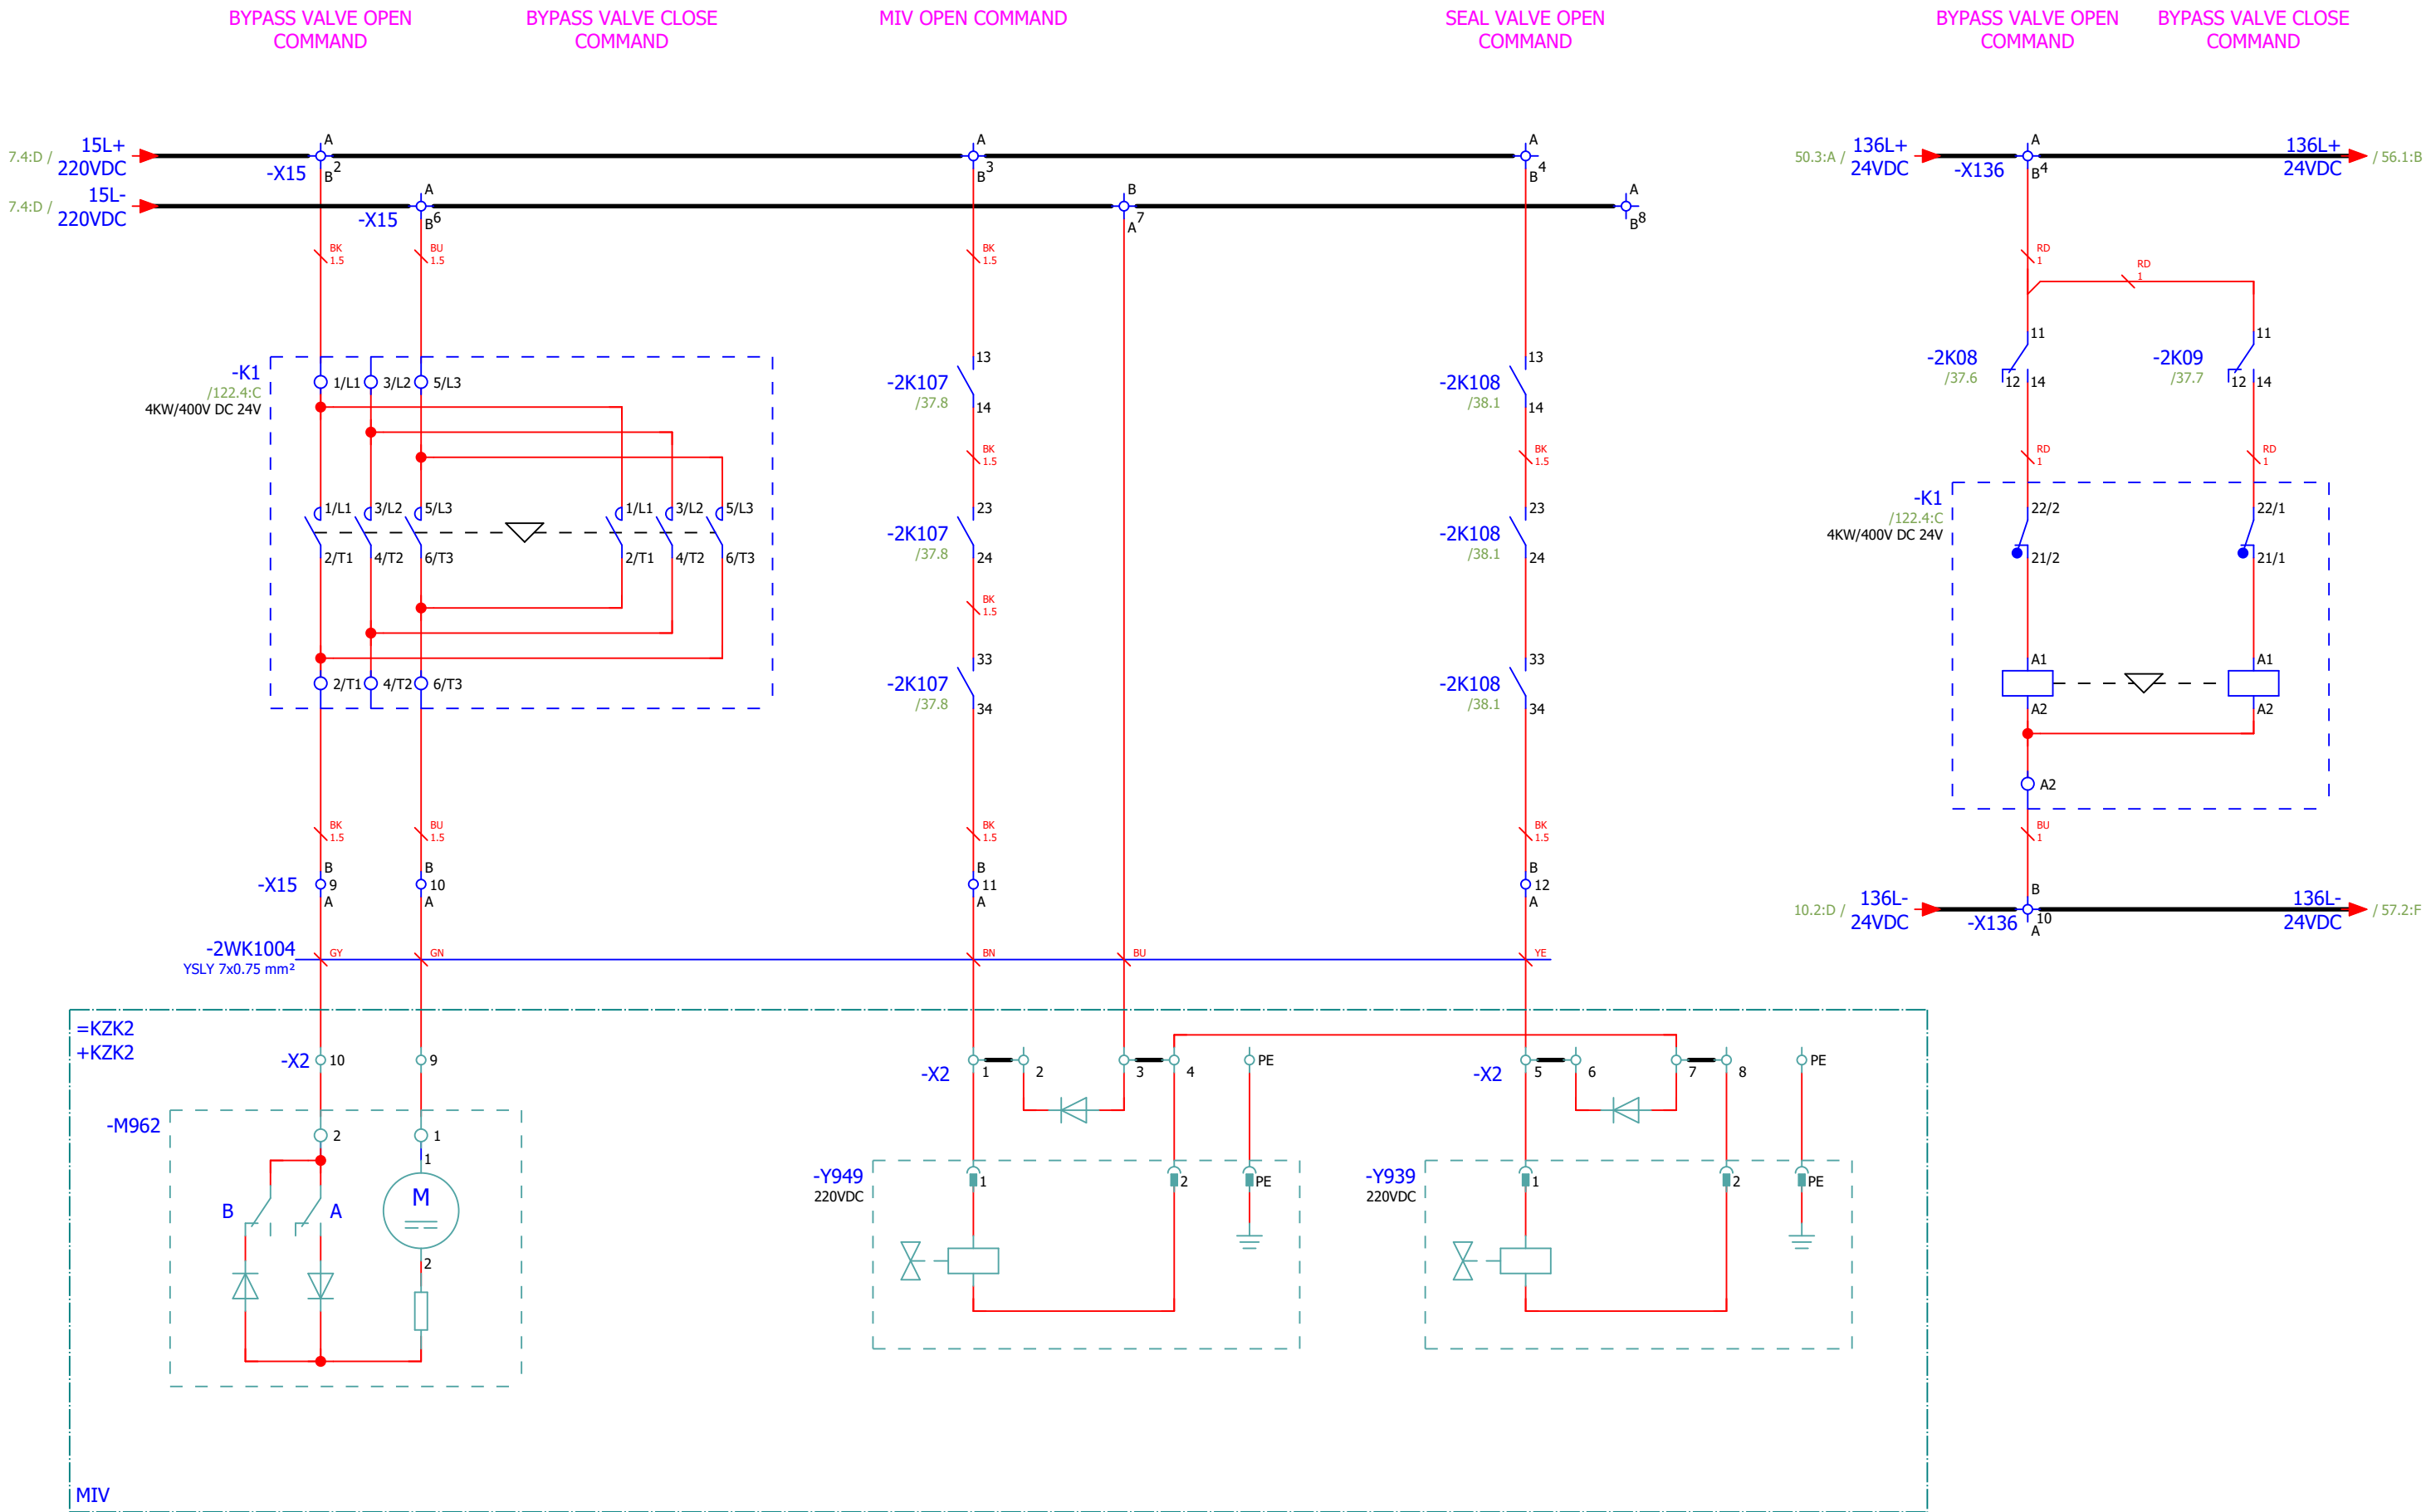

Approved by Contractor			Reconstruction and Modernisation of HPP Perucica - Phase II		SINTAKSA A Voith Company	Unit KA2 control cubicle circuit diagrams	DRAWING No.: PERU-01-19-170-31-002	REV No.: 02	= UBCJA10GH100
Approved by Designer	Grga Kolić	01.10.2026.			Sintaksa - A Voith Company Ulica Domovinskog rata 104C, 21 000 Split, Hrvatska	MIV CONTROL 24VDC	Designer No.:	SALES No.:	+ UBCJA10
Checked by	Antonio Aleksić	01.10.2026.							PAGE 52
Drawn by	Tamara Trogrlić	01.10.2026.	PROJECT NAME	EMPLOYER	DESIGNER				PAGE 52 / 157

CONFIDENTIAL, ALL RIGHTS RESERVED DIN 34

Format ISO/DIN A3

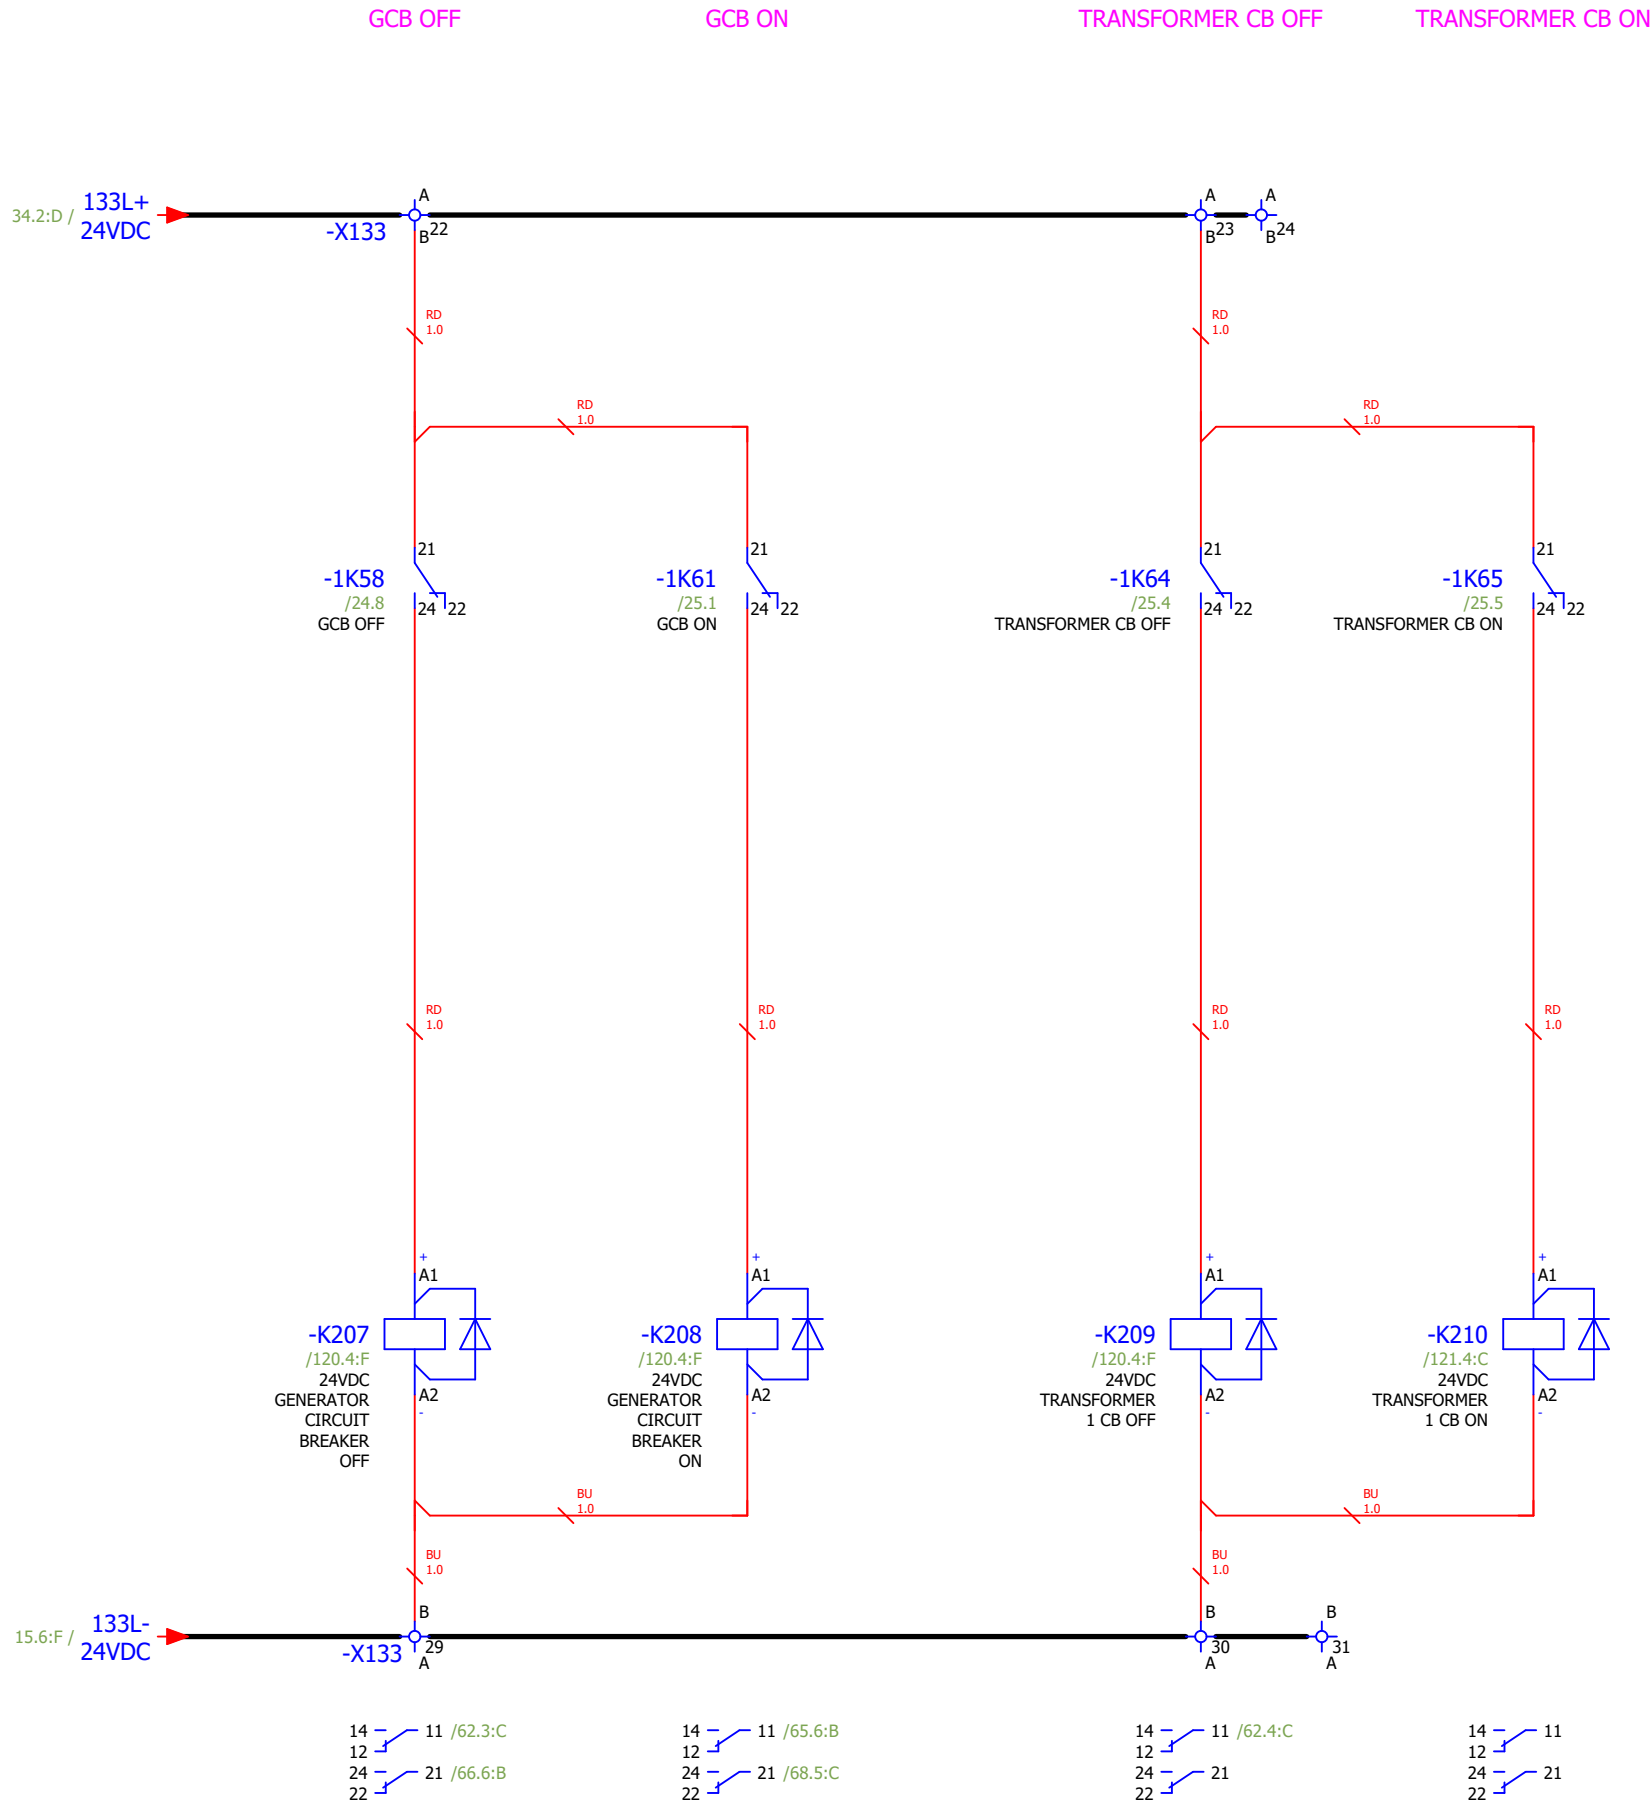

Approved by Contractor			Reconstruction and Modernisation of HPP Perucica - Phase II		 Sintaksa - A Voith Company Ulica Domovinskog rata 104C, 21 000 Split, Hrvatska	Unit KA2 control cubicle circuit diagrams LOCAL CONTROL	DRAWING No.: PERU-01-19-170-31-002	REV No.: 02	= UBCJA10GH100 + UBCJA10
Approved by Designer	Grga Kolić	01.10.2026.					Designer No.:	SALES No.:	PAGE 53
Checked by	Antonio Aleksić	01.10.2026.							
Drawn by	Tamara Trogrlić	01.10.2026.							PAGE 53 / 157

CONFIDENTIAL, ALL RIGHTS RESERVED DIN 34

Format ISO/DIN A3

53

Approved by Contractor			Reconstruction and Modernisation of HPP Perucica - Phase II		 A Voith Company Sintaksa - A Voith Company Ulica Domovinskog rata 104C, 21 000 Split, Hrvatska	Unit KA2 control cubicle circuit diagrams CB CONTROL	DRAWING No.: PERU-01-19-170-31-002	REV No.: 02	= UBCJA10GH100
Approved by Designer	Grga Kolić	01.10.2026.					Designer No.:	SALES No.:	+ UBCJA10
Checked by	Antonio Aleksić	01.10.2026.							PAGE 54
Drawn by	Tamara Trogrlić	01.10.2026.							PAGE 54 / 157

12345678

A

B

C

D

E

F

A

B

C

D

E



F

GENERATOR CB
CLOSING

GENERATOR CIRCUIT
BREAKER OPEN
COMMAND

GCB OFF
COMMAND - ESD

TRANSFORMER CB
CLOSING

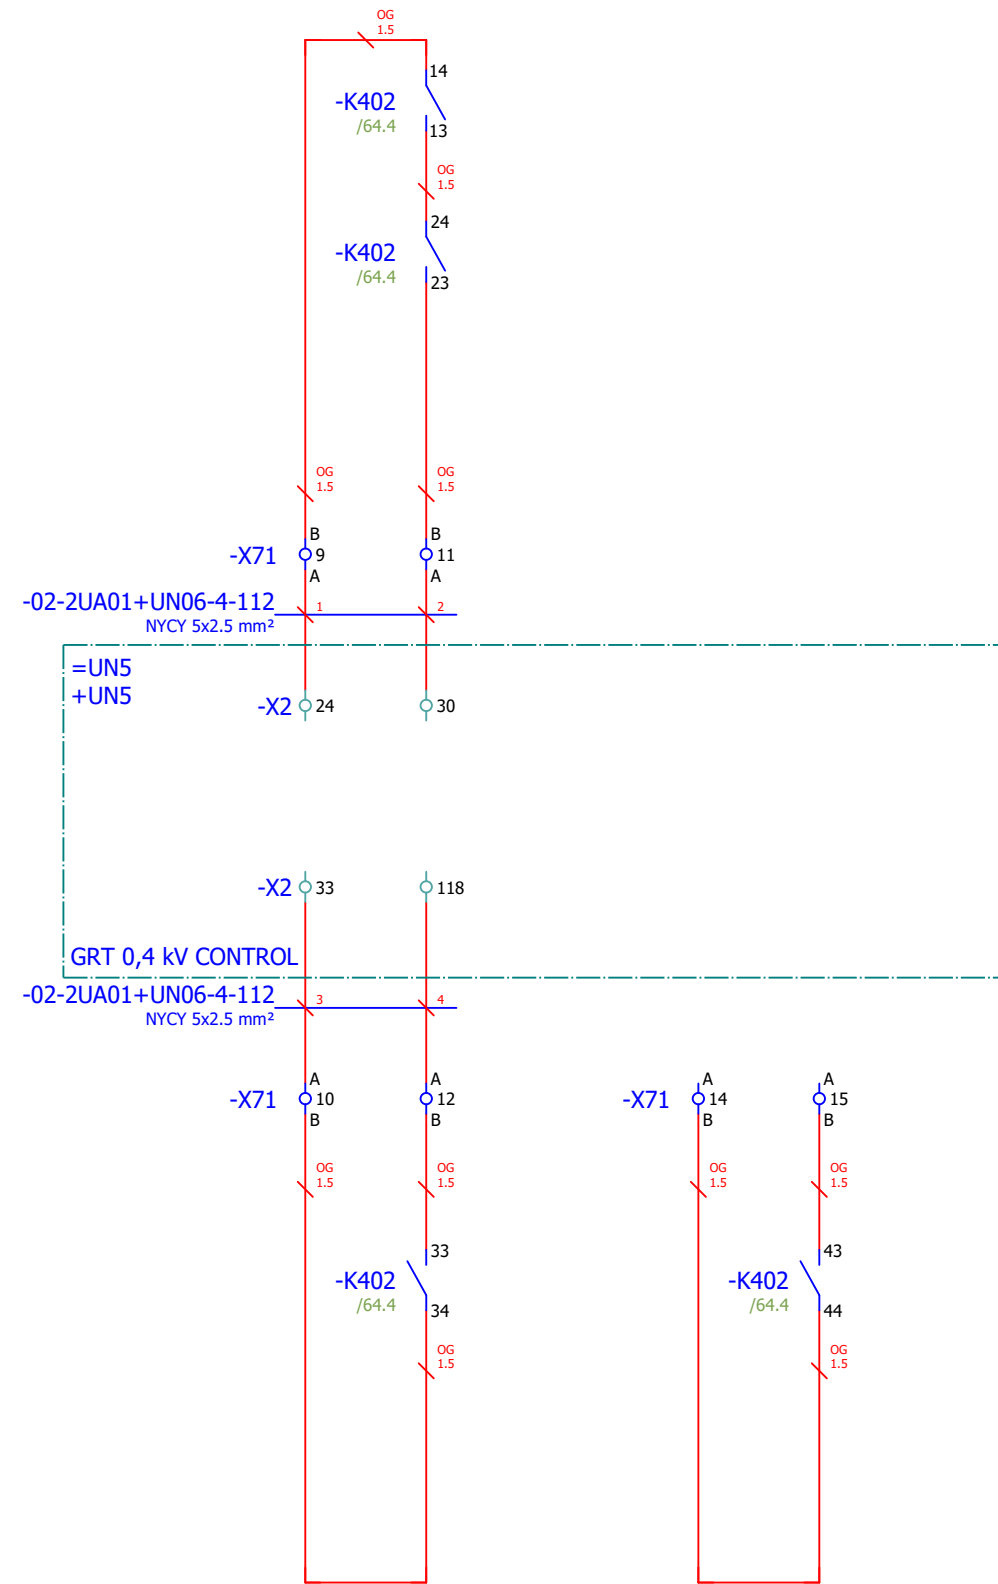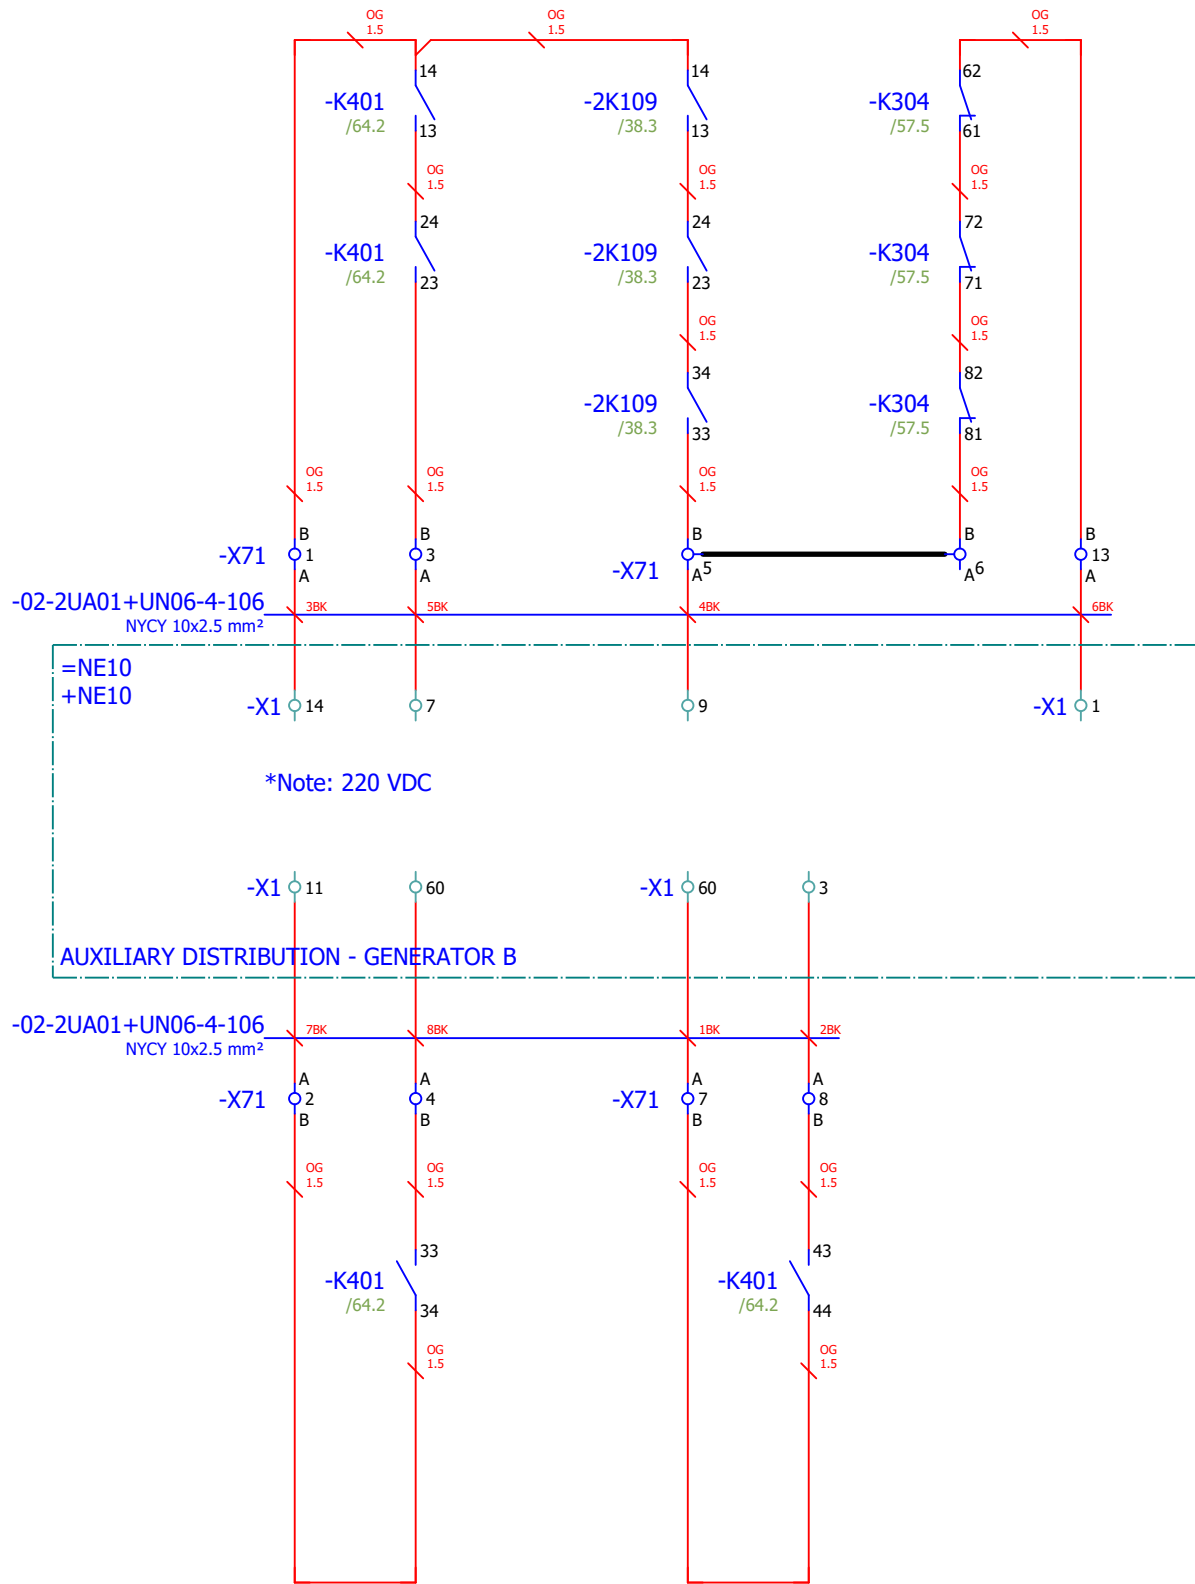


CONFIDENTIAL, ALL RIGHTS RESERVED DIN 34

Format ISO/DIN A3

54

56

Approved by Contractor			Reconstruction and Modernisation of HPP Perucica - Phase II		 A Voith Company Sintaksa - A Voith Company Ulica Domovinskog rata 104C, 21 000 Split, Hrvatska	Unit KA2 control cubicle circuit diagrams EXCITATION CB TRIP COMMAND	DRAWING No.: PERU-01-19-170-31-002	REV No.: 02	= UBCJA10GH100 + UBCJA10
Approved by Designer	Grga Kolić	01.10.2026.					Designer No.:	SALES No.:	PAGE 55
Checked by	Antonio Aleksić	01.10.2026.							
Drawn by	Tamara Trogrlić	01.10.2026.							PAGE 55 / 157

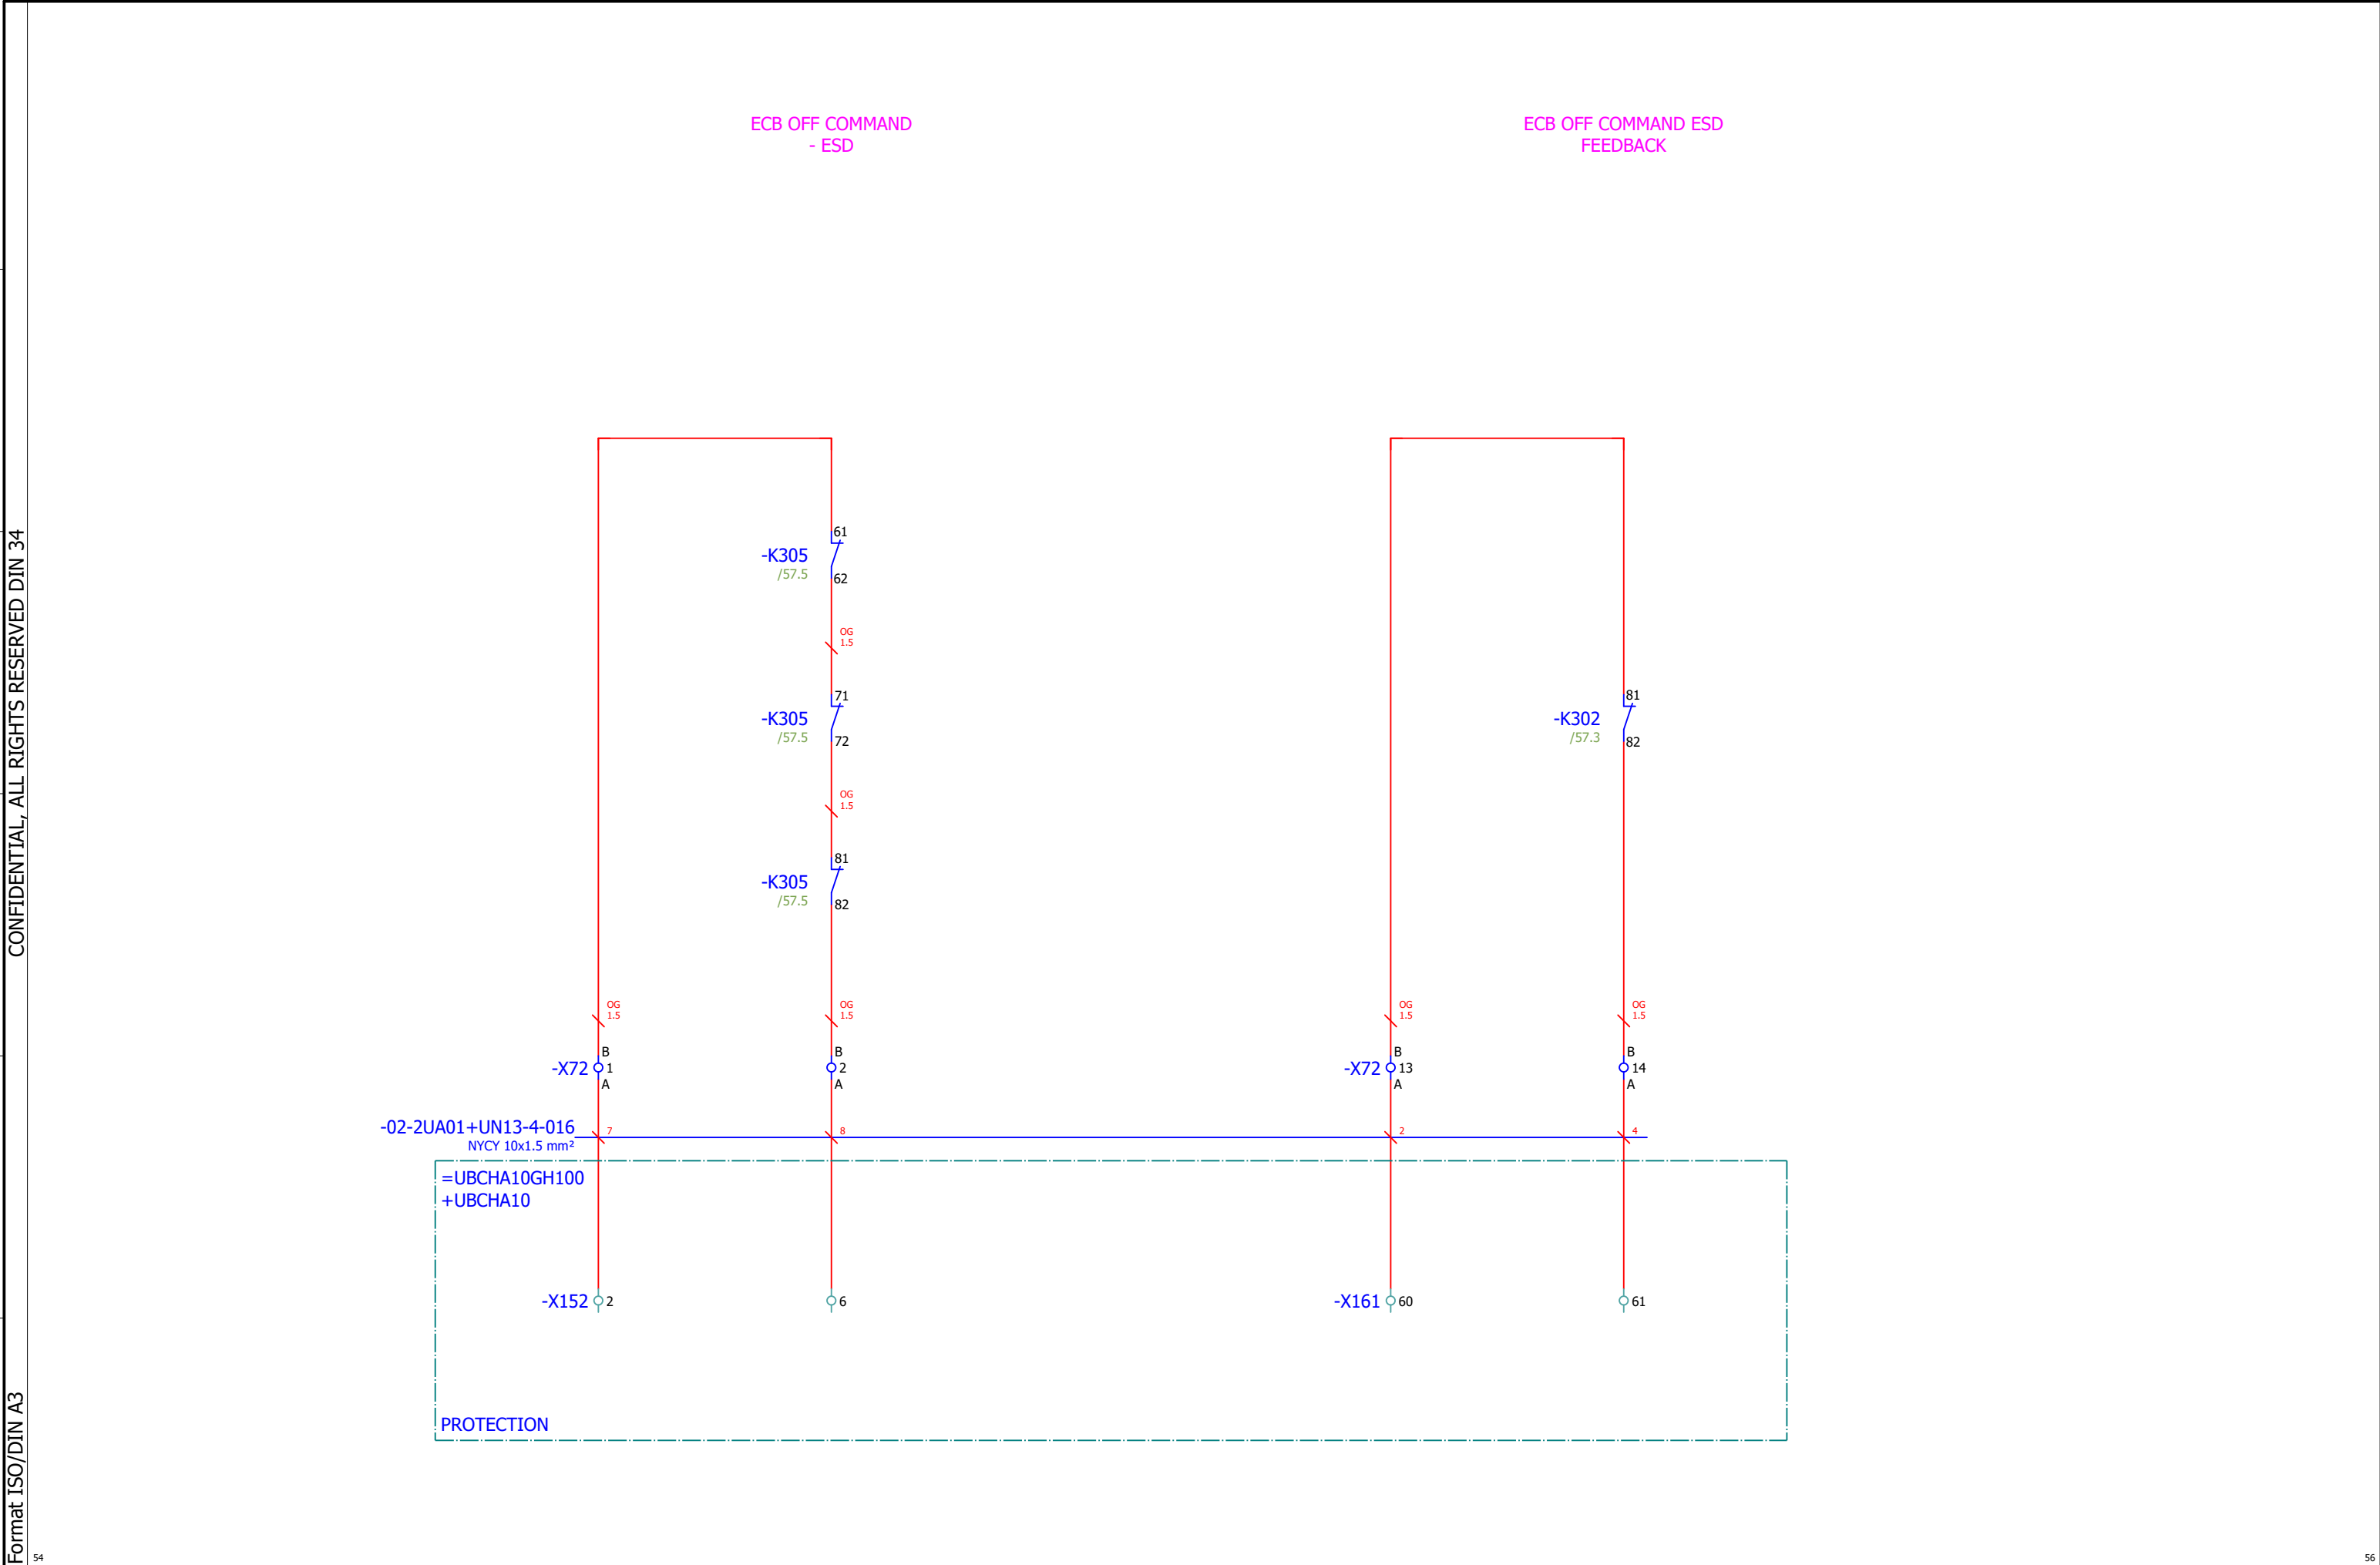


CONFIDENTIAL, ALL RIGHTS RESERVED DIN 34

Format ISO/DIN A3

56

58

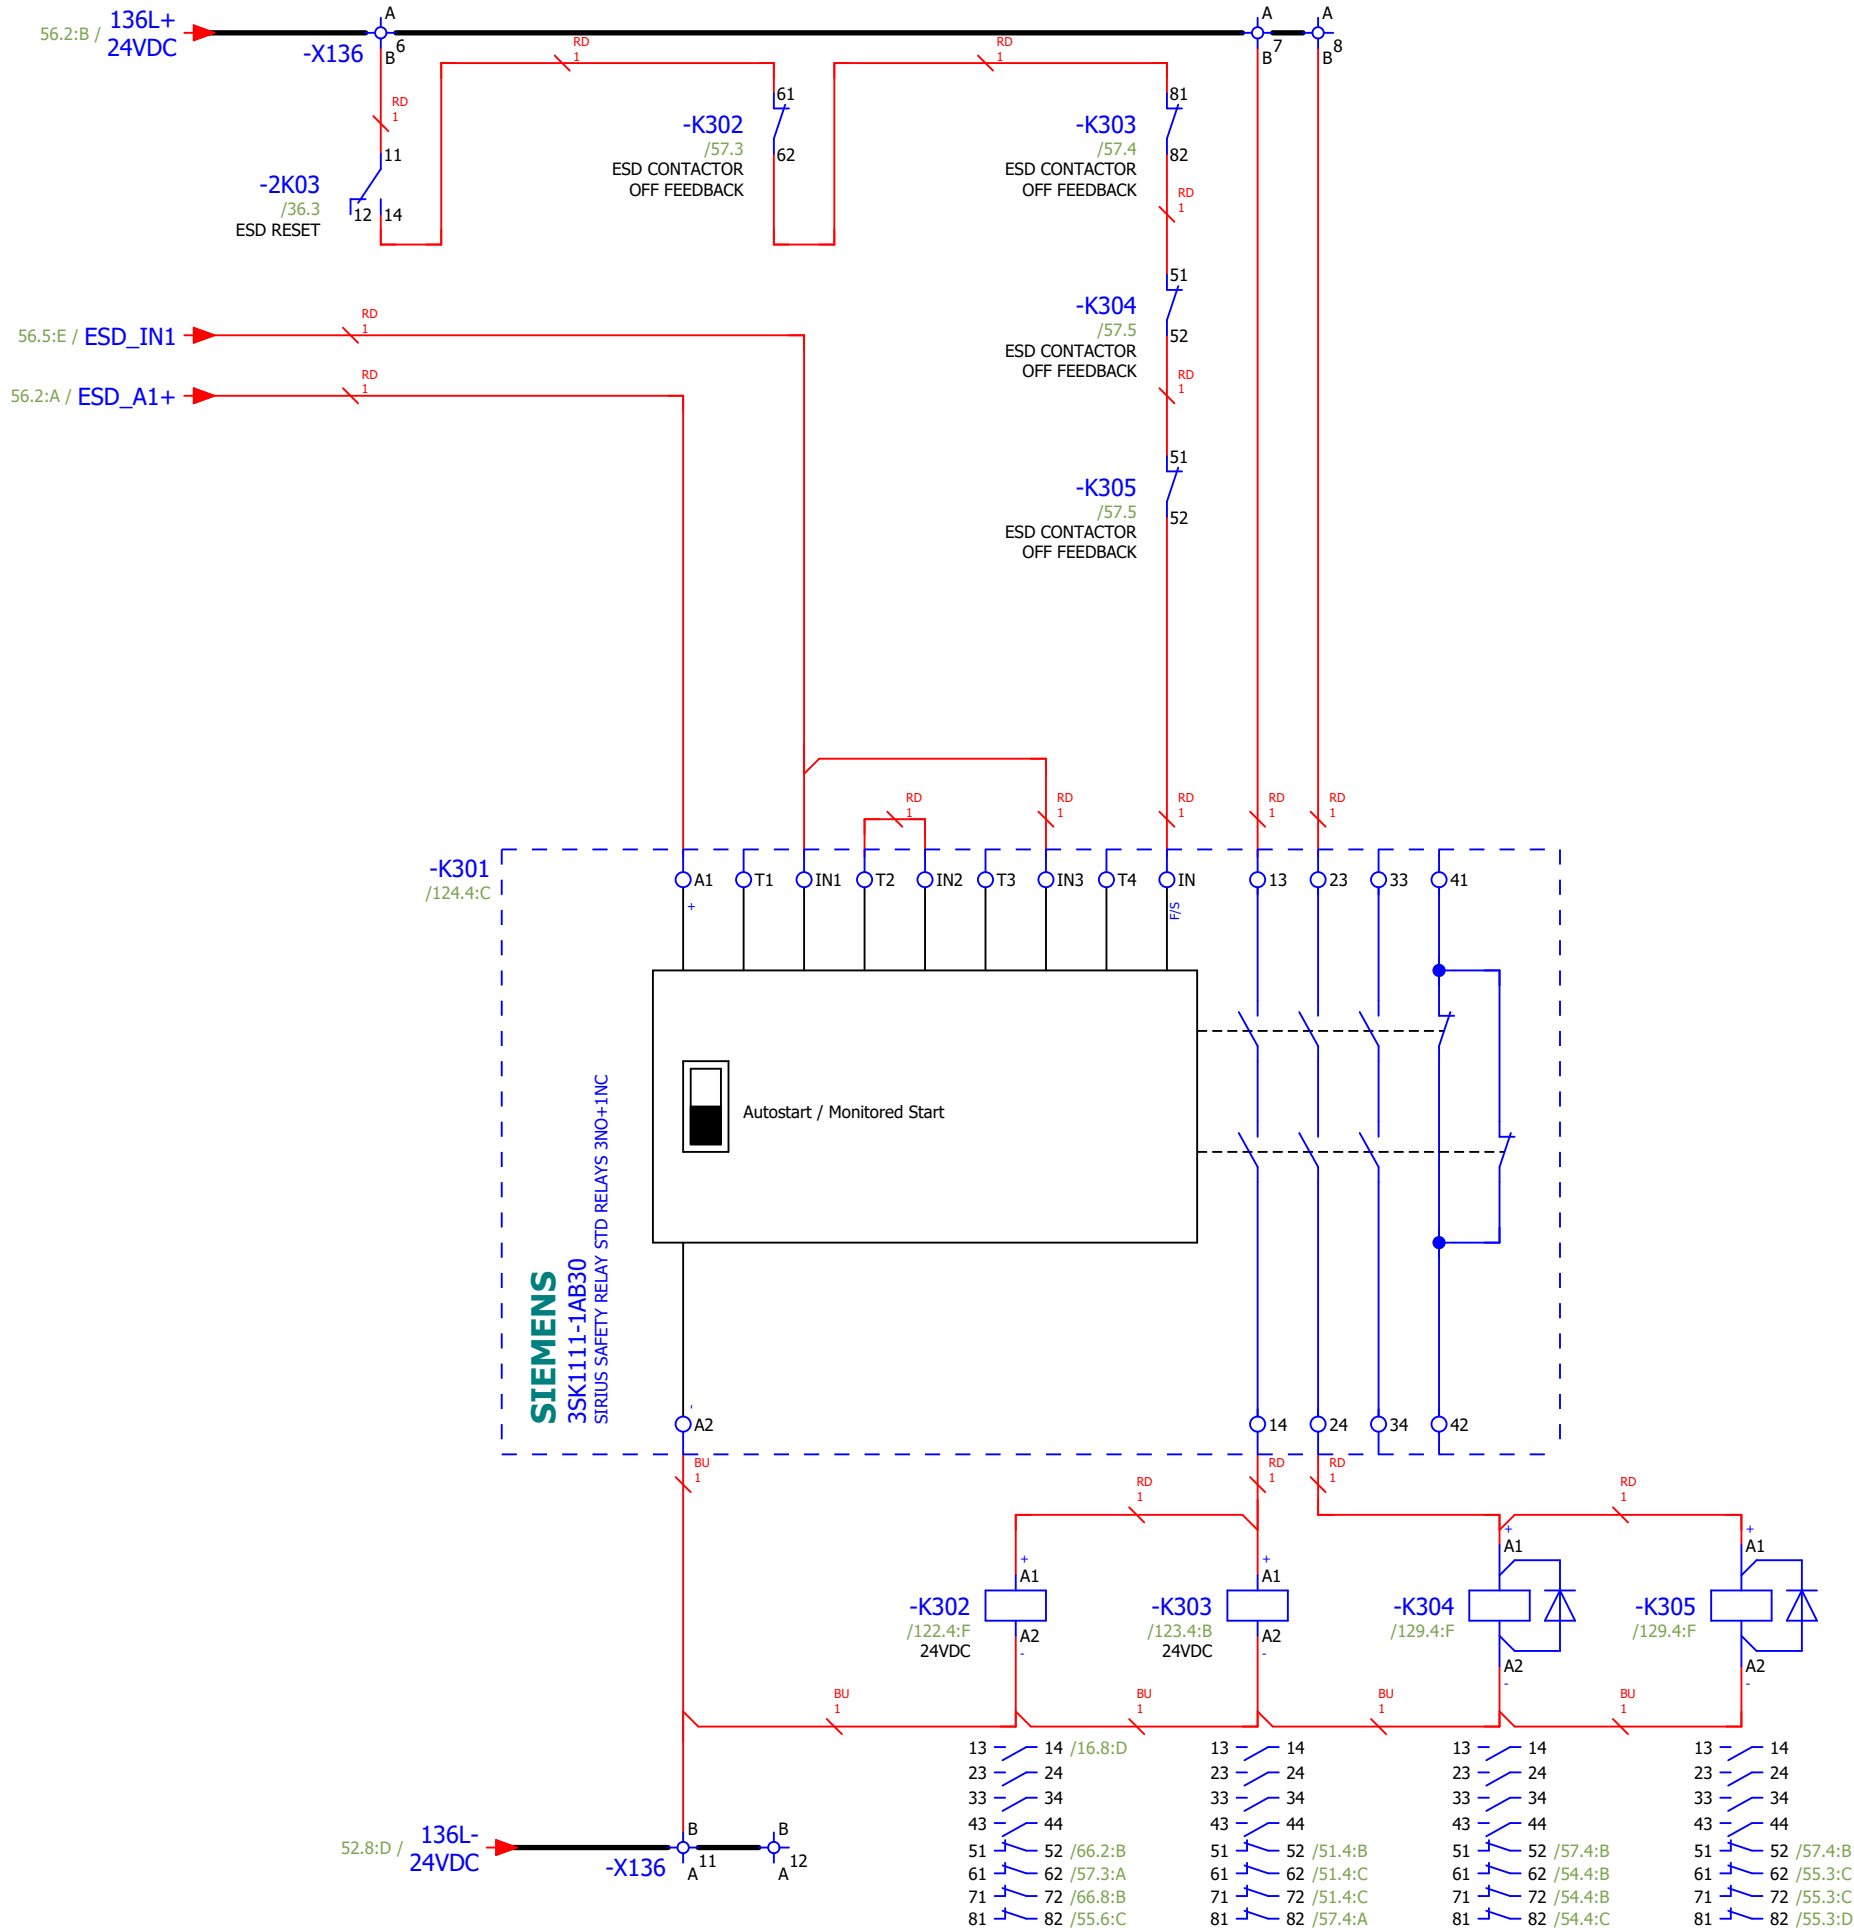

Approved by Contractor			Reconstruction and Modernisation of HPP Perucica - Phase II		 A Voith Company	Unit KA2 control cubicle circuit diagrams	DRAWING No.: PERU-01-19-170-31-002	REV No.: 02	= UBCJA10GH100 + UBCJA10
Approved by Designer	Grga Kolić	01.10.2026.	PROJECT NAME	EMPLOYER	DESIGNER	EMERGENCY SHUTDOWN	Designer No.:	SALES No.:	PAGE 57
Checked by	Antonio Aleksić	01.10.2026.							PAGE 57 / 157
Drawn by	Tamara Trogrlić	01.10.2026.							


Format ISO/DIN A3



1	2	3	4	5	6	7	8
---	---	---	---	---	---	---	---

Format ISO/DIN A3
CONFIDENTIAL, ALL RIGHTS RESERVED DIN 34

Approved by Contractor			Reconstruction and Modernisation of HPP Perucica - Phase II		 A Voith Company Sintaksa - A Voith Company Ulica Domovinskog rata 104C, 21 000 Split, Hrvatska	Unit KA2 control cubicle circuit diagrams SYNCHRONIZATION CONTROL	DRAWING No.: PERU-01-19-170-31-002	REV No.: 02	= UBCJA10GH100 + UBCJA10
Approved by Designer	Grga Kolić	01.10.2026.					Designer No.:	SALES No.:	PAGE 59
Checked by	Antonio Aleksić	01.10.2026.							
Drawn by	Tamara Trogrlić	01.10.2026.							PAGE 59 / 157

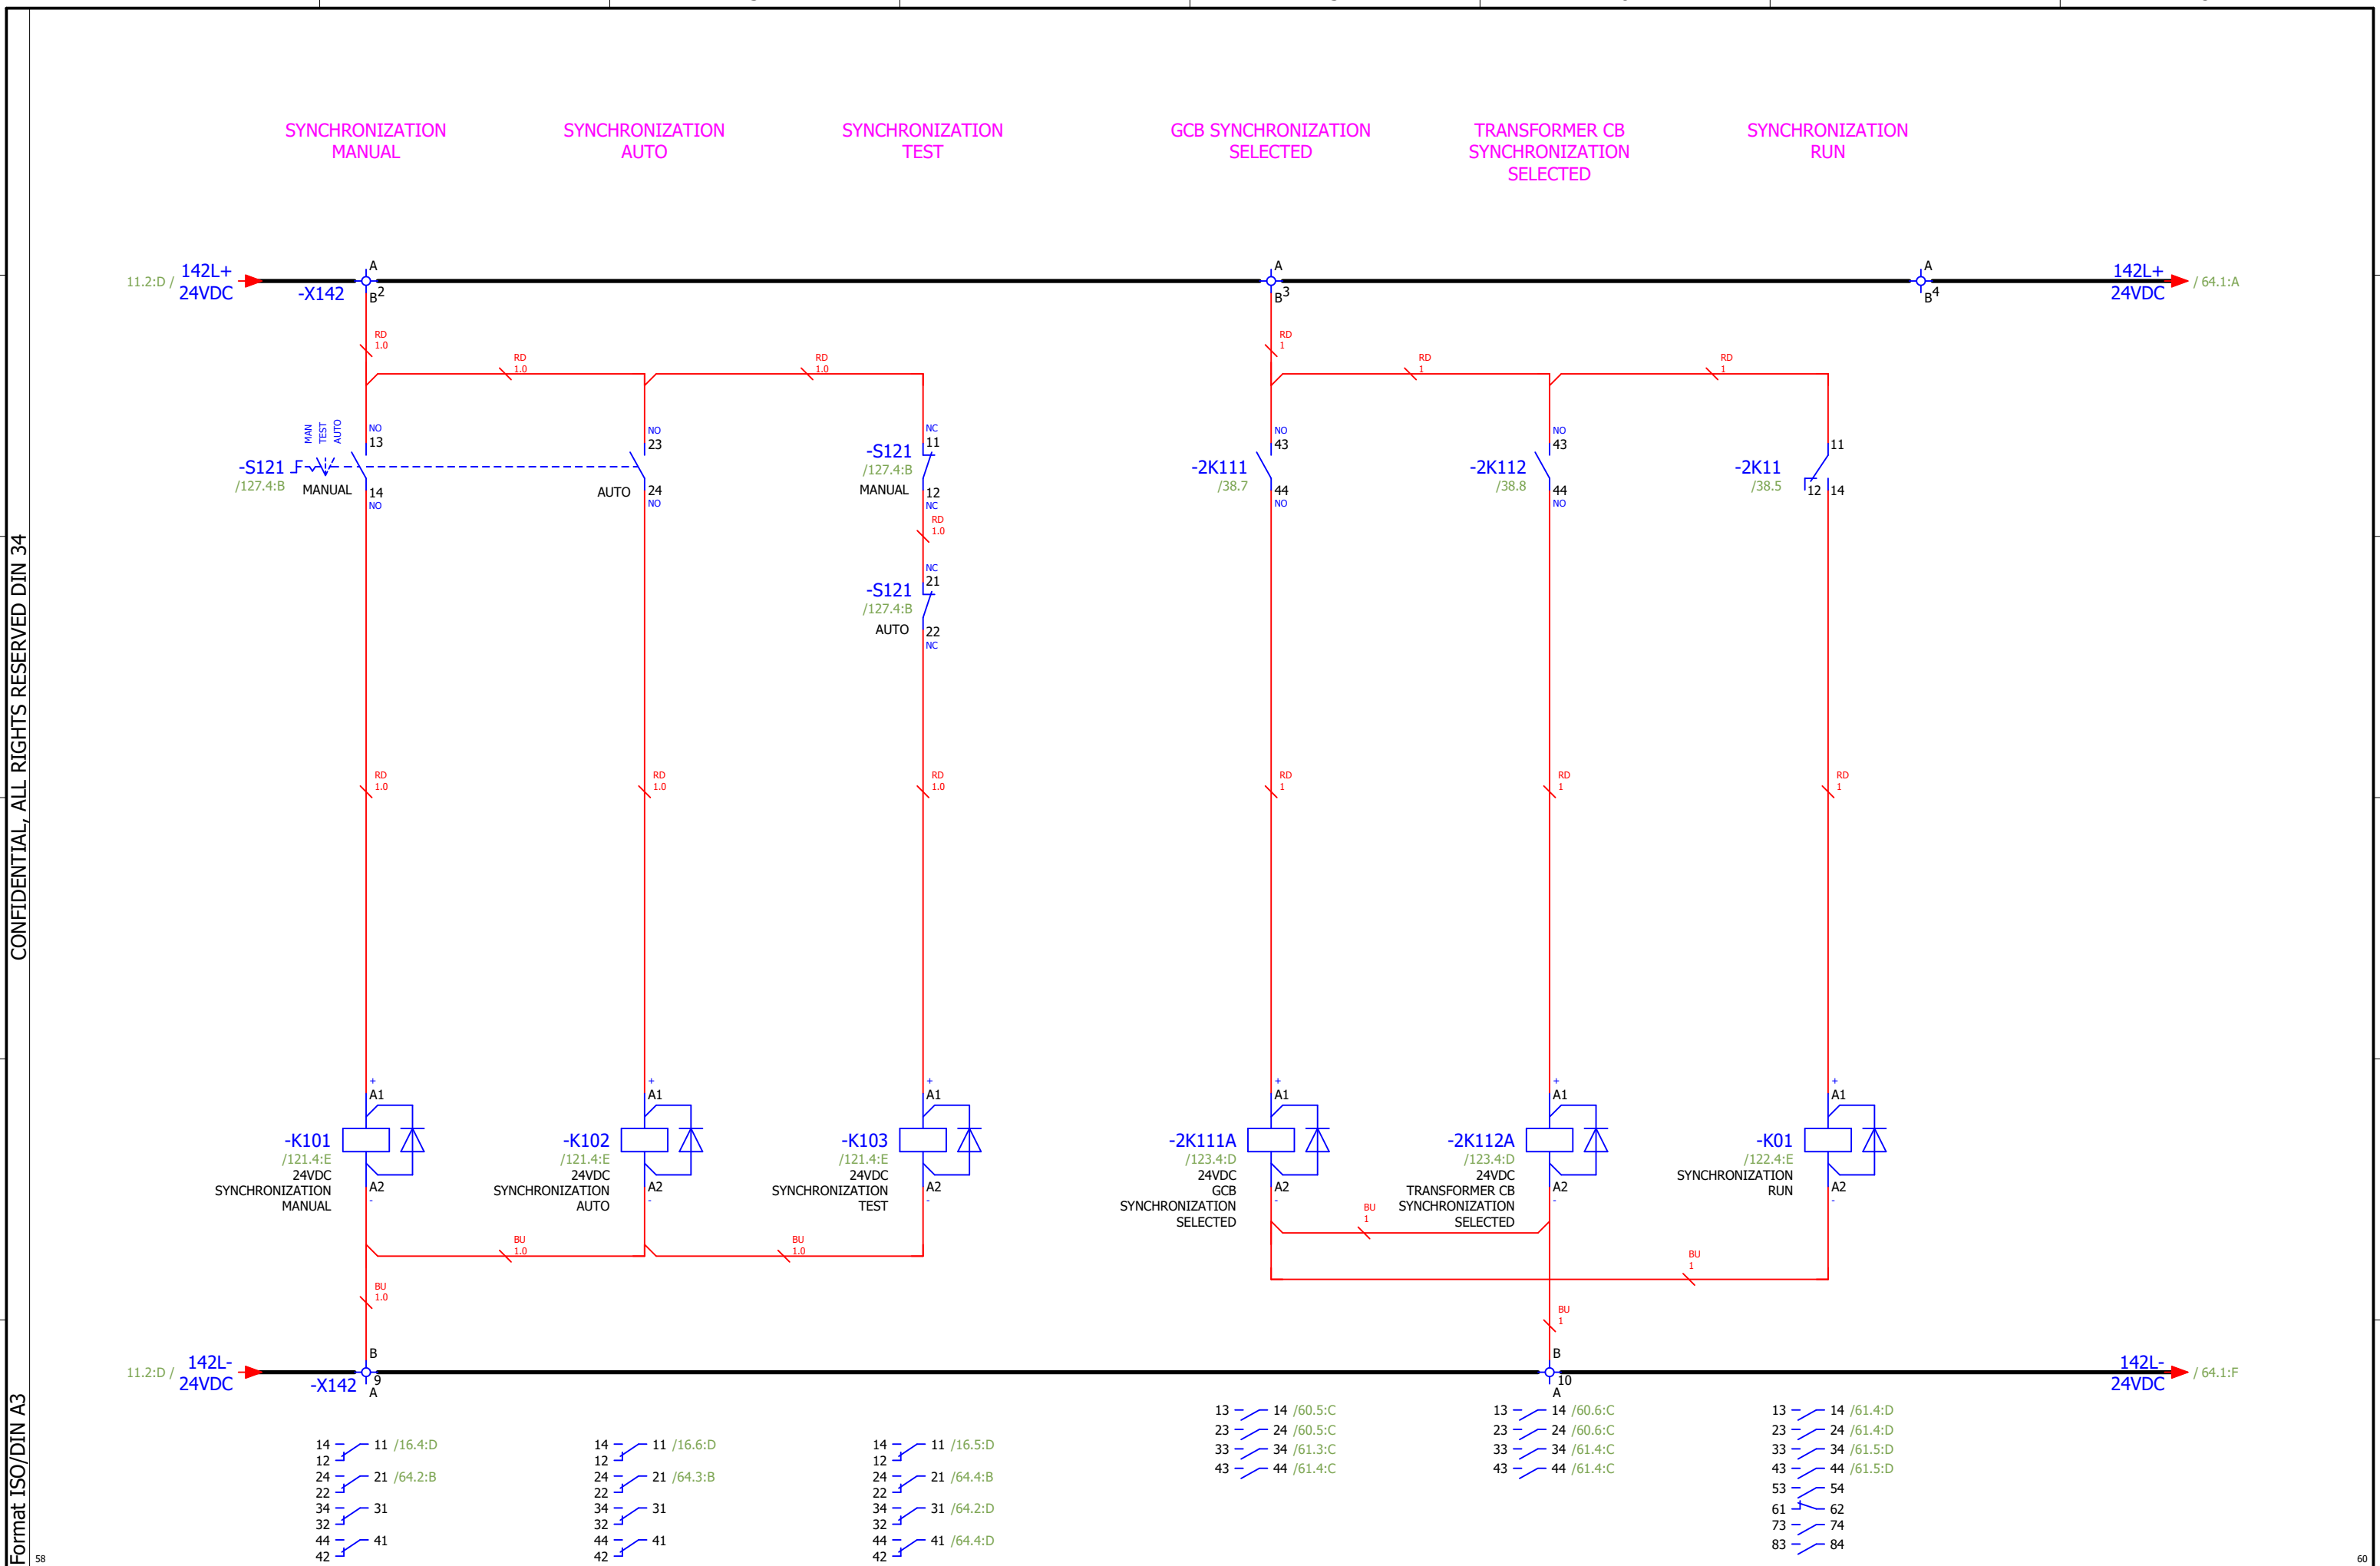

CONFIDENTIAL, ALL RIGHTS RESERVED DIN 34


Format ISO/DIN A3

59

61

Approved by Contractor			Reconstruction and Modernisation of HPP Perucica - Phase II		 A Voith Company Sintaksa - A Voith Company Ulica Domovinskog rata 104C, 21 000 Split, Hrvatska	Unit KA2 control cubicle circuit diagrams SYNCHRONIZATION CONTROL	DRAWING No.: PERU-01-19-170-31-002	REV No.: 02	= UBCJA10GH100 + UBCJA10
Approved by Designer	Grga Kolić	01.10.2026.					Designer No.:	SALES No.:	PAGE 60
Checked by	Antonio Aleksić	01.10.2026.							
Drawn by	Tamara Trogrlić	01.10.2026.							PAGE 60 / 157

SYNCHRONIZER
VOLTAGE MEASUREMENT

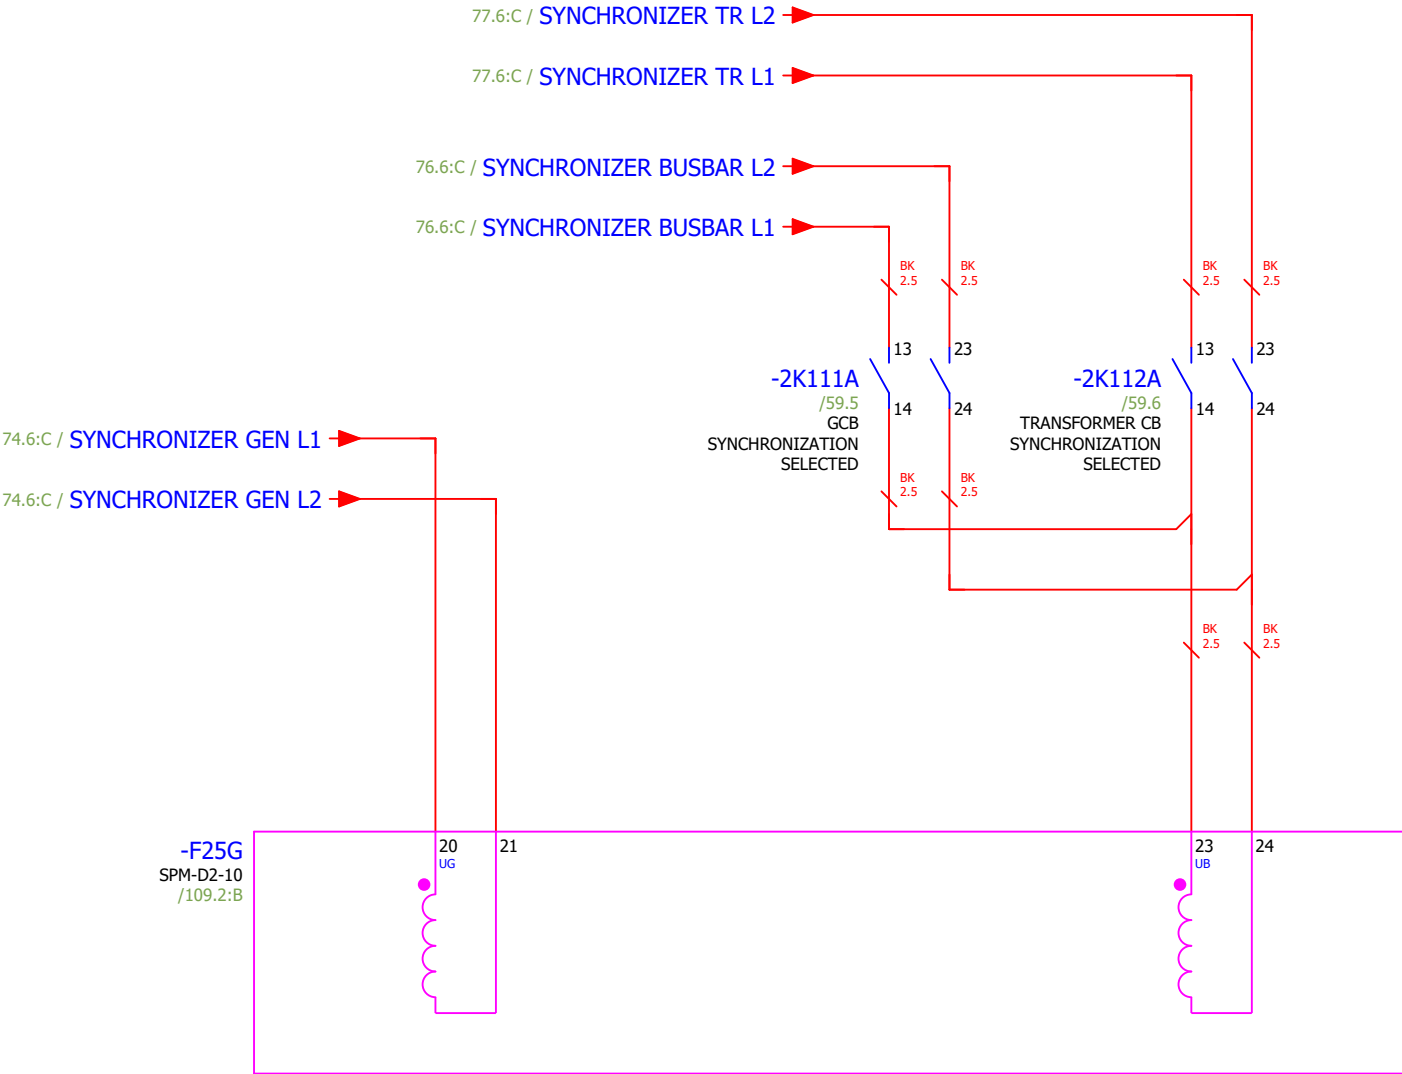

CONFIDENTIAL, ALL RIGHTS RESERVED DIN 34


Format ISO/DIN A3

60

62

Approved by Contractor			Reconstruction and Modernisation of HPP Perucica - Phase II		 A Voith Company Sintaksa - A Voith Company Ulica Domovinskog rata 104C, 21 000 Split, Hrvatska	Unit KA2 control cubicle circuit diagrams SYNCHRONIZATION	DRAWING No.: PERU-01-19-170-31-002	REV No.: 02	= UBCJA10GH100 + UBCJA10	
Approved by Designer	Grga Kolić	01.10.2026.					Designer No.:	SALES No.:	PAGE 61	PAGE 61 / 157
Checked by	Antonio Aleksić	01.10.2026.	PROJECT NAME	EMPLOYER	DESIGNER					
Drawn by	Tamara Trogrlić	01.10.2026.								

SYNCHROCHECK
VOLTAGE MEASUREMENT

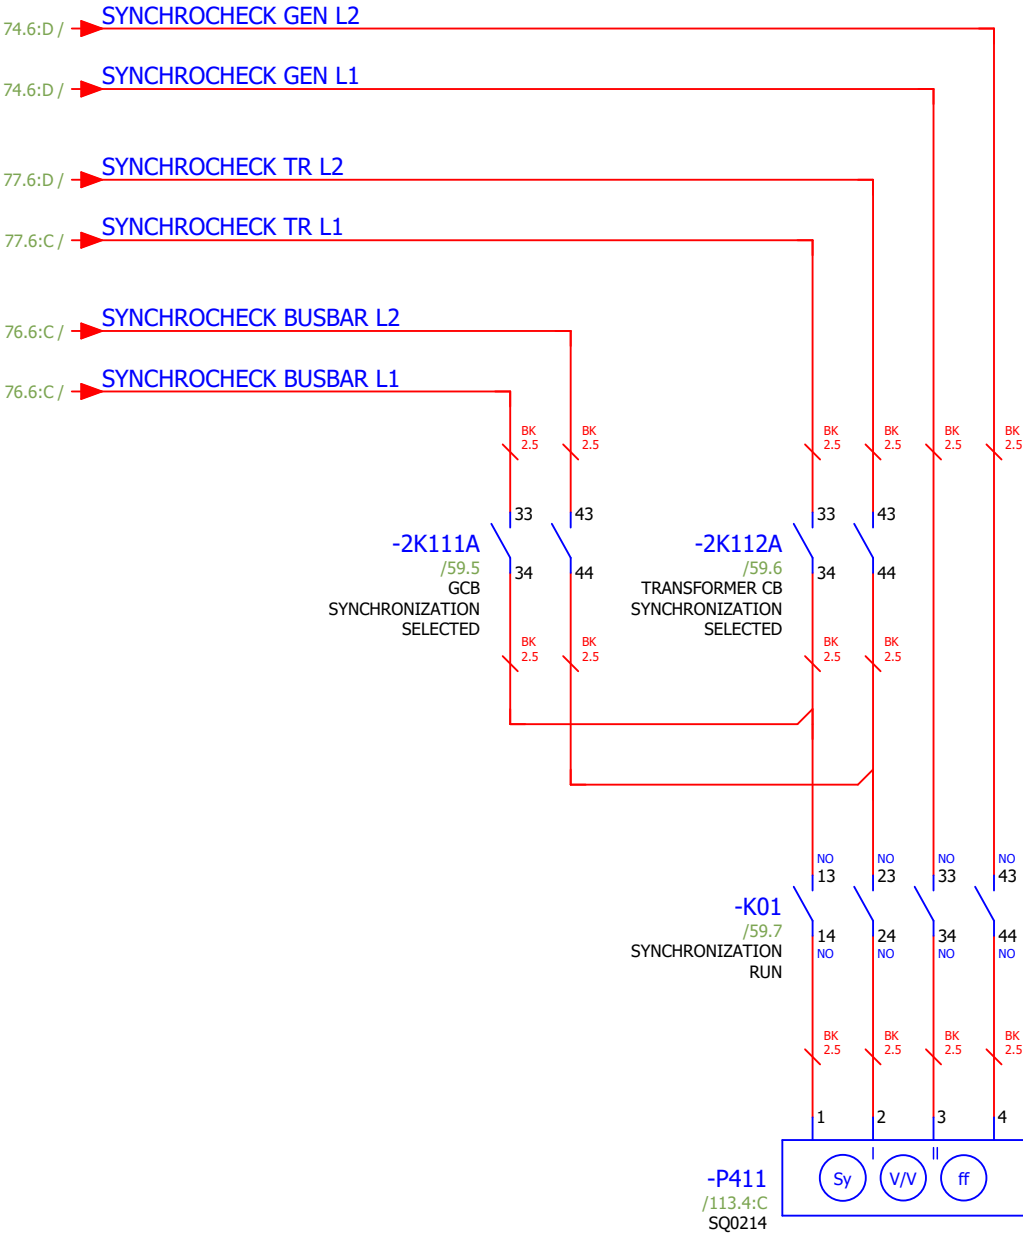


CONFIDENTIAL, ALL RIGHTS RESERVED DIN 34

Format ISO/DIN A3


61

63

Approved by Contractor			Reconstruction and Modernisation of HPP Perucica - Phase II		 A Voith Company Sintaksa - A Voith Company Ulica Domovinskog rata 104C, 21 000 Split, Hrvatska	Unit KA2 control cubicle circuit diagrams SYNCHRONIZATION	DRAWING No.: PERU-01-19-170-31-002	REV No.: 02	= UBCJA10GH100 + UBCJA10
Approved by Designer	Grga Kolić	01.10.2026.					Designer No.:	SALES No.:	PAGE 62
Checked by	Antonio Aleksić	01.10.2026.							
Drawn by	Tamara Trogrlić	01.10.2026.							PAGE 62 / 157

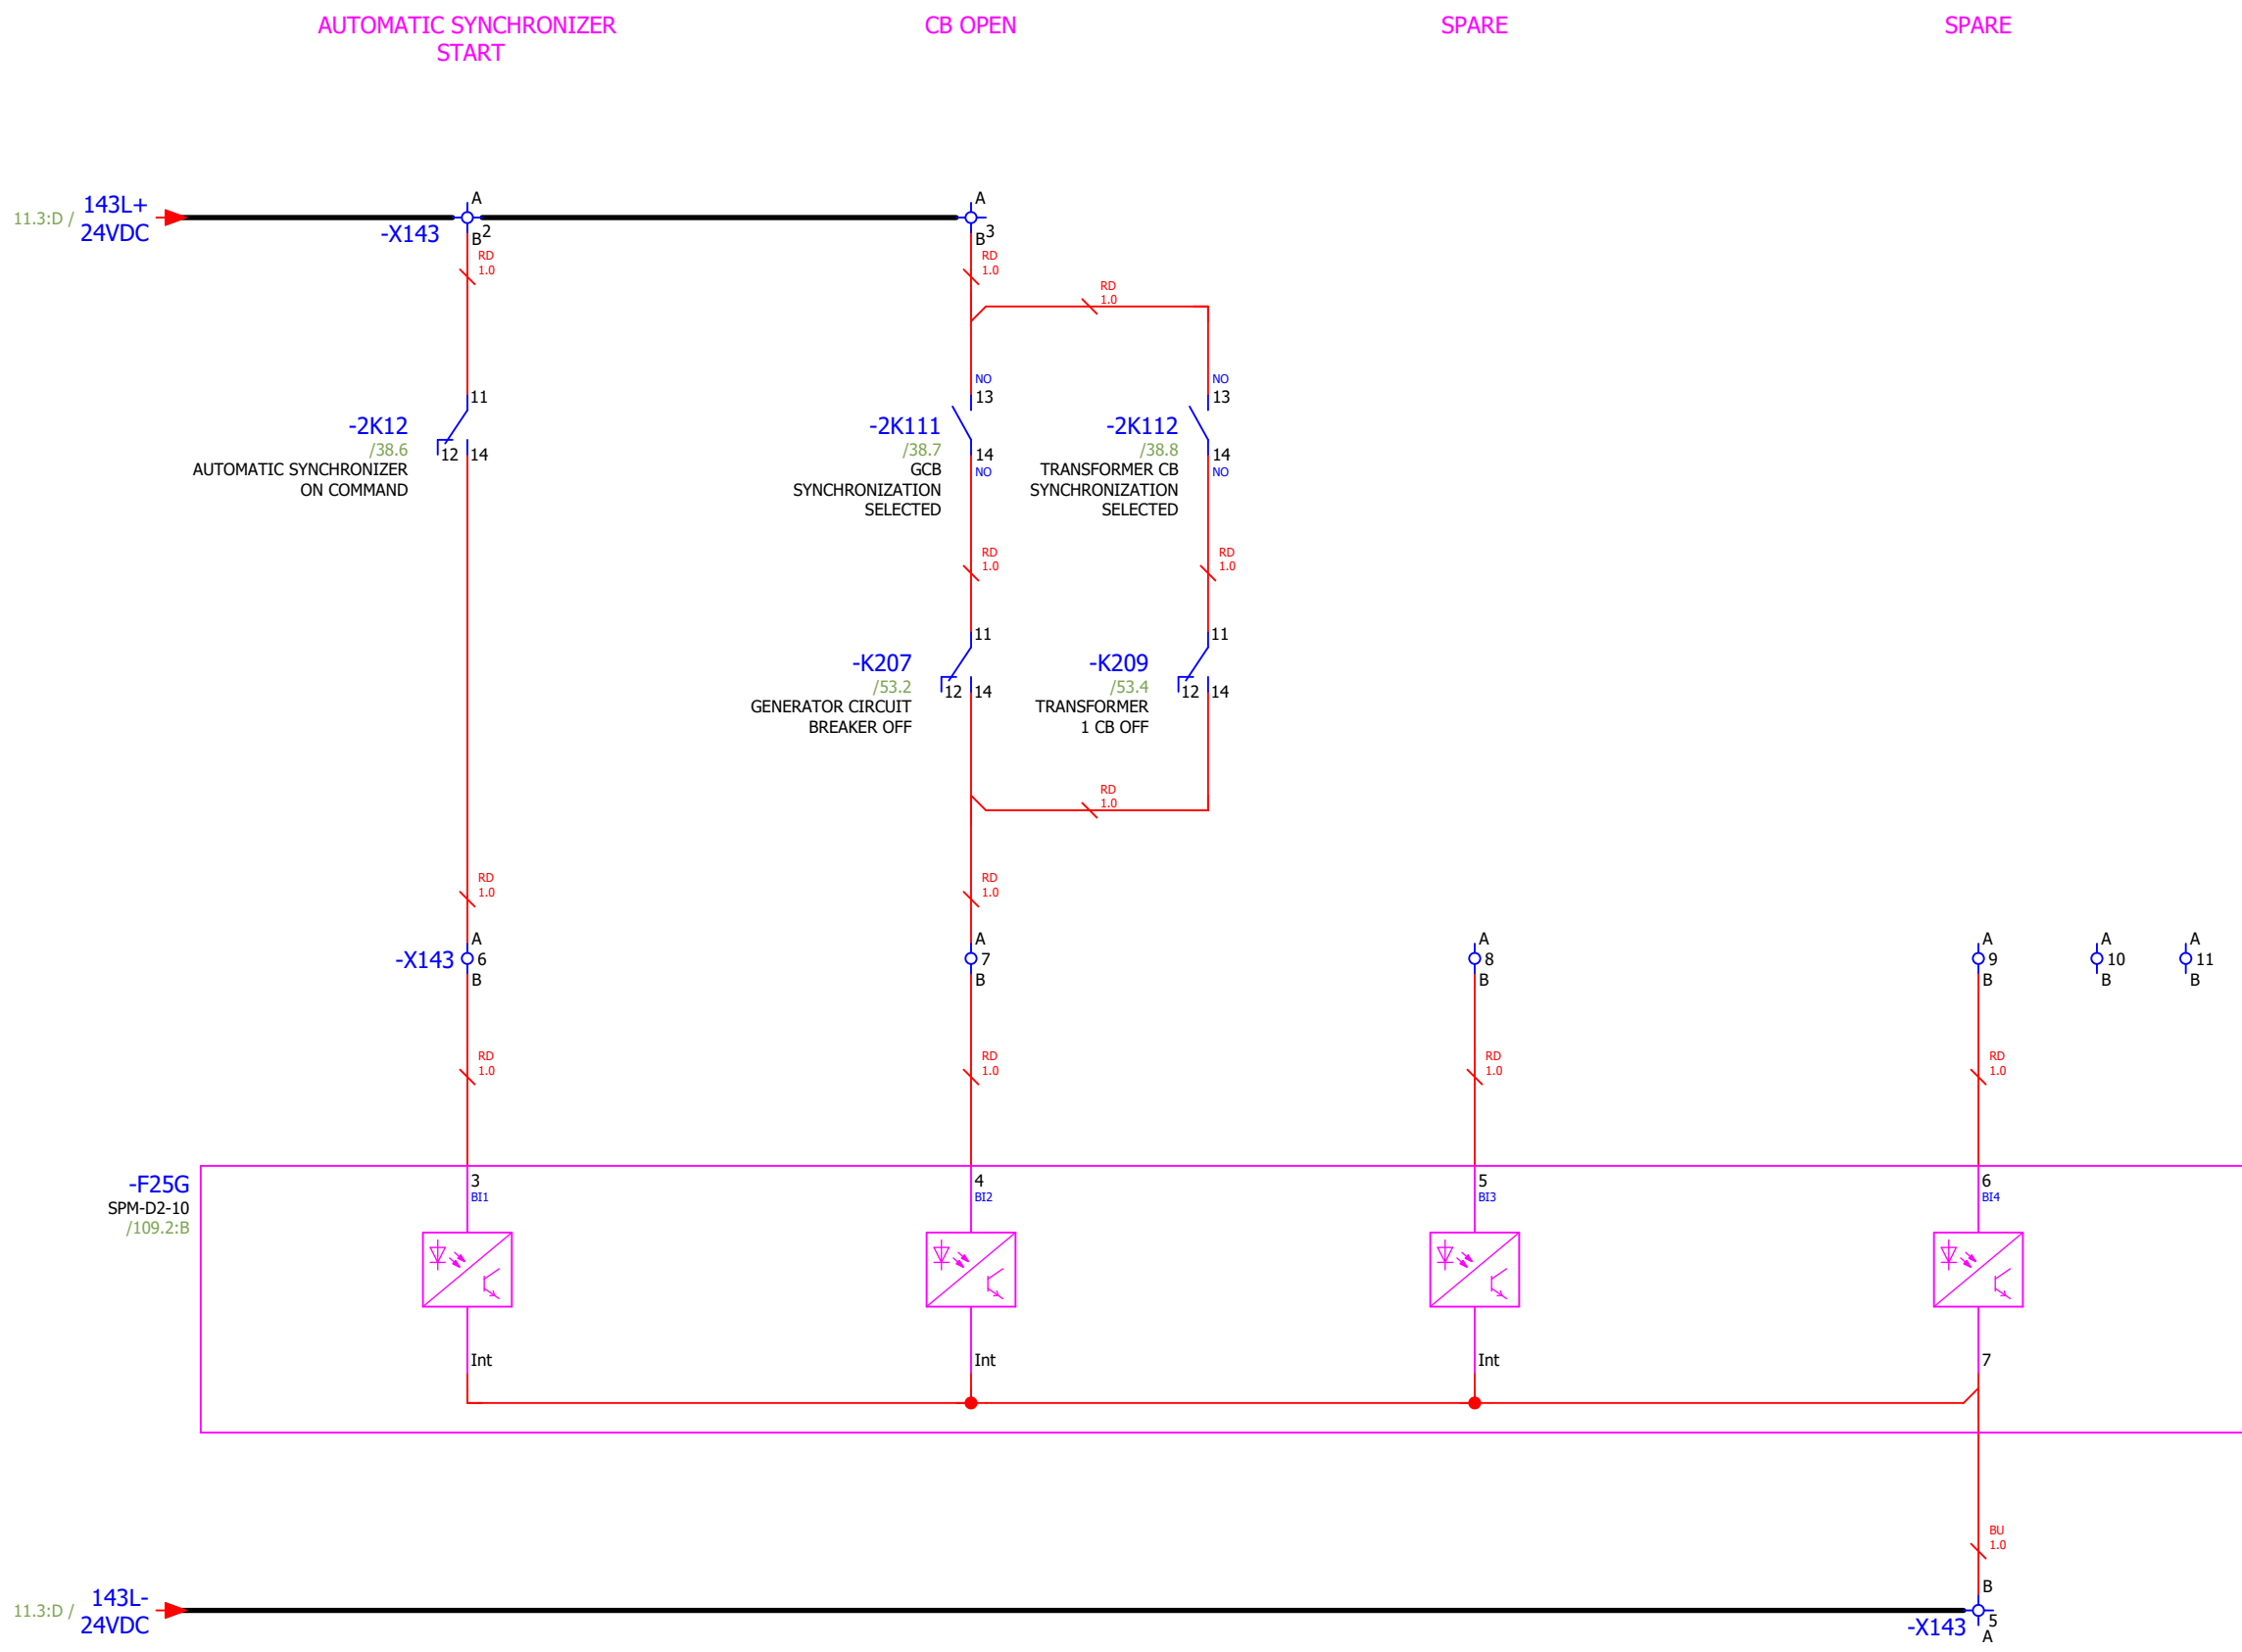

CONFIDENTIAL, ALL RIGHTS RESERVED DIN 34
Format ISO/DIN A3

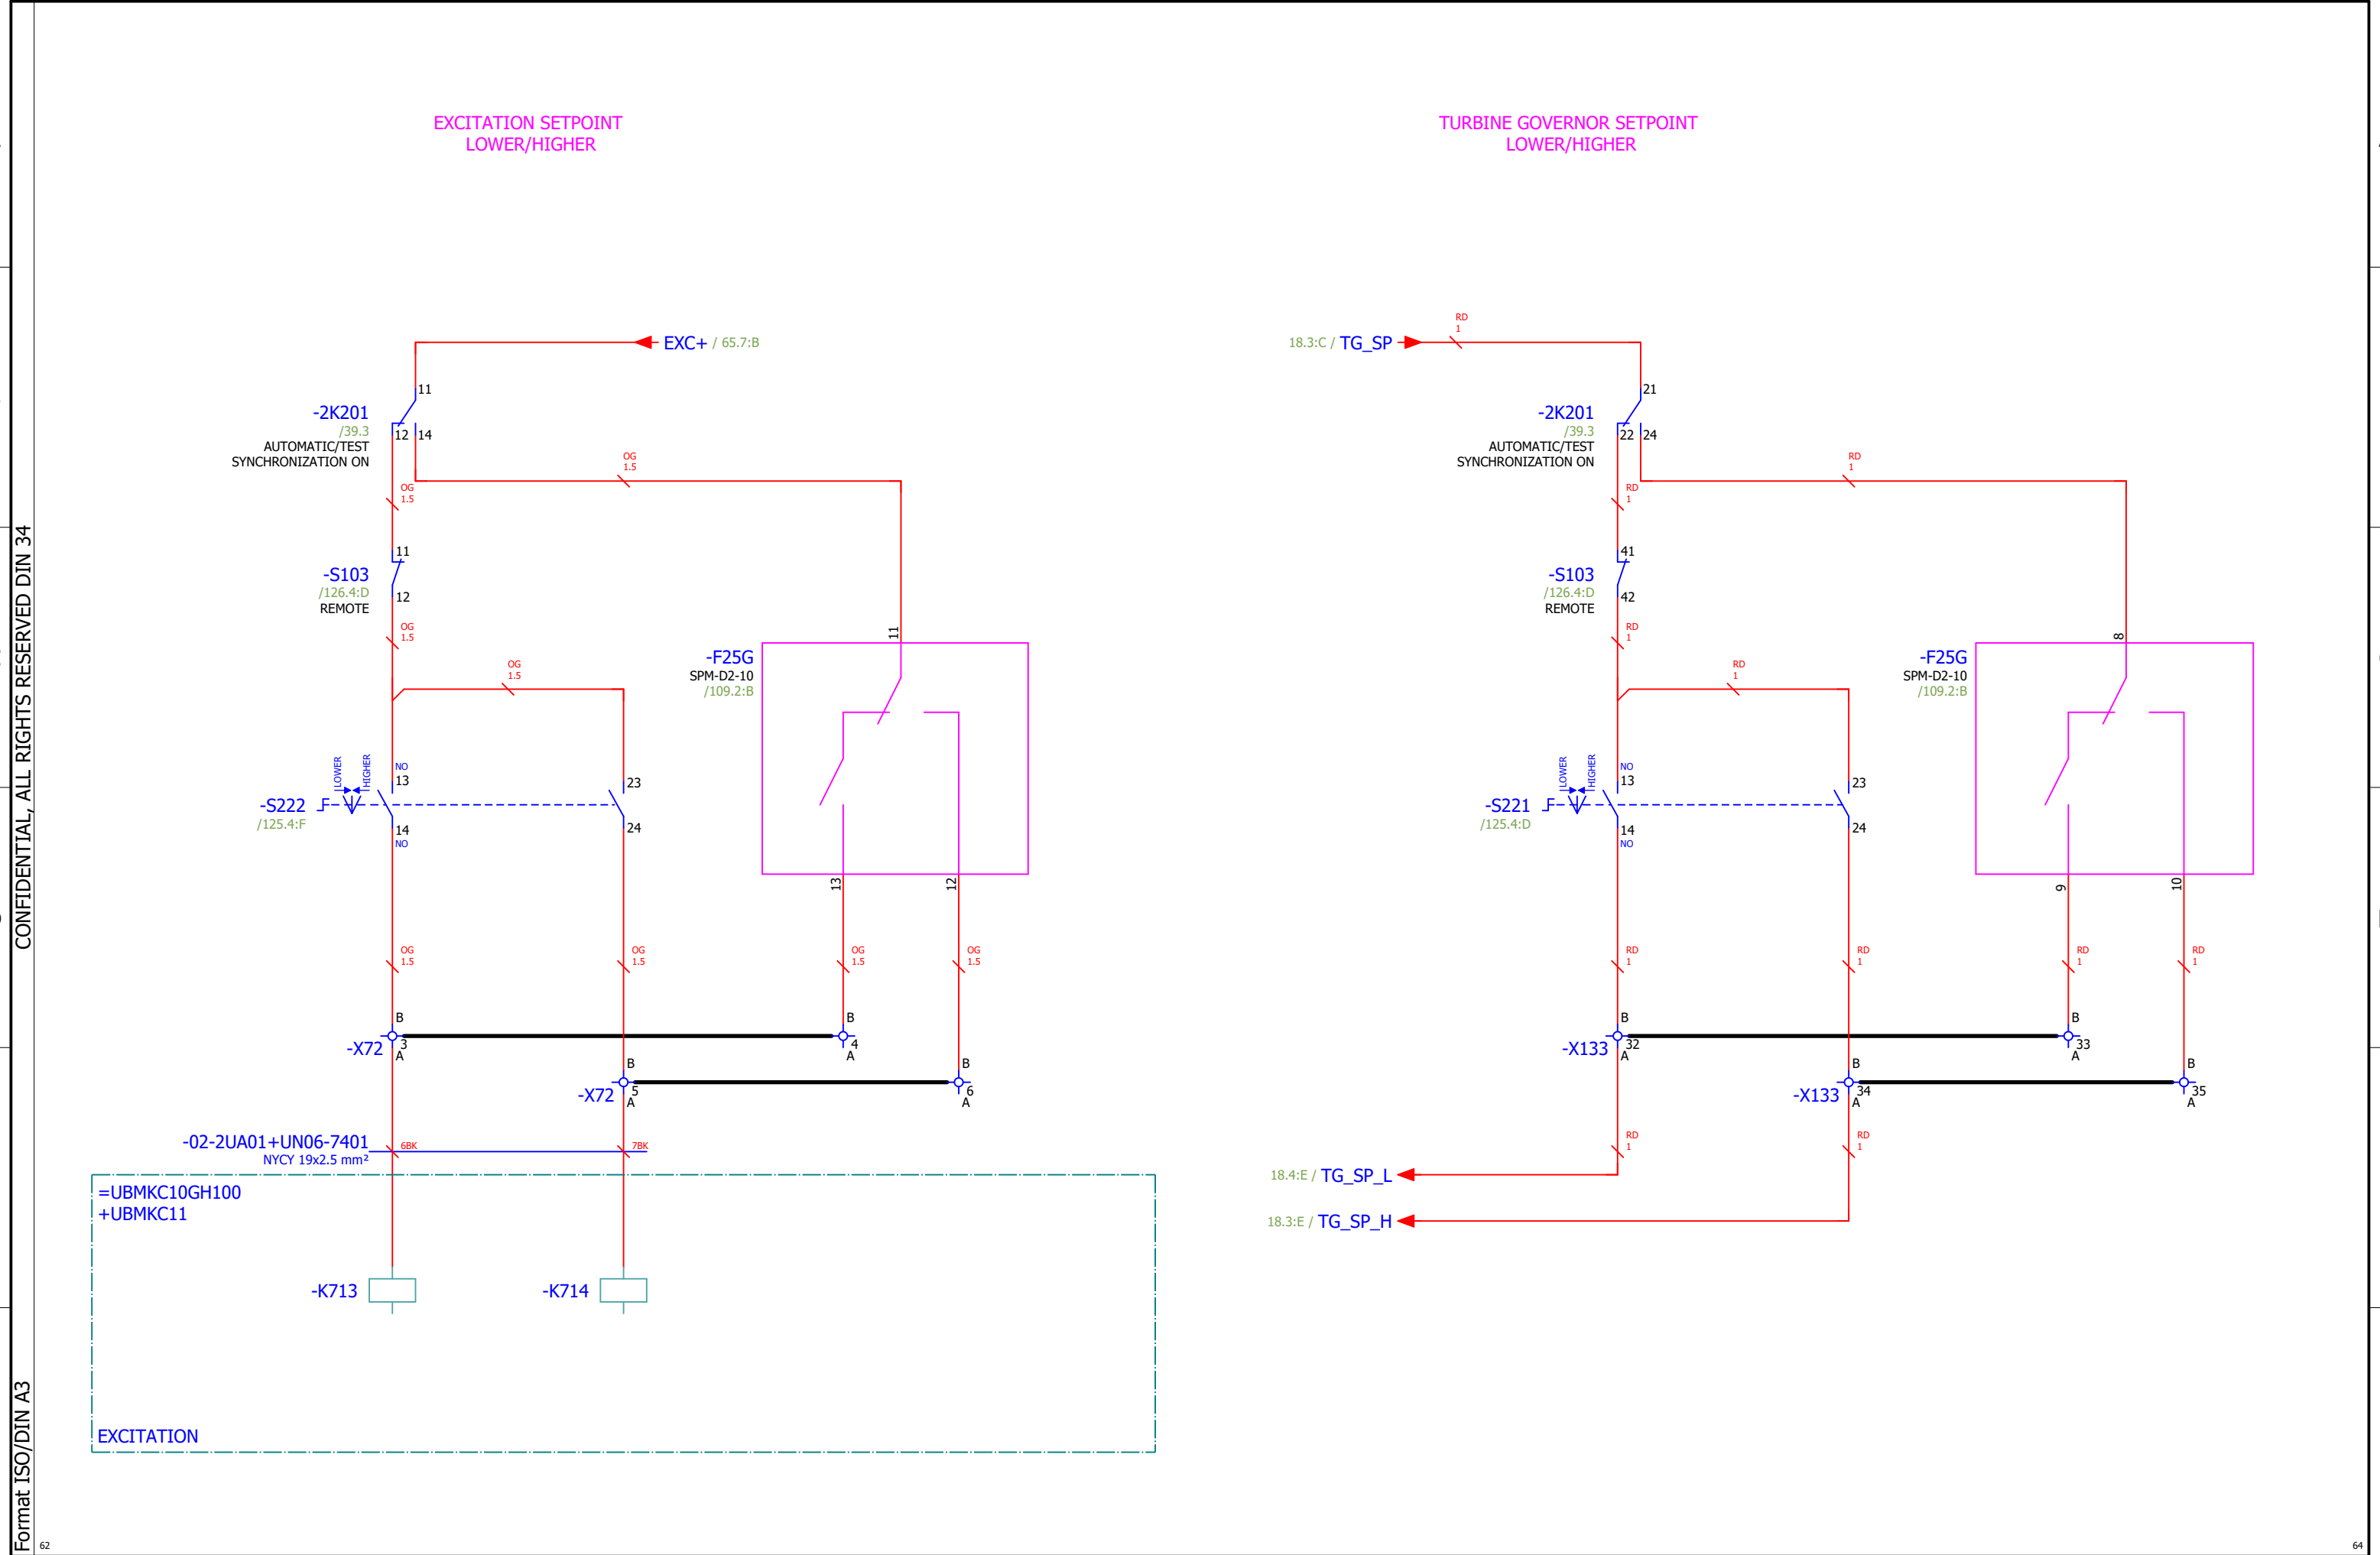

Approved by Contractor			Reconstruction and Modernisation of HPP Perucica - Phase II		SINTAKSA A Voith Company	Unit KA2 control cubicle circuit diagrams	DRAWING No.: PERU-01-19-170-31-002	REV No.: 02	= UBCJA10GH100
Approved by Designer	Grga Kolić	01.10.2026.			Sintaksa - A Voith Company Ulica Domovinskog rata 104C, 21 000 Split, Hrvatska	SYNCHRONIZATION	Designer No.:	SALES No.:	+ UBCJA10
Checked by	Antonio Aleksić	01.10.2026.							PAGE 63
Drawn by	Tamara Trogrlić	01.10.2026.	PROJECT NAME	EMPLOYER	DESIGNER				PAGE 63 / 157


CONFIDENTIAL, ALL RIGHTS RESERVED DIN 34

Format ISO/DIN A3

63


Approved by Contractor			Reconstruction and Modernisation of HPP Perucica - Phase II		 A Voith Company Sintaksa - A Voith Company Ulica Domovinskog rata 104C, 21 000 Split, Hrvatska	Unit KA2 control cubicle circuit diagrams SYNCHRONIZATION	DRAWING No.:	REV No.:	= UBCJA10GH100
Approved by Designer	Grga Kolić	01.10.2026.					PERU-01-19-170-31-002	02	+ UBCJA10
Checked by	Antonio Aleksić	01.10.2026.					Designer No.:	SALES No.:	PAGE
Drawn by	Tamara Trogrlić	01.10.2026.							64
			PROJECT NAME	EMPLOYER	DESIGNER				PAGE 64 / 157

1 2 3 4 5 6 7 8

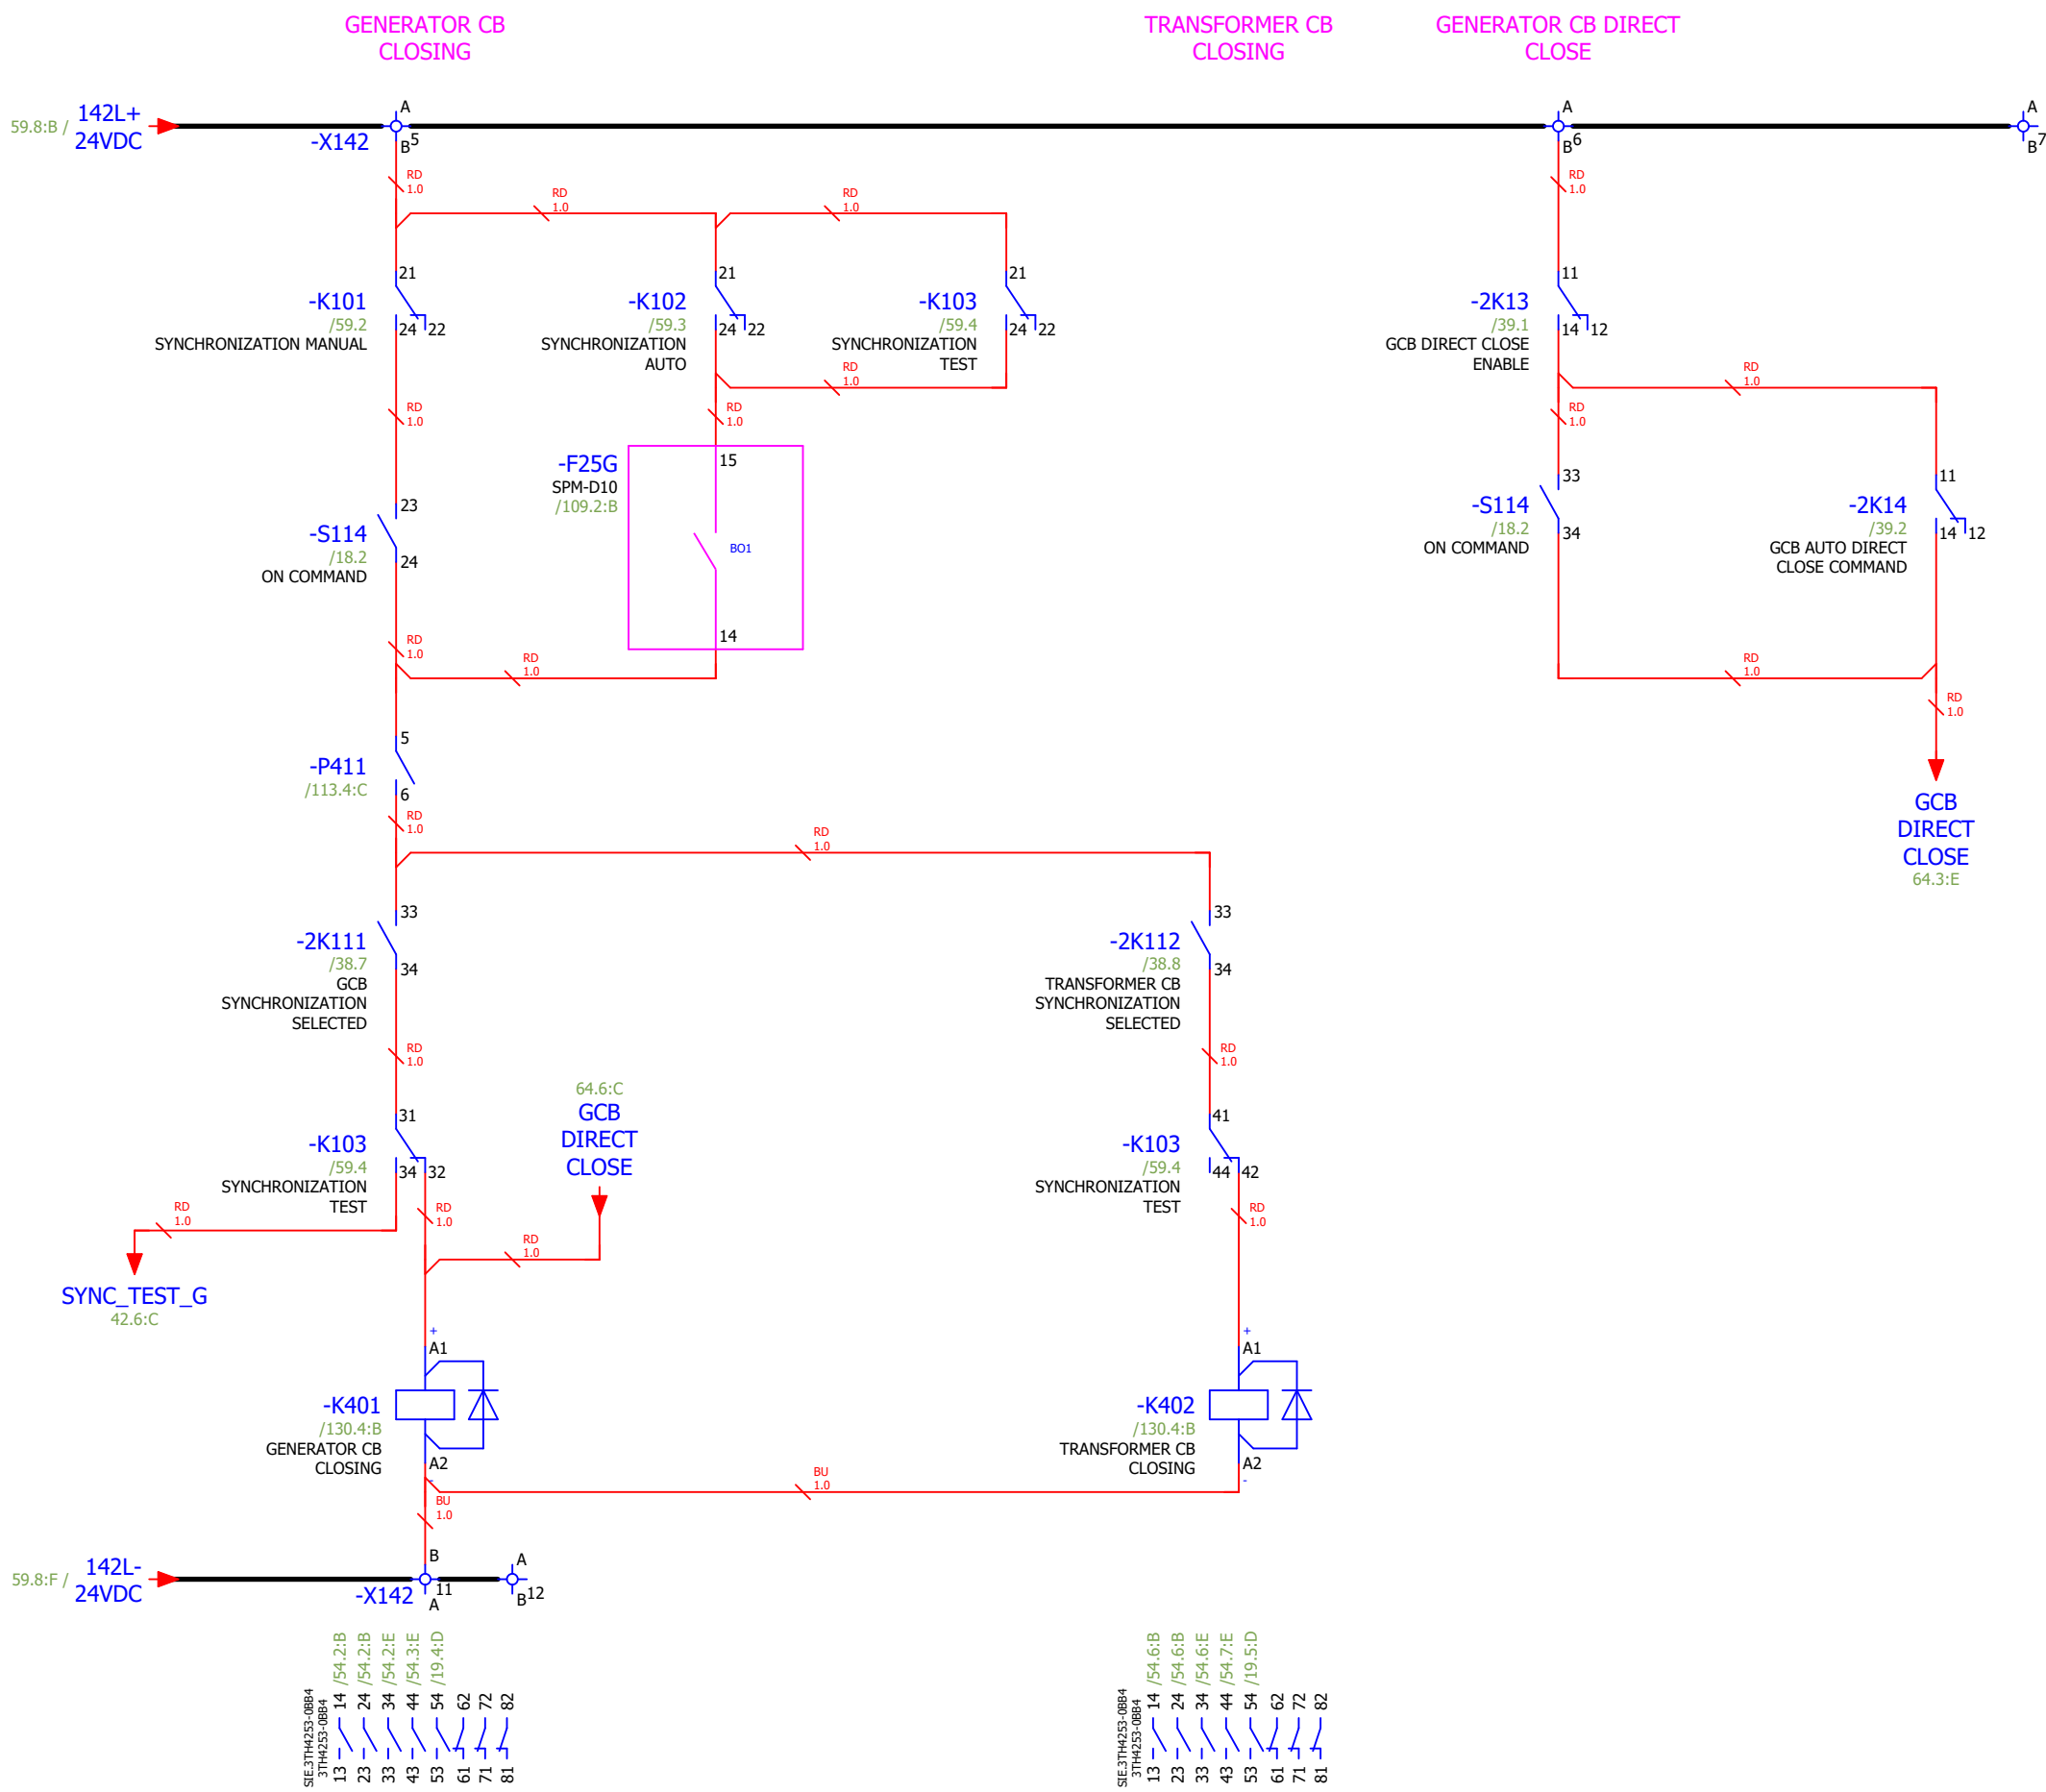

65

Format ISO/DIN A3

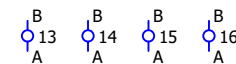


1	2	3	4	5	6	7	8
---	---	---	---	---	---	---	---

ESD VALVE CLOSED



1	2	3	4	5	6	7	8
---	---	---	---	---	---	---	---

Format ISO/DIN A3

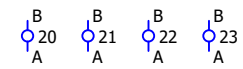68

CONFIDENTIAL, ALL RIGHTS RESERVED DIN 34

Format ISO/DIN A3

67

Approved by Contractor			Reconstruction and Modernisation of HPP Perucica - Phase II		 A Voith Company Sintaksa - A Voith Company Ulica Domovinskog rata 104C, 21 000 Split, Hrvatska	Unit KA2 control cubicle circuit diagrams SIGNAL COLUMN	DRAWING No.: PERU-01-19-170-31-002	REV No.: 02	= UBCJA10GH100
Approved by Designer	Grga Kolić	01.10.2026.							+ UBCJA10
Checked by	Antonio Aleksić	01.10.2026.					Designer No.:	SALES No.:	PAGE 68
Drawn by	Tamara Trogrlić	01.10.2026.							PAGE 68 / 157

12345678

A

B

C

D

E

F

A


B

C

D


E

F

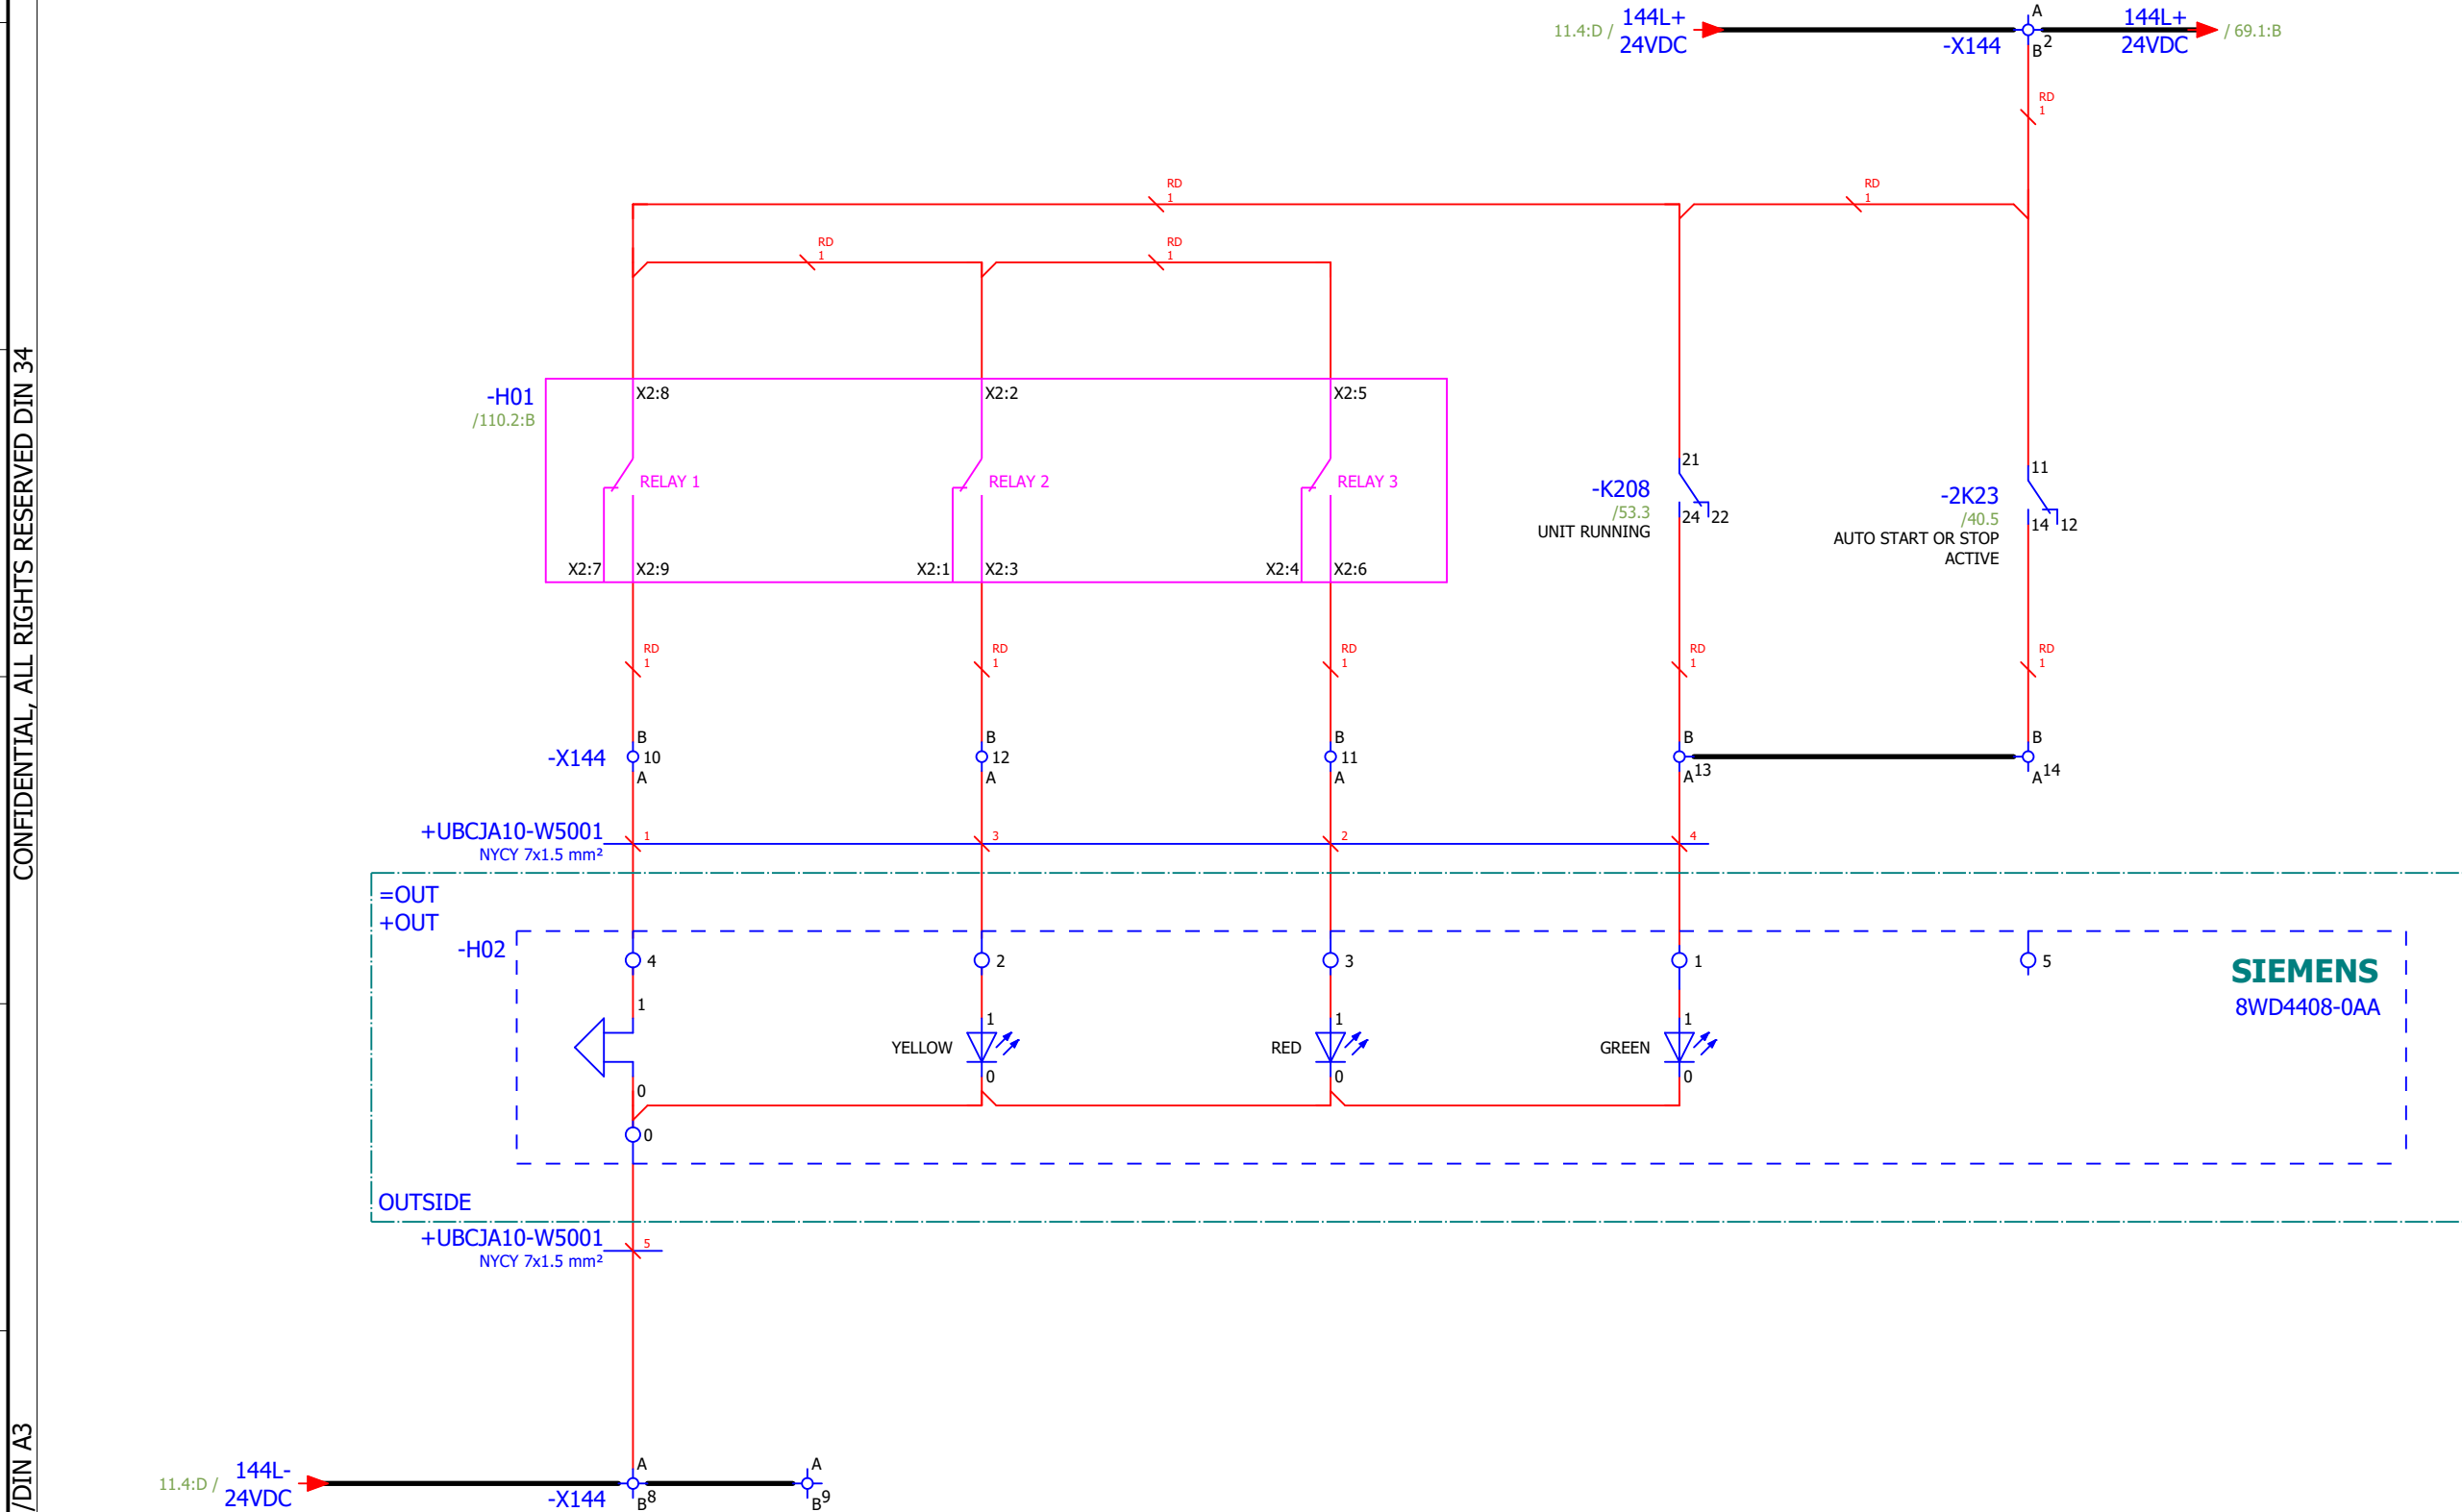

CONFIDENTIAL, ALL RIGHTS RESERVED DIN 34

Format ISO/DIN A3

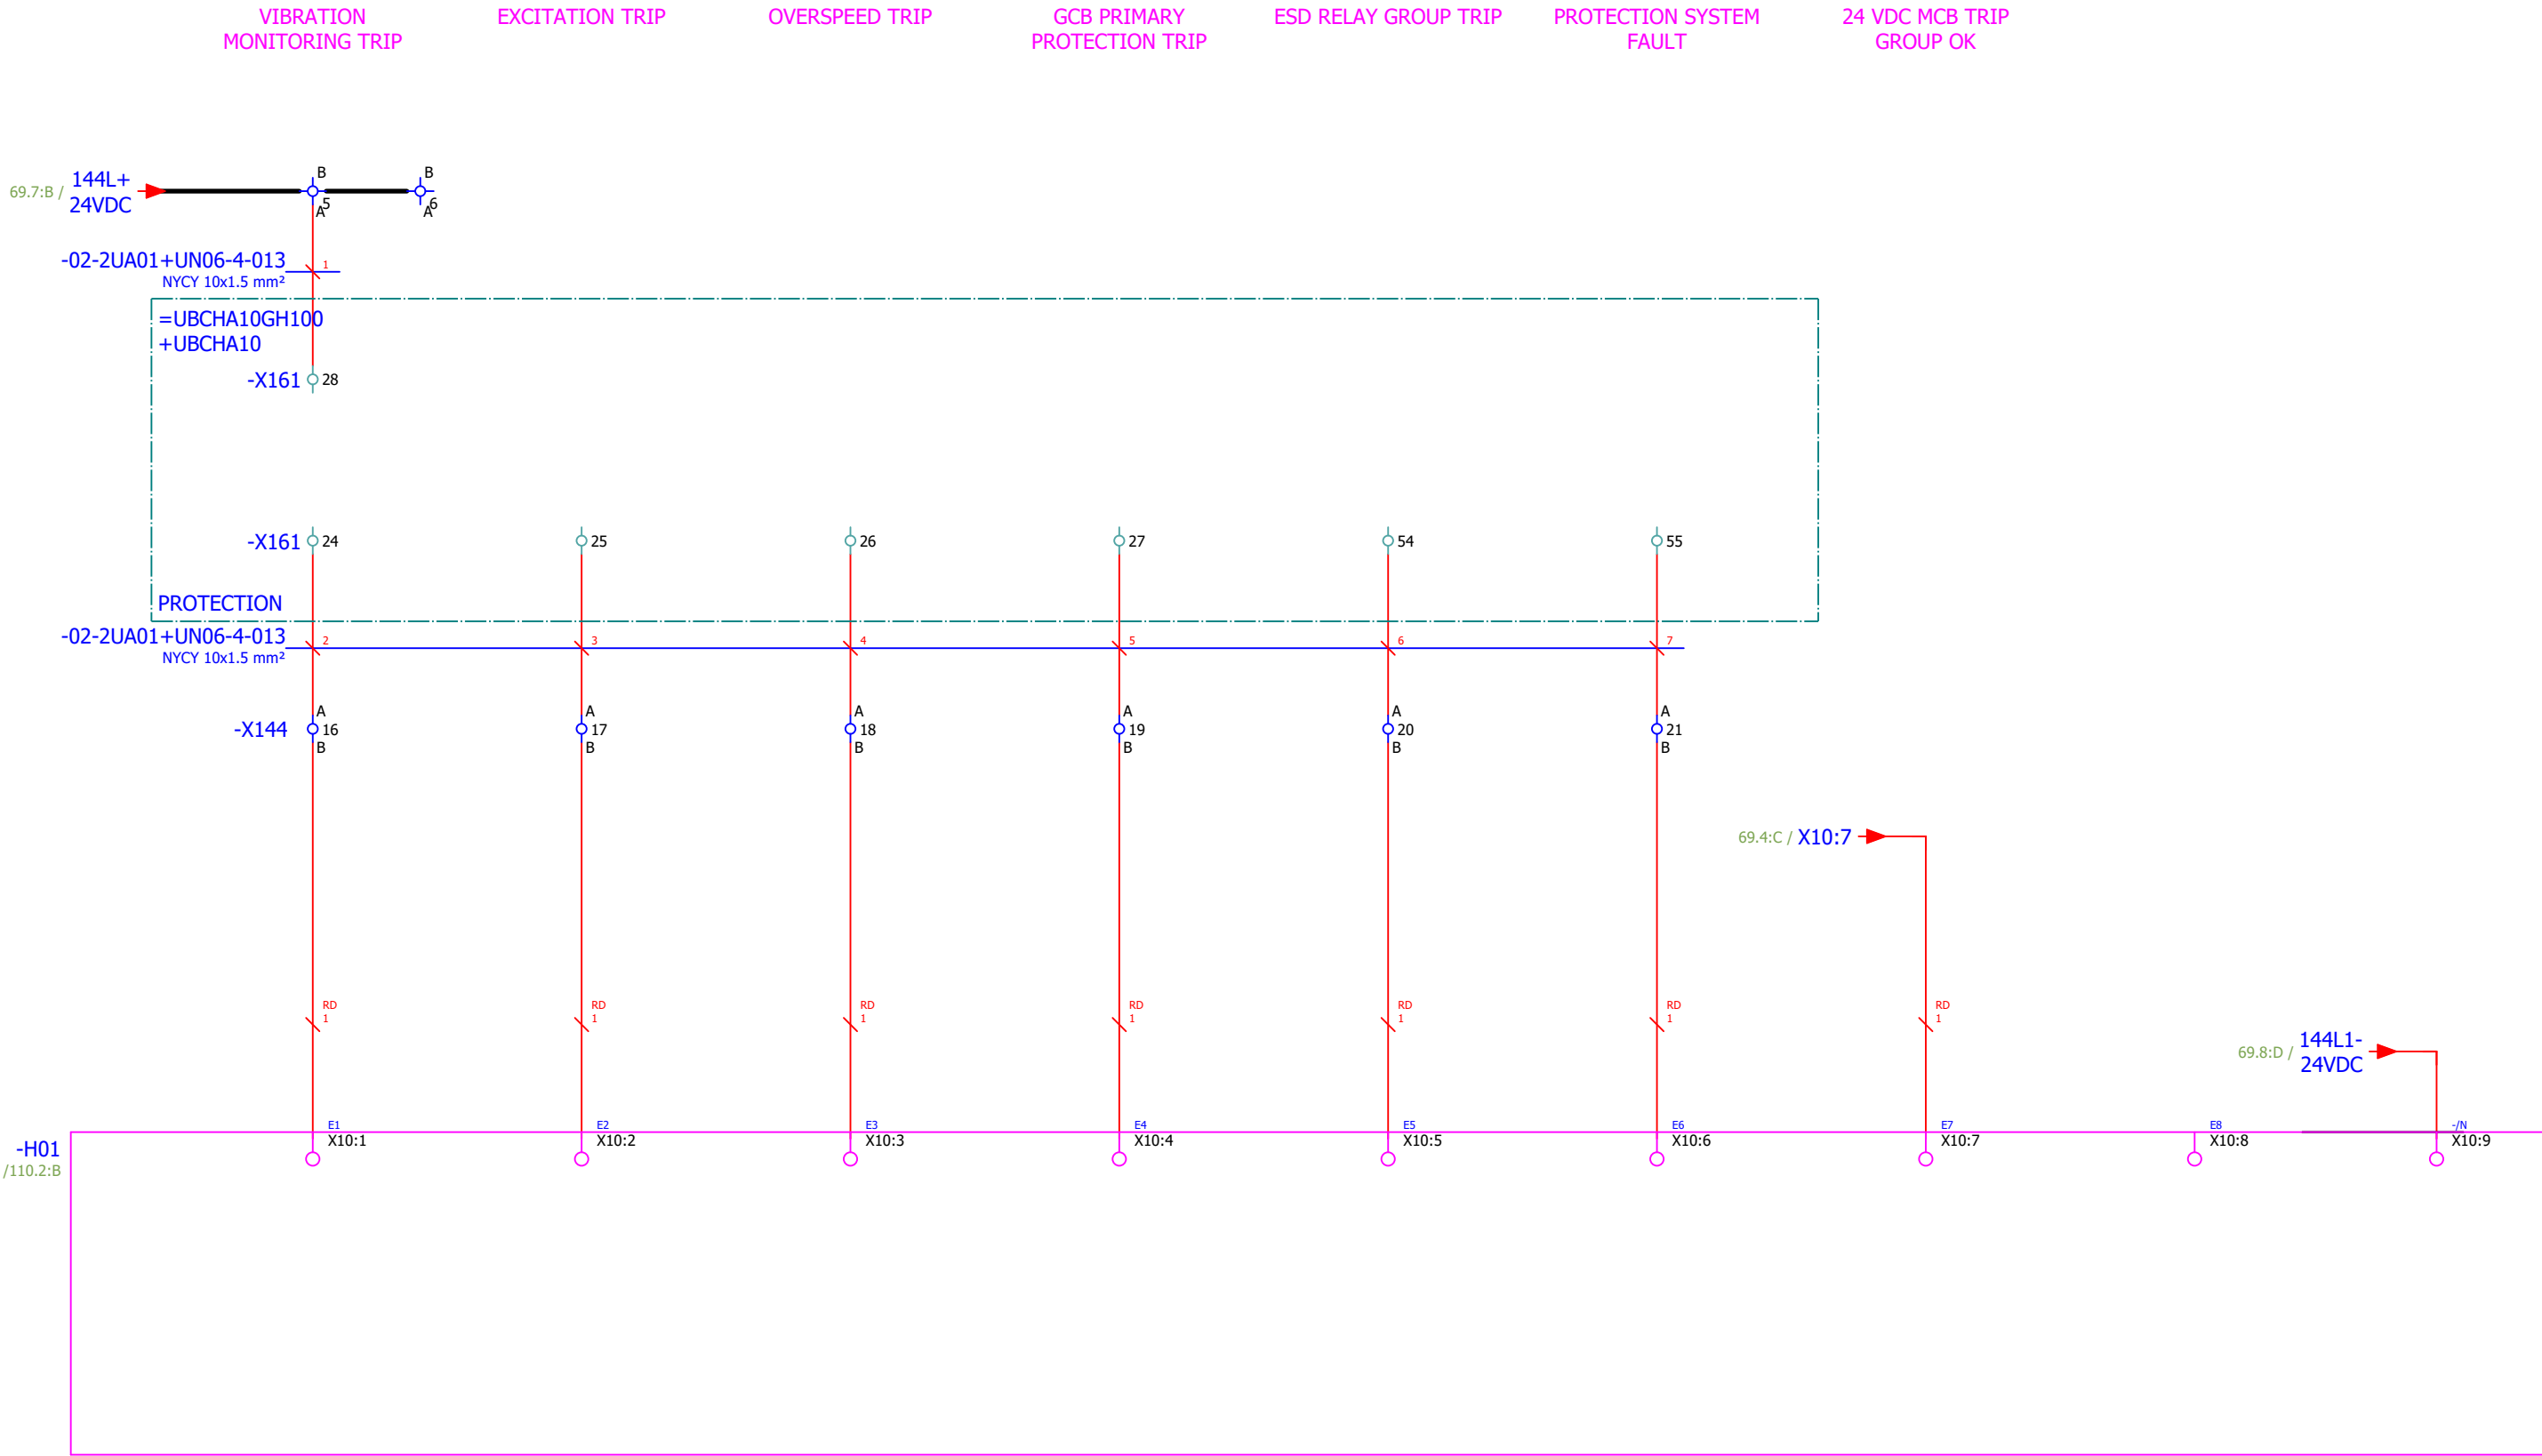

Approved by Contractor			Reconstruction and Modernisation of HPP Perucica - Phase II		 A Voith Company Sintaksa - A Voith Company Ulica Domovinskog rata 104C, 21 000 Split, Hrvatska	Unit KA2 control cubicle circuit diagrams ALARM ANNUNCIATOR - TRIP	DRAWING No.:	REV No.:	= UBCJA10GH100
Approved by Designer	Grga Kolić	01.10.2026.					PERU-01-19-170-31-002	02	+ UBCJA10
Checked by	Antonio Aleksić	01.10.2026.					Designer No.:	SALES No.:	PAGE 70
Drawn by	Tamara Trogrlić	01.10.2026.							PAGE 70 / 157

CONFIDENTIAL, ALL RIGHTS RESERVED DIN 34

Format ISO/DIN A3


70

72

Approved by Contractor			Reconstruction and Modernisation of HPP Perucica - Phase II		 A Voith Company Sintaksa - A Voith Company Ulica Domovinskog rata 104C, 21 000 Split, Hrvatska	Unit KA2 control cubicle circuit diagrams ALARM ANNUNCIATOR - TRIP	DRAWING No.: PERU-01-19-170-31-002	REV No.: 02	= UBCJA10GH100 + UBCJA10
Approved by Designer	Grga Kolić	01.10.2026.					Designer No.:	SALES No.:	PAGE 71
Checked by	Antonio Aleksić	01.10.2026.	PROJECT NAME	EMPLOYER	DESIGNER				PAGE 71 / 157
Drawn by	Tamara Trogrlić	01.10.2026.							

71

73

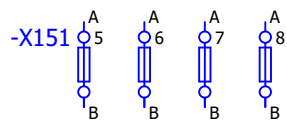

CONFIDENTIAL, ALL RIGHTS RESERVED DIN 34
Format ISO/DIN A3

72

Approved by Contractor			Reconstruction and Modernisation of HPP Perucica - Phase II		 Sintaksa - A Voith Company Ulica Domovinskog rata 104C, 21 000 Split, Hrvatska	Unit KA2 control cubicle circuit diagrams CT CIRCUITS	DRAWING No.: PERU-01-19-170-31-002	REV No.: 02	= UBCJA10GH100 + UBCJA10
Approved by Designer	Grga Kolić	01.10.2026.					Designer No.:	SALES No.:	PAGE 73
Checked by	Antonio Aleksić	01.10.2026.							
Drawn by	Tamara Trogrlić	01.10.2026.							PAGE 73 / 157

A

B

C

D

E

F

A


B

C

D


E

F

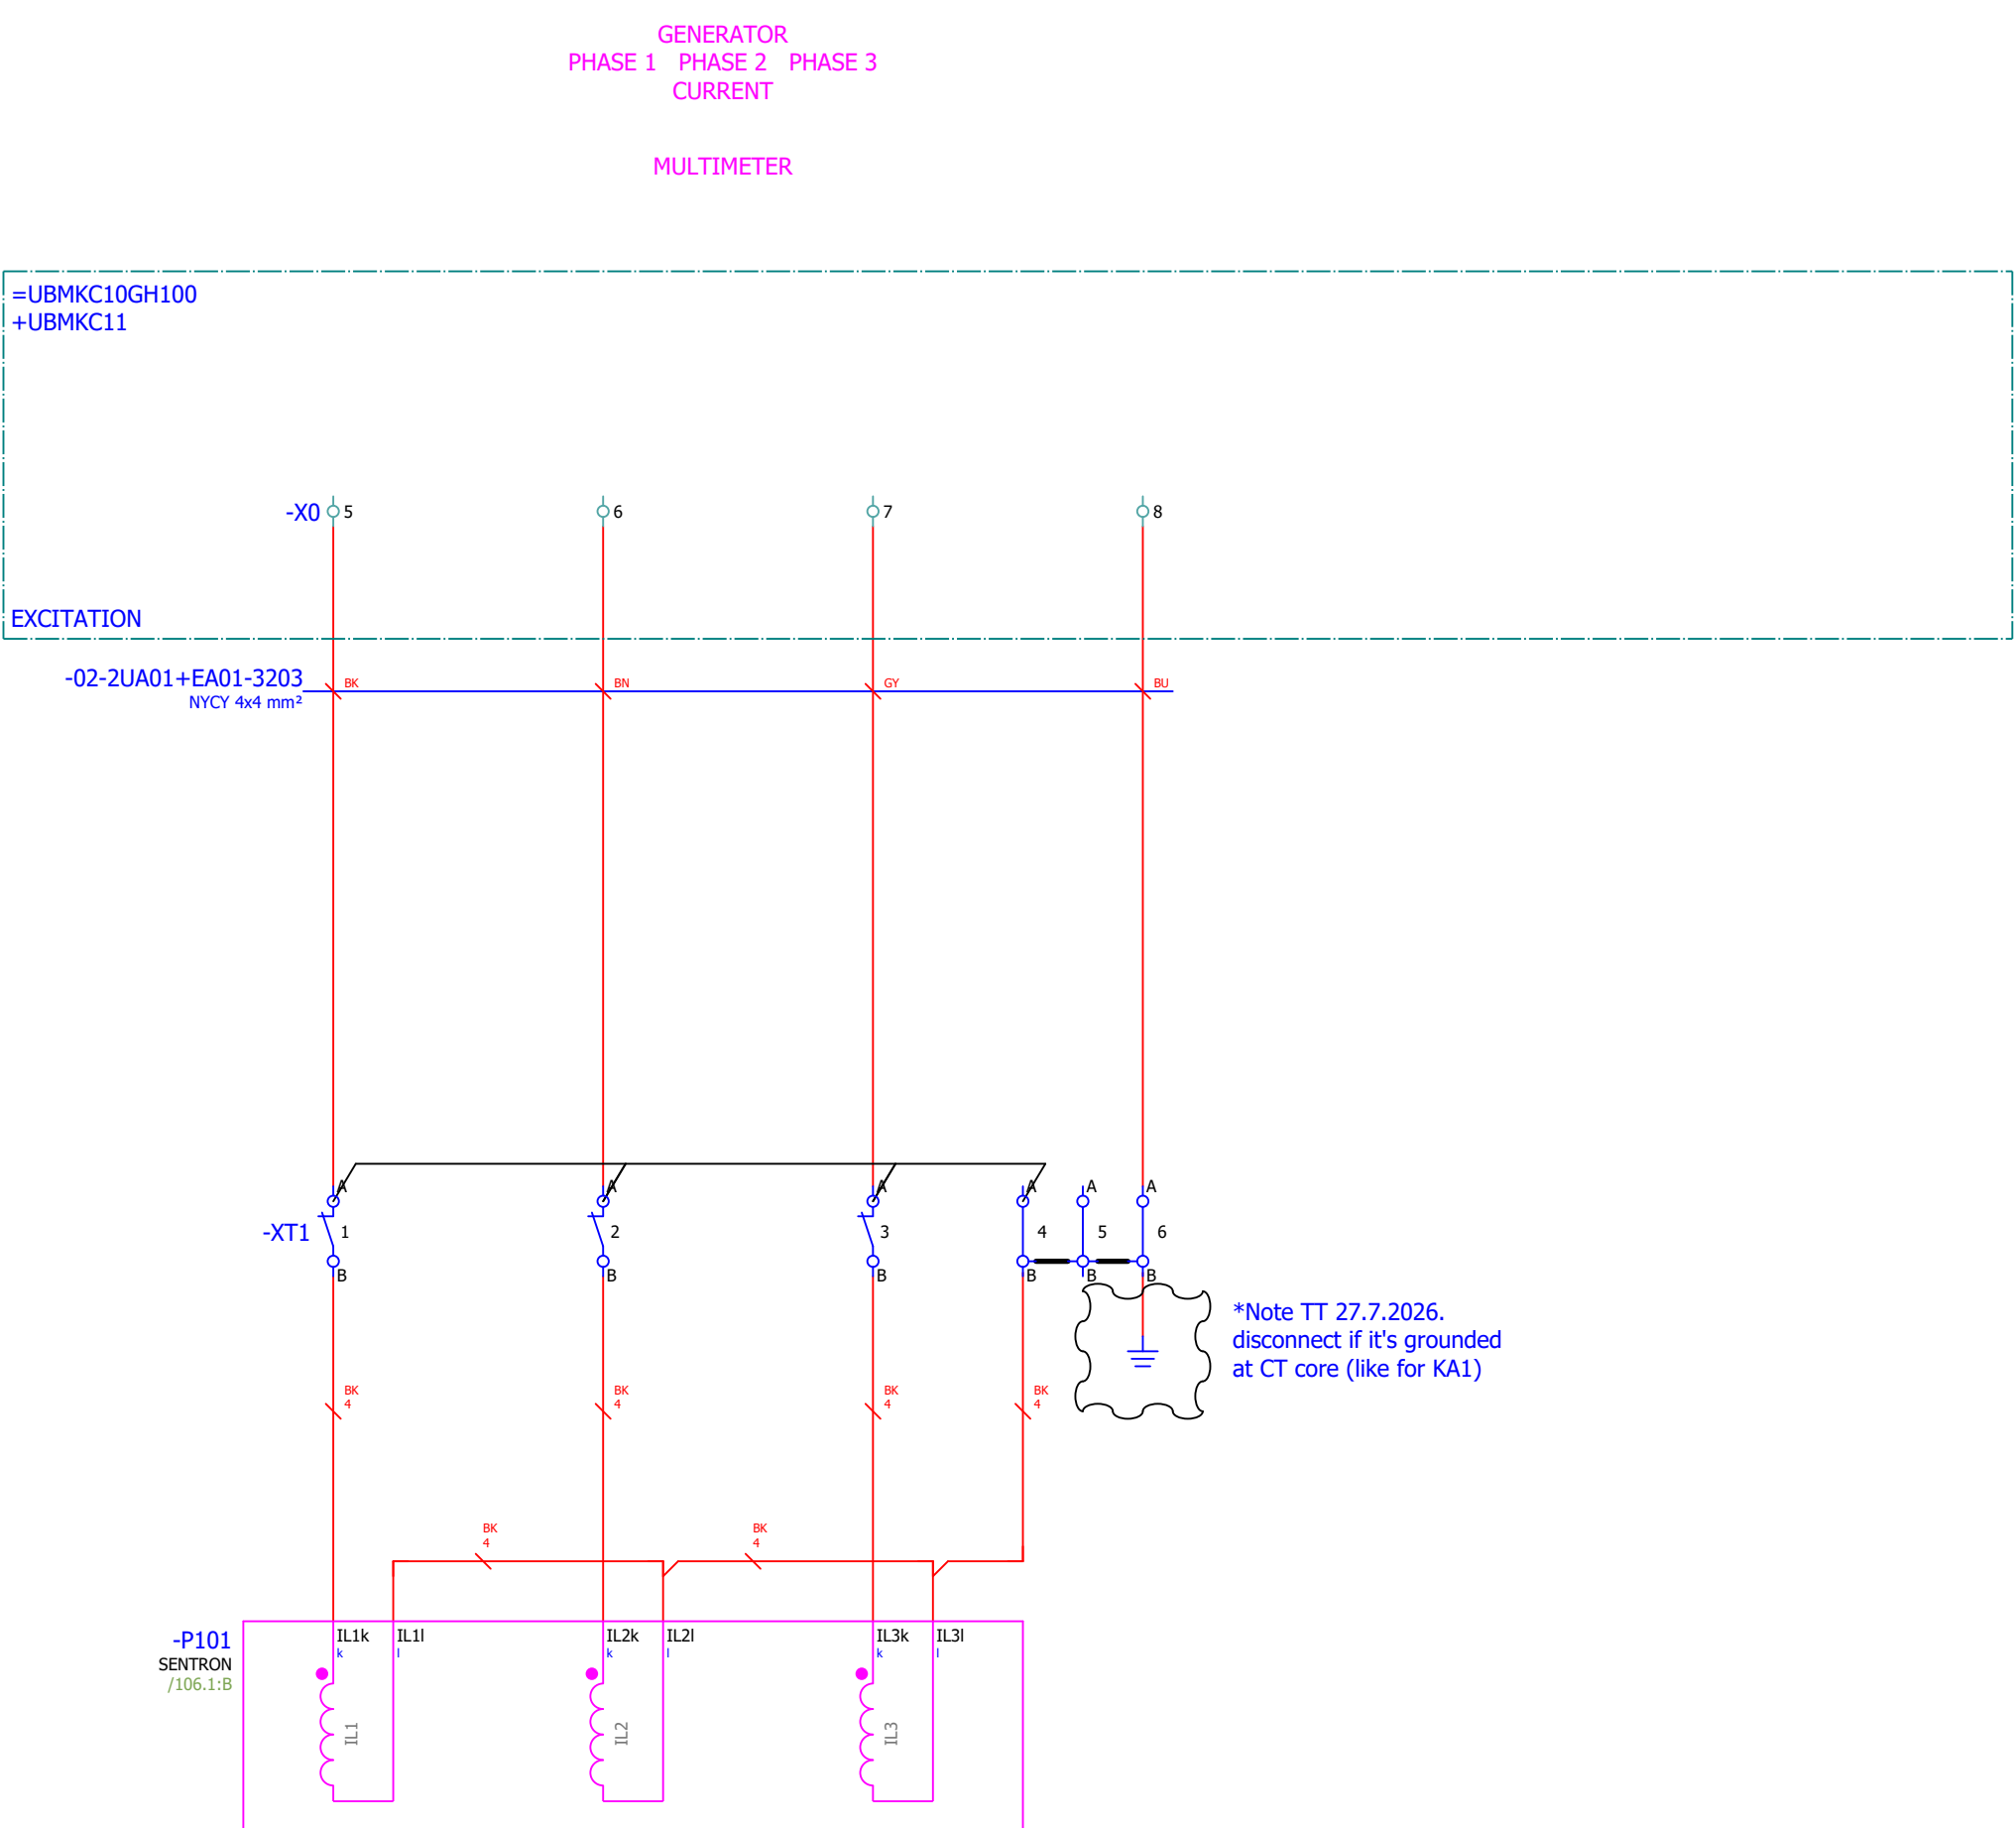

74

CONFIDENTIAL, ALL RIGHTS RESERVED DIN 34
Format ISO/DIN A3

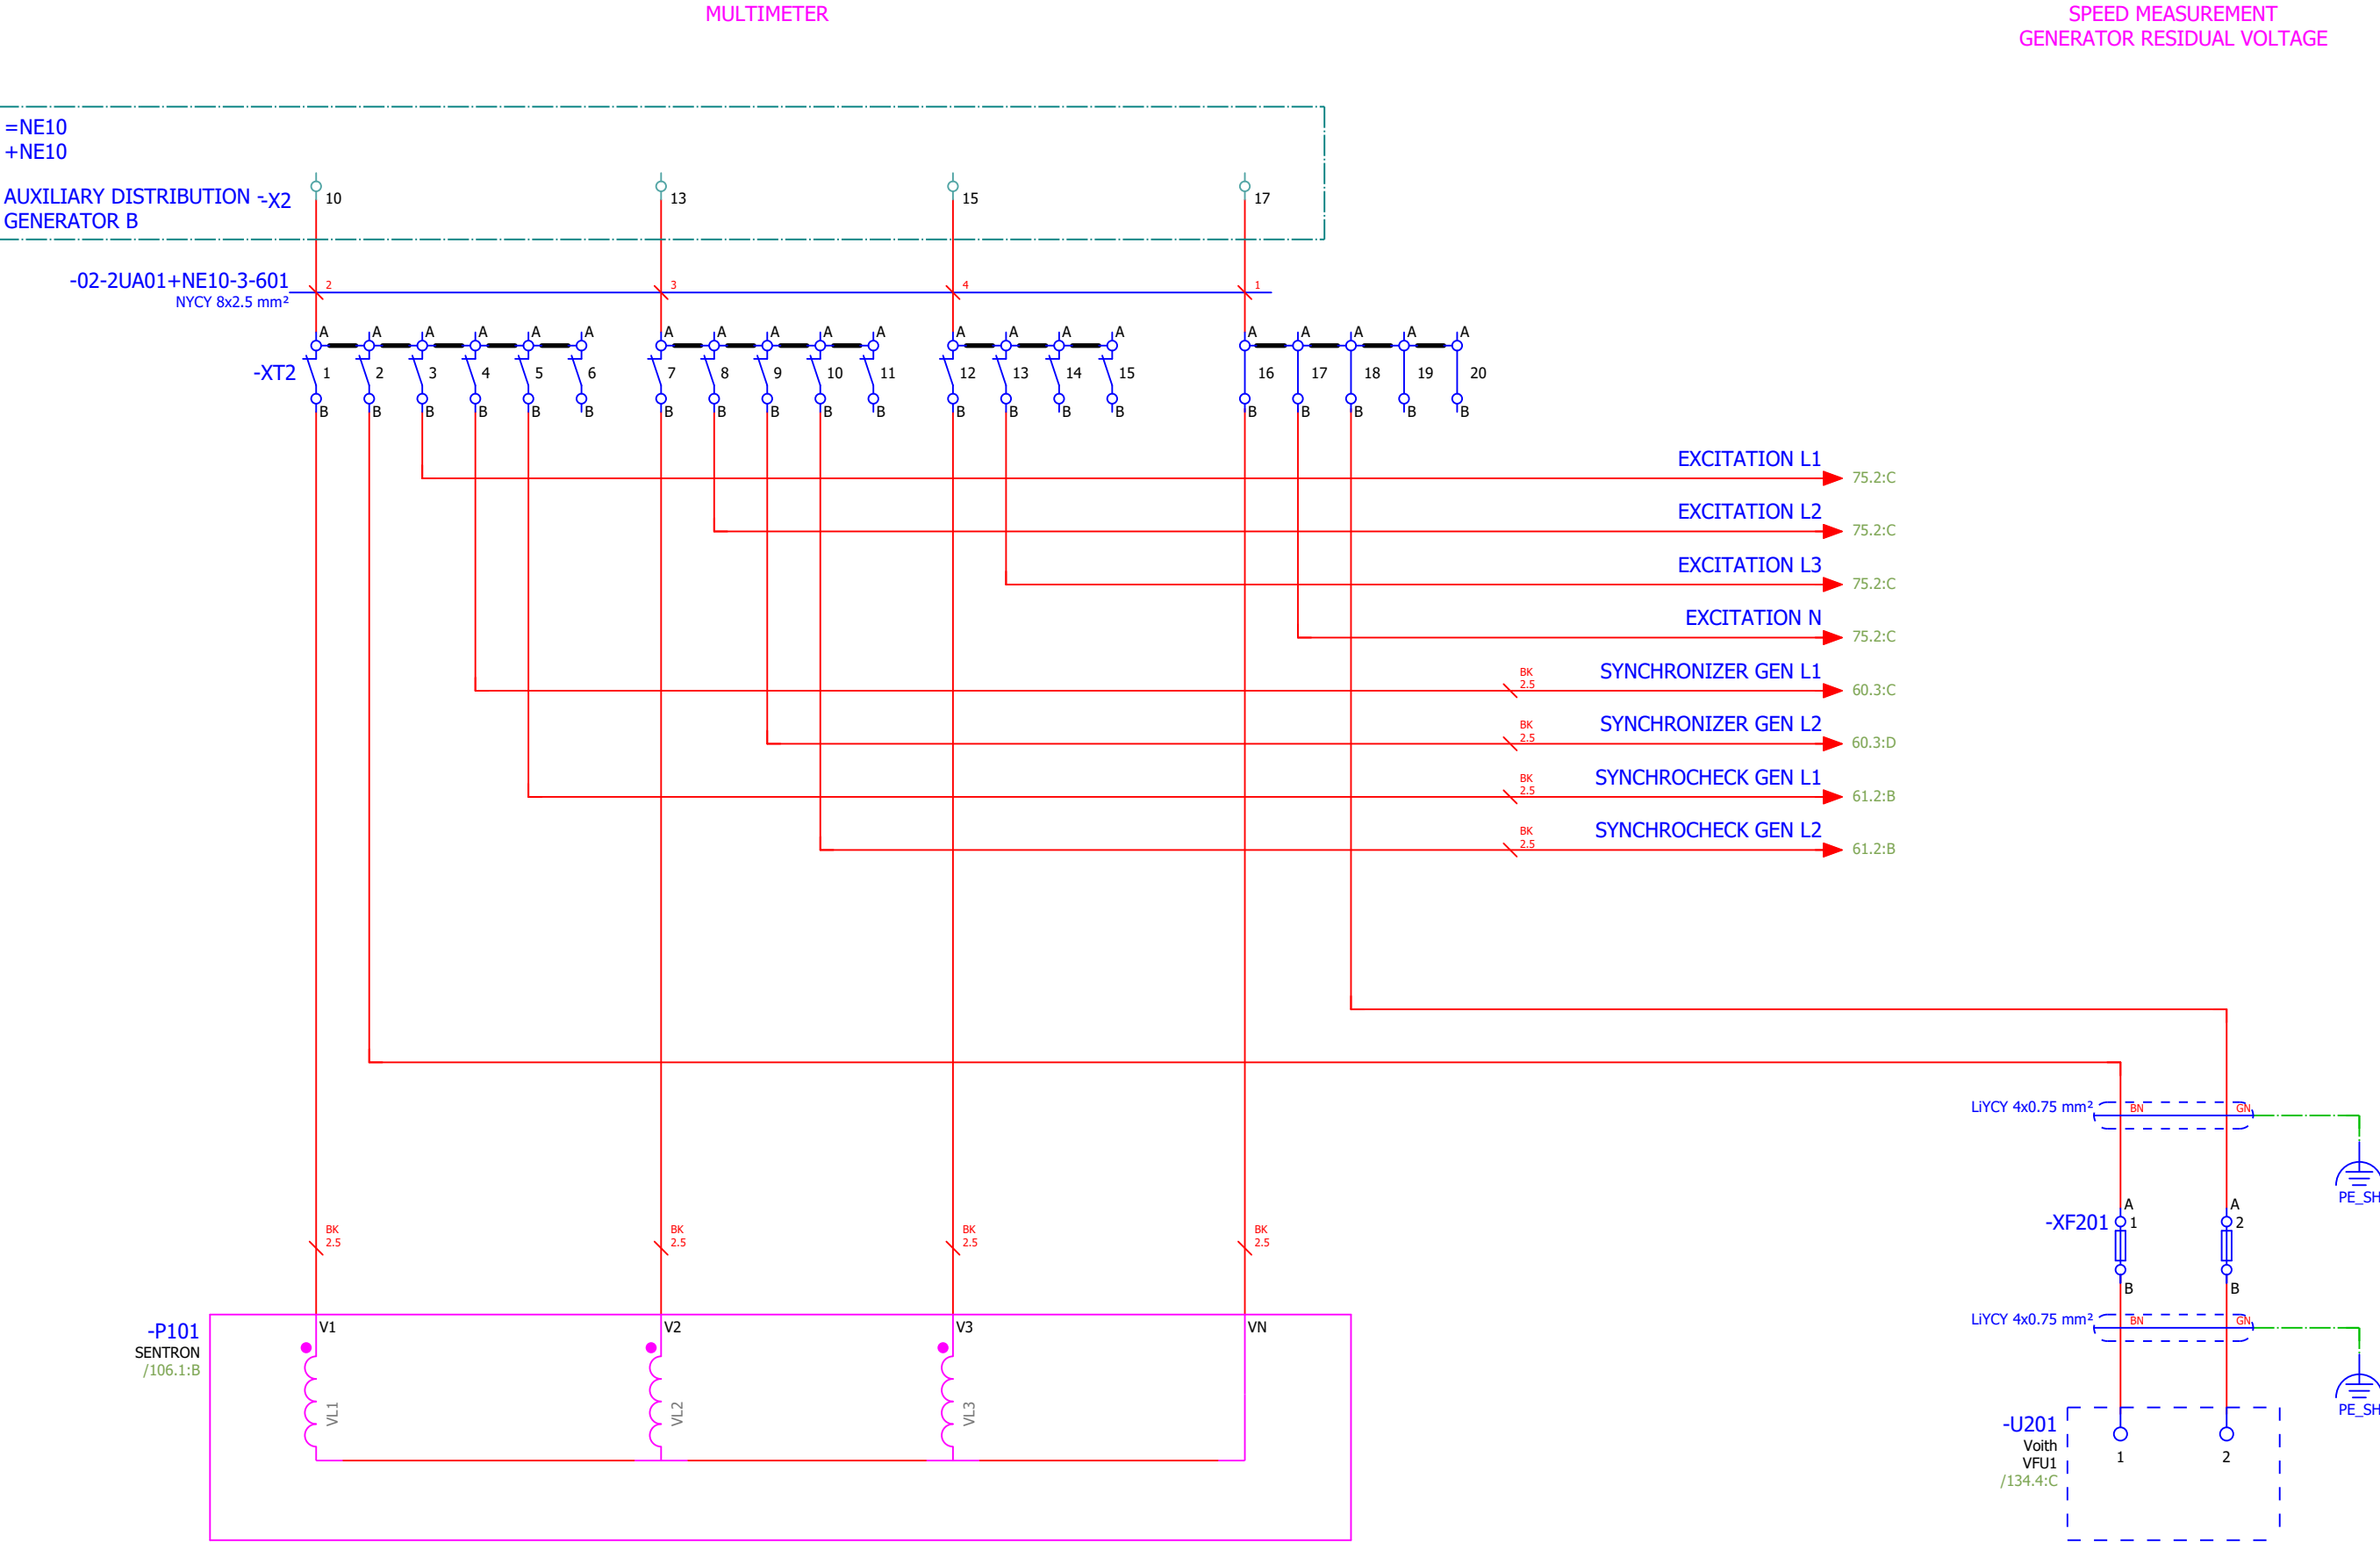

Approved by Contractor			Reconstruction and Modernisation of HPP Perucica - Phase II		SINTAKSA A Voith Company Sintaksa - A Voith Company Ulica Domovinskog rata 104C, 21 000 Split, Hrvatska	Unit KA2 control cubicle circuit diagrams VT CIRCUITS	DRAWING No.: PERU-01-19-170-31-002	REV No.: 02	= UBCJA10GH100
Approved by Designer	Grga Kolić	01.10.2026.					Designer No.:	SALES No.:	+ UBCJA10
Checked by	Antonio Aleksić	01.10.2026.							PAGE 74
Drawn by	Tamara Trogrlić	01.10.2026.							PAGE 74 / 157


CONFIDENTIAL, ALL RIGHTS RESERVED DIN 34

Format ISO/DIN A3

74


76

Approved by Contractor			Reconstruction and Modernisation of HPP Perucica - Phase II		 A Voith Company Sintaksa - A Voith Company Ulica Domovinskog rata 104C, 21 000 Split, Hrvatska	Unit KA2 control cubicle circuit diagrams VT CIRCUITS	DRAWING No.: PERU-01-19-170-31-002	REV No.: 02	= UBCJA10GH100 + UBCJA10
Approved by Designer	Grga Kolić	01.10.2026.					Designer No.:	SALES No.:	PAGE 75
Checked by	Antonio Aleksić	01.10.2026.							PAGE 75 / 157
Drawn by	Tamara Trogrlić	01.10.2026.							

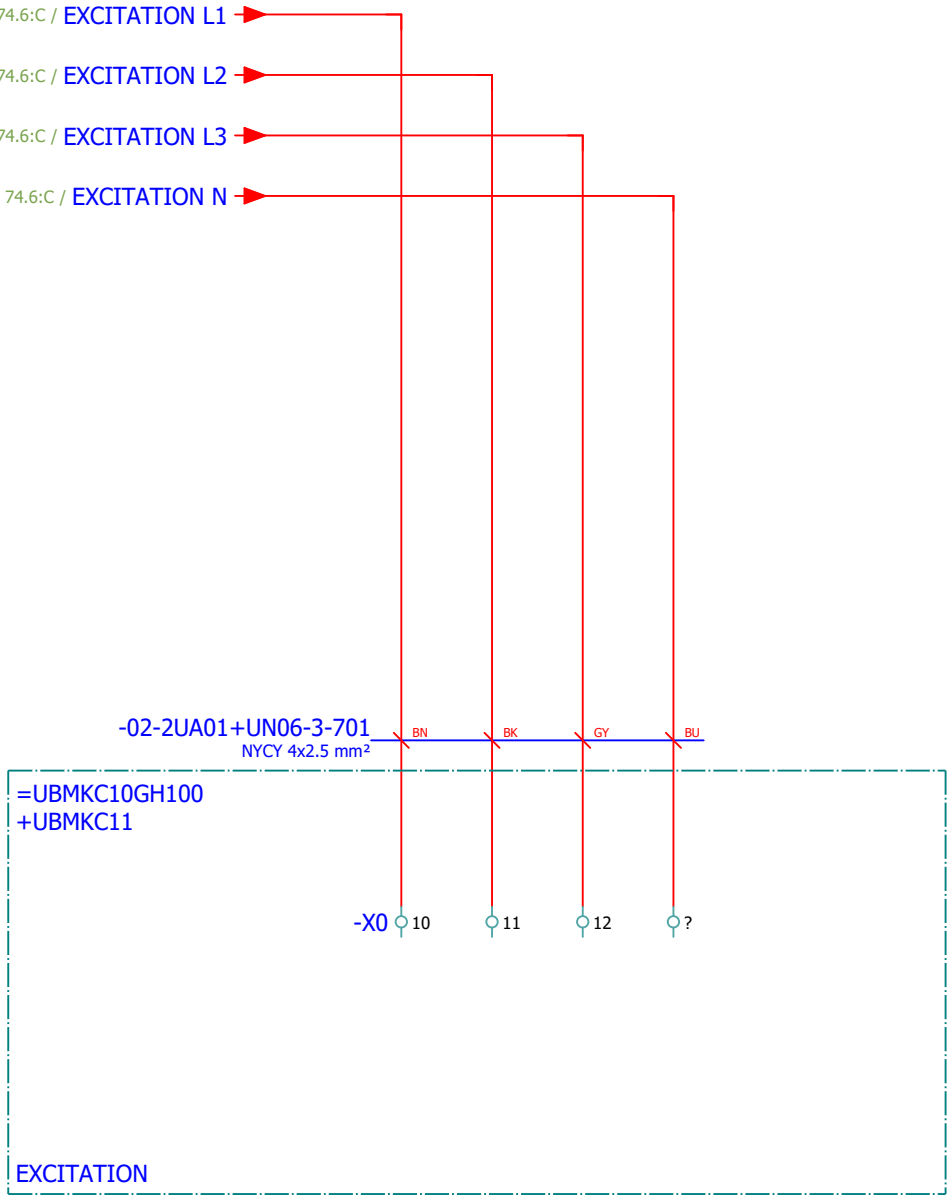

CONFIDENTIAL, ALL RIGHTS RESERVED DIN 34

Format ISO/DIN A3

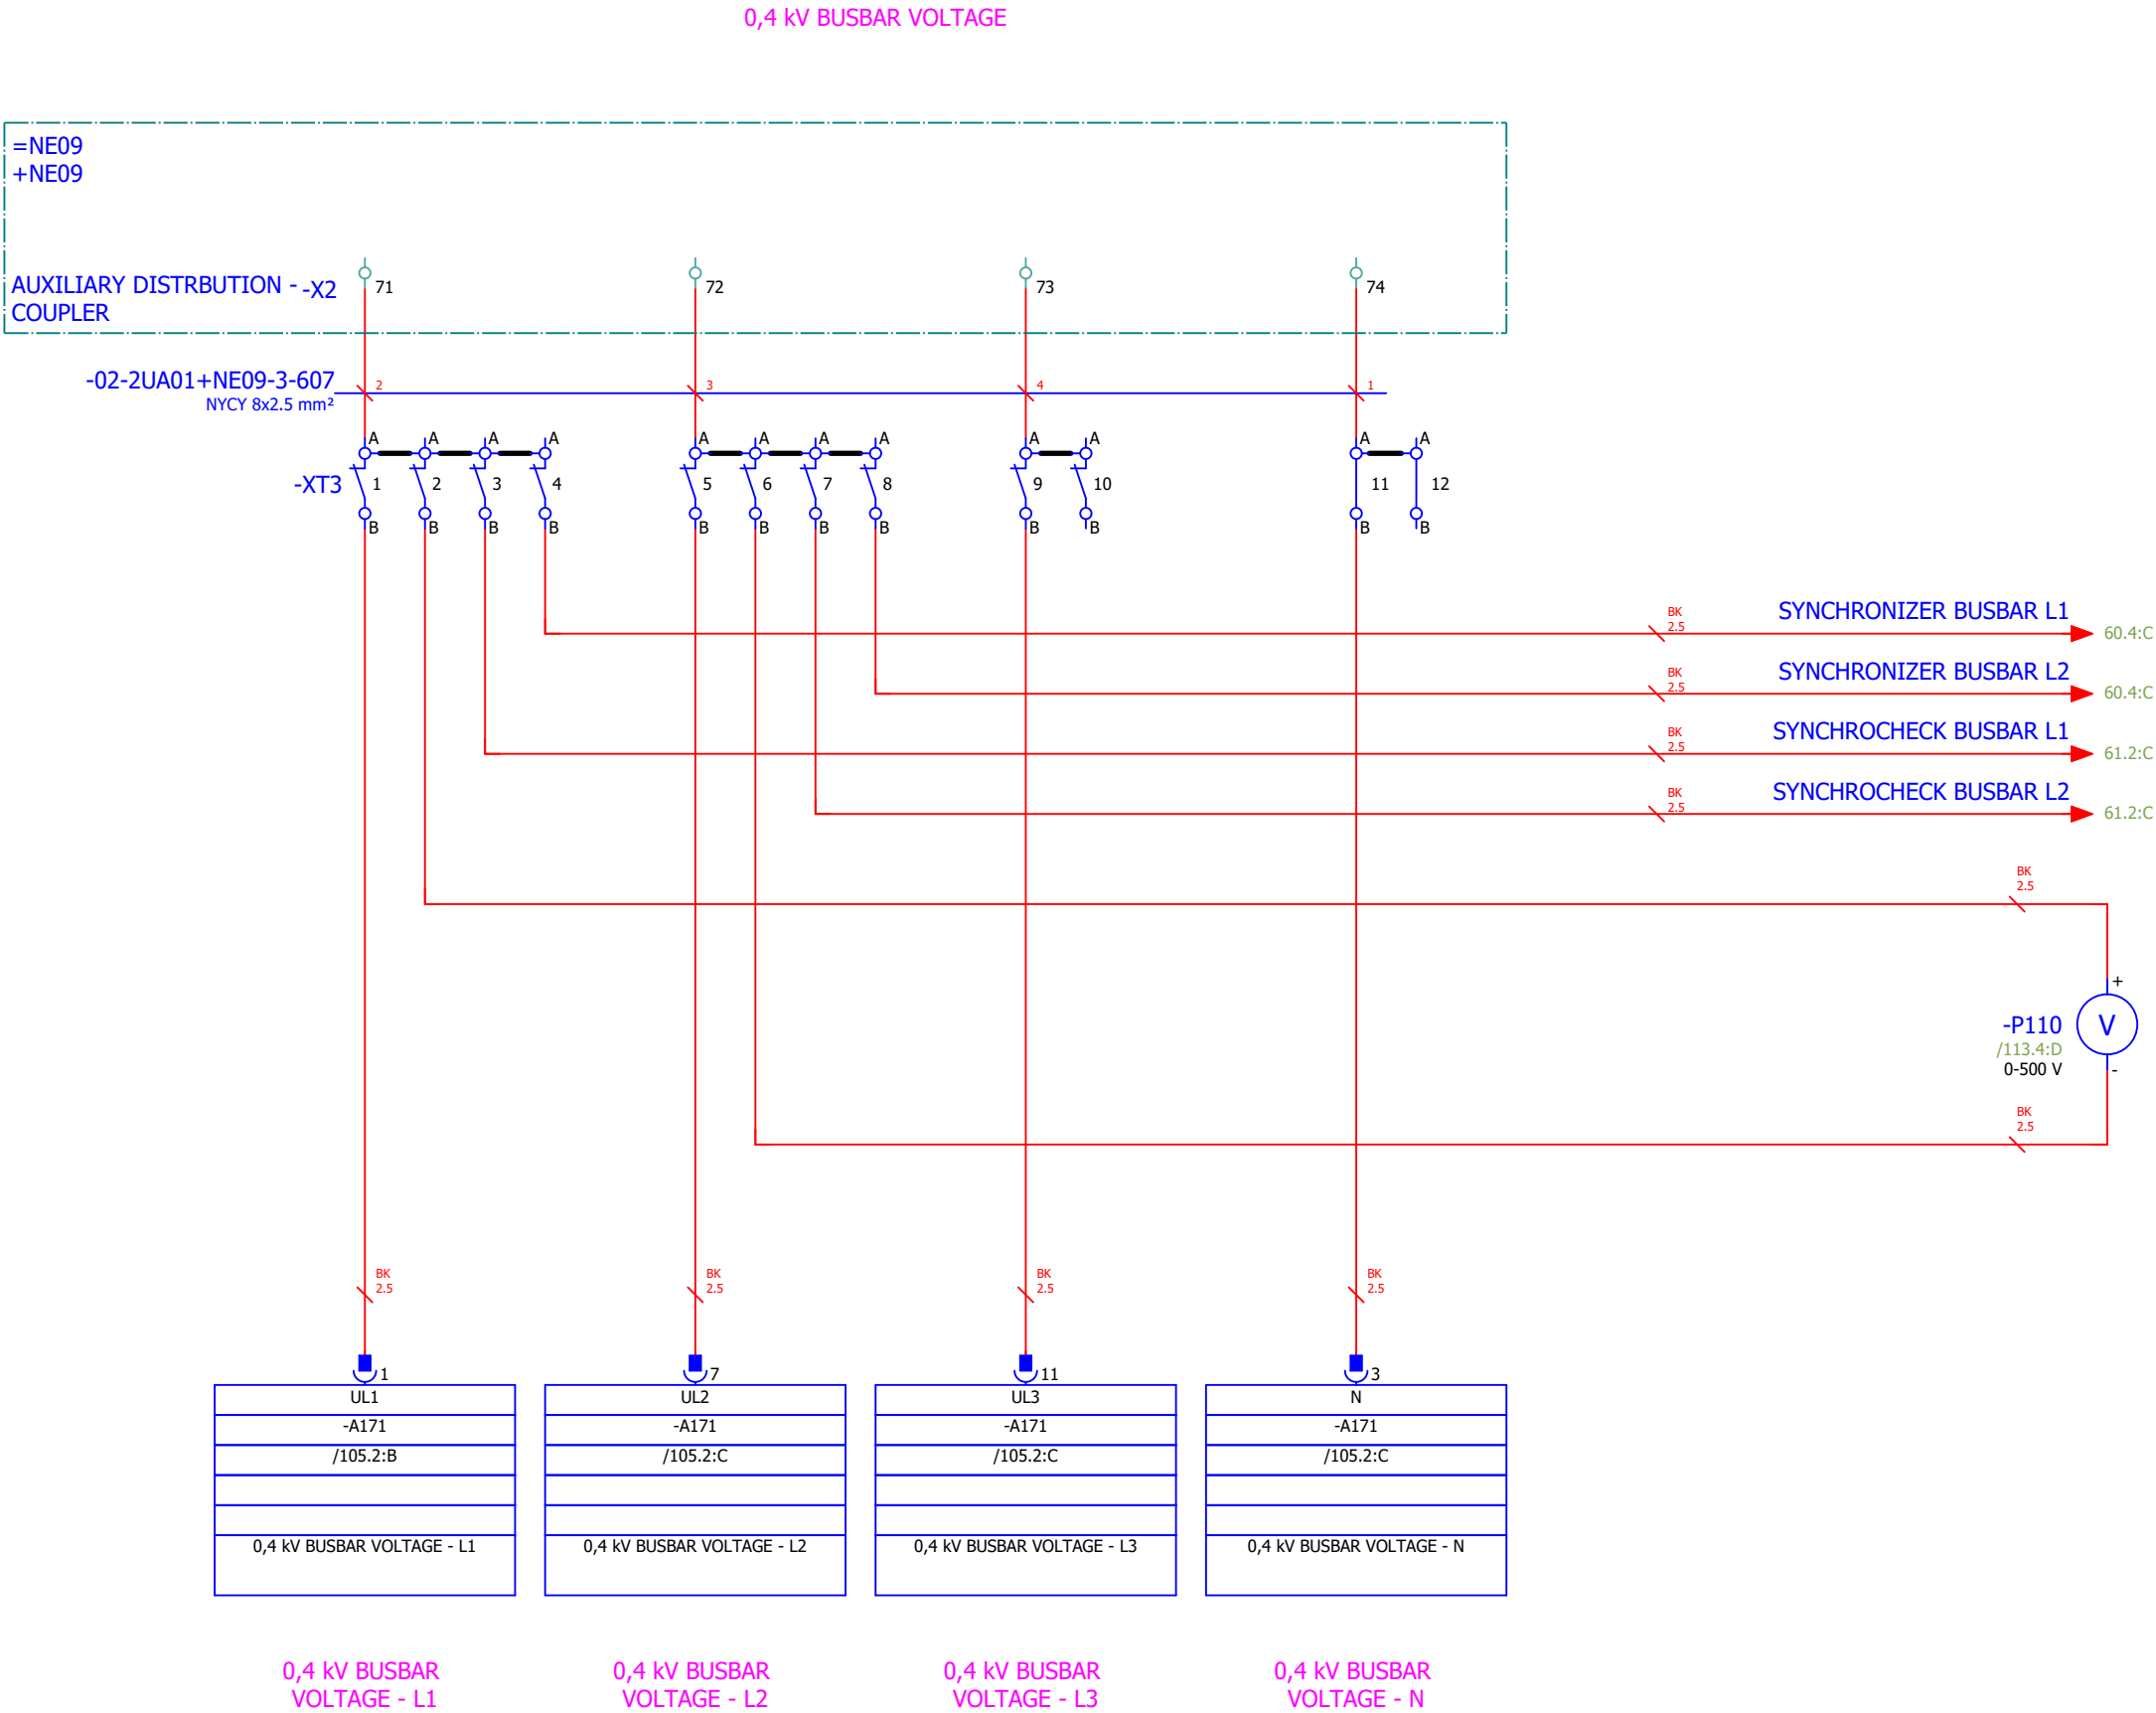


Approved by Contractor			Reconstruction and Modernisation of HPP Perucica - Phase II		 A Voith Company Sintaksa - A Voith Company Ulica Domovinskog rata 104C, 21 000 Split, Hrvatska	Unit KA2 control cubicle circuit diagrams VT CIRCUITS	DRAWING No.: PERU-01-19-170-31-002	REV No.: 02	= UBCJA10GH100 + UBCJA10
Approved by Designer	Grga Kolić	01.10.2026.					Designer No.:	SALES No.:	PAGE 76
Checked by	Antonio Aleksić	01.10.2026.							
Drawn by	Tamara Trogrlić	01.10.2026.							PAGE 76 / 157

CONFIDENTIAL, ALL RIGHTS RESERVED DIN 34

Format ISO/DIN A3

76


78

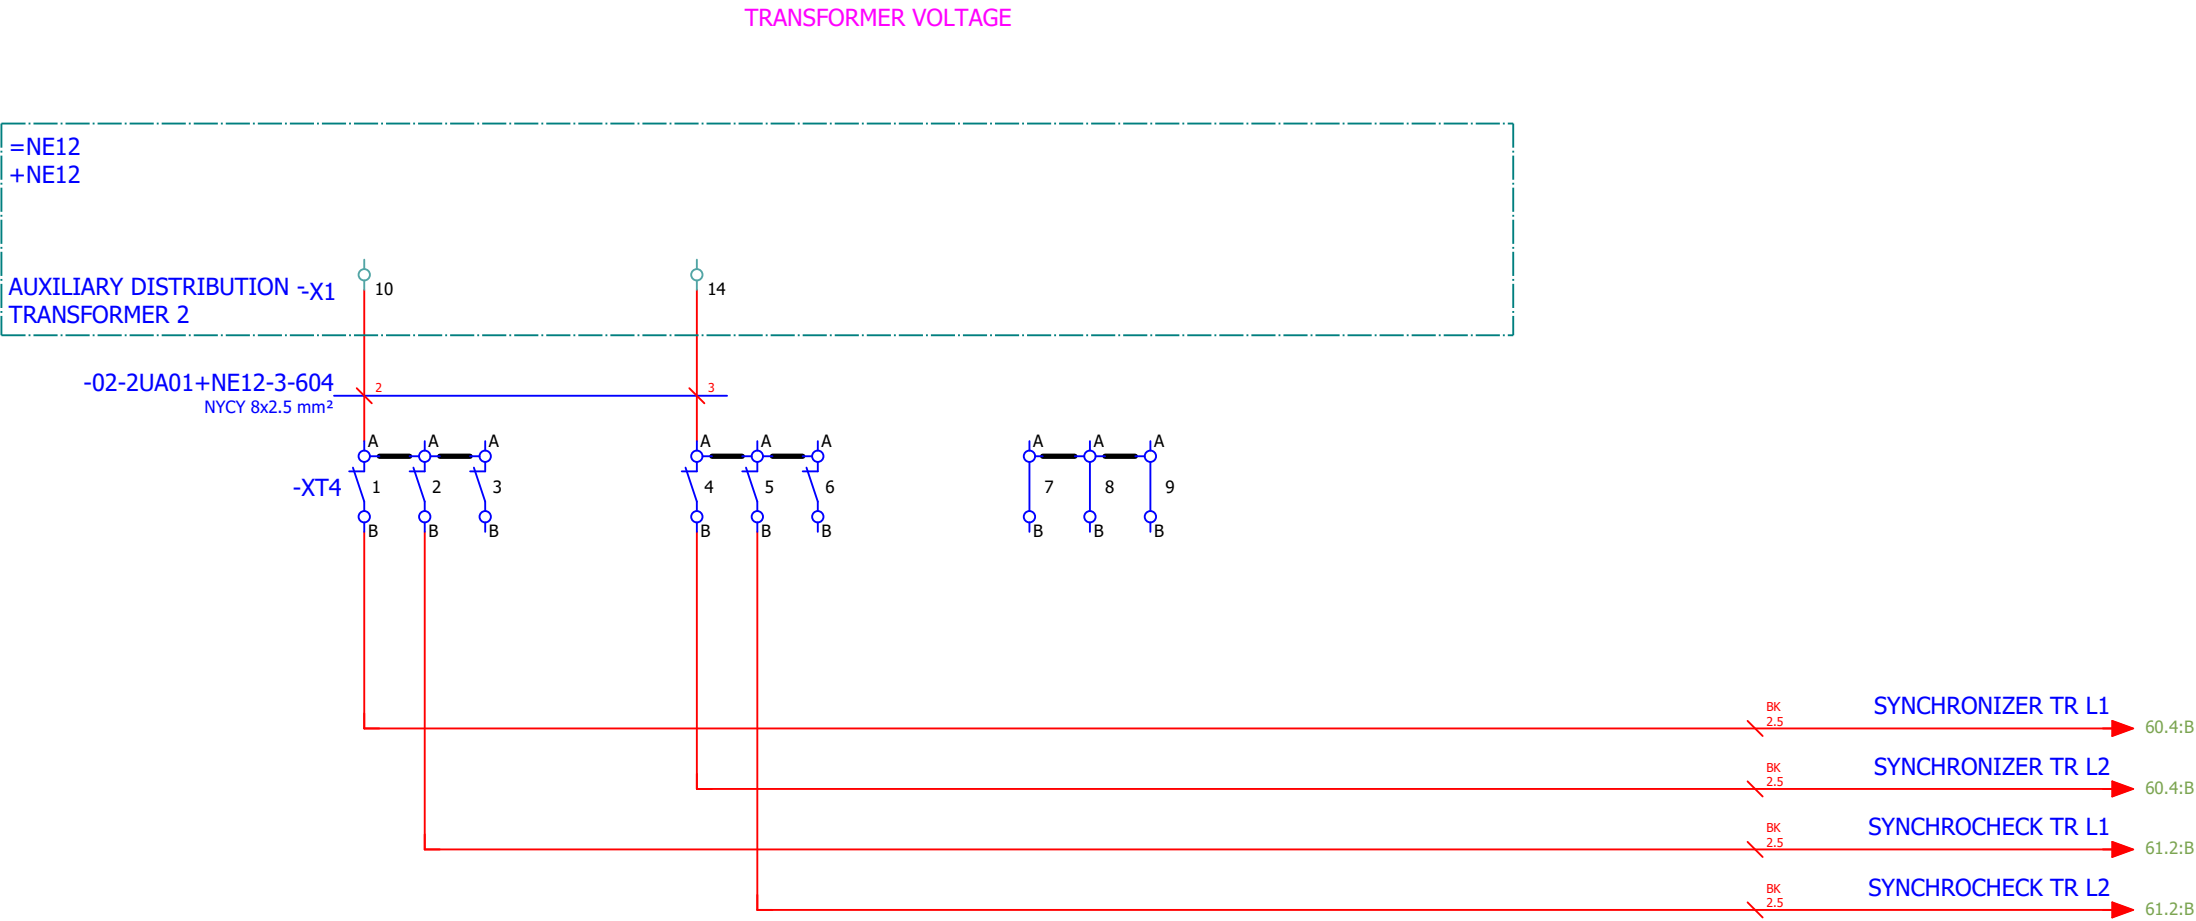

Approved by Contractor			Reconstruction and Modernisation of HPP Perucica - Phase II		 A Voith Company Sintaksa - A Voith Company Ulica Domovinskog rata 104C, 21 000 Split, Hrvatska	Unit KA2 control cubicle circuit diagrams VT CIRCUITS	DRAWING No.: PERU-01-19-170-31-002	REV No.: 02	= UBCJA10GH100 + UBCJA10
Approved by Designer	Grga Kolić	01.10.2026.					Designer No.:	SALES No.:	PAGE 77
Checked by	Antonio Aleksić	01.10.2026.	PROJECT NAME	EMPLOYER	DESIGNER				PAGE 77 / 157
Drawn by	Tamara Trogrlić	01.10.2026.							

CONFIDENTIAL, ALL RIGHTS RESERVED DIN 34

Format ISO/DIN A3

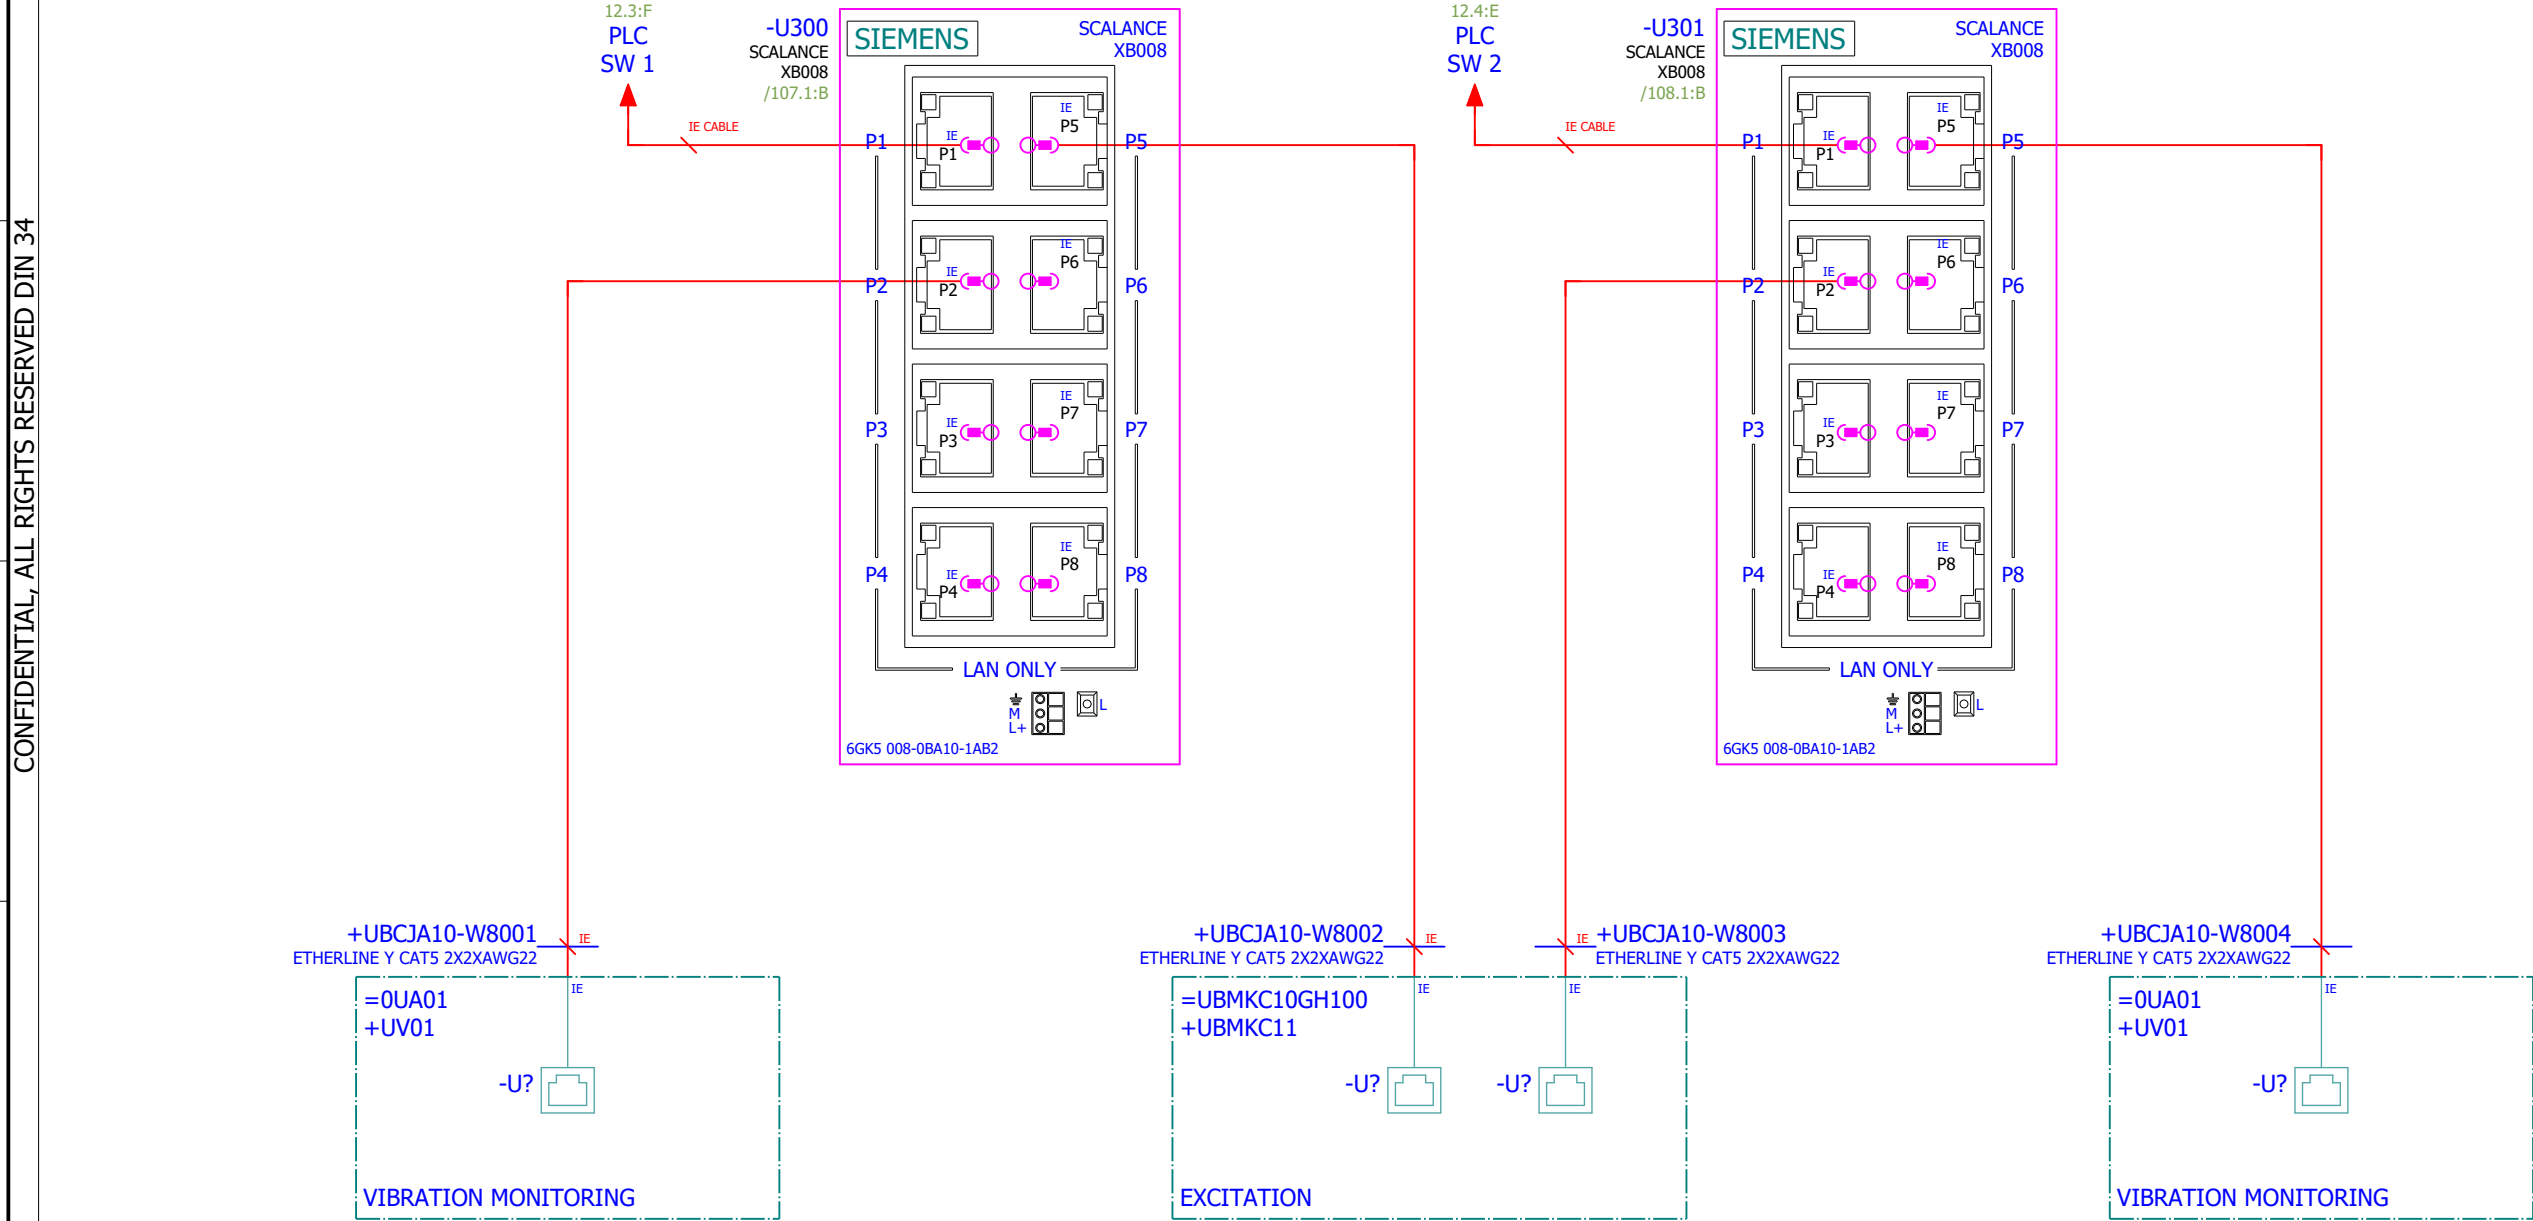


Approved by Contractor			Reconstruction and Modernisation of HPP Perucica - Phase II			Unit KA2 control cubicle circuit diagrams	DRAWING No.: PERU-01-19-170-31-002	REV No.: 02	= UBCJA10GH100
Approved by Designer	Grga Kolić	01.10.2026.			Sintaksa - A Voith Company	SWITCH	Designer No.:	SALES No.:	+ UBCJA10
Checked by	Antonio Aleksić	01.10.2026.			Ulica Domovinskog rata 104C, 21 000 Split, Hrvatska				PAGE 78
Drawn by	Tamara Trogrlić	01.10.2026.	PROJECT NAME	EMPLOYER	DESIGNER				PAGE 78 / 157

CONFIDENTIAL, ALL RIGHTS RESERVED DIN 34

Format ISO/DIN A3

78

Approved by Contractor			Reconstruction and Modernisation of HPP Perucica - Phase II		 A Voith Company Sintaksa - A Voith Company Ulica Domovinskog rata 104C, 21 000 Split, Hrvatska	Unit KA2 control cubicle circuit diagrams COMMUNICATION	DRAWING No.: PERU-01-19-170-31-002	REV No.: 02	= UBCJA10GH100 + UBCJA10
Approved by Designer	Grga Kolić	01.10.2026.					Designer No.:	SALES No.:	PAGE 79
Checked by	Antonio Aleksić	01.10.2026.							
Drawn by	Tamara Trogrlić	01.10.2026.							PAGE 79 / 157

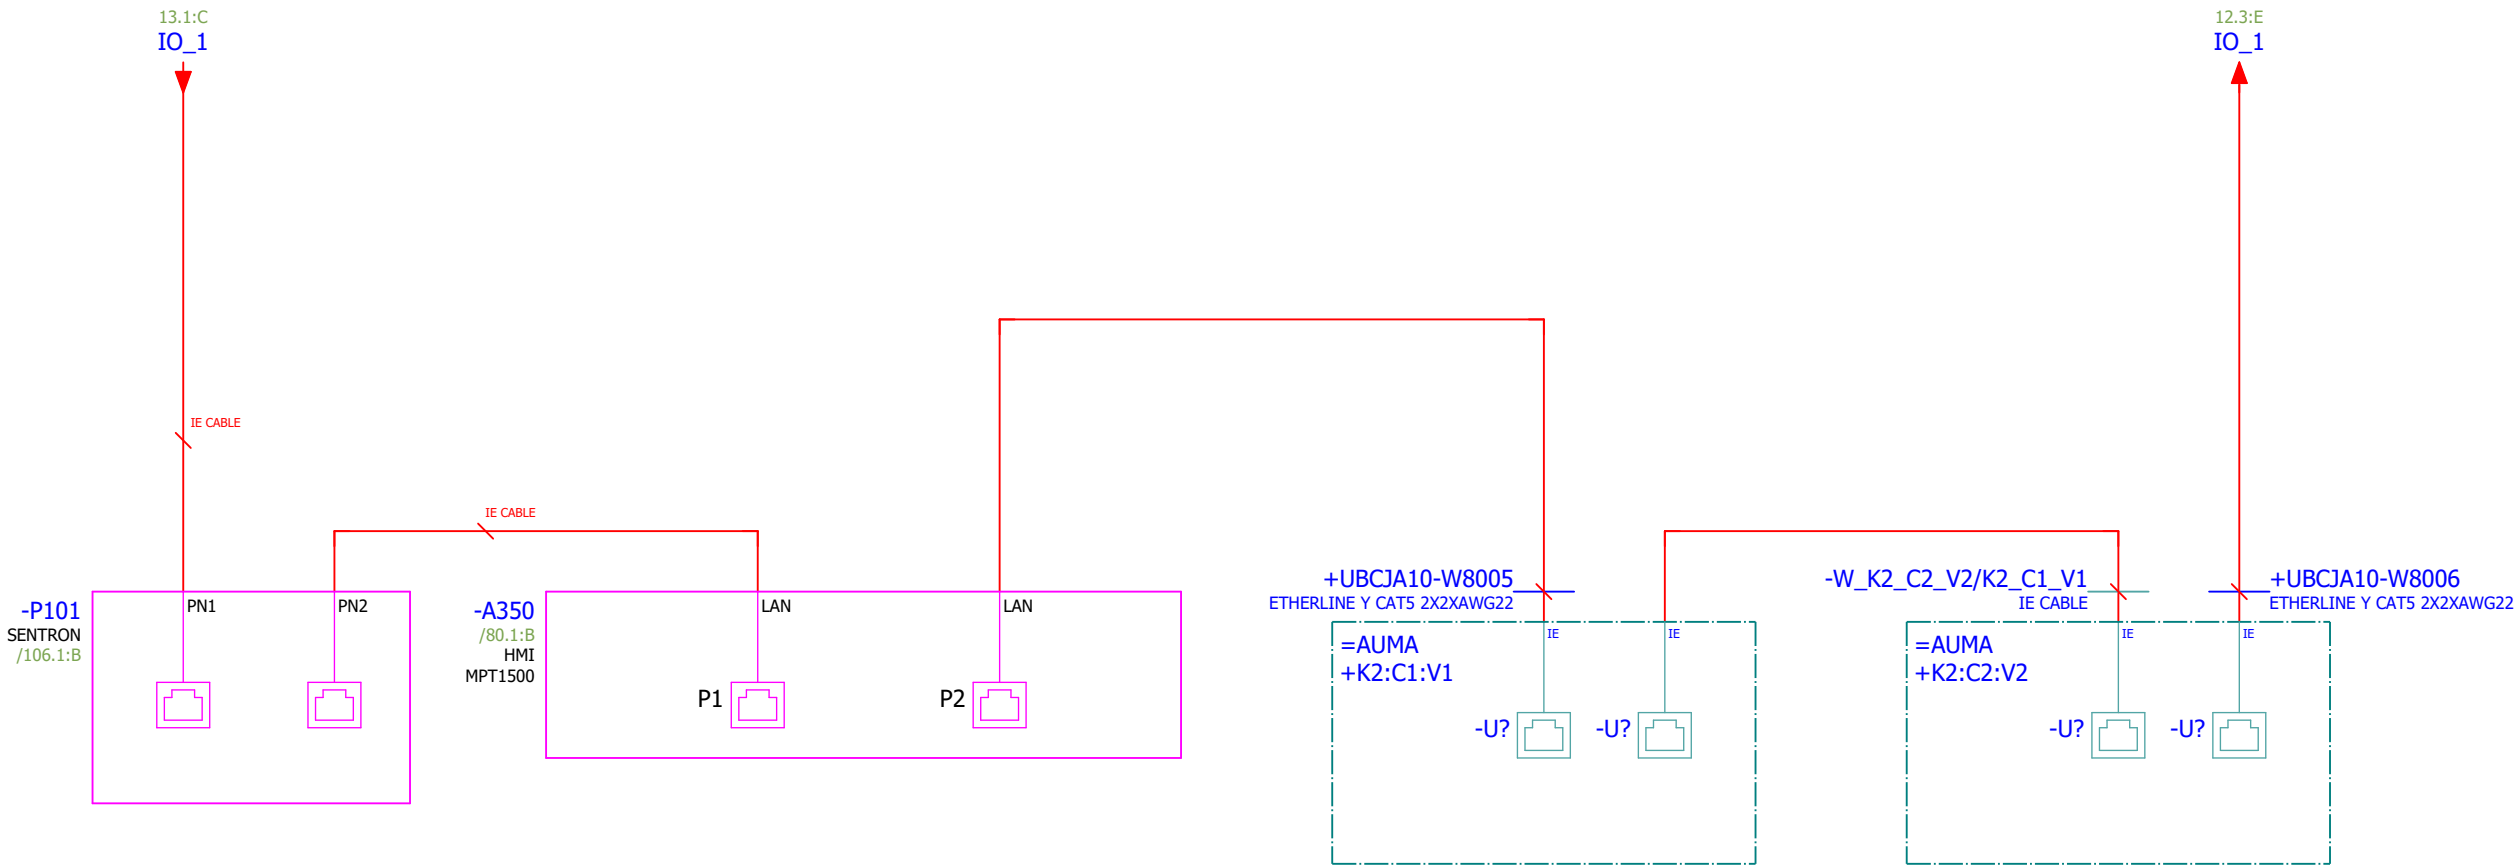

80

Approved by Contractor			Reconstruction and Modernisation of HPP Perucica - Phase II		 A Voith Company Sintaksa - A Voith Company Ulica Domovinskog rata 104C, 21 000 Split, Hrvatska	Unit KA2 control cubicle circuit diagrams	DRAWING No.:	REV No.:	= UBCJA10GH100
Approved by Designer	Grga Kolić	01.10.2026.					PERU-01-19-170-31-002	02	+ UBCJA10
Checked by	Antonio Aleksić	01.10.2026.					Designer No.:	SALES No.:	PAGE 80
Drawn by	Tamara Trogrlić	01.10.2026.	PROJECT NAME	EMPLOYER	DESIGNER	HMI - TOUCH PANEL			PAGE 80 / 157



Approved by Contractor			Reconstruction and Modernisation of HPP Perucica - Phase II		 A Voith Company	Unit KA2 control cubicle circuit diagrams	DRAWING No.:	REV No.:	= UBCJA10GH100			
Approved by Designer	Grga Kolić	01.10.2026.			Sintaksa - A Voith Company Ulica Domovinskog rata 104C, 21 000 Split, Hrvatska		PERU-01-19-170-31-002	02	+ UBCJA10			
Checked by	Antonio Aleksić	01.10.2026.			PROJECT NAME		EMPLOYER	DESIGNER	PLC OVERVIEW	Designer No.:	SALES No.:	PAGE 81
Drawn by	Tamara Trogrlić	01.10.2026.								PAGE 81 / 157		



F

B

1	2	3	4	5	6	7	8
---	---	---	---	---	---	---	---

BF

Approved by Contractor			Reconstruction and Modernisation of HPP Perucica - Phase II		 A Voith Company	Unit KA2 control cubicle circuit diagrams	DRAWING No.:	REV No.:	= UBCJA10GH100			
Approved by Designer	Grga Kolić	01.10.2026.			Sintaksa - A Voith Company Ulica Domovinskog rata 104C, 21 000 Split, Hrvatska		PERU-01-19-170-31-002	02	+ UBCJA10			
Checked by	Antonio Aleksić	01.10.2026.			PROJECT NAME		EMPLOYER	DESIGNER	PLC OVERVIEW DI	Designer No.:	SALES No.:	PAGE 95
Drawn by	Tamara Trogrlić	01.10.2026.								PAGE 95 / 157		



1

2

3

4

5

6

7

8

Qty.
(pcs)

Equipment technical description

Manufacturer

Location
(= / +)

Designation
(-)

Symbol
Position in schematics (Page, column)

1

Digital input module ET 200SP


DI 16X24V DC Standard
type 3 (IEC 61131); sink input; fits to BU-type A0
input delay time 0,05..20ms; Diagnostics: wire break,
supply voltage
6ES7131-6BH01-0BA0
BaseUnit BU15-P16+A0+2B
6ES7193-6BP00-0BA0

Siemens

+UBCJA10

-A120

-A120
/13.8:B

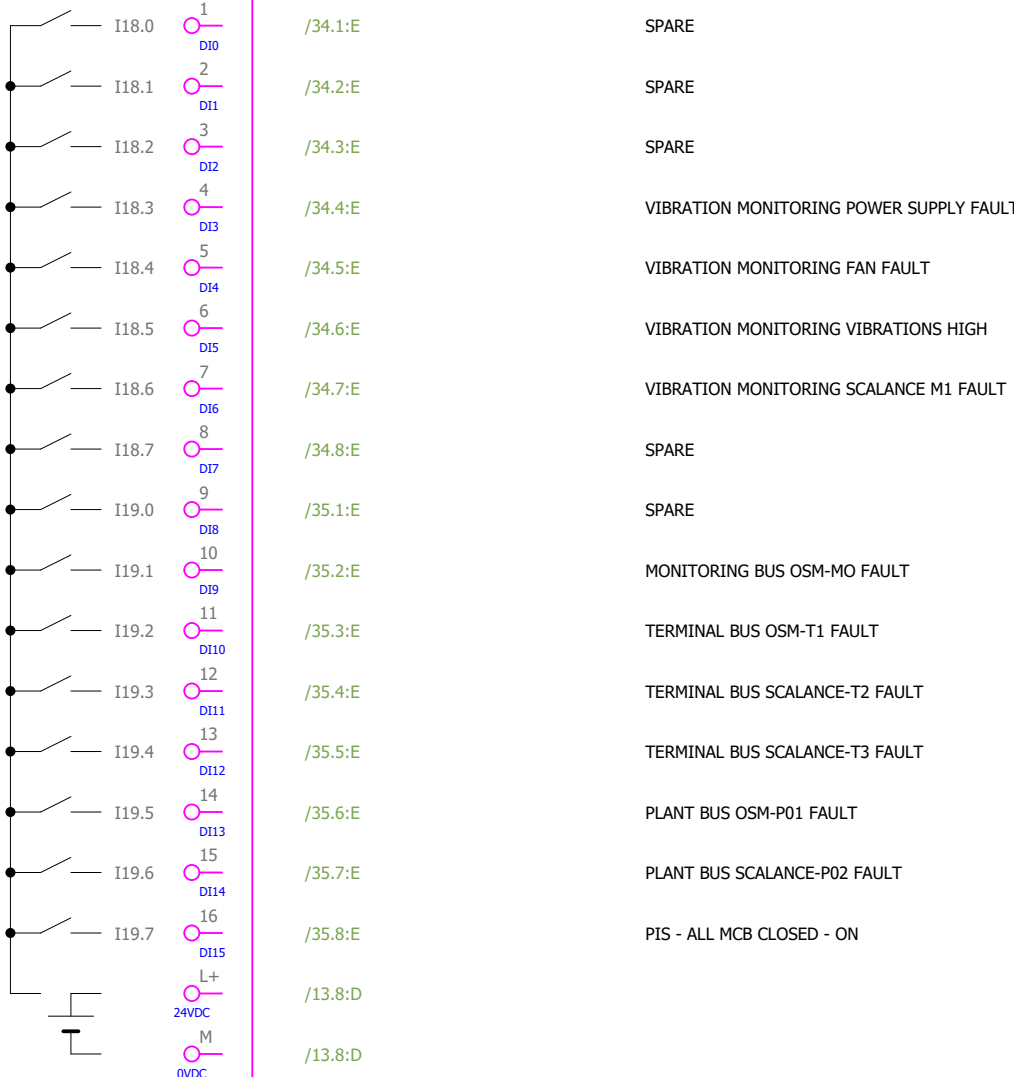

1

2

3

4

5

6

7

8

Approved by Contractor

Approved by Designer

Checked by

Drawn by

Grga Kolić

Antonio Aleksić

Tamara Trogrlić

01.10.2026.

01.10.2026.

01.10.2026.

Reconstruction and Modernisation
of HPP Perucica - Phase II

PROJECT NAME



EMPLOYER


A Voith Company

Sintaksa - A Voith Company
Ulica Domovinskog rata 104C, 21 000 Split, Hrvatska

DESIGNER

Unit KA2 control cubicle circuit diagrams

PLC OVERVIEW DI

DRAWING No.:
PERU-01-19-170-31-002

Designer No.:

REV No.:
02

SALES No.:

= UBCJA10GH100
+ UBCJA10

PAGE
96 / 157

1

2

3

4

5

6

7

8

1



1		2		3		4		5		6		7		8	
Qty. (pcs)	Equipment technical description			Manufacturer		Location (= / +)		Designation (-)		Symbol Position in schematics (Page, column)					
1	Digital output module ET200SP			Siemens		+UBCJA10		-A133							
	DQ 16x 24V DC/0,5A fits to BU-type A0; Source output (PNP/P-switching); substitute value output, Module diagnostics: short-circuit to L+ and ground, wire break, supply 6ES7132-6BH01-0BA0 BaseUnit BU15-P16+A0+2B 6ES7193-6BP00-0BA0														
-A133 /14.2:B SIEMENS															

98

100

CONFIDENTIAL, ALL RIGHTS RESERVED DIN 34

Format ISO/DIN A3

Approved by Contractor			Reconstruction and Modernisation of HPP Perucica - Phase II		 A Voith Company Sintaksa - A Voith Company Ulica Domovinskog rata 104C, 21 000 Split, Hrvatska	Unit KA2 control cubicle circuit diagrams	DRAWING No.:	REV No.:	= UBCJA10GH100
Approved by Designer	Grga Kolić	01.10.2026.					PERU-01-19-170-31-002	02	+ UBCJA10
Checked by	Antonio Aleksić	01.10.2026.					Designer No.:	SALES No.:	PAGE 99
Drawn by	Tamara Trogrlić	01.10.2026.	PROJECT NAME	EMPLOYER	DESIGNER	PLC OVERVIEW DQ			PAGE 99 / 157


CONFIDENTIAL, ALL RIGHTS RESERVED DIN 34

B

LE

1	2	3	4	5	6	7	8
---	---	---	---	---	---	---	---

Qty. (pcs)	Equipment technical description	Manufacturer	Location (= / +)	Designation (-)	Symbol Position in schematics (Page, column)
1	Analog input module SIMATIC ET 200SP AI 4XI 2-/4-WIRE Standard fits to BU-TYPE A0, A1 Module diagnosis, 16 bit, +/-0,3% 6ES7134-6GD01-0BA1 BaseUnit BU15-P16+A0+2D 6ES7193-6BP00-0DA0	Siemens	+UBCJA10	-A141	

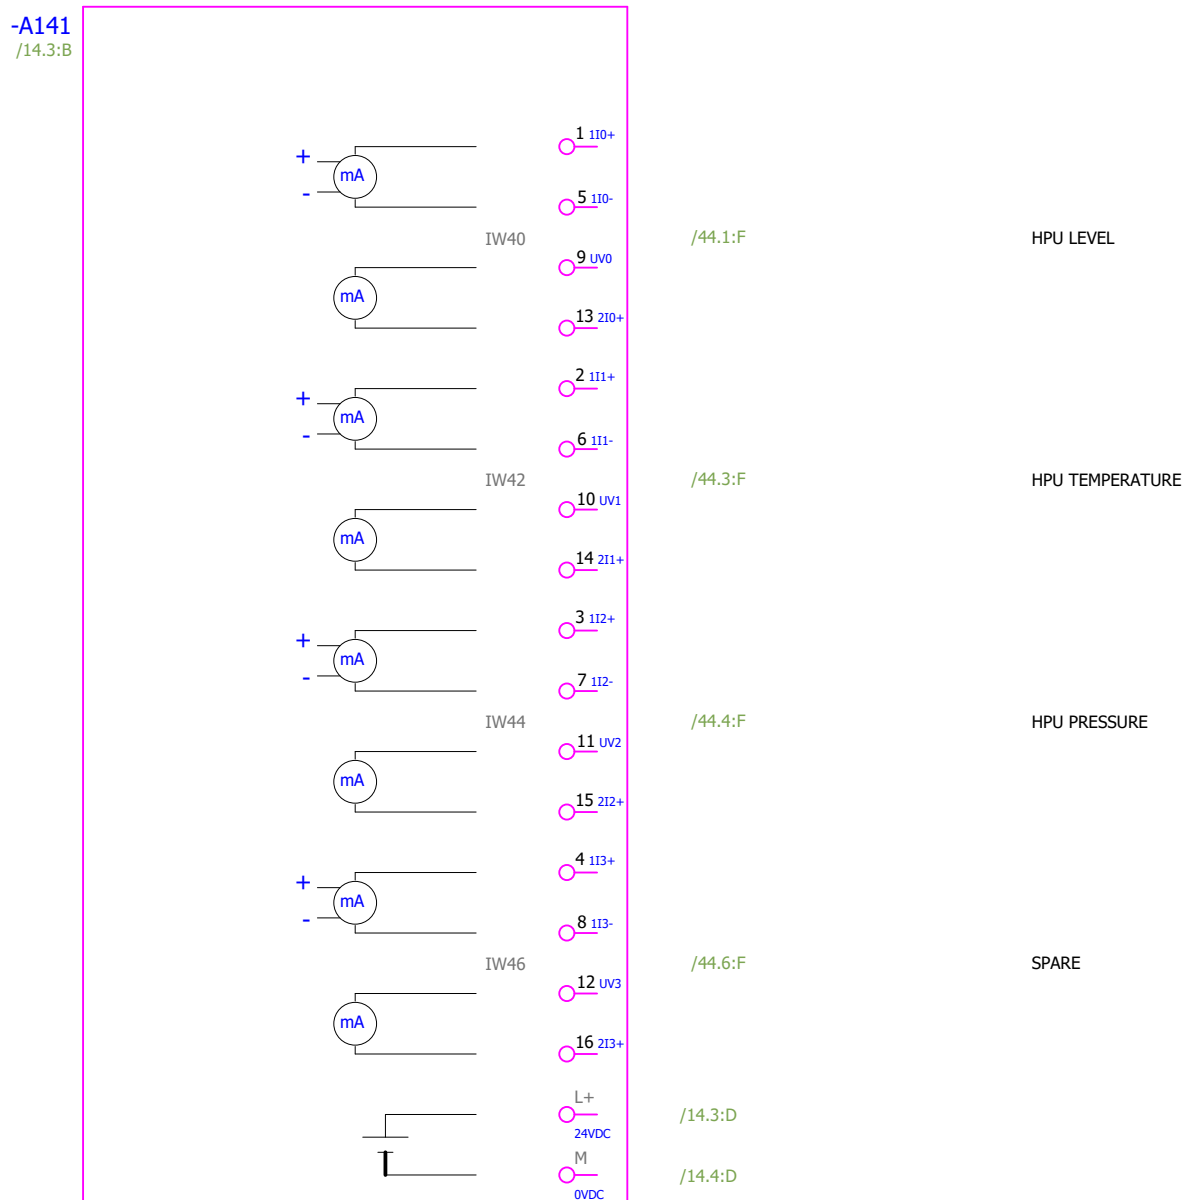

SIEMENS

[illegible]

B

D

F

E


1	2	3	4	5	6	7	8
---	---	---	---	---	---	---	---

1		2		3		4		5		6		7		8	
Qty. (pcs)		Equipment technical description		Manufacturer		Location (= / +)		Designation (-)		Symbol Position in schematics (Page, column)					
1		SIMATIC ET 200SP AI Energy Meter CT ST SIMATIC ET 200SP, analog input module, AI Energy Meter CT ST, for 1A or 5A current transformer, suitable for BU type U0, channel diagnostics 6ES7134-6PA01-0BU0 SIMATIC ET 200SP BU type U0 BU20-P16+A0+2D PU 1 6ES7193-6BP00-0DU0		Siemens		+UBCJA10		-A171							

CONFIDENTIAL, ALL RIGHTS RESERVED DIN 34

Format ISO/DIN A3

-A171
/14.5:B

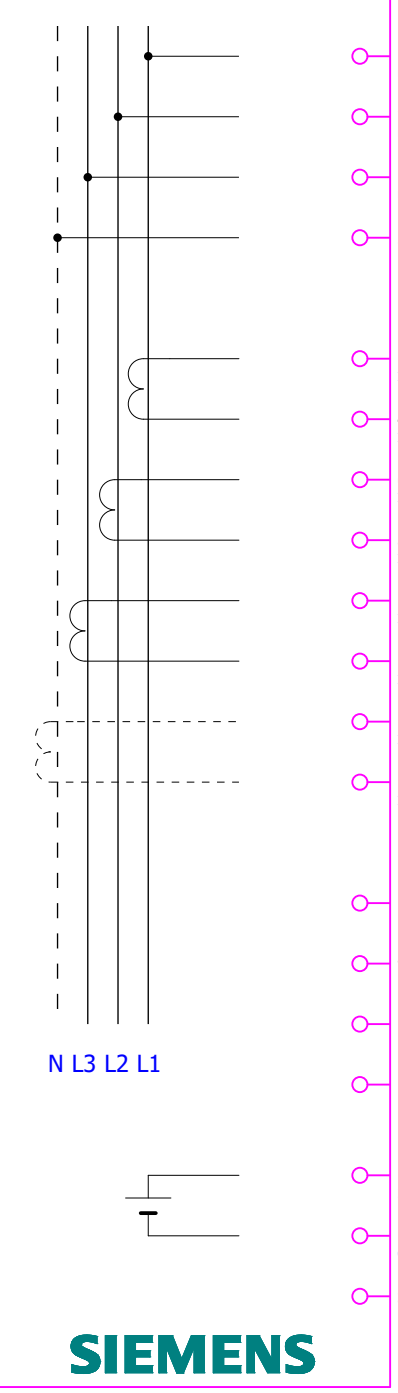

- 1 UL1 /76.2:E 0,4 kV BUSBAR VOLTAGE - L1
- 7 UL2 /76.3:E 0,4 kV BUSBAR VOLTAGE - L2
- 11 UL3 /76.4:E 0,4 kV BUSBAR VOLTAGE - L3
- 3 N /76.4:E 0,4 kV BUSBAR VOLTAGE - N
- 2 IL1+
- 4 IL1-
- 6 IL2+
- 8 IL2-
- 10 IL3+
- 12 IL3-
- 14 IN+
- 13 IN-
- 5 RES
- 9 RES
- 15 RES
- 16 RES
- P1 /14.5:D 24VDC
- P2 /14.6:D 0VDC
- SH

Approved by Contractor			Reconstruction and Modernisation of HPP Perucica - Phase II		 A Voith Company Sintaksa - A Voith Company Ulica Domovinskog rata 104C, 21 000 Split, Hrvatska	Unit KA2 control cubicle circuit diagrams PLC OVERVIEW AI ENERGY METER	DRAWING No.:	REV No.:	= UBCJA10GH100
Approved by Designer	Grga Kolić	01.10.2026.					PERU-01-19-170-31-002	02	+ UBCJA10
Checked by	Antonio Aleksić	01.10.2026.					Designer No.:	SALES No.:	PAGE 105
Drawn by	Tamara Trogrlić	01.10.2026.							PAGE 105 / 157

1	2	3	4	5	6	7	8
---	---	---	---	---	---	---	---

Format ISO/DIN A3

107

109

CONFIDENTIAL, ALL RIGHTS RESERVED DIN 34

Format ISO/DIN A3

1	2	3	4	5	6	7	8										
Qty. (pcs)	Equipment technical description	Manufacturer	Location (= / +)	Designation (-)	Symbol Position in schematics (Page, column)												
1	Ethernet switch 24 V DC 8x 10/100 Mbit/s twisted pair ports with RJ45 sockets LED diagnostics Type: Scalance XB008 Order No.: 6GK5008-0BA10-1AB2 6GK5008-0BA10-1AB2	Siemens	+UBCJA10	-U301													
-U301 /9.2:E /78.5:B P1 /78.5:B P2 /78.5:C P3 /78.5:C P4 /78.5:D P5 /78.5:B P6 /78.5:C P7 /78.5:C P8 /78.5:D 1/GND 1 GND /9.3:E 2/M 2 M /9.3:E 3 24V /9.2:E																	
Approved by Contractor			01.10.2026.		Reconstruction and Modernisation of HPP Perucica - Phase II		SINTAKSA A Voith Company Sintaksa - A Voith Company Ulica Domovinskog rata 104C, 21 000 Split, Hrvatska	Unit KA2 control cubicle circuit diagrams		DRAWING No.:		REV No.:		= UBCJA10GH100			
Approved by Designer		Grga Kolić	01.10.2026.					SWITCH 2		PERU-01-19-170-31-002		02		+ UBCJA10			
Checked by		Antonio Aleksić	01.10.2026.							Designer No.:		SALES No.:		PAGE		108	
Drawn by		Tamara Trogrlić	01.10.2026.		PROJECT NAME			EMPLOYER		DESIGNER				PAGE		108 / 157	
1	2	3	4	5	6	7	8										

110 |




Format ISO/DIN A3

EES
BSM-P 59B1611PR000

CONFIDENTIAL, ALL RIGHTS RESERVED DIN 34





1		2		3		4		5		6		7		8		
Qty. (pcs)	Equipment technical description	Manufacturer	Location (+)	Designation (-)	Symbol Position in schematics (Page, column)											
1	Contact module with 1 contact element, 1 NO Contact module with 1 contact element, 1 NO, screw terminal, for front plate mounting Order No.: 3SU1400-1AA10-1BA0 ILLUMINATED PUSHBUTTON, RED Type: 3SU1051-0AB20-0AA0 Illuminated pushbutton, 22 mm, round, metal, shiny, red, pushbutton, flat, momentary contact type HOLDER Type: 3SU1550-0AA10-0AA0 Holder for 3 modules, universal, plastic/metal LED MODULE, RED Type: 3SU1401-1BB20-1AA0 LED MODULE WITH INTEGRATED LED 24V AC/DC, RED, SCREW TERMINAL, FOR FRONT PLATE MOUNTING SIRIUS ACT Label holder Type: 3SU1900-0AP10-0AA0 Label holder, 22mm, frame rectangular at the bottom, black, for labeling plate 17.5 mm x 27 mm, for gluing	Siemens														
		+UBCJA10	-S112	/17.8:D	/42.4:D											
2	Heater Rated power: 100W Input voltage: 110-250V Order No.: HT100	Alfa Electric														
		+UBCJA10	-R101	/5.5:F												
		+UBCJA10	-R102	/5.6:F												
2	LED system light Slim enclosure LED lamp, 9 W, 100 to 230V, 50H, 538×23×36 mm Order No.: LL49W-100-230V	ALFA ELECTRIC														
		+UBCJA10	-E101	/5.3:F												
		+UBCJA10	-E102	/5.4:F												
110112																
Approved by Contractor			Reconstruction and Modernisation of HPP Perucica - Phase II						Unit KA2 control cubicle circuit diagrams		DRAWING No.: PERU-01-19-170-31-002		REV No.: 02		= UBCJA10GH100	
Approved by Designer		Grga Kolić	01.10.2026.					A Voith Company		Device tag List		PERU-01-19-170-31-002		+ UBCJA10		
Checked by		Antonio Aleksić	01.10.2026.					Sintaksa - A Voith Company				Designer No.:		SALES No.:		
Drawn by		Tamara Trogrlić	01.10.2026.	PROJECT NAME		EMPLOYER		DESIGNER						PAGE 111		
														PAGE 111 / 157		
1		2		3		4		5		6		7		8		

Format ISO/DIN A3

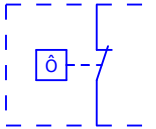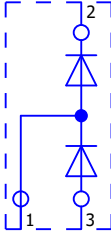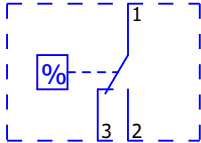1		2		3		4		5		6		7		8					
A																A			
	Qty. (pcs)	Equipment technical description	Manufacturer	Location (+)	Designation (-)	Symbol Position in schematics (Page, column)													
	1	Thermostat NO contact 0...+60°C Type: THV02 Order No.: THV02	Alfa Electric																
				+UBCJA10	-B103	/5.6:C													
B																B			
	1	Diode Circuit configuration: Two diodes doubler circuit, two diodes common cathode, two diodes common anode, single diode Vf - Forward Voltage: 1.35 V Vr - Reverse Voltage: 800 V Type: DD100KB80 Order No.: 197-DD100KB80	SanRex																
				+UBCJA10	-V1	/6.1:B													
+UBCJA10				-V2	/6.2:B														
C																C			
	2	Electronic hygrostat Hygrostat, Rated Voltage 120-240 V AC, Rated Current 10-5A 10-90 %RF Type: IGR35F Order No.: IGR35F																	
+UBCJA10						-B102	/5.5:E												
D																D			
	1																		
E																	E		
	1																		
F																	F		
Format ISO/DIN A3																			
111113																			
Approved by Contractor				01.10.2026.		Reconstruction and Modernisation of HPP Perucica - Phase II				 A Voith Company		Unit KA2 control cubicle circuit diagrams		DRAWING No.: PERU-01-19-170-31-002		REV No.: 02		= UBCJA10GH100	
Approved by Designer		Grga Kolić		01.10.2026.						Sintaksa - A Voith Company Ulica Domovinskog rata 104C, 21 000 Split, Hrvatska		Device tag List		Designer No.:		SALES No.:		+ UBCJA10	
Checked by		Antonio Aleksić		01.10.2026.												PAGE		112	
Drawn by		Tamara Trogrlić		01.10.2026.		PROJECT NAME		EMPLOYER		DESIGNER						PAGE		112 / 157	
1		2		3		4		5		6		7		8					

CONFIDENTIAL, ALL RIGHTS RESERVED DIN 34


Format ISO/DIN A3

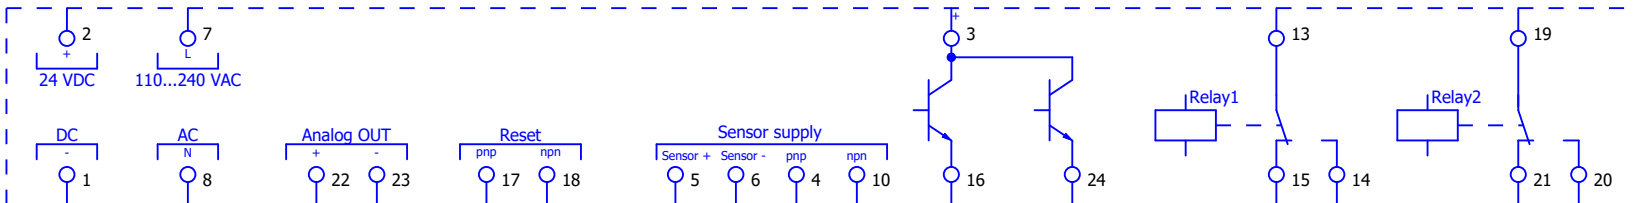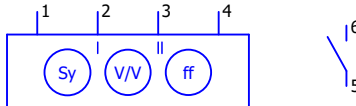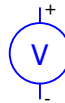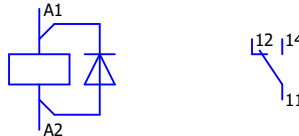
1		2		3		4		5		6		7		8	
Qty. (pcs)	Equipment technical description			Manufacturer	Location (+)	Designation (-)	Symbol Position in schematics (Page, column)								
1	Speed monitoring relay MONITOR/FR-1 /110-240VAC/DC Nominal voltage: 110...240VAC (50...60Hz)/27Hz (tip. 24VDC) 2 relay outputs, 2 transistor outputs Analog output: 0/4...20mA Impuls inputs: pnp/npn, NAMUR (24V) Input frequency (max): 5kHz Setting range: 1...60000 imp/min (0.1...1000Hz) Type: DD2503 Order No.: DD2503			ifm electronic											
					+UBCJA10	-B111	/9.5:E			/48.7:F					
1	Synchronisation meters for manual or semiautomatic synchronisation Scale: 360° Power supply from bus bar or generator Displayed value equal to voltage input Order No.: SQ0214-L-400V-R3-N-N-S-A-0			ISKRA											
					+UBCJA10	-P411	/61.4:E			/64.2:C					
1	Analog panel meter Scale: 0-500 V, 48x48mm Direct measurement Order No.: EA16N E61500000A8			LUMEL											
					+UBCJA10	-P110	/76.6:D								
1	Analog panel meter Scale: 0-200% Input signal: 4-20mA Order No.: MA19LN A900X000008			LUMEL											
					+UBCJA10	-P1	/46.5:C								
1	Auxiliary relay PLC-INTERFACE, consisting of PLC-BSC.../21 basic terminal block with screw connection and plug-in miniature relay with power contact, 1 C/O, input voltage 24 V DC for mounting on DIN rail NS 35/7.5 Order No.: 2966171			Phoenix Contact											
					+UBCJA10	-1K12	/20.4:D			/20.4:E					
					+UBCJA10	-1K13	/20.5:D			/20.5:E					
					+UBCJA10	-1K14	/20.6:D			/20.6:E					

112

114

Approved by Contractor			Reconstruction and Modernisation of HPP Perucica - Phase II		 A Voith Company Sintaksa - A Voith Company Ulica Domovinskog rata 104C, 21 000 Split, Hrvatska	Unit KA2 control cubicle circuit diagrams	DRAWING No.:	REV No.:	= UBCJA10GH100
Approved by Designer	Grga Kolić	01.10.2026.					PERU-01-19-170-31-002	02	+ UBCJA10
Checked by	Antonio Aleksić	01.10.2026.					Designer No.:	SALES No.:	PAGE 113
Drawn by	Tamara Trogrlić	01.10.2026.	PROJECT NAME	EMPLOYER	DESIGNER	Device tag List			PAGE 113 / 157

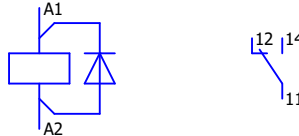1		2		3		4		5		6		7		8	
Qty. (pcs)	Equipment technical description	Manufacturer	Location (+)	Designation (-)	Symbol Position in schematics (Page, column)										
113	Auxiliary relay	Phoenix Contact													
	PLC-INTERFACE, consisting of PLC-BSC.../21 basic terminal block with screw connection and plug-in miniature relay with power contact, 1 C/O, input voltage 24 V DC for mounting on DIN rail NS 35/7.5 Order No.: 2966171		+UBCJA10	-1K15	/20.7:D	/20.7:E									
			+UBCJA10	-1K16	/20.8:D	/20.8:E									
			+UBCJA10	-1K21	/21.1:D	/21.1:E									
			+UBCJA10	-1K22	/21.2:D	/21.2:E									
			+UBCJA10	-1K23	/21.3:D	/21.3:E									
			+UBCJA10	-1K24	/21.4:D	/21.4:E									
			+UBCJA10	-1K32	/22.2:D	/22.2:E									
			+UBCJA10	-1K33	/22.3:D	/22.3:E									
			+UBCJA10	-1K34	/22.4:D	/22.4:E									
			+UBCJA10	-1K35	/22.5:D	/22.5:E									
			+UBCJA10	-1K36	/22.6:D	/22.6:E									
			+UBCJA10	-1K37	/22.7:D	/22.7:E									
			+UBCJA10	-1K38	/22.8:D	/22.8:E									
			+UBCJA10	-1K41	/23.1:D	/23.1:E									
			+UBCJA10	-1K42	/23.2:D	/23.2:E									
			+UBCJA10	-1K43	/23.3:D	/23.3:E									
			+UBCJA10	-1K44	/23.4:D	/23.4:E									
			+UBCJA10	-1K47	/23.7:D	/23.7:E									
			+UBCJA10	-1K48	/23.8:D	/23.8:E									
			+UBCJA10	-1K51	/24.1:D	/24.1:E									
			+UBCJA10	-1K52	/24.2:D	/24.2:E									
			+UBCJA10	-1K53	/24.3:D	/24.3:E									
			+UBCJA10	-1K55	/24.5:D	/24.5:E									
			+UBCJA10	-1K56	/24.6:D	/24.6:E									
			+UBCJA10	-1K57	/24.7:D	/24.7:E									
			+UBCJA10	-1K75	/26.5:D	/26.5:E									
			+UBCJA10	-1K77	/26.7:D	/26.7:E									
			+UBCJA10	-1K78	/26.8:D	/26.8:E									
			+UBCJA10	-1K81	/27.1:D	/27.1:E									
			+UBCJA10	-1K82	/27.2:D	/27.2:E									
			+UBCJA10	-1K83	/27.3:D	/27.3:E									
			+UBCJA10	-1K84	/27.4:D	/27.4:E									
		Approved by Contractor			Reconstruction and Modernisation of HPP Perucica - Phase II			 A Voith Company	Unit KA2 control cubicle circuit diagrams	DRAWING No.:	REV No.:	= UBCJA10GH100			
Approved by Designer		Grga Kolić	01.10.2026.	PERU-01-19-170-31-002						02	+ UBCJA10				
Checked by		Antonio Aleksić	01.10.2026.	Designer No.:						SALES No.:	PAGE	114			
Drawn by		Tamara Trogrlić	01.10.2026.	PROJECT NAME	EMPLOYER	DESIGNER	Device tag List			PAGE	114 / 157				

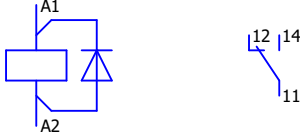
1		2		3		4		5		6		7		8																	
A																A															
	Qty. (pcs)	Equipment technical description	Manufacturer	Location (+)	Designation (-)	Symbol Position in schematics (Page, column)																									
		Auxiliary relay PLC-INTERFACE, consisting of PLC-BSC.../21 basic terminal block with screw connection and plug-in miniature relay with power contact, 1 C/O, input voltage 24 V DC for mounting on DIN rail NS 35/7.5 Order No.: 2966171	Phoenix Contact																												
B				+UBCJA10	-1K85	/27.5:D		/27.5:E								B															
				+UBCJA10	-1K86	/27.6:D		/27.6:E																							
				+UBCJA10	-1K87	/27.7:D		/27.7:E																							
				+UBCJA10	-1K88	/27.8:D		/27.8:E																							
				+UBCJA10	-1K91	/28.1:D		/28.1:E																							
C				+UBCJA10	-1K92	/28.2:D		/28.2:E								C															
				+UBCJA10	-1K93	/28.3:D		/28.3:E																							
				+UBCJA10	-1K94	/28.4:D		/28.4:E																							
				+UBCJA10	-1K95	/28.5:D		/28.5:E																							
				+UBCJA10	-1K101	/29.1:D		/29.1:E																							
				+UBCJA10	-1K102	/29.2:D		/29.2:E																							
				+UBCJA10	-1K103	/29.3:D		/29.3:E																							
				+UBCJA10	-1K104	/29.4:D		/29.4:E																							
				+UBCJA10	-1K105	/29.5:D		/29.5:E																							
				+UBCJA10	-1K106	/29.6:D		/29.6:E																							
D				+UBCJA10	-1K107	/29.7:D		/29.7:E								D															
				+UBCJA10	-1K108	/29.8:D		/29.8:E																							
				+UBCJA10	-1K111	/30.1:D		/30.1:E																							
				+UBCJA10	-1K112	/30.2:D		/30.2:E																							
				+UBCJA10	-1K113	/30.3:D		/30.3:E																							
E				+UBCJA10	-1K114	/30.4:D		/30.4:E								E															
				+UBCJA10	-1K115	/30.5:D		/30.5:E																							
				+UBCJA10	-1K116	/30.6:D		/30.6:E																							
				+UBCJA10	-1K117	/30.7:D		/30.7:E																							
				+UBCJA10	-1K118	/30.8:D		/30.8:E																							
				+UBCJA10	-1K121	/31.1:D		/31.1:E																							
				+UBCJA10	-1K122	/31.2:D		/31.2:E																							
				+UBCJA10	-1K123	/31.3:D		/31.3:E																							
				+UBCJA10	-1K124	/31.4:D		/31.4:E																							
				+UBCJA10	-1K125	/31.5:D		/31.5:E																							
F				+UBCJA10	-1K126	/31.6:D		/31.6:E								F															
				+UBCJA10	-1K127	/31.7:D		/31.7:E																							
114																116															
Approved by Contractor				01.10.2026.		Reconstruction and Modernisation of HPP Perucica - Phase II				 A Voith Company Sintaksa - A Voith Company Ulica Domovinskog rata 104C, 21 000 Split, Hrvatska		Unit KA2 control cubicle circuit diagrams Device tag List		DRAWING No.:		REV No.:		= UBCJA10GH100													
Approved by Designer		Grga Kolić		01.10.2026.										PERU-01-19-170-31-002		02		+ UBCJA10													
Checked by		Antonio Aleksić		01.10.2026.										Designer No.:		SALES No.:		PAGE		115											
Drawn by		Tamara Trogrlić		01.10.2026.		PROJECT NAME		EMPLOYER		DESIGNER						PAGE		115 / 157													
1		2		3		4		5		6		7		8																	

115

117


CONFIDENTIAL, ALL RIGHTS RESERVED DIN 34

Format ISO/DIN A3

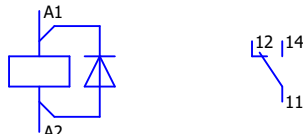Qty. (pcs)	Equipment technical description	Manufacturer	Location (+)	Designation (-)	Symbol Position in schematics (Page, column)	
	Auxiliary relay PLC-INTERFACE, consisting of PLC-BSC.../21 basic terminal block with screw connection and plug-in miniature relay with power contact, 1 C/O, input voltage 24 V DC for mounting on DIN rail NS 35/7.5 Order No.: 2966171	Phoenix Contact				
			+UBCJA10	-1K128	/31.8:D	/31.8:E
			+UBCJA10	-1K131	/32.1:D	/32.1:E
			+UBCJA10	-1K132	/32.2:D	/32.2:E
			+UBCJA10	-1K133	/32.3:D	/32.3:E
			+UBCJA10	-1K134	/32.4:D	/32.4:E
			+UBCJA10	-1K135	/32.5:D	/32.5:E
			+UBCJA10	-1K136	/32.6:D	/32.6:E
			+UBCJA10	-1K137	/32.7:D	/32.7:E
			+UBCJA10	-1K138	/32.8:D	/32.8:E
			+UBCJA10	-1K141	/33.1:D	/33.1:E
			+UBCJA10	-1K142	/33.2:D	/33.2:E
			+UBCJA10	-1K143	/33.3:D	/33.3:E
			+UBCJA10	-1K144	/33.4:D	/33.4:E
			+UBCJA10	-1K145	/33.5:D	/33.5:E
			+UBCJA10	-1K146	/33.6:D	/33.6:E
			+UBCJA10	-1K147	/33.7:D	/33.7:E
			+UBCJA10	-1K148	/33.8:D	/33.8:E
			+UBCJA10	-1K151	/34.1:D	/34.1:E
			+UBCJA10	-1K152	/34.2:D	/34.2:E
			+UBCJA10	-1K153	/34.3:D	/34.3:E
			+UBCJA10	-1K157	/34.7:D	/34.7:E
			+UBCJA10	-1K158	/34.8:D	/34.8:E
			+UBCJA10	-1K161	/35.1:D	/35.1:E
			+UBCJA10	-1K162	/35.2:D	/35.2:E
			+UBCJA10	-1K163	/35.3:D	/35.3:E
			+UBCJA10	-1K164	/35.4:D	/35.4:E
			+UBCJA10	-1K165	/35.5:D	/35.5:E
			+UBCJA10	-1K166	/35.6:D	/35.6:E
			+UBCJA10	-1K167	/35.7:D	/35.7:E
			+UBCJA10	-1K168	/35.8:D	/35.8:E
			+UBCJA10	-2K01	/36.1:D	/56.2:C
			+UBCJA10	-2K02	/36.2:D	/56.2:C



Approved by Contractor			Reconstruction and Modernisation of HPP Perucica - Phase II		 Sintaksa - A Voith Company Ulica Domovinskog rata 104C, 21 000 Split, Hrvatska	Unit KA2 control cubicle circuit diagrams	DRAWING No.:	REV No.:	= UBCJA10GH100		
Approved by Designer		Grga Kolić					01.10.2026.	PERU-01-19-170-31-002	02	+ UBCJA10	
Checked by		Antonio Aleksić	01.10.2026.	PROJECT NAME	EMPLOYER	DESIGNER	Device tag List	Designer No.:	SALES No.:	PAGE	116
Drawn by		Tamara Trogrlić	01.10.2026.						PAGE	116 / 157	

CONFIDENTIAL, ALL RIGHTS RESERVED DIN 34


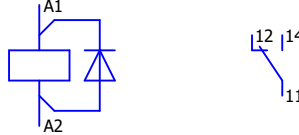
1	2	3	4	5	6	7	8
Qty. (pcs)	Equipment technical description	Manufacturer	Location (+)	Designation (-)	Symbol Position in schematics (Page, column)		
127	Auxiliary relay	Phoenix Contact					
	PLC-INTERFACE, consisting of PLC-BSC.../21 basic terminal block with screw connection and plug-in miniature relay with power contact, 1 C/O, input voltage 24 V DC for mounting on DIN rail NS 35/7.5 Order No.: 2966171		+UBCJA10	-2K03	/36.3:D	/57.2:A	
			+UBCJA10	-2K04	/36.4:D	/58.4:B	
			+UBCJA10	-2K05	/36.5:D	/49.2:B	
			+UBCJA10	-2K06	/36.6:D	/49.3:B	
			+UBCJA10	-2K07	/36.7:D	/49.4:B	
			+UBCJA10	-2K08	/37.6:D	/52.7:B	
			+UBCJA10	-2K09	/37.7:D	/52.8:B	
			+UBCJA10	-2K10	/38.2:D	/49.6:B	
			+UBCJA10	-2K11	/38.5:D	/59.7:B	
			+UBCJA10	-2K12	/38.6:D	/62.2:B	
			+UBCJA10	-2K13	/39.1:D	/64.5:B	
			+UBCJA10	-2K14	/39.2:D	/64.6:B	
			+UBCJA10	-2K15	/39.4:D	/65.2:B	
			+UBCJA10	-2K16	/39.5:D	/65.3:B	
			+UBCJA10	-2K17	/39.6:D	/65.4:B	
			+UBCJA10	-2K18	/39.7:D	/65.5:B	
			+UBCJA10	-2K19	/39.8:D	/67.2:B	
			+UBCJA10	-2K20	/40.1:D	/67.3:B	
			+UBCJA10	-2K21	/40.2:D	/67.4:B	
			+UBCJA10	-2K22	/40.3:D	/67.5:B	
			+UBCJA10	-2K23	/40.5:D	/68.6:C	
			+UBCJA10	-2K24	/40.6:D		
			+UBCJA10	-2K25	/40.7:D		
			+UBCJA10	-2K26	/40.8:D		
			+UBCJA10	-2K27	/41.1:D		
			+UBCJA10	-2K28	/41.2:D		
			+UBCJA10	-2K29	/41.3:D		
			+UBCJA10	-2K30	/41.4:D		

116										118									
Approved by Contractor				Reconstruction and Modernisation			 A Voith Company	Unit KA2 control cubicle circuit diagrams		DRAWING No.:		REV No.:		= UBCJA10GH100					
Approved by Designer		Grga Kolić	01.10.2026.	of HPP Perucica - Phase II				Device tag List		PERU-01-19-170-31-002		02		+ UBCJA10					
Checked by		Antonio Aleksić	01.10.2026.			Sintaksa - A Voith Company Ulica Domovinskog rata 104C, 21 000 Split, Hrvatska				Designer No.:		SALES No.:		PAGE 117					
Drawn by		Tamara Trogrlić	01.10.2026.	PROJECT NAME		EMPLOYER		DESIGNER						PAGE 117 / 157					
1		2		3		4		5		6		7		8					

Format ISO/DIN A3

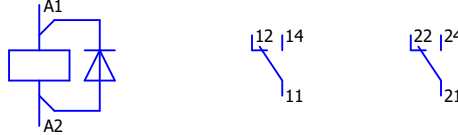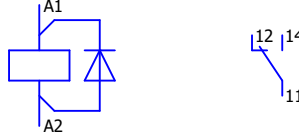1		2		3		4		5		6		7		8					
CONFIDENTIAL, ALL RIGHTS RESERVED DIN 34																			
Qty. (pcs)		Equipment technical description		Manufacturer		Location (+)		Designation (-)		Symbol Position in schematics (Page, column)									
16		Interface relay 24VDC, 2CO Auxiliary relay Nominal coil voltage: 24VDC 2 CO Order No.: 2967060		Phoenix Contact															
						+UBCJA10		-1K11		/20.3:D		/20.3:E		/71.2:C					
						+UBCJA10		-1K25		/21.5:D		/21.5:E		/71.2:C					
						+UBCJA10		-1K26		/21.6:D		/21.6:E		/71.3:C					
						+UBCJA10		-1K27		/21.7:D		/21.7:E		/71.4:C					
						+UBCJA10		-1K28		/21.8:D		/21.8:E		/71.5:C					
						+UBCJA10		-1K31		/22.1:D		/22.1:E		/71.6:C					
						+UBCJA10		-1K45		/23.5:D		/23.5:E		/71.6:C					
						+UBCJA10		-1K46		/23.6:D		/23.6:E		/71.7:C					
						+UBCJA10		-1K54		/24.4:D		/24.4:E		/71.8:C					
						+UBCJA10		-1K76		/26.6:D		/26.6:E							
						+UBCJA10		-1K96		/28.6:D		/28.6:E							
						+UBCJA10		-1K97		/28.7:D		/28.7:E							
						+UBCJA10		-1K98		/28.8:D		/28.8:E		/69.5:C					
						+UBCJA10		-1K154		/34.4:D		/34.4:E		/71.2:D					
						+UBCJA10		-1K155		/34.5:D		/34.5:E		/71.2:D					
						+UBCJA10		-1K156		/34.6:D		/34.6:E		/71.3:D					
9		Auxiliary relay Input voltage 230 V AC/220 V DC Order No.: 2966207		Phoenix Contact															
						+UBCJA10		-1K62		/25.2:D		/25.2:E							
						+UBCJA10		-1K63		/25.3:D		/25.3:E							
						+UBCJA10		-1K66		/25.6:D		/25.6:E							
						+UBCJA10		-1K67		/25.7:D		/25.7:E							
						+UBCJA10		-1K68		/25.8:D		/25.8:E							
						+UBCJA10		-1K71		/26.1:D		/26.1:E							
						+UBCJA10		-1K72		/26.2:D		/26.2:E							
						+UBCJA10		-1K73		/26.3:D		/26.3:E							
						+UBCJA10		-1K74		/26.4:D		/26.4:E							
Format ISO/DIN A3																			
117																			
Approved by Contractor				Reconstruction and Modernisation of HPP Perucica - Phase II				 A Voith Company		Unit KA2 control cubicle circuit diagrams		DRAWING No.:		REV No.:		= UBCJA10GH100			
Approved by Designer		Grga Kolić										01.10.2026.		PERU-01-19-170-31-002		02		+ UBCJA10	
Checked by		Antonio Aleksić		01.10.2026.		PROJECT NAME		EMPLOYER		DESIGNER		Designer No.:		SALES No.:		PAGE		118	
Drawn by		Tamara Trogrlić		01.10.2026.								PAGE		118 / 157					
1		2		3		4		5		6		7		8					

		1	2	3	4	5	6	7	8
A	B	C	D	E	F				
A	B	C	D	E	F				
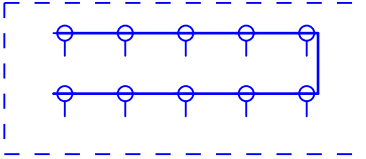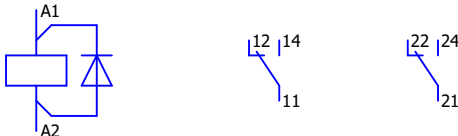1		2		3		4		5		6		7		8		
A																A
	Qty. (pcs)	Equipment technical description	Manufacturer	Location (+)	Designation (-)	Symbol Position in schematics (Page, column)										
	3	Distribution block Linergy DS - screw distribution block 1P - 125A - 10 holes Type: Linergy DS Order No.: LGY112510	Schneider Electric													
						+UBCJA10	-U50	/6.1:A								
+UBCJA10						-U51	/6.1:B									
B																B
C																C
	3	Interface plug-in relay - Zelio RXG Nominal coil voltage: 24VDC Nominal contact current: 5A 2 CO, with LED, lockable test button Base: RGZE1S48M Protection diode: RXM040W Order No.: RXG22BD Protection module Harmony 6...230V DC Type: SE.RZM040W Harmony, Protection module, diode, for RSZ, 6...230 V DC Socket Type: RGZE1S48M Socket with clamp, 5 A, For RXG2 relays 2 C/O, screw connectors	Schneider Electric													
						+UBCJA10	-2K201	/39.3:D	/63.2:B	/63.6:B						
						+UBCJA10	-2K202	/41.5:D								
D																D
E																E
F																F

119

121

Approved by Contractor			Reconstruction and Modernisation of HPP Perucica - Phase II		 A Voith Company Sintaksa - A Voith Company Ulica Domovinskog rata 104C, 21 000 Split, Hrvatska	Unit KA2 control cubicle circuit diagrams	DRAWING No.:	REV No.:	= UBCJA10GH100
Approved by Designer	Grga Kolić	01.10.2026.					PERU-01-19-170-31-002	02	+ UBCJA10
Checked by	Antonio Aleksić	01.10.2026.					Designer No.:	SALES No.:	PAGE 120
Drawn by	Tamara Trogrlić	01.10.2026.					PROJECT NAME	EMPLOYER	DESIGNER

1

2

3

4

5



6

7

8

Approved by Contractor			Reconstruction and Modernisation of HPP Perucica - Phase II		 A Voith Company	Unit KA2 control cubicle circuit diagrams	DRAWING No.:	REV No.:	= UBCJA10GH100
Approved by Designer	Grga Kolić	01.10.2026.			Sintaksa - A Voith Company Ulica Domovinskog rata 104C, 21 000 Split, Hrvatska		PERU-01-19-170-31-002	02	+ UBCJA10
Checked by	Antonio Aleksić	01.10.2026.			Device tag List		Designer No.:	SALES No.:	PAGE 122
Drawn by	Tamara Troglić	01.10.2026.					PROJECT NAME	EMPLOYER	DESIGNER

CONFIDENTIAL, ALL RIGHTS RESERVED DIN 34

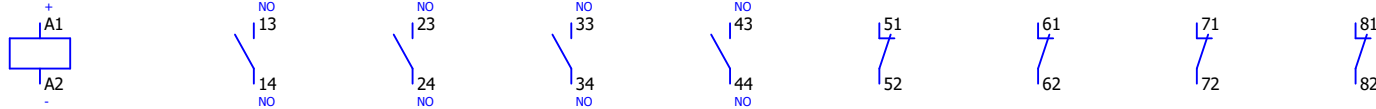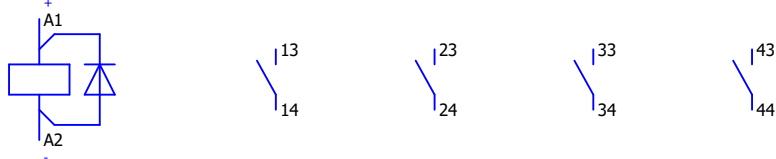1	2	3	4	5	6	7	8
Qty. (pcs)	Equipment technical description	Manufacturer	Location (+)	Designation (-)	Symbol Position in schematics (Page, column)		
2	SIRIUS contactor relay Contactor relay, 4NO, 24VDC, with integrated diode, size S00, screw terminal Order No.: 3RH2140-1FB40 AUXILIARY SWITCH BLOCK, 4NC Type: 3RH2911-1GA04 Auxiliary switch block 4NC, only with contactor relays 3RH2140 and 3RH2440 combinable, screw terminal DIN EN 50011	Siemens					
			+UBCJA10	-K303	/57.4:E /51.4:B /51.4:C /51.4:C /57.4:A		
14	COUPL.CONT.RELAY,4NO,DC24V,DIODE COUPLING CONTACTOR RELAY, 4NO, DC 24V, 0.85...1.85*US, W/ INTEGRATED DIODE, SIZE S00, SCREW TERMINAL Order No.: 3RH2140-1VB40	Siemens					
			+UBCJA10	-2K101	/36.8:D /50.2:B /50.2:C /50.2:C		
			+UBCJA10	-2K102	/37.1:D /50.3:B /50.3:C /50.3:C		
			+UBCJA10	-2K103	/37.2:D /50.4:B /50.4:C /50.4:C		
			+UBCJA10	-2K104	/37.3:D /50.5:B /50.5:C /50.5:C		
			+UBCJA10	-2K105	/37.4:D /50.6:B /50.6:C /50.6:C		
			+UBCJA10	-2K106	/37.5:D /51.3:B /51.3:C /51.3:C		
			+UBCJA10	-2K107	/37.8:D /52.4:B /52.4:C /52.4:C		
			+UBCJA10	-2K108	/38.1:D /52.6:B /52.6:C /52.6:C		
			+UBCJA10	-2K109	/38.3:D /54.3:B /54.3:B /54.3:C		
			+UBCJA10	-2K110	/38.4:D		
			+UBCJA10	-2K111A	/59.5:E /60.5:C /60.5:C /61.3:C /61.4:C		
			+UBCJA10	-2K112A	/59.6:E /60.6:C /60.6:C /61.4:C /61.4:C		
			+UBCJA10	-2K113	/41.7:D		
+UBCJA10	-2K114	/41.8:D					

Approved by Contractor			Reconstruction and Modernisation of HPP Perucica - Phase II		 A Voith Company Sintaksa - A Voith Company Ulica Domovinskog rata 104C, 21 000 Split, Hrvatska	Unit KA2 control cubicle circuit diagrams	DRAWING No.:	REV No.:	= UBCJA10GH100
Approved by Designer		Grga Kolić					01.10.2026.	PERU-01-19-170-31-002	02
Checked by		Antonio Aleksić	01.10.2026.	EMPLOYER	DESIGNER	Device tag List	Designer No.:	SALES No.:	PAGE 123
Drawn by		Tamara Trogrlić	01.10.2026.				PROJECT NAME	PAGE 123 / 157	

122

124

CONFIDENTIAL, ALL RIGHTS RESERVED DIN 34

Format ISO/DIN A3

123

1	2	3	4	5	6	7	8
Qty. (pcs)	Equipment technical description	Manufacturer	Location (+)	Designation (-)	Symbol Position in schematics (Page, column)		
1	SIRIUS SAFETY RELAY STD RELAYS 3NO+1NC SIRIUS safety relay Basic unit Standard series Relay enabling circuits 3 NO contacts plus Relay signaling circuit 1 NC contact Us = 24 V AC/DC screw terminal Type: 3SK1111-1AB30 Order No.: 3SK1111-1AB30	Siemens					
			+UBCJA10	-K301	/57.2:C	/57.4:E	
1	ILLUM. MUSHROOM PUSHBUTTON, 40MM, RED Illuminated mushroom pushbutton, 22 mm, round, metal, shiny, red, 40 mm, latching, Pull-to-unlatch mechanism Order No.: 3SU1051-1BA20-0AA0 LED MODULE, RED Type: 3SU1401-1BB20-1AA0 LED MODULE WITH INTEGRATED LED 24V AC/DC, RED, SCREW TERMINAL, FOR FRONT PLATE MOUNTING PROTECTIVE COLLAR Type: 3SU1900-0DY30-0AA0 PROTECTIVE COLLAR FOR EM. STOP MUSHROOM PUSHBUTTON, WITHOUT OR WITH RONIS LOCK, YELLOW, PLASTIC HOLDER, CONTACT MODULE 1NC,1NC Type: 3SU1550-1AA10-1PA0 Holder for 3 modules, metal, 1 NC, 1 NC, screw terminal	Siemens					
			+UBCJA10	-S301	/43.8:D	/16.7:D	/56.1:B



125

Approved by Contractor			Reconstruction and Modernisation of HPP Perucica - Phase II			Unit KA2 control cubicle circuit diagrams	DRAWING No.:	REV No.:	= UBCJA10GH100
Approved by Designer	Grga Kolić	01.10.2026.					PERU-01-19-170-31-002	02	+ UBCJA10
Checked by	Antonio Aleksić	01.10.2026.	PROJECT NAME	EMPLOYER	DESIGNER	Device tag List	Designer No.:	SALES No.:	PAGE
Drawn by	Tamara Trogrlić	01.10.2026.							124
									PAGE
									124 / 157

124

Format ISO/DIN A3

CONFIDENTIAL, ALL RIGHTS RESERVED DIN 34

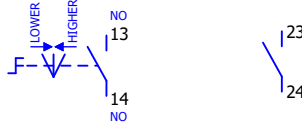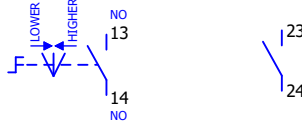1		2		3		4		5		6		7		8	
Qty. (pcs)	Equipment technical description			Manufacturer	Location (+)	Designation (-)	Symbol Position in schematics (Page, column)								
1	SELECTOR SWITCH, I>O<II, RED Siemens Selector switch, illuminable, 22 mm, round, metal, shiny, red, selector switch, short, 3 switch positions I>O<II, momentary contact type, actuating angle 2x45°, 10:30h/12h/13:30h Order No.: 3SU1052-2BM20-0AA0 Contact module with 1 contact element, 1 NO Type: 3SU1400-1AA10-1BA0 Contact module with 1 contact element, 1 NO, screw terminal, for front plate mounting Contact module with 1 contact element, 1 NO Type: 3SU1400-1AA10-1BA0 Contact module with 1 contact element, 1 NO, screw terminal, for front plate mounting HOLDER Type: 3SU1550-0AA10-0AA0 Holder for 3 modules, universal, plastic/metal SIRIUS ACT Label holder Type: 3SU1900-0AP10-0AA0 Label holder, 22mm, frame rectangular at the bottom, black, for labeling plate 17.5 mm x 27 mm, for gluing														
				+UBCJA10	-S221	/63.6:D		/63.7:D							
1	SELECTOR SWITCH, I>O<II, BLUE Siemens Selector switch, illuminable, 22 mm, round, metal, shiny, blue, selector switch, short, 3 switch positions I>O<II, momentary contact type, actuating angle 2x45°, 10:30h/12h/13:30h Order No.: 3SU1052-2BM50-0AA0 Contact module with 1 contact element, 1 NO Type: 3SU1400-1AA10-1BA0 Contact module with 1 contact element, 1 NO, screw terminal, for front plate mounting Contact module with 1 contact element, 1 NO Type: 3SU1400-1AA10-1BA0 Contact module with 1 contact element, 1 NO, screw terminal, for front plate mounting HOLDER Type: 3SU1550-0AA10-0AA0 Holder for 3 modules, universal, plastic/metal SIRIUS ACT Label holder Type: 3SU1900-0AP10-0AA0 Label holder, 22mm, frame rectangular at the bottom, black, for labeling plate 17.5 mm x 27 mm, for gluing														
				+UBCJA10	-S222	/63.2:D		/63.3:D							
Approved by Contractor			Reconstruction and Modernisation of HPP Perucica - Phase II		 A Voith Company	Unit KA2 control cubicle circuit diagrams		DRAWING No.: PERU-01-19-170-31-002		REV No.: 02	= UBCJA10GH100				
Approved by Designer		Grga Kolić				Designer No.:		SALES No.:		+ UBCJA10					
Checked by		Antonio Aleksić	PROJECT NAME	EMPLOYER	DESIGNER	Device tag List		Designer No.:		PAGE	125				
Drawn by		Tamara Trogrlić						PAGE		125 / 157					
1		2		3		4		5		6		7		8	

126

CONFIDENTIAL, ALL RIGHTS RESERVED DIN 34


Format ISO/DIN A3

1		2		3		4		5		6		7		8			
A																A	
	Qty. (pcs)	Equipment technical description	Manufacturer	Location (+)	Designation (-)	Symbol Position in schematics (Page, column)											
B	1	SELECTOR SWITCH, I-O-II, BLACK, WHITE	Siemens													B	
		Selector switch, illuminable, 22 mm, round, metal, shiny, white, selector switch, short, 3 switch positions I-O-II, latching, actuating angle 2x45°, 10:30h/12h/13:30h, with holder, 2x1NO+1NC, screw terminal Order No.: 3SU1150-2BL60-1LA0 SIRIUS ACT Label holder Type: 3SU1900-0AP10-0AA0 Label holder, 22mm, frame rectangular at the bottom, black, for labeling plate 17.5 mm x 27 mm, for gluing	+UBCJA10	-S121	/59.2:B	/59.4:B	/59.3:B	/59.4:C									
C	1	KEY-OPERATED SWITCH RONIS, O-I	Siemens													C	
		RONIS key-operated switch, 22 mm, round, metal, shiny, lock number SB30, with 2 keys, 2 switch positions O-I, latching, actuating angle 90°, 10:30h/13:30h, key removal O+I, with holder, 1 NO+1 NC, screw terminal, possible special locks: 3SB31, 421, 455 Order No.: 3SU1150-4BF11-1FA0 SIRIUS ACT Label holder Type: 3SU1900-0AP10-0AA0 Label holder, 22mm, frame rectangular at the bottom, black, for labeling plate 17.5 mm x 27 mm, for gluing DIN rail mounting base - Ø 22 mm units - for control and signalling unit Type: A9A15151 DIN rail mounting base - Ø 22 mm units - for control and signalling unit	+UBCJA10	-S100	/16.1:D												
E	1	ILLUMINATED PUSHBUTTON, RED	Siemens													E	
		ILLUMINATED pushbutton, 22 mm, round, metal, shiny, red, pushbutton, flat, momentary contact type, with holder, 1 NO+1 NC, LED module with integrated LED 24 V AC/DC, screw terminal Order No.: 3SU1152-0AB20-1FA0 SIRIUS ACT Label holder Type: 3SU1900-0AP10-0AA0 Label holder, 22mm, frame rectangular at the bottom, black, for labeling plate 17.5 mm x 27 mm, for gluing	+UBCJA10	-S290	/17.3:D	/43.6:D											
F	1														F		
Format ISO/DIN A3																	
126																	
128																	
Approved by Contractor				Reconstruction and Modernisation of HPP Perucica - Phase II						Unit KA2 control cubicle circuit diagrams		DRAWING No.: PERU-01-19-170-31-002		REV No.: 02		= UBCJA10GH100	
Approved by Designer		Grga Kolić		01.10.2026.						Device tag List		Designer No.:		SALES No.:		PAGE 127	
Checked by		Antonio Aleksić		01.10.2026.													
Drawn by		Tamara Trogrlić		01.10.2026.		PROJECT NAME		EMPLOYER		DESIGNER						PAGE 127 / 157	
1		2		3		4		5		6		7		8			

127

Format ISO/DIN A3

CONFIDENTIAL, ALL RIGHTS RESERVED DIN 34

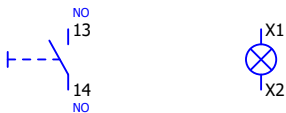Qty. (pcs)	Equipment technical description	Manufacturer	Location (+)	Designation (-)	Symbol Position in schematics (Page, column)										
4	ILLUMINATED PUSHBUTTON, GREEN Illuminated pushbutton, 22 mm, round, metal, shiny, green, pushbutton, flat, momentary contact type, with holder, 1 NO, LED module with integrated LED 24 V AC/DC, screw terminal Order No.: 3SU1152-0AB40-1BA0 SIRIUS ACT Label holder Type: 3SU1900-0AP10-0AA0 Label holder, 22mm, frame rectangular at the bottom, black, for labeling plate 17.5 mm x 27 mm, for gluing	Siemens													
			+UBCJA10	-S111	/17.7:D /42.3:D										
			+UBCJA10	-S113	/18.1:D										
			+UBCJA10	-S131	/17.6:D /43.2:D										
			+UBCJA10	-S291	/17.4:D /43.7:D										
1	INDICATOR LIGHT, RED Indicator lights, 22 mm, round, metal, shiny, red, lens, smooth, with holder, LED module with integrated LED 24 V AC/DC, screw terminal Order No.: 3SU1152-6AA20-1AA0 SIRIUS ACT Label holder Type: 3SU1900-0AP10-0AA0 Label holder, 22mm, frame rectangular at the bottom, black, for labeling plate 17.5 mm x 27 mm, for gluing	Siemens													
			+UBCJA10	-H104	/43.4:D										
1	INDICATOR LIGHT, YELLOW Indicator lights, 22 mm, round, metal, shiny, yellow, lens, smooth, with holder, LED module with integrated LED 24 V AC/DC, screw terminal Order No.: 3SU1152-6AA30-1AA0 SIRIUS ACT Label holder Type: 3SU1900-0AP10-0AA0 Label holder, 22mm, frame rectangular at the bottom, black, for labeling plate 17.5 mm x 27 mm, for gluing	Siemens													
			+UBCJA10	-H103	/43.3:D										

Approved by Contractor			Reconstruction and Modernisation of HPP Perucica - Phase II		 Sintaksa - A Voith Company Ulica Domovinskog rata 104C, 21 000 Split, Hrvatska	Unit KA2 control cubicle circuit diagrams Device tag List	DRAWING No.:	REV No.:	= UBCJA10GH100
Approved by Designer	Grga Kolić	01.10.2026.					PERU-01-19-170-31-002	02	+ UBCJA10
Checked by	Antonio Aleksić	01.10.2026.	DESIGNER	Designer No.:			SALES No.:	PAGE	128
Drawn by	Tamara Trogrlić	01.10.2026.	PROJECT NAME	EMPLOYER				PAGE	128 / 157

129





CONFIDENTIAL, ALL RIGHTS RESERVED DIN 34

Format ISO/DIN A3

127

129

CONFIDENTIAL, ALL RIGHTS RESERVED DIN 34

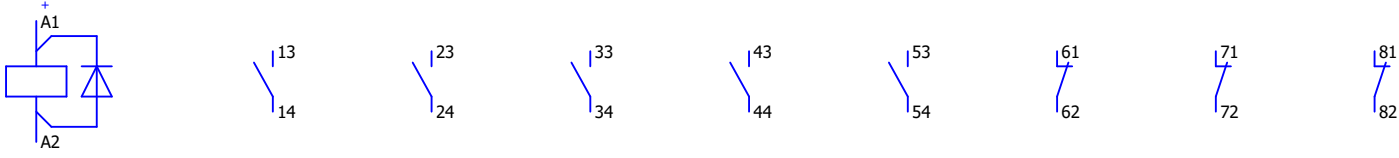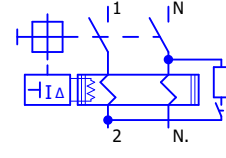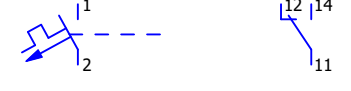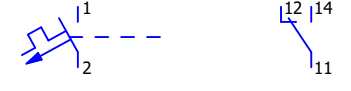1		2		3		4		5		6		7		8	
Qty. (pcs)	Equipment technical description	Manufacturer	Location (+)	Designation (-)	Symbol Position in schematics (Page, column)										
2	Contactor relay Contactor relay, 53E, DIN EN 50011, 5NO + 3NC, screw terminal DC operation 24 V DC Order No.: 3TH4253-0BB4 Surge suppressor Type: 3TX7402-3A Surge suppressor Interference suppression diode with cable spacer 24-250 V DC for mounting to coil terminal for contactor relays 3TH4	Siemens													
			+UBCJA10	-K401	/64.2:E	/54.2:B	/54.2:B	/54.2:E	/54.3:E	/19.4:D					
			+UBCJA10	-K402	/64.4:E	/54.6:B	/54.6:B	/54.6:E	/54.7:E	/19.5:D					
1	RCBO RCBO, 10 kA, 1P+N, type AC, 30 mA, C-char, In: 13 A, Un AC: 230 V Order No.: 5SU1354-1KK13	Siemens													
			+UBCJA10	-F0	/5.2:C										
4	Miniature circuit breaker 230/400V 10kA 1-pole B curve 2A Order No.: 5SY4102-6 Auxiliary switch Type: 5ST3016 1 C/O For MCB 5SL, 5SY, 5SP; Incorporated switch 5TL1 RCBO 5SU1, RC 5SV Rated voltage: 30 V	Siemens													
			+UBCJA10	-F135	/9.8:B	/15.7:D									
			+UBCJA10	-F137	/10.2:B	/15.7:B									
			+UBCJA10	-F138	/10.3:B	/15.7:C									
			+UBCJA10	-F147	/11.7:B										
	SENTRON Miniature circuit breaker Miniature circuit breaker 230/400 V 10kA, 1-pole, B, 6 A, D=70 mm Order No.: 5SY4106-6 Auxiliary switch Type: 5ST3016 1 C/O For MCB 5SL, 5SY, 5SP; Incorporated switch 5TL1 RCBO 5SU1, RC 5SV Rated voltage: 30 V	Siemens													
			+UBCJA10	-F131	/9.1:B	/15.7:B									



Format ISO/DIN A3

129

Approved by Contractor			Reconstruction and Modernisation of HPP Perucica - Phase II		 A Voith Company Sintaksa - A Voith Company Ulica Domovinskog rata 104C, 21 000 Split, Hrvatska	Unit KA2 control cubicle circuit diagrams	DRAWING No.:	REV No.:	= UBCJA10GH100	
Approved by Designer	Grga Kolić	01.10.2026.					PERU-01-19-170-31-002	02	+ UBCJA10	
Checked by	Antonio Aleksić	01.10.2026.					Designer No.:	SALES No.:	PAGE	130
Drawn by	Tamara Trogrlić	01.10.2026.	PROJECT NAME	EMPLOYER	DESIGNER	Device tag List			PAGE	130 / 157

131

CONFIDENTIAL, ALL RIGHTS RESERVED DIN 34

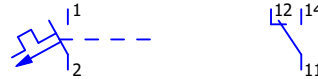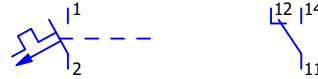1	2	3	4	5	6	7	8	
12	Qty. (pcs)	Equipment technical description	Manufacturer	Location (+)	Designation (-)	Symbol Position in schematics (Page, column)		
		SENTRON Miniature circuit breaker Miniature circuit breaker 230/400 V 10kA, 1-pole, B, 6 A, D=70 mm Order No.: 5SY4106-6 Auxiliary switch Type: 5ST3016 1 C/O For MCB 5SL, 5SY, 5SP; Incorporated switch 5TL1 RCBO 5SU1, RC 5SV Rated voltage: 30 V	Siemens					
				+UBCJA10	-F132	/9.4:B	/15.6:B	
				+UBCJA10	-F133	/9.6:B	/15.7:C	
				+UBCJA10	-F134	/9.7:B	/15.7:C	
				+UBCJA10	-F139	/10.4:B	/15.6:C	
				+UBCJA10	-F140	/10.6:B	/15.7:C	
				+UBCJA10	-F141	/10.7:B	/15.7:D	
				+UBCJA10	-F142	/11.1:B	/15.6:C	
				+UBCJA10	-F143	/11.2:B	/15.6:D	
				+UBCJA10	-F144	/11.3:B	/15.6:B	
				+UBCJA10	-F145	/11.4:B		
+UBCJA10	-F146	/11.6:B						
1		Miniature circuit breaker, 10kA, 1-pole, B, 10A 230/400 V 10kA 1-pole B curve 10A Order No.: 5SY4110-6 Auxiliary switch Type: 5ST3016 1 C/O For MCB 5SL, 5SY, 5SP; Incorporated switch 5TL1 RCBO 5SU1, RC 5SV Rated voltage: 30 V	Siemens					
				+UBCJA10	-F136	/10.1:B	/15.7:D	

130

132

Approved by Contractor			Reconstruction and Modernisation of HPP Perucica - Phase II		 A Voith Company Sintaksa - A Voith Company Ulica Domovinskog rata 104C, 21 000 Split, Hrvatska	Unit KA2 control cubicle circuit diagrams Device tag List	DRAWING No.:	REV No.:	= UBCJA10GH100	
Approved by Designer	Grga Kolić	01.10.2026.					PERU-01-19-170-31-002	02	+ UBCJA10	
Checked by	Antonio Aleksić	01.10.2026.					Designer No.:	SALES No.:	PAGE	131
Drawn by	Tamara Trogrlić	01.10.2026.					PROJECT NAME	EMPLOYER	DESIGNER	PAGE
1	2	3	4	5	6	7	8			

1		2		3		4		5		6		7		8	
CONFIDENTIAL, ALL RIGHTS RESERVED DIN 34															
Format ISO/DIN A3															
131															
133															
132															
132 / 157															
131															
133															
132															
132 / 157															
131															
133															

		1	2	3	4	5	6	7	8
A	B	C	D	E	F				
A	B	C	D	E	F				
Approved by Contractor			Reconstruction and Modernisation of HPP Perucica - Phase II		 A Voith Company	Unit KA2 control cubicle circuit diagrams	DRAWING No.:	REV No.:	= UBCJA10GH100		
Approved by Designer	Grga Kolić	01.10.2026.			Sintaksa - A Voith Company Ulica Domovinskog rata 104C, 21 000 Split, Hrvatska		PERU-01-19-170-31-002	02	+ UBCJA10		
Checked by	Antonio Aleksić	01.10.2026.			PROJECT NAME		EMPLOYER	DESIGNER	Designer No.:	SALES No.:	PAGE 134
Drawn by	Tamara Trogrlić	01.10.2026.							Device tag List		PAGE 134 / 157

CONFIDENTIAL, ALL RIGHTS RESERVED DIN 34

Format ISO/DIN A3

134

1

2

3

4

5

6

7

8

	Cable name : -2WK1001		Number of conductors : 4		Description :			
	Cable type : NYY		Number of used conductors : 2					
			Cable cross section : 2.5					
	External Connections			Connection color/number	Internal Connections			
To device		Pin designation	Page/column		From device		Pin designation	Page/column
=KZK2+KZK2-X1		1	=UBCJA10GH100+UBCJA10/10.7:E	BK	=UBCJA10GH100+UBCJA10-X141		1:A	=UBCJA10GH100+UBCJA10/10.7:D
=KZK2+KZK2-X1		14	=UBCJA10GH100+UBCJA10/10.7:E	BU	=UBCJA10GH100+UBCJA10-X141		19:A	=UBCJA10GH100+UBCJA10/10.7:D

	Cable name : -2WK1002		Number of conductors : 12		Description :		
	Cable type : LiYCY		Number of used conductors : 6				
			Cable cross section : 0.75				
	External Connections			Connection color/number	Internal Connections		
To device	Pin designation	Page/column	From device		Pin designation	Page/column	
=KZK2+KZK2-X1	30	=UBCJA10GH100+UBCJA10/31.8:C	WH	=UBCJA10GH100+UBCJA10-1K128	A1	=UBCJA10GH100+UBCJA10/31.8:D	
=KZK2+KZK2-X1	29	=UBCJA10GH100+UBCJA10/31.7:C	BN	=UBCJA10GH100+UBCJA10-1K127	A1	=UBCJA10GH100+UBCJA10/31.7:D	
=KZK2+KZK2-X1	28	=UBCJA10GH100+UBCJA10/31.6:C	GN	=UBCJA10GH100+UBCJA10-1K126	A1	=UBCJA10GH100+UBCJA10/31.6:D	
=KZK2+KZK2-X1	27	=UBCJA10GH100+UBCJA10/31.3:C	YE	=UBCJA10GH100+UBCJA10-1K123	A1	=UBCJA10GH100+UBCJA10/31.3:D	
			GY				
			PK				
=KZK2+KZK2-X1	26	=UBCJA10GH100+UBCJA10/31.1:C	BU	=UBCJA10GH100+UBCJA10-1K121	A1	=UBCJA10GH100+UBCJA10/31.1:D	
			RD				
=KZK2+KZK2-X1	25	=UBCJA10GH100+UBCJA10/31.2:C	BK	=UBCJA10GH100+UBCJA10-1K122	A1	=UBCJA10GH100+UBCJA10/31.2:D	
			VT				
			GY-PK				
			RD-BU				

	Cable name :	-2WK1003	Number of conductors :		4	Description :		
	Cable type :	LiYCY	Number of used conductors :		1			
			Cable cross section :		0.75			
External Connections					Internal Connections			
To device		Pin designation	Page/column	Connection color/number		From device	Pin designation	Page/column
				WH				
=KZK2+KZK2-X1		37	=UBCJA10GH100+UBCJA10/45.2:C	BN		=UBCJA10GH100+UBCJA10-X151	5:A	=UBCJA10GH100+UBCJA10/45.2:C
				GN				
				YE				

Approved by Contractor			Reconstruction and Modernisation of HPP Perucica - Phase II		 A Voith Company Sintaksa - A Voith Company Ulica Domovinskog rata 104C, 21 000 Split, Hrvatska	Unit KA2 control cubicle circuit diagrams CABLE DIAGRAM	DRAWING No.: PERU-01-19-170-31-002	REV No.:	= UBCJA10GH100
Approved by Designer	Grga Kolić	01.10.2026.							+ UBCJA10
Checked by	Antonio Aleksić	01.10.2026.					Designer No.:	SALES No.:	PAGE 135
Drawn by	Tamara Trogrlić	01.10.2026.	PROJECT NAME	EMPLOYER	DESIGNER				PAGE 135 / 157

CONFIDENTIAL, ALL RIGHTS RESERVED DIN 34

Format ISO/DIN A3

135

Approved by Contractor			Reconstruction and Modernisation of HPP Perucica - Phase II		 A Voith Company Sintaksa - A Voith Company Ulica Domovinskog rata 104C, 21 000 Split, Hrvatska	Unit KA2 control cubicle circuit diagrams CABLE DIAGRAM	DRAWING No.: PERU-01-19-170-31-002	REV No.:	= UBCJA10GH100
Approved by Designer	Grga Kolić	01.10.2026.							+ UBCJA10
Checked by	Antonio Aleksić	01.10.2026.					Designer No.:	SALES No.:	PAGE 136
Drawn by	Tamara Trogrlić	01.10.2026.							PAGE 136 / 157

	Cable name : -2WK1004		Number of conductors : 7		Description :		
	Cable type : YSLY		Number of used conductors : 5				
			Cable cross section : 0.75				
	External Connections			Connection color/number	Internal Connections		
To device	Pin designation	Page/column	From device		Pin designation	Page/column	
=KZK2+KZK2-X2	1	=UBCJA10GH100+UBCJA10/52.4:E	BN	=UBCJA10GH100+UBCJA10-X15	11:A	=UBCJA10GH100+UBCJA10/52.4:D	
=KZK2+KZK2-X2	3	=UBCJA10GH100+UBCJA10/52.4:E	BU	=UBCJA10GH100+UBCJA10-X15	7:A	=UBCJA10GH100+UBCJA10/52.4:B	
=KZK2+KZK2-X2	9	=UBCJA10GH100+UBCJA10/52.2:E	GN	=UBCJA10GH100+UBCJA10-X15	10:A	=UBCJA10GH100+UBCJA10/52.2:D	
=KZK2+KZK2-X2	10	=UBCJA10GH100+UBCJA10/52.2:E	GY	=UBCJA10GH100+UBCJA10-X15	9:A	=UBCJA10GH100+UBCJA10/52.2:D	
=KZK2+KZK2-X2	5	=UBCJA10GH100+UBCJA10/52.6:E	YE	=UBCJA10GH100+UBCJA10-X15	12:A	=UBCJA10GH100+UBCJA10/52.6:D	

	Cable name : -2WK1005		Number of conductors : 4		Description :	
	Cable type : LiYCY		Number of used conductors : 3			
			Cable cross section : 0.75			
External Connections			Connection color/number	Internal Connections		
To device	Pin designation	Page/column		From device	Pin designation	Page/column
			WH			
=KZK2+KZK2-X1	38	=UBCJA10GH100+UBCJA10/32.7:C	BN	=UBCJA10GH100+UBCJA10-1K137	A1	=UBCJA10GH100+UBCJA10/32.7:D
=KZK2+KZK2-X2	11	=UBCJA10GH100+UBCJA10/31.4:C	GN	=UBCJA10GH100+UBCJA10-1K124	A1	=UBCJA10GH100+UBCJA10/31.4:D
=KZK2+KZK2-X2	12	=UBCJA10GH100+UBCJA10/31.5:C	YE	=UBCJA10GH100+UBCJA10-1K125	A1	=UBCJA10GH100+UBCJA10/31.5:D

	Cable name : -2WK1006		Number of conductors : 3		Description :		
	Cable type : NYY-J		Number of used conductors : 2				
			Cable cross section : 2.5				
	External Connections			Connection color/number	Internal Connections		
To device	Pin designation	Page/column	From device		Pin designation	Page/column	
=TN+TN-X4	12	=UBCJA10GH100+UBCJA10/49.5:E	BN	=UBCJA10GH100+UBCJA10-X62	7:A	=UBCJA10GH100+UBCJA10/49.5:D	
=TN+TN-X4	13	=UBCJA10GH100+UBCJA10/49.6:E	BU	=UBCJA10GH100+UBCJA10-X62	8:A	=UBCJA10GH100+UBCJA10/49.6:D	

	Cable name : -2WS811		Number of conductors : 4		Description :	
	Cable type : LiYCY		Number of used conductors : 2			
			Cable cross section : 0.75			
	External Connections			Connection color/number	Internal Connections	
To device	Pin designation	Page/column	From device		Pin designation	Page/column
=LUB+LUB-S811	1	=UBCJA10GH100+UBCJA10/30.5:B	WH	=UBCJA10GH100+UBCJA10-X140	7:A	=UBCJA10GH100+UBCJA10/30.5:B
=LUB+LUB-S811	3	=UBCJA10GH100+UBCJA10/30.5:C	BN	=UBCJA10GH100+UBCJA10-1K115	A1	=UBCJA10GH100+UBCJA10/30.5:D
			GN			
			YE			

135

137

CONFIDENTIAL, ALL RIGHTS RESERVED DIN 34

Format ISO/DIN A3

	Cable name : -2WT100		Number of conductors : 7		Description :	
	Cable type : LiYCY		Number of used conductors : 5			
			Cable cross section : 0.75			
	External Connections			Connection color/number	Internal Connections	
To device	Pin designation	Page/column	From device		Pin designation	Page/column
=T2+T2-X1	1	=UBCJA10GH100+UBCJA10/10.8:E	WH	=UBCJA10GH100+UBCJA10-X141	2:A	=UBCJA10GH100+UBCJA10/10.8:D
=T2+T2-X1	5	=UBCJA10GH100+UBCJA10/10.8:E	BN	=UBCJA10GH100+UBCJA10-X141	20:A	=UBCJA10GH100+UBCJA10/10.8:D
=T2+T2-X1	9	=UBCJA10GH100+UBCJA10/45.3:C	GN	=UBCJA10GH100+UBCJA10-X135	12:A	=UBCJA10GH100+UBCJA10/45.3:E
=T2+T2-X1	10	=UBCJA10GH100+UBCJA10/45.3:C	YE	=UBCJA10GH100+UBCJA10-PE_SH	6:A	=UBCJA10GH100+UBCJA10/45.3:C
=T2+T2-X1	11	=UBCJA10GH100+UBCJA10/48.7:C	GY	=UBCJA10GH100+UBCJA10-X51	5:A	=UBCJA10GH100+UBCJA10/48.7:D
			PK			
			BU			

	Cable name : -2WT101		Number of conductors : 7		Description :	
			Number of used conductors : 4			
	Cable type : LiYCY		Cable cross section : 0.75			
	External Connections			Connection color/number	Internal Connections	
To device	Pin designation	Page/column	From device		Pin designation	Page/column
=T2+T2-X1	12	=UBCJA10GH100+UBCJA10/48.5:C	WH	=UBCJA10GH100+UBCJA10-X51	1:A	=UBCJA10GH100+UBCJA10/48.5:D
=T2+T2-X1	13	=UBCJA10GH100+UBCJA10/48.5:C	BN	=UBCJA10GH100+UBCJA10-X51	2:A	=UBCJA10GH100+UBCJA10/48.5:D
=T2+T2-X1	14	=UBCJA10GH100+UBCJA10/48.5:C	GN	=UBCJA10GH100+UBCJA10-X51	3:A	=UBCJA10GH100+UBCJA10/48.5:D
=T2+T2-X1	15	=UBCJA10GH100+UBCJA10/30.4:C	YE	=UBCJA10GH100+UBCJA10-1K114	A1	=UBCJA10GH100+UBCJA10/30.4:D
			GY			
			PK			
			BU			

	Cable name : -2WUN300		Number of conductors : 4	Description :		
	Cable type : PP00		Number of used conductors : 2			
			Cable cross section : 2.5			
External Connections			Connection color/number	Internal Connections		
To device	Pin designation	Page/column		From device	Pin designation	Page/column
=TN+TN-X1	1	=UBCJA10GH100+UBCJA10/10.6:E	BK	=UBCJA10GH100+UBCJA10-X140	1:A	=UBCJA10GH100+UBCJA10/10.6:D
=TN+TN-X1	14	=UBCJA10GH100+UBCJA10/10.6:E	BU	=UBCJA10GH100+UBCJA10-X140	10:A	=UBCJA10GH100+UBCJA10/10.6:D

	Cable name : -2WUN301		Number of conductors : 7		Description :		
	Cable type : LiYCY		Number of used conductors : 7				
			Cable cross section : 0.75				
	External Connections			Connection color/number	Internal Connections		
To device	Pin designation	Page/column	From device		Pin designation	Page/column	
=TN+TN-X1	29	=UBCJA10GH100+UBCJA10/30.1:C	WH	=UBCJA10GH100+UBCJA10-1K111	A1	=UBCJA10GH100+UBCJA10/30.1:D	
=TN+TN-X1	30	=UBCJA10GH100+UBCJA10/30.2:C	BN	=UBCJA10GH100+UBCJA10-1K112	A1	=UBCJA10GH100+UBCJA10/30.2:D	
=TN+TN-X1	31	=UBCJA10GH100+UBCJA10/50.4:E	GN	=UBCJA10GH100+UBCJA10-X136	15:A	=UBCJA10GH100+UBCJA10/50.4:D	
=TN+TN-X1	32	=UBCJA10GH100+UBCJA10/50.2:E	YE	=UBCJA10GH100+UBCJA10-X136	13:A	=UBCJA10GH100+UBCJA10/50.2:D	
=TN+TN-X1	33	=UBCJA10GH100+UBCJA10/50.3:E	GY	=UBCJA10GH100+UBCJA10-X136	14:A	=UBCJA10GH100+UBCJA10/50.3:D	
=TN+TN-X1	36	=UBCJA10GH100+UBCJA10/50.5:E	PK	=UBCJA10GH100+UBCJA10-X136	16:A	=UBCJA10GH100+UBCJA10/50.5:D	

Approved by Contractor			Reconstruction and Modernisation of HPP Perucica - Phase II		 A Voith Company Sintaksa - A Voith Company Ulica Domovinskog rata 104C, 21 000 Split, Hrvatska	Unit KA2 control cubicle circuit diagrams CABLE DIAGRAM	DRAWING No.: PERU-01-19-170-31-002	REV No.: = UBCJA10GH100
Approved by Designer	Grga Kolić	01.10.2026.						+ UBCJA10
Checked by	Antonio Aleksić	01.10.2026.					Designer No.:	PAGE 137
Drawn by	Tamara Trogrlić	01.10.2026.						PAGE 137 / 157

CONFIDENTIAL, ALL RIGHTS RESERVED DIN 34

Format ISO/DIN A3

137

139

Approved by Contractor			Reconstruction and Modernisation of HPP Perucica - Phase II		 Sintaksa - A Voith Company Ulica Domovinskog rata 104C, 21 000 Split, Hrvatska	Unit KA2 control cubicle circuit diagrams CABLE DIAGRAM	DRAWING No.: PERU-01-19-170-31-002	REV No.: = UBCJA10GH100	
Approved by Designer	Grga Kolić	01.10.2026.						+ UBCJA10	
Checked by	Antonio Aleksić	01.10.2026.					Designer No.:	SALES No.:	PAGE 138
Drawn by	Tamara Trogrlić	01.10.2026.							PAGE 138 / 157

	Cable name :	-2WUN301	Number of conductors :		7	Description :		
	Cable type :	LiYCY	Number of used conductors :		7			
			Cable cross section :		0.75			
External Connections			Connection color/number	Internal Connections				
To device		Pin designation		Page/column	From device		Pin designation	Page/column
=TN+TN-X1		37		=UBCJA10GH100+UBCJA10/50.6:E	=UBCJA10GH100+UBCJA10-X136		17:A	=UBCJA10GH100+UBCJA10/50.6:D

	Cable name :	-2WUN302	Number of conductors :		4	Description :		
	Cable type :	LiYCY	Number of used conductors :		4			
			Cable cross section :		0.75			
External Connections			Connection color/number	Internal Connections				
To device		Pin designation		Page/column	From device		Pin designation	Page/column
=TN+TN-X1		38		=UBCJA10GH100+UBCJA10/46.1:E	=UBCJA10GH100+UBCJA10-X140		15:B	=UBCJA10GH100+UBCJA10/46.1:D
=TN+TN-X1		39		=UBCJA10GH100+UBCJA10/46.3:E	=UBCJA10GH100+UBCJA10-X61		1:A	=UBCJA10GH100+UBCJA10/46.3:E
=TN+TN-X1		40		=UBCJA10GH100+UBCJA10/46.3:E	=UBCJA10GH100+UBCJA10-X61		2:A	=UBCJA10GH100+UBCJA10/46.3:E
=TN+TN-X1		41	=UBCJA10GH100+UBCJA10/46.3:E	=UBCJA10GH100+UBCJA10-X61		3:A	=UBCJA10GH100+UBCJA10/46.3:E	

	Cable name : -2WUN303		Number of conductors : 4		Description :			
	Cable type : LiYCY		Number of used conductors : 2					
			Cable cross section : 0.75					
External Connections			Connection color/number	Internal Connections				
To device		Pin designation		Page/column	From device		Pin designation	Page/column
=TN+TN-X1		47	=UBCJA10GH100+UBCJA10/51.3:E	BN	=UBCJA10GH100+UBCJA10-X13		4:A	=UBCJA10GH100+UBCJA10/51.3:D
=TN+TN-X1		46	=UBCJA10GH100+UBCJA10/51.3:E	WH	=UBCJA10GH100+UBCJA10-X13		5:A	=UBCJA10GH100+UBCJA10/51.3:D

	Cable name : -2WUN304		Number of conductors : 7		Description :	
	Cable type : LiYCY		Number of used conductors : 4			
			Cable cross section : 0.75			
	External Connections			Connection color/number	Internal Connections	
To device	Pin designation	Page/column	From device		Pin designation	Page/column
=TN+TN-X2	12	=UBCJA10GH100+UBCJA10/44.5:C	WH	=UBCJA10GH100+UBCJA10-X151	3:A	=UBCJA10GH100+UBCJA10/44.5:C
=TN+TN-X2	15	=UBCJA10GH100+UBCJA10/30.3:C	BN	=UBCJA10GH100+UBCJA10-1K113	A1	=UBCJA10GH100+UBCJA10/30.3:D
=TN+TN-X2	18	=UBCJA10GH100+UBCJA10/44.1:C	GN	=UBCJA10GH100+UBCJA10-X151	1:A	=UBCJA10GH100+UBCJA10/44.1:C
=TN+TN-X2	20	=UBCJA10GH100+UBCJA10/44.3:C	YE	=UBCJA10GH100+UBCJA10-X151	2:A	=UBCJA10GH100+UBCJA10/44.3:C
			GY			
			PK			
			BU			

CONFIDENTIAL, ALL RIGHTS RESERVED DIN 34

Format ISO/DIN A3

138

140

	Cable name : -2WUN310		Number of conductors : 4		Description :	
	Cable type : PP00		Number of used conductors : 4			
			Cable cross section : 1.5			
	External Connections			Connection color/number	Internal Connections	
To device	Pin designation	Page/column	From device		Pin designation	Page/column
=TN+TN-X3	6	=UBCJA10GH100+UBCJA10/49.2:E	BK	=UBCJA10GH100+UBCJA10-X62	1:A	=UBCJA10GH100+UBCJA10/49.2:D
=TN+TN-X3	17	=UBCJA10GH100+UBCJA10/49.4:E	BN	=UBCJA10GH100+UBCJA10-X62	5:A	=UBCJA10GH100+UBCJA10/49.4:D
=TN+TN-X3	7	=UBCJA10GH100+UBCJA10/49.2:E	BU	=UBCJA10GH100+UBCJA10-X62	2:A	=UBCJA10GH100+UBCJA10/49.2:D
=TN+TN-X3	18	=UBCJA10GH100+UBCJA10/49.5:E	GNYE	=UBCJA10GH100+UBCJA10-X62	6:A	=UBCJA10GH100+UBCJA10/49.5:D

	Cable name : -2WUN311		Number of conductors : 4		Description :	
	Cable type : PP00		Number of used conductors : 2			
			Cable cross section : 1.5			
External Connections			Connection color/number	Internal Connections		
To device	Pin designation	Page/column		From device	Pin designation	Page/column
=TN+TN-X4	5	=UBCJA10GH100+UBCJA10/49.3:E	BK	=UBCJA10GH100+UBCJA10-X62	3:A	=UBCJA10GH100+UBCJA10/49.3:D
=TN+TN-X4	6	=UBCJA10GH100+UBCJA10/49.3:E	BU	=UBCJA10GH100+UBCJA10-X62	4:A	=UBCJA10GH100+UBCJA10/49.3:D

	Cable name : -2WUN312		Number of conductors : 7		Description :	
	Cable type : LiYCY		Number of used conductors : 6			
			Cable cross section : 0.75			
	External Connections			Connection color/number	Internal Connections	
To device	Pin designation	Page/column	From device		Pin designation	Page/column
=TN+TN-X3	9	=UBCJA10GH100+UBCJA10/29.3:C	WH	=UBCJA10GH100+UBCJA10-1K103	A1	=UBCJA10GH100+UBCJA10/29.3:D
=TN+TN-X3	10	=UBCJA10GH100+UBCJA10/29.4:C	BN	=UBCJA10GH100+UBCJA10-1K104	A1	=UBCJA10GH100+UBCJA10/29.4:D
=TN+TN-X4	8	=UBCJA10GH100+UBCJA10/29.5:C	GN	=UBCJA10GH100+UBCJA10-1K105	A1	=UBCJA10GH100+UBCJA10/29.5:D
=TN+TN-X4	9	=UBCJA10GH100+UBCJA10/29.6:C	YE	=UBCJA10GH100+UBCJA10-1K106	A1	=UBCJA10GH100+UBCJA10/29.6:D
=TN+TN-X3	21	=UBCJA10GH100+UBCJA10/29.8:C	GY	=UBCJA10GH100+UBCJA10-1K108	A1	=UBCJA10GH100+UBCJA10/29.8:D
			PK			
=TN+TN-X3	20	=UBCJA10GH100+UBCJA10/29.7:C	BU	=UBCJA10GH100+UBCJA10-1K107	A1	=UBCJA10GH100+UBCJA10/29.7:D

	Cable name : -02-0UA01+UV01-7-105		Number of conductors : 10		Description :	
	Cable type : NYCY		Number of used conductors : 10			
			Cable cross section : 2.5			
	External Connections			Connection color/number	Internal Connections	
To device	Pin designation	Page/column	From device		Pin designation	Page/column
=0UA01+UV01-X30	3	=UBCJA10GH100+UBCJA10/10.4:E	1BK	=UBCJA10GH100+UBCJA10-X139	1:A	=UBCJA10GH100+UBCJA10/10.4:D
=0UA01+UV01-X30	4	=UBCJA10GH100+UBCJA10/10.5:E	2BK	=UBCJA10GH100+UBCJA10-X139	12:A	=UBCJA10GH100+UBCJA10/10.5:D
=0UA01+UV01-X11	17	=UBCJA10GH100+UBCJA10/34.4:B	3BK	=UBCJA10GH100+UBCJA10-X139	2:A	=UBCJA10GH100+UBCJA10/34.4:B
=0UA01+UV01-X11	20	=UBCJA10GH100+UBCJA10/34.4:C	4BK	=UBCJA10GH100+UBCJA10-1K154	A1	=UBCJA10GH100+UBCJA10/34.4:D
=0UA01+UV01-X11	22	=UBCJA10GH100+UBCJA10/34.5:B	5BK	=UBCJA10GH100+UBCJA10-X139	3:A	=UBCJA10GH100+UBCJA10/34.5:B
=0UA01+UV01-X11	25	=UBCJA10GH100+UBCJA10/34.5:C	6BK	=UBCJA10GH100+UBCJA10-1K155	A1	=UBCJA10GH100+UBCJA10/34.5:D
=0UA01+UV01-X11	10	=UBCJA10GH100+UBCJA10/34.6:B	7BK	=UBCJA10GH100+UBCJA10-X139	4:A	=UBCJA10GH100+UBCJA10/34.6:B
=0UA01+UV01-X11	11	=UBCJA10GH100+UBCJA10/34.6:C	8BK	=UBCJA10GH100+UBCJA10-1K156	A1	=UBCJA10GH100+UBCJA10/34.6:D
=0UA01+UV01-X11	28	=UBCJA10GH100+UBCJA10/34.7:C	9BK	=UBCJA10GH100+UBCJA10-1K157	A1	=UBCJA10GH100+UBCJA10/34.7:D

Approved by Contractor			Reconstruction and Modernisation of HPP Perucica - Phase II		 A Voith Company Sintaksa - A Voith Company Ulica Domovinskog rata 104C, 21 000 Split, Hrvatska	Unit KA2 control cubicle circuit diagrams CABLE DIAGRAM	DRAWING No.:	REV No.:	= UBCJA10GH100
Approved by Designer	Grga Kolić	01.10.2026.					PERU-01-19-170-31-002		+ UBCJA10
Checked by	Antonio Aleksić	01.10.2026.					Designer No.:	SALES No.:	PAGE 139
Drawn by	Tamara Trogrlić	01.10.2026.							PAGE 139 / 157

CONFIDENTIAL, ALL RIGHTS RESERVED DIN 34

Format ISO/DIN A3

139

141

Approved by Contractor			Reconstruction and Modernisation of HPP Perucica - Phase II		 A Voith Company Sintaksa - A Voith Company Ulica Domovinskog rata 104C, 21 000 Split, Hrvatska	Unit KA2 control cubicle circuit diagrams CABLE DIAGRAM	DRAWING No.: PERU-01-19-170-31-002	REV No.:	= UBCJA10GH100
Approved by Designer	Grga Kolić	01.10.2026.							+ UBCJA10
Checked by	Antonio Aleksić	01.10.2026.					Designer No.:	SALES No.:	PAGE 140
Drawn by	Tamara Trogrlić	01.10.2026.							PAGE 140 / 157

	Cable name :	-02-0UA01+UV01-7-105	Number of conductors :		10	Description :		
	Cable type :	NYCY	Number of used conductors :		10			
			Cable cross section :		2.5			
External Connections			Connection color/number	Internal Connections				
To device		Pin designation		Page/column	From device		Pin designation	Page/column
=0UA01+UV01-X11		30	=UBCJA10GH100+UBCJA10/34.7:B	10BK	=UBCJA10GH100+UBCJA10-X139		5:A	=UBCJA10GH100+UBCJA10/34.7:B

	Cable name : -02-0XC01+XC01-7-102		Number of conductors : 10		Description :	
	Cable type : NYCY		Number of used conductors : 8			
			Cable cross section : 2.5			
	External Connections			Connection color/number	Internal Connections	
To device	Pin designation	Page/column	From device		Pin designation	Page/column
=0XC01+XC01-X01	2	=UBCJA10GH100+UBCJA10/35.2:B	1BK	=UBCJA10GH100+UBCJA10-X139	7:A	=UBCJA10GH100+UBCJA10/35.2:B
=0XC01+XC01-X02	17	=UBCJA10GH100+UBCJA10/35.2:C	2BK	=UBCJA10GH100+UBCJA10-1K162	A1	=UBCJA10GH100+UBCJA10/35.2:D
=0XC01+XC01-X02	15	=UBCJA10GH100+UBCJA10/35.3:C	3BK	=UBCJA10GH100+UBCJA10-1K163	A1	=UBCJA10GH100+UBCJA10/35.3:D
=0XC01+XC01-X02	12	=UBCJA10GH100+UBCJA10/35.4:C	4BK	=UBCJA10GH100+UBCJA10-1K164	A1	=UBCJA10GH100+UBCJA10/35.4:D
=0XC01+XC01-X02	13	=UBCJA10GH100+UBCJA10/35.5:C	5BK	=UBCJA10GH100+UBCJA10-1K165	A1	=UBCJA10GH100+UBCJA10/35.5:D
=0XC01+XC01-X02	14	=UBCJA10GH100+UBCJA10/35.6:C	6BK	=UBCJA10GH100+UBCJA10-1K166	A1	=UBCJA10GH100+UBCJA10/35.6:D
=0XC01+XC01-X02	11	=UBCJA10GH100+UBCJA10/35.7:C	7BK	=UBCJA10GH100+UBCJA10-1K167	A1	=UBCJA10GH100+UBCJA10/35.7:D
=0XC01+XC01-X02	16	=UBCJA10GH100+UBCJA10/35.8:C	8BK	=UBCJA10GH100+UBCJA10-1K168	A1	=UBCJA10GH100+UBCJA10/35.8:D

	Cable name : -02-2NA01+NA01-1204		Number of conductors : 3		Description :			
	Cable type : NYY-J		Number of used conductors : 3					
			Cable cross section : 4					
External Connections			Connection color/number	Internal Connections				
To device		Pin designation		Page/column	From device		Pin designation	Page/column
=2NA01+NA01-X10		16		=UBCJA10GH100+UBCJA10/5.2:B	=UBCJA10GH100+UBCJA10-X0		1:A	=UBCJA10GH100+UBCJA10/5.2:C
=2NA01+NA01-N				=UBCJA10GH100+UBCJA10/5.2:B	=UBCJA10GH100+UBCJA10-X0		2:A	=UBCJA10GH100+UBCJA10/5.2:C
=2NA01+NA01-X10		19/PE		=UBCJA10GH100+UBCJA10/5.3:B	=UBCJA10GH100+UBCJA10-X0		3:A	=UBCJA10GH100+UBCJA10/5.3:C

	Cable name : -02-2NA01+NA01-2203		Number of conductors : 3		Description :			
	Cable type : NYY-J		Number of used conductors : 2					
			Cable cross section : 4					
External Connections			Connection color/number	Internal Connections				
To device		Pin designation		Page/column	From device		Pin designation	Page/column
=2NA01+NA01-X4		5		=UBCJA10GH100+UBCJA10/6.1:F	=UBCJA10GH100+UBCJA10-X10		1:A	=UBCJA10GH100+UBCJA10/6.1:E
=2NA01+NA01-X4		6		=UBCJA10GH100+UBCJA10/6.1:F	=UBCJA10GH100+UBCJA10-X10		2:A	=UBCJA10GH100+UBCJA10/6.1:E
				GNYE				

CONFIDENTIAL, ALL RIGHTS RESERVED DIN 34

Format ISO/DIN A3

140

142

Approved by Contractor			Reconstruction and Modernisation of HPP Perucica - Phase II		 A Voith Company Sintaksa - A Voith Company Ulica Domovinskog rata 104C, 21 000 Split, Hrvatska	Unit KA2 control cubicle circuit diagrams CABLE DIAGRAM	DRAWING No.: PERU-01-19-170-31-002	REV No.:	= UBCJA10GH100
Approved by Designer	Grga Kolić	01.10.2026.							+ UBCJA10
Checked by	Antonio Aleksić	01.10.2026.					Designer No.:	SALES No.:	PAGE 141
Drawn by	Tamara Trogrlić	01.10.2026.							PAGE 141 / 157

	Cable name : -02-2NA01+NA01-2204		Number of conductors : 3		Description :			
	Cable type : NYY-J		Number of used conductors : 2					
			Cable cross section : 4					
	External Connections			Connection color/number	Internal Connections			
To device		Pin designation	Page/column		From device		Pin designation	Page/column
=2NA01+NA01-X4		9	=UBCJA10GH100+UBCJA10/6.2:F		=UBCJA10GH100+UBCJA10-X10		3:A	=UBCJA10GH100+UBCJA10/6.2:E
=2NA01+NA01-X4		10	=UBCJA10GH100+UBCJA10/6.2:F		=UBCJA10GH100+UBCJA10-X10		4:A	=UBCJA10GH100+UBCJA10/6.2:E
					GNYE			

	Cable name :	-02-2NA01+NA01-4301	Number of conductors :		8	Description :
	Cable type :	NYCY	Number of used conductors :		4	
			Cable cross section :		2.5	
External Connections			Connection color/number	Internal Connections		
To device	Pin designation	Page/column		From device	Pin designation	Page/column
=2NA01+NA01-X11	1	=UBCJA10GH100+UBCJA10/20.3:B	1	=UBCJA10GH100+UBCJA10-X137	2:A	=UBCJA10GH100+UBCJA10/20.3:B
=2NA01+NA01-X11	2	=UBCJA10GH100+UBCJA10/20.3:C	2	=UBCJA10GH100+UBCJA10-1K11	A1	=UBCJA10GH100+UBCJA10/20.3:D
=2NA01+NA01-X11	7	=UBCJA10GH100+UBCJA10/21.5:B	3	=UBCJA10GH100+UBCJA10-X137	5:A	=UBCJA10GH100+UBCJA10/21.5:B
=2NA01+NA01-X11	43	=UBCJA10GH100+UBCJA10/21.5:C	4	=UBCJA10GH100+UBCJA10-1K25	A1	=UBCJA10GH100+UBCJA10/21.5:D

	Cable name :	-02-2NA01+NA01-4303	Number of conductors :		19	Description :		
	Cable type :	NYCY	Number of used conductors :		8			
			Cable cross section :		2.5			
External Connections				Internal Connections				
To device		Pin designation	Page/column	Connection color/number	From device		Pin designation	Page/column
=2NA01+NA01-X11		10	=UBCJA10GH100+UBCJA10/21.4:B	11	=UBCJA10GH100+UBCJA10-X137		4:A	=UBCJA10GH100+UBCJA10/21.4:B
=2NA01+NA01-X11		12	=UBCJA10GH100+UBCJA10/21.4:C	12	=UBCJA10GH100+UBCJA10-1K24		A1	=UBCJA10GH100+UBCJA10/21.4:D
=2NA01+NA01-X11		16	=UBCJA10GH100+UBCJA10/20.4:C	13	=UBCJA10GH100+UBCJA10-1K12		A1	=UBCJA10GH100+UBCJA10/20.4:D
=2NA01+NA01-X11		24	=UBCJA10GH100+UBCJA10/20.6:C	14	=UBCJA10GH100+UBCJA10-1K14		A1	=UBCJA10GH100+UBCJA10/20.6:D
=2NA01+NA01-X11		32	=UBCJA10GH100+UBCJA10/20.8:C	15	=UBCJA10GH100+UBCJA10-1K16		A1	=UBCJA10GH100+UBCJA10/20.8:D
=2NA01+NA01-X11		36	=UBCJA10GH100+UBCJA10/21.1:C	16	=UBCJA10GH100+UBCJA10-1K21		A1	=UBCJA10GH100+UBCJA10/21.1:D
=2NA01+NA01-X11		40	=UBCJA10GH100+UBCJA10/21.2:C	17	=UBCJA10GH100+UBCJA10-1K22		A1	=UBCJA10GH100+UBCJA10/21.2:D
=2NA01+NA01-X11		44	=UBCJA10GH100+UBCJA10/21.3:C	18	=UBCJA10GH100+UBCJA10-1K23		A1	=UBCJA10GH100+UBCJA10/21.3:D

	Cable name : -02-2NA01+NA01-4304		Number of conductors : 8		Description :	
	Cable type : NYCY		Number of used conductors : 6			
			Cable cross section : 2.5			
	External Connections			Connection color/number	Internal Connections	
To device	Pin designation	Page/column	From device		Pin designation	Page/column
=2NA01+NA01-X5	1	=UBCJA10GH100+UBCJA10/21.6:B	1	=UBCJA10GH100+UBCJA10-X137	6:A	=UBCJA10GH100+UBCJA10/21.6:B
=2NA01+NA01-X5	2	=UBCJA10GH100+UBCJA10/21.6:C	2	=UBCJA10GH100+UBCJA10-1K26	A1	=UBCJA10GH100+UBCJA10/21.6:D
=2NA01+NA01-X5	7	=UBCJA10GH100+UBCJA10/21.7:B	3	=UBCJA10GH100+UBCJA10-X137	7:A	=UBCJA10GH100+UBCJA10/21.7:B
=2NA01+NA01-X5	9	=UBCJA10GH100+UBCJA10/21.7:C	4	=UBCJA10GH100+UBCJA10-1K27	A1	=UBCJA10GH100+UBCJA10/21.7:D
=2NA01+NA01-X5	10	=UBCJA10GH100+UBCJA10/21.8:B	5	=UBCJA10GH100+UBCJA10-X137	8:A	=UBCJA10GH100+UBCJA10/21.8:B
=2NA01+NA01-X5	11	=UBCJA10GH100+UBCJA10/21.8:C	6	=UBCJA10GH100+UBCJA10-1K28	A1	=UBCJA10GH100+UBCJA10/21.8:D

A

A

	Cable name : -02-2NA01+NA01-4305		Number of conductors : 8		Description :		
	Cable type : NYCY		Number of used conductors : 4				
			Cable cross section : 2.5				
	External Connections			Connection color/number	Internal Connections		
To device	Pin designation	Page/column	From device		Pin designation	Page/column	
=2NA01+NA01-X5	16	=UBCJA10GH100+UBCJA10/22.1:B	1		=UBCJA10GH100+UBCJA10-X137	9:A	=UBCJA10GH100+UBCJA10/22.1:B
=2NA01+NA01-X5	18	=UBCJA10GH100+UBCJA10/22.1:C	2		=UBCJA10GH100+UBCJA10-1K31	A1	=UBCJA10GH100+UBCJA10/22.1:D
=2NA01+NA01-X5	19	=UBCJA10GH100+UBCJA10/23.5:B	3		=UBCJA10GH100+UBCJA10-X137	13:A	=UBCJA10GH100+UBCJA10/23.5:B
=2NA01+NA01-X5	61	=UBCJA10GH100+UBCJA10/23.5:C	4		=UBCJA10GH100+UBCJA10-1K45	A1	=UBCJA10GH100+UBCJA10/23.5:D

B

B

	Cable name : -02-2NA01+NA01-4309		Number of conductors :	16	Description :		
	Cable type : NYCY		Number of used conductors :	15			
			Cable cross section :	2.5			
	External Connections			Connection color/number	Internal Connections		
To device	Pin designation	Page/column	From device		Pin designation	Page/column	
=2NA01+NA01-X5	20	=UBCJA10GH100+UBCJA10/22.2:B	1BK	=UBCJA10GH100+UBCJA10-X137	10:A	=UBCJA10GH100+UBCJA10/22.2:B	
=2NA01+NA01-X5	22	=UBCJA10GH100+UBCJA10/22.2:C	2BK	=UBCJA10GH100+UBCJA10-1K32	A1	=UBCJA10GH100+UBCJA10/22.2:D	
=2NA01+NA01-X5	46	=UBCJA10GH100+UBCJA10/22.3:C	3BK	=UBCJA10GH100+UBCJA10-1K33	A1	=UBCJA10GH100+UBCJA10/22.3:D	
=2NA01+NA01-X5	26	=UBCJA10GH100+UBCJA10/22.4:C	4BK	=UBCJA10GH100+UBCJA10-1K34	A1	=UBCJA10GH100+UBCJA10/22.4:D	
=2NA01+NA01-X5	50	=UBCJA10GH100+UBCJA10/22.5:C	5BK	=UBCJA10GH100+UBCJA10-1K35	A1	=UBCJA10GH100+UBCJA10/22.5:D	
=2NA01+NA01-X5	30	=UBCJA10GH100+UBCJA10/22.6:C	6BK	=UBCJA10GH100+UBCJA10-1K36	A1	=UBCJA10GH100+UBCJA10/22.6:D	
=2NA01+NA01-X5	54	=UBCJA10GH100+UBCJA10/22.7:C	7BK	=UBCJA10GH100+UBCJA10-1K37	A1	=UBCJA10GH100+UBCJA10/22.7:D	
=2NA01+NA01-X5	34	=UBCJA10GH100+UBCJA10/22.8:C	8BK	=UBCJA10GH100+UBCJA10-1K38	A1	=UBCJA10GH100+UBCJA10/22.8:D	
=2NA01+NA01-X5	58	=UBCJA10GH100+UBCJA10/23.1:C	9BK	=UBCJA10GH100+UBCJA10-1K41	A1	=UBCJA10GH100+UBCJA10/23.1:D	
=2NA01+NA01-X5	38	=UBCJA10GH100+UBCJA10/23.2:C	10BK	=UBCJA10GH100+UBCJA10-1K42	A1	=UBCJA10GH100+UBCJA10/23.2:D	
=2NA01+NA01-X5	62	=UBCJA10GH100+UBCJA10/23.3:C	11BK	=UBCJA10GH100+UBCJA10-1K43	A1	=UBCJA10GH100+UBCJA10/23.3:D	
=2NA01+NA01-X5	42	=UBCJA10GH100+UBCJA10/23.4:C	12BK	=UBCJA10GH100+UBCJA10-1K44	A1	=UBCJA10GH100+UBCJA10/23.4:D	
=2NA01+NA01-X5.1	1	=UBCJA10GH100+UBCJA10/24.5:B	13BK	=UBCJA10GH100+UBCJA10-X137	18:A	=UBCJA10GH100+UBCJA10/24.5:B	
=2NA01+NA01-X5.1	2	=UBCJA10GH100+UBCJA10/24.5:C	14BK	=UBCJA10GH100+UBCJA10-1K55	A1	=UBCJA10GH100+UBCJA10/24.5:D	
=2NA01+NA01-X5.1	3	=UBCJA10GH100+UBCJA10/24.6:C	15BK	=UBCJA10GH100+UBCJA10-1K56	A1	=UBCJA10GH100+UBCJA10/24.6:D	

C

C

D

D

	Cable name : -02-2NA01+NA01-4310		Number of conductors : 2	Description :		
	Cable type : NYCY		Number of used conductors : 2			
			Cable cross section : 2.5			
External Connections			Connection color/number	Internal Connections		
To device	Pin designation	Page/column		From device	Pin designation	Page/column
=2NA01+NA01-X8	1	=UBCJA10GH100+UBCJA10/23.6:B		=UBCJA10GH100+UBCJA10-X137	14:A	=UBCJA10GH100+UBCJA10/23.6:B
=2NA01+NA01-X8	3	=UBCJA10GH100+UBCJA10/23.6:C		=UBCJA10GH100+UBCJA10-1K46	A1	=UBCJA10GH100+UBCJA10/23.6:D

E

E

F

F

Approved by Contractor			Reconstruction and Modernisation of HPP Perucica - Phase II			Unit KA2 control cubicle circuit diagrams	DRAWING No.:	REV No.:	= UBCJA10GH100
Approved by Designer	Grga Kolić	01.10.2026.			Sintaksa - A Voith Company Ulica Domovinskog rata 104C, 21 000 Split, Hrvatska		PERU-01-19-170-31-002	+ UBCJA10	
Checked by	Antonio Aleksić	01.10.2026.			CABLE DIAGRAM		Designer No.:	SALES No.:	PAGE 142
Drawn by	Tamara Trogrlić	01.10.2026.	PROJECT NAME	EMPLOYER	DESIGNER				PAGE 142 / 157

1

2

3

4

5

6

7

8

Cable name :

-02-2NA01+NA01-4312

Cable type :

NYCY

Number of conductors :

19

Number of used conductors :

8

Cable cross section :

2.5

Description :

External Connections

To device

Pin designation

Page/column

Connection color/number

=2NA01+NA01-X8

8

=UBCJA10GH100+UBCJA10/23.7:B

7

=2NA01+NA01-X8

10

=UBCJA10GH100+UBCJA10/23.7:C

8

=2NA01+NA01-X8

14

=UBCJA10GH100+UBCJA10/23.8:C

9

=2NA01+NA01-X8

18

=UBCJA10GH100+UBCJA10/24.1:C

10

=2NA01+NA01-X8

22

=UBCJA10GH100+UBCJA10/24.2:C

11

=2NA01+NA01-X8

26

=UBCJA10GH100+UBCJA10/24.3:C

12

=2NA01+NA01-X8

7

=UBCJA10GH100+UBCJA10/24.4:B

13

=2NA01+NA01-X8

25

=UBCJA10GH100+UBCJA10/24.4:C

14

Internal Connections

From device

Pin designation

Page/column

=UBCJA10GH100+UBCJA10-X137

15:A

=UBCJA10GH100+UBCJA10/23.7:B

=UBCJA10GH100+UBCJA10-1K47

A1

=UBCJA10GH100+UBCJA10/23.7:D

=UBCJA10GH100+UBCJA10-1K48

A1

=UBCJA10GH100+UBCJA10/23.8:D

=UBCJA10GH100+UBCJA10-1K51

A1

=UBCJA10GH100+UBCJA10/24.1:D

=UBCJA10GH100+UBCJA10-1K52

A1

=UBCJA10GH100+UBCJA10/24.2:D

=UBCJA10GH100+UBCJA10-1K53

A1

=UBCJA10GH100+UBCJA10/24.3:D

=UBCJA10GH100+UBCJA10-X137

17:A

=UBCJA10GH100+UBCJA10/24.4:B

=UBCJA10GH100+UBCJA10-1K54

A1

=UBCJA10GH100+UBCJA10/24.4:D

Cable name :

-02-2UA01+EA01-7-403

Cable type :

NYCY

Number of conductors :

4

Number of used conductors :

4

Cable cross section :

2.5

Description :

External Connections

To device

Pin designation

Page/column

Connection color/number

=UBMKC10GH100+UBMKC11-X80

26

=UBCJA10GH100+UBCJA10/28.3:C

BK

=UBMKC10GH100+UBMKC11-X80

23

=UBCJA10GH100+UBCJA10/28.4:B

BN

=UBMKC10GH100+UBMKC11-X80

24

=UBCJA10GH100+UBCJA10/28.4:C

BU

=UBMKC10GH100+UBMKC11-X80

25

=UBCJA10GH100+UBCJA10/28.3:B

GY

Internal Connections

From device

Pin designation

Page/column

=UBCJA10GH100+UBCJA10-1K93

A1

=UBCJA10GH100+UBCJA10/28.3:D

=UBCJA10GH100+UBCJA10-X138

14:A

=UBCJA10GH100+UBCJA10/28.4:B

=UBCJA10GH100+UBCJA10-1K94

A1

=UBCJA10GH100+UBCJA10/28.4:D

=UBCJA10GH100+UBCJA10-X138

13:A

=UBCJA10GH100+UBCJA10/28.3:B

Cable name :

-02-2UA01+EA01-7-404

Cable type :

NYCY

Number of conductors :

8

Number of used conductors :

6

Cable cross section :

2.5

Description :

External Connections

To device

Pin designation

Page/column

Connection color/number

=UBMKC10GH100+UBMKC11-X80

40

=UBCJA10GH100+UBCJA10/28.5:B

1BK

=UBMKC10GH100+UBMKC11-X80

41

=UBCJA10GH100+UBCJA10/28.5:C

2BK

=UBMKC10GH100+UBMKC11-X80

42

=UBCJA10GH100+UBCJA10/28.6:B

3BK

=UBMKC10GH100+UBMKC11-X80

44

=UBCJA10GH100+UBCJA10/28.6:C

4BK

=UBMKC10GH100+UBMKC11-X80

43

=UBCJA10GH100+UBCJA10/28.7:B

5BK

=UBMKC10GH100+UBMKC11-X80

45

=UBCJA10GH100+UBCJA10/28.7:C

6BK

Internal Connections

From device

Pin designation

Page/column

=UBCJA10GH100+UBCJA10-X138

15:A

=UBCJA10GH100+UBCJA10/28.5:B

=UBCJA10GH100+UBCJA10-1K95

A1

=UBCJA10GH100+UBCJA10/28.5:D

=UBCJA10GH100+UBCJA10-X138

16:A

=UBCJA10GH100+UBCJA10/28.6:B

=UBCJA10GH100+UBCJA10-1K96

A1

=UBCJA10GH100+UBCJA10/28.6:D

=UBCJA10GH100+UBCJA10-X138

17:A

=UBCJA10GH100+UBCJA10/28.7:B

=UBCJA10GH100+UBCJA10-1K97

A1

=UBCJA10GH100+UBCJA10/28.7:D

Cable name :

-02-2UA01+EA01-3203

Cable type :

NYCY

Number of conductors :

4

Number of used conductors :

4

Cable cross section :

4

Description :

External Connections

To device

Pin designation

Page/column

Connection color/number

=UBMKC10GH100+UBMKC11-X0

8

=UBCJA10GH100+UBCJA10/73.5:B

BU

=UBMKC10GH100+UBMKC11-X0

6

=UBCJA10GH100+UBCJA10/73.3:B

BN

=UBMKC10GH100+UBMKC11-X0

5

=UBCJA10GH100+UBCJA10/73.3:B

BK

=UBMKC10GH100+UBMKC11-X0

7

=UBCJA10GH100+UBCJA10/73.4:B

GY

Internal Connections

From device

Pin designation

Page/column

=UBCJA10GH100+UBCJA10-XT1

6:A

=UBCJA10GH100+UBCJA10/73.5:D

=UBCJA10GH100+UBCJA10-XT1

2:A

=UBCJA10GH100+UBCJA10/73.3:D

=UBCJA10GH100+UBCJA10-XT1

1:A

=UBCJA10GH100+UBCJA10/73.3:D

=UBCJA10GH100+UBCJA10-XT1

3:A

=UBCJA10GH100+UBCJA10/73.4:D

Approved by Contractor

Approved by Designer

Checked by

Drawn by

Grga Kolić

Antonio Aleksić

Tamara Trogrlić

01.10.2026.

01.10.2026.

01.10.2026.

Reconstruction and Modernisation of HPP Perucica - Phase II

PROJECT NAME



EMPLOYER



SINTAKSA
A Voith Company

Sintaksa - A Voith Company

Ulica Domovinskog rata 104C, 21 000 Split, Hrvatska

DESIGNER

Unit KA2 control cubicle circuit diagrams

CABLE DIAGRAM

DRAWING No.:
PERU-01-19-170-31-002

Designer No.:

REV No.:

SALES No.:

= UBCJA10GH100

+ UBCJA10

PAGE 143

PAGE 143 / 157

1

2

3

4

5

6

7

8

CONFIDENTIAL, ALL RIGHTS RESERVED DIN 34

Format ISO/DIN A3

	Cable name : -02-2UA01+EA01-7402		Number of conductors : 19		Description :			
	Cable type : NYCY		Number of used conductors : 2					
			Cable cross section : 2.5					
External Connections			Connection color/number	Internal Connections				
To device		Pin designation		Page/column	From device		Pin designation	Page/column
=UBMKC10GH100+UBMKC11-X80		60	=UBCJA10GH100+UBCJA10/28.8:B	9	=UBCJA10GH100+UBCJA10-X138		18:A	=UBCJA10GH100+UBCJA10/28.8:B
=UBMKC10GH100+UBMKC11-K1		14	=UBCJA10GH100+UBCJA10/28.8:C	10	=UBCJA10GH100+UBCJA10-1K98		A1	=UBCJA10GH100+UBCJA10/28.8:D

	Cable name : -02-2UA01+NE09-3-607		Number of conductors : 8		Description :			
	Cable type : NYCY		Number of used conductors : 4					
			Cable cross section : 2.5					
	External Connections			Connection color/number	Internal Connections			
To device		Pin designation	Page/column		From device		Pin designation	Page/column
=NE09+NE09-X2		74	=UBCJA10GH100+UBCJA10/76.4:B	1	=UBCJA10GH100+UBCJA10-XT3		11:A	=UBCJA10GH100+UBCJA10/76.4:B
=NE09+NE09-X2		71	=UBCJA10GH100+UBCJA10/76.2:B	2	=UBCJA10GH100+UBCJA10-XT3		1:A	=UBCJA10GH100+UBCJA10/76.2:B
=NE09+NE09-X2		72	=UBCJA10GH100+UBCJA10/76.3:B	3	=UBCJA10GH100+UBCJA10-XT3		5:A	=UBCJA10GH100+UBCJA10/76.3:B
=NE09+NE09-X2		73	=UBCJA10GH100+UBCJA10/76.4:B	4	=UBCJA10GH100+UBCJA10-XT3		9:A	=UBCJA10GH100+UBCJA10/76.4:B

	Cable name : -02-2UA01+NE10-3-601		Number of conductors : 8		Description :			
	Cable type : NYCY		Number of used conductors : 4					
			Cable cross section : 2.5					
	External Connections			Connection color/number	Internal Connections			
To device		Pin designation	Page/column		From device		Pin designation	Page/column
=NE10+NE10-X2		17	=UBCJA10GH100+UBCJA10/74.5:B	1	=UBCJA10GH100+UBCJA10-XT2		16:A	=UBCJA10GH100+UBCJA10/74.5:B
=NE10+NE10-X2		10	=UBCJA10GH100+UBCJA10/74.2:B	2	=UBCJA10GH100+UBCJA10-XT2		1:A	=UBCJA10GH100+UBCJA10/74.2:B
=NE10+NE10-X2		13	=UBCJA10GH100+UBCJA10/74.3:B	3	=UBCJA10GH100+UBCJA10-XT2		7:A	=UBCJA10GH100+UBCJA10/74.3:B
=NE10+NE10-X2		15	=UBCJA10GH100+UBCJA10/74.4:B	4	=UBCJA10GH100+UBCJA10-XT2		12:A	=UBCJA10GH100+UBCJA10/74.4:B

	Cable name : -02-2UA01+NE10-4-101		Number of conductors : 16		Description :	
	Cable type : NYCY		Number of used conductors : 10			
			Cable cross section : 2.5			
	External Connections			Connection color/number	Internal Connections	
To device	Pin designation	Page/column	From device		Pin designation	Page/column
=NE10+NE10-X1	41	=UBCJA10GH100+UBCJA10/24.8:C	1BK	=UBCJA10GH100+UBCJA10-1K58	A1	=UBCJA10GH100+UBCJA10/24.8:D
=NE10+NE10-X1	31	=UBCJA10GH100+UBCJA10/24.8:B	2BK	=UBCJA10GH100+UBCJA10-X14	2:A	=UBCJA10GH100+UBCJA10/24.8:B
=NE10+NE10-X1	42	=UBCJA10GH100+UBCJA10/25.1:C	3BK	=UBCJA10GH100+UBCJA10-1K61	A1	=UBCJA10GH100+UBCJA10/25.1:D
=NE10+NE10-X2	20	=UBCJA10GH100+UBCJA10/25.6:B	4BK	=UBCJA10GH100+UBCJA10-X14	6:A	=UBCJA10GH100+UBCJA10/25.6:B
=NE10+NE10-X1	46	=UBCJA10GH100+UBCJA10/25.2:C	5BK	=UBCJA10GH100+UBCJA10-1K62	A1	=UBCJA10GH100+UBCJA10/25.2:D
=NE10+NE10-X1	33	=UBCJA10GH100+UBCJA10/25.2:B	6BK	=UBCJA10GH100+UBCJA10-X14	3:A	=UBCJA10GH100+UBCJA10/25.2:B
=NE10+NE10-X1	48	=UBCJA10GH100+UBCJA10/25.3:C	7BK	=UBCJA10GH100+UBCJA10-1K63	A1	=UBCJA10GH100+UBCJA10/25.3:D
=NE10+NE10-X1	34	=UBCJA10GH100+UBCJA10/25.3:B	8BK	=UBCJA10GH100+UBCJA10-X14	4:A	=UBCJA10GH100+UBCJA10/25.3:B
=NE10+NE10-X2	37	=UBCJA10GH100+UBCJA10/25.6:C	9BK	=UBCJA10GH100+UBCJA10-1K66	A1	=UBCJA10GH100+UBCJA10/25.6:D
=NE10+NE10-X2	38	=UBCJA10GH100+UBCJA10/25.7:C	10BK	=UBCJA10GH100+UBCJA10-1K67	A1	=UBCJA10GH100+UBCJA10/25.7:D

Approved by Contractor			Reconstruction and Modernisation of HPP Perucica - Phase II		 A Voith Company	Unit KA2 control cubicle circuit diagrams	DRAWING No.:	REV No.:	= UBCJA10GH100
Approved by Designer	Grga Kolić	01.10.2026.					PERU-01-19-170-31-002		+ UBCJA10
Checked by	Antonio Aleksić	01.10.2026.					Designer No.:	SALES No.:	PAGE 144
Drawn by	Tamara Trogrlić	01.10.2026.					CABLE DIAGRAM		PAGE 144 / 157

CONFIDENTIAL, ALL RIGHTS RESERVED DIN 34

Format ISO/DIN A3

144

146

Approved by Contractor			Reconstruction and Modernisation of HPP Perucica - Phase II		 A Voith Company Sintaksa - A Voith Company Ulica Domovinskog rata 104C, 21 000 Split, Hrvatska	Unit KA2 control cubicle circuit diagrams CABLE DIAGRAM	DRAWING No.: PERU-01-19-170-31-002	REV No.:	= UBCJA10GH100
Approved by Designer	Grga Kolić	01.10.2026.							+ UBCJA10
Checked by	Antonio Aleksić	01.10.2026.					Designer No.:	SALES No.:	PAGE 145
Drawn by	Tamara Trogrlić	01.10.2026.							PAGE 145 / 157

	Cable name :	-02-2UA01+NE11-4-113	Number of conductors :	7	Description :
			Number of used conductors :	3	
	Cable type :	NYCY	Cable cross section :	2.5	

External Connections			Connection color/number	Internal Connections		
To device	Pin designation	Page/column		From device	Pin designation	Page/column
=NE11+NE11-X2	53	=UBCJA10GH100+UBCJA10/25.8:B	1BK	=UBCJA10GH100+UBCJA10-X14	7:A	=UBCJA10GH100+UBCJA10/25.8:B
=NE11+NE11-X2	54	=UBCJA10GH100+UBCJA10/26.1:C	2BK	=UBCJA10GH100+UBCJA10-1K71	A1	=UBCJA10GH100+UBCJA10/26.1:D
=NE11+NE11-X2	55	=UBCJA10GH100+UBCJA10/25.8:C	3BK	=UBCJA10GH100+UBCJA10-1K68	A1	=UBCJA10GH100+UBCJA10/25.8:D

	Cable name :	-02-2UA01+NE12-3-604	Number of conductors :	8	Description :
			Number of used conductors :	2	
	Cable type :	NYCY	Cable cross section :	2.5	

External Connections			Connection color/number	Internal Connections		
To device	Pin designation	Page/column		From device	Pin designation	Page/column
=NE12+NE12-X1	10	=UBCJA10GH100+UBCJA10/77.2:B	2	=UBCJA10GH100+UBCJA10-XT4	1:A	=UBCJA10GH100+UBCJA10/77.2:B
=NE12+NE12-X1	14	=UBCJA10GH100+UBCJA10/77.3:B	3	=UBCJA10GH100+UBCJA10-XT4	4:A	=UBCJA10GH100+UBCJA10/77.3:B

	Cable name :	-02-2UA01+NE12-4-108	Number of conductors :	7	Description :
			Number of used conductors :	3	
	Cable type :	NYCY	Cable cross section :	2.5	

External Connections			Connection color/number	Internal Connections		
To device	Pin designation	Page/column		From device	Pin designation	Page/column
=NE12+NE12-X2	41	=UBCJA10GH100+UBCJA10/25.4:C	1BK	=UBCJA10GH100+UBCJA10-1K64	A1	=UBCJA10GH100+UBCJA10/25.4:D
=NE12+NE12-X2	42	=UBCJA10GH100+UBCJA10/25.5:C	3BK	=UBCJA10GH100+UBCJA10-1K65	A1	=UBCJA10GH100+UBCJA10/25.5:D
=NE12+NE12-X2	31	=UBCJA10GH100+UBCJA10/25.4:B	4	=UBCJA10GH100+UBCJA10-X14	5:A	=UBCJA10GH100+UBCJA10/25.4:B

	Cable name :	-02-2UA01+UN03-4-017	Number of conductors :	10	Description :
			Number of used conductors :	2	
	Cable type :	NYCY	Cable cross section :	1.5	

External Connections			Connection color/number	Internal Connections		
To device	Pin designation	Page/column		From device	Pin designation	Page/column
			1			
			2			
			3			
=UBCHA10GH100+UBCHA10-X141	6	=UBCJA10GH100+UBCJA10/66.3:E	4	=UBCJA10GH100+UBCJA10-X73	3:A	=UBCJA10GH100+UBCJA10/66.3:D
			5			
			6			
			7			
=UBCHA10GH100+UBCHA10-X141	15	=UBCJA10GH100+UBCJA10/66.4:E	8	=UBCJA10GH100+UBCJA10-X73	4:A	=UBCJA10GH100+UBCJA10/66.4:D
			9			
			10			

1		2		3		4		5		6		7		8	
	Cable name : -02-2UA01+UN03-4-018			Number of conductors : 4			Description :								
	Cable type : NYCY			Number of used conductors : 2											
				Cable cross section : 2.5											
External Connections						Connection color/number		Internal Connections							
To device		Pin designation		Page/column				From device		Pin designation		Page/column			
=UBCHA10GH100+UBCHA10-X141		26		=UBCJA10GH100+UBCJA10/66.8:E		BU		=UBCJA10GH100+UBCJA10-X73		8:A		=UBCJA10GH100+UBCJA10/66.8:D			
						BN									
=UBCHA10GH100+UBCHA10-X141		20		=UBCJA10GH100+UBCJA10/66.7:E		BK		=UBCJA10GH100+UBCJA10-X73		7:A		=UBCJA10GH100+UBCJA10/66.7:D			
						GY									
	Cable name : -02-2UA01+UN06-3-701			Number of conductors : 4			Description :								
	Cable type : NYCY			Number of used conductors : 4											
				Cable cross section : 2.5											
External Connections						Connection color/number		Internal Connections							
To device		Pin designation		Page/column				From device		Pin designation		Page/column			
=UBMKC10GH100+UBMKC11-X0		?		=UBCJA10GH100+UBCJA10/75.4:E		BU		=UBCJA10GH100+UBCJA10-XT2		17:B		=UBCJA10GH100+UBCJA10/74.5:B			
=UBMKC10GH100+UBMKC11-X0		10		=UBCJA10GH100+UBCJA10/75.3:E		BN		=UBCJA10GH100+UBCJA10-XT2		3:B		=UBCJA10GH100+UBCJA10/74.2:B			
=UBMKC10GH100+UBMKC11-X0		11		=UBCJA10GH100+UBCJA10/75.3:E		BK		=UBCJA10GH100+UBCJA10-XT2		8:B		=UBCJA10GH100+UBCJA10/74.3:B			
=UBMKC10GH100+UBMKC11-X0		12		=UBCJA10GH100+UBCJA10/75.3:E		GY		=UBCJA10GH100+UBCJA10-XT2		13:B		=UBCJA10GH100+UBCJA10/74.4:B			
	Cable name : -02-2UA01+UN06-4-014			Number of conductors : 10			Description :								
	Cable type : NYCY			Number of used conductors : 4											
				Cable cross section : 1.5											
External Connections						Connection color/number		Internal Connections							
To device		Pin designation		Page/column				From device		Pin designation		Page/column			
=UBCHA10GH100+UBCHA10-X161		32		=UBCJA10GH100+UBCJA10/27.5:C		1		=UBCJA10GH100+UBCJA10-1K85		A1		=UBCJA10GH100+UBCJA10/27.5:D			
=UBCHA10GH100+UBCHA10-X161		33		=UBCJA10GH100+UBCJA10/26.5:C		2		=UBCJA10GH100+UBCJA10-1K75		A1		=UBCJA10GH100+UBCJA10/26.5:D			
						3									
						4									
						5									
						6									
=UBCHA10GH100+UBCHA10-X161		39		=UBCJA10GH100+UBCJA10/27.5:B		7		=UBCJA10GH100+UBCJA10-X138		10:A		=UBCJA10GH100+UBCJA10/27.5:B			
=UBCHA10GH100+UBCHA10-X161		40		=UBCJA10GH100+UBCJA10/26.5:B		8		=UBCJA10GH100+UBCJA10-X138		2:A		=UBCJA10GH100+UBCJA10/26.5:B			
						9									
						10									
	Cable name : -02-2UA01+UN06-4-106			Number of conductors : 10			Description :								
	Cable type : NYCY			Number of used conductors : 8											
				Cable cross section : 2.5											
External Connections						Connection color/number		Internal Connections							
To device		Pin designation		Page/column				From device		Pin designation		Page/column			
=NE10+NE10-X1		60		=UBCJA10GH100+UBCJA10/54.3:D		1BK		=UBCJA10GH100+UBCJA10-X71		7:A		=UBCJA10GH100+UBCJA10/54.3:E			
=NE10+NE10-X1		3		=UBCJA10GH100+UBCJA10/54.3:D		2BK		=UBCJA10GH100+UBCJA10-X71		8:A		=UBCJA10GH100+UBCJA10/54.3:E			
=NE10+NE10-X1		14		=UBCJA10GH100+UBCJA10/54.2:C		3BK		=UBCJA10GH100+UBCJA10-X71		1:A		=UBCJA10GH100+UBCJA10/54.2:C			
=NE10+NE10-X1		9		=UBCJA10GH100+UBCJA10/54.3:C		4BK		=UBCJA10GH100+UBCJA10-X71		5:A		=UBCJA10GH100+UBCJA10/54.3:C			
=NE10+NE10-X1		7		=UBCJA10GH100+UBCJA10/54.2:C		5BK		=UBCJA10GH100+UBCJA10-X71		3:A		=UBCJA10GH100+UBCJA10/54.2:C			

CONFIDENTIAL, ALL RIGHTS RESERVED DIN 34

Format ISO/DIN A3

146

148

Approved by Contractor			Reconstruction and Modernisation of HPP Perucica - Phase II		 A Voith Company Sintaksa - A Voith Company Ulica Domovinskog rata 104C, 21 000 Split, Hrvatska	Unit KA2 control cubicle circuit diagrams CABLE DIAGRAM	DRAWING No.: PERU-01-19-170-31-002	REV No.:	= UBCJA10GH100
Approved by Designer	Grga Kolić	01.10.2026.							+ UBCJA10
Checked by	Antonio Aleksić	01.10.2026.					Designer No.:	SALES No.:	PAGE 147
Drawn by	Tamara Trogrlić	01.10.2026.							PAGE 147 / 157

	Cable name : -02-2UA01+UN06-4-106		Number of conductors : 10		Description :	
	Cable type : NYCY		Number of used conductors : 8			
			Cable cross section : 2.5			
	External Connections			Connection color/number	Internal Connections	
To device	Pin designation	Page/column	From device		Pin designation	Page/column
=NE10+NE10-X1	1	=UBCJA10GH100+UBCJA10/54.4:C	6BK	=UBCJA10GH100+UBCJA10-X71	13:A	=UBCJA10GH100+UBCJA10/54.4:C
=NE10+NE10-X1	11	=UBCJA10GH100+UBCJA10/54.2:D	7BK	=UBCJA10GH100+UBCJA10-X71	2:A	=UBCJA10GH100+UBCJA10/54.2:E
=NE10+NE10-X1	60	=UBCJA10GH100+UBCJA10/54.2:D	8BK	=UBCJA10GH100+UBCJA10-X71	4:A	=UBCJA10GH100+UBCJA10/54.2:E

	Cable name : -02-2UA01+UN06-4-112		Number of conductors : 5		Description :			
	Cable type : NYCY		Number of used conductors : 4					
			Cable cross section : 2.5					
	External Connections			Connection color/number	Internal Connections			
To device		Pin designation	Page/column		From device		Pin designation	Page/column
=UN5+UN5-X2		24	=UBCJA10GH100+UBCJA10/54.6:C	1	=UBCJA10GH100+UBCJA10-X71		9:A	=UBCJA10GH100+UBCJA10/54.6:C
=UN5+UN5-X2		30	=UBCJA10GH100+UBCJA10/54.6:C	2	=UBCJA10GH100+UBCJA10-X71		11:A	=UBCJA10GH100+UBCJA10/54.6:C
=UN5+UN5-X2		33	=UBCJA10GH100+UBCJA10/54.6:D	3	=UBCJA10GH100+UBCJA10-X71		10:A	=UBCJA10GH100+UBCJA10/54.6:E
=UN5+UN5-X2		118	=UBCJA10GH100+UBCJA10/54.6:D	4	=UBCJA10GH100+UBCJA10-X71		12:A	=UBCJA10GH100+UBCJA10/54.6:E

	Cable name :	-02-2UA01+UN06-7-106	Number of conductors :		7	Description :
	Cable type :	NYCY	Number of used conductors :		5	
			Cable cross section :		2.5	
External Connections			Connection color/number	Internal Connections		
To device	Pin designation	Page/column		From device	Pin designation	Page/column
=0UA01+UV01-X10	17	=UBCJA10GH100+UBCJA10/67.2:E	1BK	=UBCJA10GH100+UBCJA10-X139	14:A	=UBCJA10GH100+UBCJA10/67.2:A
=0UA01+UV01-X10	21	=UBCJA10GH100+UBCJA10/67.2:E	2BK	=UBCJA10GH100+UBCJA10-X139	16:A	=UBCJA10GH100+UBCJA10/67.2:D
=0UA01+UV01-X10	24	=UBCJA10GH100+UBCJA10/67.3:E	3BK	=UBCJA10GH100+UBCJA10-X139	17:A	=UBCJA10GH100+UBCJA10/67.3:D
=0UA01+UV01-X10	27	=UBCJA10GH100+UBCJA10/67.4:E	4BK	=UBCJA10GH100+UBCJA10-X139	18:A	=UBCJA10GH100+UBCJA10/67.4:D
=0UA01+UV01-X10	30	=UBCJA10GH100+UBCJA10/67.5:E	5BK	=UBCJA10GH100+UBCJA10-X139	19:A	=UBCJA10GH100+UBCJA10/67.5:D

	Cable name : -02-2UA01+UN06-7401		Number of conductors : 19		Description :	
	Cable type : NYCY		Number of used conductors : 8			
			Cable cross section : 2.5			
	External Connections			Connection color/number	Internal Connections	
To device	Pin designation	Page/column	From device		Pin designation	Page/column
=UBMKC10GH100+UBMKC11-X80	61	=UBCJA10GH100+UBCJA10/65.1:E	1BK	=UBCJA10GH100+UBCJA10-X72	7:A	=UBCJA10GH100+UBCJA10/65.1:D
=UBMKC10GH100+UBMKC11-K701		=UBCJA10GH100+UBCJA10/65.3:E	2BK	=UBCJA10GH100+UBCJA10-X72	9:A	=UBCJA10GH100+UBCJA10/65.3:D
=UBMKC10GH100+UBMKC11-K700		=UBCJA10GH100+UBCJA10/65.2:E	3BK	=UBCJA10GH100+UBCJA10-X72	8:A	=UBCJA10GH100+UBCJA10/65.2:D
=UBMKC10GH100+UBMKC11-K707		=UBCJA10GH100+UBCJA10/65.4:E	4BK	=UBCJA10GH100+UBCJA10-X72	10:A	=UBCJA10GH100+UBCJA10/65.4:D
=UBMKC10GH100+UBMKC11-K712		=UBCJA10GH100+UBCJA10/65.5:E	5BK	=UBCJA10GH100+UBCJA10-X72	11:A	=UBCJA10GH100+UBCJA10/65.5:D
=UBMKC10GH100+UBMKC11-K713		=UBCJA10GH100+UBCJA10/63.2:E	6BK	=UBCJA10GH100+UBCJA10-X72	3:A	=UBCJA10GH100+UBCJA10/63.2:D
=UBMKC10GH100+UBMKC11-K714		=UBCJA10GH100+UBCJA10/63.3:E	7BK	=UBCJA10GH100+UBCJA10-X72	5:A	=UBCJA10GH100+UBCJA10/63.3:E
=UBMKC10GH100+UBMKC11-K717		=UBCJA10GH100+UBCJA10/65.6:E	8BK	=UBCJA10GH100+UBCJA10-X72	12:A	=UBCJA10GH100+UBCJA10/65.6:D

CONFIDENTIAL, ALL RIGHTS RESERVED DIN 34

Format ISO/DIN A3

147

149

Approved by Contractor			Reconstruction and Modernisation of HPP Perucica - Phase II		 A Voith Company Sintaksa - A Voith Company Ulica Domovinskog rata 104C, 21 000 Split, Hrvatska	Unit KA2 control cubicle circuit diagrams CABLE DIAGRAM	DRAWING No.: PERU-01-19-170-31-002	REV No.:	= UBCJA10GH100
Approved by Designer	Grga Kolić	01.10.2026.							+ UBCJA10
Checked by	Antonio Aleksić	01.10.2026.					Designer No.:	SALES No.:	PAGE 148
Drawn by	Tamara Trogrlić	01.10.2026.							PAGE 148 / 157

	Cable name : -02-2UA01+UN13-4-003		Number of conductors : 5		Description :		
			Number of used conductors : 2				
	Cable type : NYCY		Cable cross section : 2.5				
	External Connections			Connection color/number	Internal Connections		
To device	Pin designation	Page/column	From device		Pin designation	Page/column	
=UBCHA10GH100+UBCHA10-X153		5	=UBCJA10GH100+UBCJA10/58.2:C	BU	=UBCJA10GH100+UBCJA10-X14	19:A	=UBCJA10GH100+UBCJA10/58.2:C
				GY			
				BN			
=UBCHA10GH100+UBCHA10-X153		1	=UBCJA10GH100+UBCJA10/58.2:B	1BK	=UBCJA10GH100+UBCJA10-X14	10:A	=UBCJA10GH100+UBCJA10/58.2:A
				2BK			

	Cable name : -02-2UA01+UN13-4-011		Number of conductors : 10		Description :	
			Number of used conductors : 4			
	Cable type : NYCY		Cable cross section : 1.5			
	External Connections			Connection color/number	Internal Connections	
To device	Pin designation	Page/column	From device		Pin designation	Page/column
			1			
			2			
=UBCHA10GH100+UBCHA10-X161	4	=UBCJA10GH100+UBCJA10/27.4:B	3	=UBCJA10GH100+UBCJA10-X138	9:A	=UBCJA10GH100+UBCJA10/27.4:B
=UBCHA10GH100+UBCHA10-X161	5	=UBCJA10GH100+UBCJA10/27.4:C	4	=UBCJA10GH100+UBCJA10-1K84	A1	=UBCJA10GH100+UBCJA10/27.4:D
=UBCHA10GH100+UBCHA10-X161	10	=UBCJA10GH100+UBCJA10/26.8:B	5	=UBCJA10GH100+UBCJA10-X138	5:A	=UBCJA10GH100+UBCJA10/26.8:B
=UBCHA10GH100+UBCHA10-X161	11	=UBCJA10GH100+UBCJA10/26.8:C	6	=UBCJA10GH100+UBCJA10-1K78	A1	=UBCJA10GH100+UBCJA10/26.8:D
			7			
			8			
			9			
			10			

	Cable name : -02-2UA01+UN13-4-012		Number of conductors : 10		Description :	
			Number of used conductors : 8			
	Cable type : NYCY		Cable cross section : 1.5			
	External Connections			Connection color/number	Internal Connections	
To device	Pin designation	Page/column	From device		Pin designation	Page/column
=UBCHA10GH100+UBCHA10-X161	12	=UBCJA10GH100+UBCJA10/27.1:B	1	=UBCJA10GH100+UBCJA10-X138	6:A	=UBCJA10GH100+UBCJA10/27.1:B
=UBCHA10GH100+UBCHA10-X161	13	=UBCJA10GH100+UBCJA10/27.1:C	2	=UBCJA10GH100+UBCJA10-1K81	A1	=UBCJA10GH100+UBCJA10/27.1:D
=UBCHA10GH100+UBCHA10-X161	14	=UBCJA10GH100+UBCJA10/27.2:B	3	=UBCJA10GH100+UBCJA10-X138	7:A	=UBCJA10GH100+UBCJA10/27.2:B
=UBCHA10GH100+UBCHA10-X161	15	=UBCJA10GH100+UBCJA10/27.2:C	4	=UBCJA10GH100+UBCJA10-1K82	A1	=UBCJA10GH100+UBCJA10/27.2:D
=UBCHA10GH100+UBCHA10-X161	16	=UBCJA10GH100+UBCJA10/27.3:B	5	=UBCJA10GH100+UBCJA10-X138	8:A	=UBCJA10GH100+UBCJA10/27.3:B
=UBCHA10GH100+UBCHA10-X161	17	=UBCJA10GH100+UBCJA10/27.3:C	6	=UBCJA10GH100+UBCJA10-1K83	A1	=UBCJA10GH100+UBCJA10/27.3:D
=UBCHA10GH100+UBCHA10-X161	47	=UBCJA10GH100+UBCJA10/26.6:C	7	=UBCJA10GH100+UBCJA10-1K76	A1	=UBCJA10GH100+UBCJA10/26.6:D
=UBCHA10GH100+UBCHA10-X161	46	=UBCJA10GH100+UBCJA10/26.6:B	8	=UBCJA10GH100+UBCJA10-X138	3:A	=UBCJA10GH100+UBCJA10/26.6:B
			9			
			10			

CONFIDENTIAL, ALL RIGHTS RESERVED DIN 34

Format ISO/DIN A3

148

150

Approved by Contractor			Reconstruction and Modernisation of HPP Perucica - Phase II		 A Voith Company Sintaksa - A Voith Company Ulica Domovinskog rata 104C, 21 000 Split, Hrvatska	Unit KA2 control cubicle circuit diagrams CABLE DIAGRAM	DRAWING No.:	REV No.:	= UBCJA10GH100
Approved by Designer	Grga Kolić	01.10.2026.						+ UBCJA10	
Checked by	Antonio Aleksić	01.10.2026.					SALES No.:	PAGE 149	
Drawn by	Tamara Trogrlić	01.10.2026.						PAGE 149 / 157	

	Cable name :	-02-2UA01+UN13-4-015	Number of conductors :	10	Description :
			Number of used conductors :	2	
	Cable type :	NYCY	Cable cross section :	1.5	

External Connections			Connection color/number	Internal Connections		
To device	Pin designation	Page/column		From device	Pin designation	Page/column
			1			
			2			
=UBCHA10GH100+UBCHA10-X161	38	=UBCJA10GH100+UBCJA10/26.7:C	3	=UBCJA10GH100+UBCJA10-1K77	A1	=UBCJA10GH100+UBCJA10/26.7:D
=UBCHA10GH100+UBCHA10-X161	45	=UBCJA10GH100+UBCJA10/26.7:B	4	=UBCJA10GH100+UBCJA10-X138	4:A	=UBCJA10GH100+UBCJA10/26.7:B
			5			
			6			
			7			
			8			
			9			
			10			

	Cable name :	-02-2UA01+UN13-4-016	Number of conductors :	10	Description :
			Number of used conductors :	8	
	Cable type :	NYCY	Cable cross section :	1.5	

External Connections			Connection color/number	Internal Connections		
To device	Pin designation	Page/column		From device	Pin designation	Page/column
=UBCHA10GH100+UBCHA10-X141	8	=UBCJA10GH100+UBCJA10/66.1:E	1	=UBCJA10GH100+UBCJA10-X73	1:A	=UBCJA10GH100+UBCJA10/66.1:D
=UBCHA10GH100+UBCHA10-X161	60	=UBCJA10GH100+UBCJA10/55.5:E	2	=UBCJA10GH100+UBCJA10-X72	13:A	=UBCJA10GH100+UBCJA10/55.5:E
=UBCHA10GH100+UBCHA10-X141	17	=UBCJA10GH100+UBCJA10/66.2:E	3	=UBCJA10GH100+UBCJA10-X73	2:A	=UBCJA10GH100+UBCJA10/66.2:D
=UBCHA10GH100+UBCHA10-X161	61	=UBCJA10GH100+UBCJA10/55.6:E	4	=UBCJA10GH100+UBCJA10-X72	14:A	=UBCJA10GH100+UBCJA10/55.6:E
=UBCHA10GH100+UBCHA10-X141	21	=UBCJA10GH100+UBCJA10/66.5:E	5	=UBCJA10GH100+UBCJA10-X73	5:A	=UBCJA10GH100+UBCJA10/66.5:D
=UBCHA10GH100+UBCHA10-X141	27	=UBCJA10GH100+UBCJA10/66.6:E	6	=UBCJA10GH100+UBCJA10-X73	6:A	=UBCJA10GH100+UBCJA10/66.6:D
=UBCHA10GH100+UBCHA10-X152	2	=UBCJA10GH100+UBCJA10/55.2:E	7	=UBCJA10GH100+UBCJA10-X72	1:A	=UBCJA10GH100+UBCJA10/55.2:E
=UBCHA10GH100+UBCHA10-X152	6	=UBCJA10GH100+UBCJA10/55.3:E	8	=UBCJA10GH100+UBCJA10-X72	2:A	=UBCJA10GH100+UBCJA10/55.3:E
			9			
			10			

	Cable name :	-2319	Number of conductors :	4	Description :
			Number of used conductors :	3	
	Cable type :	LiYCY	Cable cross section :	0.75	

External Connections			Connection color/number	Internal Connections		
To device	Pin designation	Page/column		From device	Pin designation	Page/column
=TI4-TI4	1	=UBCJA10GH100+UBCJA10/33.2:B	WH	=UBCJA10GH100+UBCJA10-X141	13:A	=UBCJA10GH100+UBCJA10/33.2:B
=TI4-TI4	2	=UBCJA10GH100+UBCJA10/33.2:C	BN	=UBCJA10GH100+UBCJA10-1K142	A1	=UBCJA10GH100+UBCJA10/33.2:D
=TI4-TI4	3	=UBCJA10GH100+UBCJA10/33.2:C	GN	=UBCJA10GH100+UBCJA10-1K143	A1	=UBCJA10GH100+UBCJA10/33.3:D
			YE			

CONFIDENTIAL, ALL RIGHTS RESERVED DIN 34

Format ISO/DIN A3

149

151

Approved by Contractor			Reconstruction and Modernisation of HPP Perucica - Phase II		 A Voith Company Sintaksa - A Voith Company Ulica Domovinskog rata 104C, 21 000 Split, Hrvatska	Unit KA2 control cubicle circuit diagrams CABLE DIAGRAM	DRAWING No.: PERU-01-19-170-31-002	REV No.:	= UBCJA10GH100
Approved by Designer	Grga Kolić	01.10.2026.							+ UBCJA10
Checked by	Antonio Aleksić	01.10.2026.					Designer No.:	SALES No.:	PAGE 150
Drawn by	Tamara Trogrlić	01.10.2026.							PAGE 150 / 157

	Cable name : -2320		Number of conductors : 4		Description :		
			Number of used conductors : 3				
	Cable type : LiYCY		Cable cross section : 0.75				
	External Connections			Connection color/number	Internal Connections		
To device	Pin designation	Page/column	From device		Pin designation	Page/column	
=TI3-TI3	1	=UBCJA10GH100+UBCJA10/32.8:B	WH	=UBCJA10GH100+UBCJA10-X141	11:A	=UBCJA10GH100+UBCJA10/32.8:B	
=TI3-TI3	2	=UBCJA10GH100+UBCJA10/32.8:C	BN	=UBCJA10GH100+UBCJA10-1K138	A1	=UBCJA10GH100+UBCJA10/32.8:D	
=TI3-TI3	3	=UBCJA10GH100+UBCJA10/32.8:C	GN	=UBCJA10GH100+UBCJA10-1K141	A1	=UBCJA10GH100+UBCJA10/33.1:D	
			YE				

	Cable name : -2321		Number of conductors : 4		Description :			
	Cable type : LiYCY		Number of used conductors : 3					
			Cable cross section : 0.75					
	External Connections			Connection color/number	Internal Connections			
To device		Pin designation	Page/column		From device		Pin designation	Page/column
=TI2-TI2		1	=UBCJA10GH100+UBCJA10/33.6:B	WH	=UBCJA10GH100+UBCJA10-X141		15:A	=UBCJA10GH100+UBCJA10/33.6:B
=TI2-TI2		2	=UBCJA10GH100+UBCJA10/33.6:C	BN	=UBCJA10GH100+UBCJA10-1K146		A1	=UBCJA10GH100+UBCJA10/33.6:D
=TI2-TI2		3	=UBCJA10GH100+UBCJA10/33.6:C	GN	=UBCJA10GH100+UBCJA10-1K147		A1	=UBCJA10GH100+UBCJA10/33.7:D
				YE				

	Cable name :	-2322	Number of conductors :		4	Description :		
			Number of used conductors :		3			
	Cable type :	LiYCY	Cable cross section :		0.75			
External Connections				Internal Connections				
To device		Pin designation	Page/column	Connection color/number	From device		Pin designation	Page/column
=TI1-TI1		1	=UBCJA10GH100+UBCJA10/33.4:B	WH	=UBCJA10GH100+UBCJA10-X141		14:A	=UBCJA10GH100+UBCJA10/33.4:B
=TI1-TI1		2	=UBCJA10GH100+UBCJA10/33.4:C	BN	=UBCJA10GH100+UBCJA10-1K144		A1	=UBCJA10GH100+UBCJA10/33.4:D
=TI1-TI1		3	=UBCJA10GH100+UBCJA10/33.4:C	GN	=UBCJA10GH100+UBCJA10-1K145		A1	=UBCJA10GH100+UBCJA10/33.5:D
				YE				

	Cable name : +UBCJA10-W5001		Number of conductors : 7		Description :		
			Number of used conductors : 5				
	Cable type : NYCY		Cable cross section : 1.5				
External Connections			Connection color/number	Internal Connections			
To device	Pin designation	Page/column		From device	Pin designation	Page/column	
=OUT+OUT-H02	4	=UBCJA10GH100+UBCJA10/68.2:D	1	=UBCJA10GH100+UBCJA10-X144	10:A	=UBCJA10GH100+UBCJA10/68.2:D	
=OUT+OUT-H02	3	=UBCJA10GH100+UBCJA10/68.4:D	2	=UBCJA10GH100+UBCJA10-X144	11:A	=UBCJA10GH100+UBCJA10/68.4:D	
=OUT+OUT-H02	2	=UBCJA10GH100+UBCJA10/68.3:D	3	=UBCJA10GH100+UBCJA10-X144	12:A	=UBCJA10GH100+UBCJA10/68.3:D	
=OUT+OUT-H02	1	=UBCJA10GH100+UBCJA10/68.5:D	4	=UBCJA10GH100+UBCJA10-X144	13:A	=UBCJA10GH100+UBCJA10/68.5:D	
=OUT+OUT-H02	0	=UBCJA10GH100+UBCJA10/68.2:E	5	=UBCJA10GH100+UBCJA10-X144	8:A	=UBCJA10GH100+UBCJA10/68.2:F	
			6				
			7				

CONFIDENTIAL, ALL RIGHTS RESERVED DIN 34

Format ISO/DIN A3

150

152

Approved by Contractor			Reconstruction and Modernisation of HPP Perucica - Phase II		 A Voith Company Sintaksa - A Voith Company Ulica Domovinskog rata 104C, 21 000 Split, Hrvatska	Unit KA2 control cubicle circuit diagrams CABLE DIAGRAM	DRAWING No.: PERU-01-19-170-31-002	REV No.:	= UBCJA10GH100
Approved by Designer	Grga Kolić	01.10.2026.							+ UBCJA10
Checked by	Antonio Aleksić	01.10.2026.					Designer No.:	SALES No.:	PAGE 151
Drawn by	Tamara Trogrlić	01.10.2026.							PAGE 151 / 157

	Cable name :	+UBCJA10-W8001	Number of conductors :		Description :			
	Cable type :	ETHERLINE Y CAT5 2X2XAWG22	Number of used conductors : 1					
			Cable cross section :					
External Connections			Connection color/number	Internal Connections				
To device		Pin designation		Page/column	From device		Pin designation	Page/column
=0UA01+UV01-U?			=UBCJA10GH100+UBCJA10/78.2:E	IE	=UBCJA10GH100+UBCJA10-U300		P2	=UBCJA10GH100+UBCJA10/78.3:C

	Cable name :	+UBCJA10-W8002	Number of conductors :		Description :			
	Cable type :	ETHERLINE Y CAT5 2X2XAWG22	Number of used conductors : 1					
			Cable cross section :					
External Connections			Connection color/number	Internal Connections				
To device		Pin designation		Page/column	From device		Pin designation	Page/column
=UBMKC10GH100+UBMKC11-U?				=UBCJA10GH100+UBCJA10/78.4:E	=UBCJA10GH100+UBCJA10-U300		P5	=UBCJA10GH100+UBCJA10/78.3:B

	Cable name :	+UBCJA10-W8003	Number of conductors :		Description :			
	Cable type :	ETHERLINE Y CAT5 2X2XAWG22	Number of used conductors : 1					
			Cable cross section :					
External Connections			Connection color/number	Internal Connections				
To device		Pin designation		Page/column	From device		Pin designation	Page/column
=UBMKC10GH100+UBMKC11-U?				=UBCJA10GH100+UBCJA10/78.5:E	=UBCJA10GH100+UBCJA10-U301		P2	=UBCJA10GH100+UBCJA10/78.5:C

	Cable name : +UBCJA10-W8004		Number of conductors :		Description :			
	Cable type : ETHERLINE Y CAT5 2X2XAWG22		Number of used conductors : 1					
			Cable cross section :					
	External Connections			Connection color/number	Internal Connections			
To device		Pin designation	Page/column		From device		Pin designation	Page/column
=0UA01+UV01-U?			=UBCJA10GH100+UBCJA10/78.7:E		=UBCJA10GH100+UBCJA10-U301		P5	=UBCJA10GH100+UBCJA10/78.5:B

	Cable name : +UBCJA10-W8005		Number of conductors :		Description :				
	Cable type : ETHERLINE Y CAT5 2X2XAWG22		Number of used conductors : 1						
			Cable cross section :						
	External Connections			Connection color/number		Internal Connections			
To device		Pin designation	Page/column			From device		Pin designation	Page/column
				IE					
=AUMA+K2:C1:V1-U?			=UBCJA10GH100+UBCJA10/79.5:E			=UBCJA10GH100+UBCJA10-A350		X1P2:LAN	=UBCJA10GH100+UBCJA10/79.4:E

	1	2	3	4	5	6	7	8																																																					
A	<table><tr><td rowspan="3"></td><td colspan="3">Cable name : +UBCJA10-W8006</td><td colspan="2">Number of conductors :</td><td colspan="3" rowspan="3">Description :</td></tr><tr><td colspan="3">Cable type : ETHERLINE Y CAT5 2X2XAWG22</td><td colspan="2">Number of used conductors : 1</td></tr><tr><td colspan="3"></td><td colspan="2">Cable cross section :</td></tr><tr><td colspan="4">External Connections</td><td rowspan="3">Connection color/number</td><td colspan="3">Internal Connections</td></tr><tr><td colspan="2">To device</td><td>Pin designation</td><td>Page/column</td><td colspan="2">From device</td><td>Pin designation</td><td>Page/column</td></tr><tr><td colspan="2"></td><td></td><td></td><td colspan="2"></td><td></td><td></td></tr><tr><td colspan="2">=AUMA+K2:C2:V2-U?</td><td></td><td>=UBCJA10GH100+UBCJA10/79.7:E</td><td>IE CABLE</td><td colspan="2">=UBCJA10GH100+UBCJA10-A102</td><td>P2 R</td><td>=UBCJA10GH100+UBCJA10/12.3:E</td></tr></table>									Cable name : +UBCJA10-W8006			Number of conductors :		Description :			Cable type : ETHERLINE Y CAT5 2X2XAWG22			Number of used conductors : 1					Cable cross section :		External Connections				Connection color/number	Internal Connections			To device		Pin designation	Page/column	From device		Pin designation	Page/column									=AUMA+K2:C2:V2-U?			=UBCJA10GH100+UBCJA10/79.7:E	IE CABLE	=UBCJA10GH100+UBCJA10-A102		P2 R	=UBCJA10GH100+UBCJA10/12.3:E	A
	Cable name : +UBCJA10-W8006			Number of conductors :		Description :																																																							
	Cable type : ETHERLINE Y CAT5 2X2XAWG22			Number of used conductors : 1																																																									
				Cable cross section :																																																									
External Connections				Connection color/number	Internal Connections																																																								
To device		Pin designation	Page/column		From device		Pin designation	Page/column																																																					
=AUMA+K2:C2:V2-U?			=UBCJA10GH100+UBCJA10/79.7:E	IE CABLE	=UBCJA10GH100+UBCJA10-A102		P2 R	=UBCJA10GH100+UBCJA10/12.3:E																																																					
B									B																																																				
C									C																																																				
D									D																																																				
E									E																																																				
F									F																																																				
Format ISO/DIN A3									153																																																				
151																																																													
Approved by Contractor			Reconstruction and Modernisation of HPP Perucica - Phase II		 Sintaksa - A Voith Company Ulica Domovinskog rata 104C, 21 000 Split, Hrvatska	Unit KA2 control cubicle circuit diagrams CABLE DIAGRAM	DRAWING No.: PERU-01-19-170-31-002	REV No.: = UBCJA10GH100																																																					
Approved by Designer		Grga Kolić					01.10.2026.	Designer No.:	SALES No.:																																																				
Checked by		Antonio Aleksić					01.10.2026.																																																						
Drawn by		Tamara Trogrlić	01.10.2026.	PROJECT NAME	EMPLOYER	DESIGNER	PAGE 152																																																						
							PAGE 152 / 157																																																						
	1	2	3	4	5	6	7	8																																																					

CONFIDENTIAL, ALL RIGHTS RESERVED DIN 34

Format ISO/DIN A3

CONFIDENTIAL, ALL RIGHTS RESERVED DIN 34

Format ISO/DIN A3

1		2	3	4	5	6	7	8
Device Tag (Location + Displayed DT)		Qty.	Description	Designation	Type number	Manufacturer	Part number	
=UBCJA10GH100+UBCJA10	A100	1	PROFINET, 2-port interface module IM 155-6PN/2 SIMATIC ET 200SP 1 BusAdapter slot; max. 64 I/O modules; 16 ET 200AL modules	Interface module ET200SP	6ES7155-6AU01-0CN0	SIE	SIE.6ES7155-6AU01-0CN0	
=UBCJA10GH100+UBCJA10	A100	1	SIMATIC ET 200SP, BA 2X RJ45, 2 RJ45 SOCKETS FOR PROFINET	PLC Bus adapter	6ES7193-6AR00-0AA0	SIE	SIE.6ES7193-6AR00-0AA0	
=UBCJA10GH100+UBCJA10	A101	1	Power supply module 25W 24 V DC Simatic S7-1500 Supplies the backplane bus of the S7-1500 with operating voltage	Power supply module for S7-1500	6ES7505-0KA00-0AB0	SIE	SIE.6ES7505-0KA00-0AB0	
=UBCJA10GH100+UBCJA10	A102	1	Work memory 1 MB and 4.5 MB for data 1st interface: PROFINET IRT with 2-port switch, 2nd interface: PROFINET RT, 6 ns bit performance SIMATIC Memory Card required	CPU 1515-2 PN SIMATIC S7-1500	6ES7515-2AN03-0AB0	SIE	SIE.6ES7515-2AN03-0AB0	
=UBCJA10GH100+UBCJA10	A102	1	SIMATIC S7, memory cards for S7-1x00 CPU/SINAMICS, 3, 3V Flash, 24 MB	SIMATIC S7 Memory card 24 MB For S7-1x00 CPU	6ES7954-8LF04-0AA0	SIE	SIE.6ES7954-8LF04-0AA0	
=UBCJA10GH100+UBCJA10	A103	2	Communications module CM 1542-1 for connection of S7-1500 to PROFINET as IO Controller or IO Device: TCP/IP, ISO-on-TCP, UDP, S7 communication, IP broadcast multicast, SNMPV1, time-of-day synchronization via NTP, 2xRJ45 (10/100 Mbit).	CM 1542-1	6GK7542-1AX10-0XE0	SIE	SIE.6GK7542-1AX10-0XE0	
=UBCJA10GH100+UBCJA10	A104;A105	2	1 channel for 24V incremental encoder or pulse encoder Type: TM count 1x 24 V Counter module Order No.: 6ES7138-6AA01-0BA0	Counter module for ET200SP	6ES7138-6AA01-0BA0	SIE	SIE.6ES7138-6AA01-0BA0	
=UBCJA10GH100+UBCJA10	A104;A131;A141	3	SIMATIC ET 200SP BU type A0 push-in terminals, without aux. terminals, new load group	BaseUnit BU15-P16+A0+2D	6ES7193-6BP00-0DA0	SIE	SIE.6ES7193-6BP00-0DA0	
=UBCJA10GH100+UBCJA10	A105;A111...A120 A132...A134;A151;A152 A161	17	BU type A0, Push-in terminals, without AUX terminals, bridged to the left	BaseUnit BU15-P16+A0+2B	6ES7193-6BP00-0BA0	SIE	SIE.6ES7193-6BP00-0BA0	
=UBCJA10GH100+UBCJA10	A111...A120	10	DI 16X24V DC Standard type 3 (IEC 61131); sink input; fits to BU-type A0 input delay time 0,05..20ms; Diagnostics: wire break, supply voltage	Digital input module ET 200SP	6ES7131-6BH01-0BA0	SIE	SIE.6ES7131-6BH01-0BA0	
=UBCJA10GH100+UBCJA10	A131...A134	4	DQ 16x 24V DC/0,5A fits to BU-type A0; Source output (PNP/P-switching); substitute value output, Module diagnostics: short-circuit to L+ and ground, wire break, supply voltage	Digital output module ET200SP	6ES7132-6BH01-0BA0	SIE	SIE.6ES7132-6BH01-0BA0	
=UBCJA10GH100+UBCJA10	A141	1	AI 4XI 2-/4-WIRE Standard fits to BU-TYPE A0, A1 Module diagnosis, 16 bit, +/-0,3%	Analog input module SIMATIC ET 200SP	6ES7134-6GD01-0BA1	SIE	SIE.6ES7134-6GD01-0BA1	
=UBCJA10GH100+UBCJA10	A151;A152	2	Analog input module for ET200SP, Type: AI 2XI 2-/4-WIRE Standard	Analog input module for ET 200SP	6ES7134-6GB00-0BA1	SIE	SIE.6ES7134-6GB00-0BA1	
=UBCJA10GH100+UBCJA10	A161	1	SIMATIC ET 200SP, Analog output module, AQ 4XU/I Standard, suitable for BU type A0, A1, Color code CC00, Module diagnostic s, 16 bit, +/-0.3%	Analog output module	6ES7135-6HD00-0BA1	SIE	SIE.6ES7135-6HD00-0BA1	
=UBCJA10GH100+UBCJA10	A171	1	SIMATIC ET 200SP, analog input module, AI Energy Meter CT ST, for 1A or 5A current transformer, suitable for BU type U0, channel diagnostics	SIMATIC ET 200SP AI Energy Meter CT ST	6ES7134-6PA01-0BU0	SIE	SIE.6ES7134-6PA01-0BU0	
=UBCJA10GH100+UBCJA10	A171	1	SIMATIC ET 200SP, BaseUnit BU20-P16+A0+2D, BU-TYPE U0, Packaging Unit: 1 Pieces, Push-in terminals, w/o AUX-terminals, new potential group, WxH: 20mm x 117mm	SIMATIC ET 200SP BU type U0 BU20-P16+A0+2D PU 1	6ES7193-6BP00-0DU0	SIE	SIE.6ES7193-6BP00-0DU0	
=UBCJA10GH100+UBCJA10	A350	1	SIMATIC HMI MTP1500, Unified Comfort Panel, touch operation, 15.6" widescreen TFT display, 16 million colors, PROFINET interface, configurable as of WinCC Unified Comfort V16, contains open-source software, which is provided free of charge see enclosed DVD	SIMATIC HMI MTP1500 Unified Comfort	6AV2128-3QB06-0AX1	SIE	SIE.6AV2128-3QB06-0AX1	
=UBCJA10GH100+UBCJA10	A350	1	2GB Type: SIMATIC SD Order No.: 6AV2181-8XP00-0AX0	Memory card	6AV2181-8XP00-0AX0	SIE	SIE.6AV2181-8XP00-0AX0	
=UBCJA10GH100+UBCJA10	B101	1	HellermannTyton Thermostat, NC contact 0...+60°C	Thermostat	THR02	ALFA ELECTRIC	THR02	
=UBCJA10GH100+UBCJA10	B102	1	Hygrostat, Rated Voltage 120-240 V AC, Rated Current 10-5A 10-90 %RF	Electronic hygrostat	IGR35F	FANDIS	FANDISEU.IGR35F	
=UBCJA10GH100+UBCJA10	B103	1	NO contact 0...+60°C	Thermostat	THV02	ALFA ELECTRIC	AEL.THV02	

152

154

Approved by Contractor			Reconstruction and Modernisation of HPP Perucica - Phase II		 A Voith Company Sintaksa - A Voith Company Ulica Domovinskog rata 104C, 21 000 Split, Hrvatska	Unit KA2 control cubicle circuit diagrams		DRAWING No.:	REV No.:	= UBCJA10GH100		
Approved by Designer	Grga Kolić	01.10.2026.				Summarized parts list		PERU-01-19-170-31-002		02	+ UBCJA10	
Checked by	Antonio Aleksić	01.10.2026.						Designer No.:		SALES No.:	PAGE 153	
Drawn by	Tamara Trogrlić	01.10.2026.						PROJECT NAME		EMPLOYER	DESIGNER	PAGE 153 / 157
1		2	3	4	5	6	7	8				

A	1		2		3		4		5		6		7		8				
	=UBCJA10GH100+UBCJA10		B111	1	Nominal voltage: 110...240VAC (50...60Hz)/27Hz (tip. 24VDC) 2 relay outputs, 2 transistor outputs Analog output: 0/4...20mA Impuls inputs: pnp/npn, NAMUR (24V) Input frequency (max): 5kHz Setting range: 1...60000 imp/min (0,1...1000Hz)			Speed monitoring relay MONITOR/FR-1 /110-240VAC/DC		DD2503		IFM		IFM.DD2503					
	=UBCJA10GH100+UBCJA10		E101;E102	2	Slim enclosure LED lamp, 9 W, 100 to 230V, 50H, 538×23×36 mm			LED system light		LL49W-100-230V		AE		AE.LL49W-100-230V					
	=UBCJA10GH100+UBCJA10		F0	1	RCBO, 10 kA, 1P+N, type AC, 30 mA, C-char, In: 13 A, Un AC: 230 V			RCBO		5SU1354-1KK13		SIE		SIE.5SU1354-1KK13					
	=UBCJA10GH100+UBCJA10		F11;F12	2	MCB - 440 VDC Number poles: 2P Class: B Max current: 10A			10A, 2P, 440 VDC, B curve		5SY5210-6		SIE		SIE.5SY5210-6					
	=UBCJA10GH100+UBCJA10		F11...F16;F131...F147	23	1 C/O For MCB 5SL, 5SY, 5SP; Incorporated switch 5TL1 RCBO 5SU1, RC 5SV Rated voltage: 30 V			Auxiliary switch		5ST3016		SIE		SIE.5ST3016					
	=UBCJA10GH100+UBCJA10		F13...F16	4	MCB - 440 VDC Number poles: 2P Class: B Max current: 6A			6A, 2P, 440 VDC, B curve		5SY5206-6		SIE		SIE.5SY5206-6					
	=UBCJA10GH100+UBCJA10		F25G	1	Power supply: 24 Vdc Discrete raise/lower: Speed Discrete raise/lower: Voltage Discrete alarm inputs: 4; discrete outputs: 2 Measuring inputs: 400 Vac Type: SPM-D2-10 Order No.: 8440-216t			Automatic synchronizer		8440-2164		Woodward		Woodward.8440-2164					
	=UBCJA10GH100+UBCJA10		F131...F134;F139...F146	12	Miniature circuit breaker 230/400 V 10kA, 1-pole, B, 6 A, D=70 mm			SENTRON Miniature circuit breaker		5SY4106-6		SIE		SIE.5SY4106-6					
	=UBCJA10GH100+UBCJA10		F135;F137;F138;F147	4	230/400V 10kA 1-pole B curve 2A			Miniature circuit breaker		5SY4102-6		SIE		SIE.5SY4102-6					
B	=UBCJA10GH100+UBCJA10		F136	1	230/400 V 10kA 1-pole B curve 10A			Miniature circuit breaker, 10kA, 1-pole, B, 10A		5SY4110-6		SIE		SIE.5SY4110-6					
	=UBCJA10GH100+UBCJA10		H01	1	The flexible fault annunciator series BSM-P, programmable			Panel mounted fault annunciator		BSM-P 59B1611PR000		ESS		BSM-P 59B1611PR000					
	=UBCJA10GH100+UBCJA10		H101;H106	2	The indicators glow in two colors: red or green. Power supply is connected as follows: X0 - common terminal (ground) X1 - red color (voltage) X2 - green color (voltage) Diameter - 22mm 24 AC/DC			Indicator Light		PK22-WP/24		SPAMEL		SPAMEL.PK22-WP/24					
	=UBCJA10GH100+UBCJA10		H103	1	Indicator lights, 22 mm, round, metal, shiny, yellow, lens, smooth, with holder, LED module with integrated LED 24 V AC/DC, screw terminal			INDICATOR LIGHT, YELLOW		3SU1152-6AA30-1AA0		SIE		SIE.3SU1152-6AA30-1AA0					
	=UBCJA10GH100+UBCJA10		H103...H105;S100;S103 S104;S111...S114;S121 S130;S131;S203;S221 S222;S290;S291;S302	19	Label holder, 22mm, frame rectangular at the bottom, black, for labeling plate 17.5 mm x 27 mm, for gluing			SIRIUS ACT Label holder		3SU1900-0AP10-0AA0		SIE		SIE.3SU1900-0AP10-0AA0					
	=UBCJA10GH100+UBCJA10		H104	1	Indicator lights, 22 mm, round, metal, shiny, red, lens, smooth, with holder, LED module with integrated LED 24 V AC/DC, screw terminal			INDICATOR LIGHT, RED		3SU1152-6AA20-1AA0		SIE		SIE.3SU1152-6AA20-1AA0					
	=UBCJA10GH100+UBCJA10		H105	1	Indicator lights, 22 mm, round, metal, shiny, white, lens, smooth, with holder, LED module with integrated LED 24 V AC/DC, screw terminal			INDICATOR LIGHT, WHITE		3SU1152-6AA60-1AA0		SIE		SIE.3SU1152-6AA60-1AA0					
	=UBCJA10GH100+UBCJA10		K1	1	REV. COMB., AC3, 4KW/400V DC24V 3-POLE, SZ S00 SCREW TERMINAL ELECTR. AND MECH. INTERLOCK Electrical and mechanical interlocking			REV.COMB.,4KW, DC24V		3RA2316-8XB30-1BB4		SIE		SIE.3RA2316-8XB30-1BB4					
	=UBCJA10GH100+UBCJA10		K01;K302;K303	3	Contactor relay, 4NO, 24VDC, with integrated diode, size S00, screw terminal			SIRIUS contactor relay		3RH2140-1FB40		SIE		SIE.3RH2140-1FB40					
	=UBCJA10GH100+UBCJA10		K01	1	Auxiliary switch block , 3NO+1NC conditional paths: 1NO, 1NC, 1NO, 1NO, for contactor relays size S00, screw terminal DIN EN 50011			AUX. SWITCH BLOCK , 3NO+1NC COND. PATHS: 1NO, 1NC,		3RH2911-1GA31		SIE		SIE.3RH2911-1GA31					
C	1		2		3		4		5		6		7		8				
	Approved by Contractor			01.10.2026.		Reconstruction and Modernisation of HPP Perucica - Phase II				 Sintaksa - A Voith Company Ulica Domovinskog rata 104C, 21 000 Split, Hrvatska		Unit KA2 control cubicle circuit diagrams		DRAWING No.: PERU-01-19-170-31-002		REV No.: 02		= UBCJA10GH100 + UBCJA10	
	Approved by Designer		Grga Kolić	01.10.2026.								Summarized parts list		Designer No.:		SALES No.:		PAGE 154	
	Checked by		Antonio Aleksić	01.10.2026.															
	Drawn by		Tamara Trogrlić	01.10.2026.		PROJECT NAME		EMPLOYER		DESIGNER								PAGE 154 / 157	
	1		2		3		4		5		6		7		8				

CONFIDENTIAL, ALL RIGHTS RESERVED DIN 34

Format ISO/DIN A3

1		2		3		4		5		6		7		8	
Device Tag (Location + Displayed DT)		Qty.	Description			Designation		Type number		Manufacturer		Part number			
=UBCJA10GH100+UBCJA10	P1	1	Scale: 0-200% Input signal: 4-20mA			Analog panel meter		MA19LN A900X000008		LUMEL		LUMEL.MA19LN A900X000008			
=UBCJA10GH100+UBCJA10	P101	1	Type: SENTRON PAC3220 Power supply: 24 ... 60 VDC -20/+10 % LCD 96x96mm protocol: Modbus TCP input: 690/400V 45-65Hz IE rated input: X/1A oder X/5A AC screw connections			Power monitoring device		7KM3220-1BA01-1EA0		SIE		SIE.7KM3220-1BA01-1EA0			
=UBCJA10GH100+UBCJA10	P101	1	expansion module switched Ethernet PROFINET V3, plug-in, for 7KM PAC32x0 / 4200 / 3VA COM100/ 800			SENTRON Switched Ethernet PROFINET V3 expansion module		7KM9300-0AE02-0AA0		SIE		SIE.7KM9300-0AE02-0AA0			
=UBCJA10GH100+UBCJA10	P110	1	Scale: 0-500 V, 48x48mm Direct measurement			Analog panel meter		EA16N E61500000A8		LUMEL		LUMEL.EA16N E61500000A8			
=UBCJA10GH100+UBCJA10	P411	1	Scale: 360° Power supply from bus bar or generator Displayed value equal to voltage input			Synchronisation meters for manual or semiautomatic synchronisation		SQ0214		Iskra		Iskra.SQ0214-L-400V-R3-N-N-S-A-0			
=UBCJA10GH100+UBCJA10	PE_SH;X151;XF201	13	Fuse modular terminal block, fuse type: Glass / ceramics / ..., fuse type: G / 5 x 20, nom. voltage: 500 V, nominal current: 6.3 A , number of positions: 1, connection method: Screw connection, Rated cross section: 1.5 mm2, cross section: 0.2 mm2- 6 mm2, mounting type: NS 35/7,5, NS 35/15, NS 32, color: black			Fuse terminal block UK 5-HESI N		3000539		PXC		PXC.3000539			
=UBCJA10GH100+UBCJA10	R101;R102	2	Rated power: 100W Input voltage: 110-250V			Heater		HT100		ALFA ELECTRIC		AE.HT100			
=UBCJA10GH100+UBCJA10	S100	1	RONIS key-operated switch, 22 mm, round, metal, shiny, lock number SB30, with 2 keys, 2 switch positions O-I, latching, actuati ng angle 90°, 10:30h/13:30h, key removal O+I, with holder, 1 NO+1 NC, screw terminal, possible special locks: 3SB31, 421, 45 5			KEY-OPERATED SWITCH RONIS, O-I		3SU1150-4BF11-1FA0		SIE		SIE.3SU1150-4BF11-1FA0			
=UBCJA10GH100+UBCJA10	S100	1	DIN rail mounting base - Ø 22 mm units - for control and signalling unit			DIN rail mounting base - Ø 22 mm units - for control and signalling unit		A9A15151		SE		SE.A9A15151			
=UBCJA10GH100+UBCJA10	S101;S102	2	Door contact, 1NO+1NC			Door contact		XCKN2110G11		SE		SE.XCKN2110G11			
=UBCJA10GH100+UBCJA10	S103;S104	2	Selector switch, illuminable, 22 mm, round, metal, shiny, white, selector switch, short, 2 switch positions O-I, latching, actuating angle 90°, 10:30h/13:30h, with holder, 1 NO, screw terminal			SELECTOR SWITCH, O-I, BLACK, WHITE		3SU1150-2BF60-1BA0		SIE		SIE.3SU1150-2BF60-1BA0			
=UBCJA10GH100+UBCJA10	S103	1	Contact module with 2 contact elements, 2 NC, screw terminal, for front plate mounting			CONTACT MODULE 2NC		3SU1400-1AA10-1EA0		SIE		SIE.3SU1400-1AA10-1EA0			
=UBCJA10GH100+UBCJA10	S104	1	Contact module with 1 contact element, 1 NC, screw terminal, for front plate mounting			Contact module with 1 contact element, 1 NC		3SU1400-1AA10-1CA0		SIE		SIE.3SU1400-1AA10-1CA0			
=UBCJA10GH100+UBCJA10	S111;S113;S131;S291	4	Illuminated pushbutton, 22 mm, round, metal, shiny, green, pushbutton, flat, momentary contact type, with holder, 1 NO, LED module with integrated LED 24 V AC/DC, screw terminal			ILLUMINATED PUSHBUTTON, GREEN		3SU1152-0AB40-1BA0		SIE		SIE.3SU1152-0AB40-1BA0			
=UBCJA10GH100+UBCJA10	S112;S114;S130;S221 S222	7	Contact module with 1 contact element, 1 NO, screw terminal, for front plate mounting			Contact module with 1 contact element, 1 NO		3SU1400-1AA10-1BA0		SIE		SIE.3SU1400-1AA10-1BA0			
=UBCJA10GH100+UBCJA10	S112;S114;S130	3	Illuminated pushbutton, 22 mm, round, metal, shiny, red, pushbutton, flat, momentary contact type			ILLUMINATED PUSHBUTTON, RED		3SU1051-0AB20-0AA0		SIE		SIE.3SU1051-0AB20-0AA0			
=UBCJA10GH100+UBCJA10	S112;S114;S130;S221 S222	5	Holder for 3 modules, universal, plastic/metal			HOLDER		3SU1550-0AA10-0AA0		SIE		SIE.3SU1550-0AA10-0AA0			
=UBCJA10GH100+UBCJA10	S112;S114;S130;S301	4	LED MODULE WITH INTEGRATED LED 24V AC/DC, RED, SCREW TERMINAL, FOR FRONT PLATE MOUNTING			LED MODULE, RED		3SU1401-1BB20-1AA0		SIE		SIE.3SU1401-1BB20-1AA0			
=UBCJA10GH100+UBCJA10	S121	1	Selector switch, illuminable, 22 mm, round, metal, shiny, white, selector switch, short, 3 switch positions I-O-II, latching, actuati ng angle 2x45°, 10:30h/12h/13:30h, with holder, 2x1NO+1NC, screw terminal			SELECTOR SWITCH, I-O-II, BLACK, WHITE		3SU1150-2BL60-1LA0		SIE		SIE.3SU1150-2BL60-1LA0			
=UBCJA10GH100+UBCJA10	S203;S302	2	Pushbutton, 22 mm, round, metal, shiny, black, pushbutton, flat, momentary contact type, with holder, 1 NO, screw terminal			PUSHBUTTON, BLACK		3SU1150-0AB10-1BA0		SIE		SIE.3SU1150-0AB10-1BA0			
=UBCJA10GH100+UBCJA10	S221	1	Selector switch, illuminable, 22 mm, round, metal, shiny, red, selector switch, short, 3 switch positions I>O<II, momentary cont act type, actuating angle 2x45°, 10:30h/12h/13:30h			SELECTOR SWITCH, I>O<II, RED		3SU1052-2BM20-0AA0		SIE		SIE.3SU1052-2BM20-0AA0			
=UBCJA10GH100+UBCJA10	S222	1	Selector switch, illuminable, 22 mm, round, metal, shiny, blue, selector switch, short, 3 switch positions I>O<II, momentary con tact type, actuating angle 2x45°, 10:30h/12h/13:30h			SELECTOR SWITCH, I>O<II, BLUE		3SU1052-2BM50-0AA0		SIE		SIE.3SU1052-2BM50-0AA0			
=UBCJA10GH100+UBCJA10	S290	1	Illuminated pushbutton, 22 mm, round, metal, shiny, red, pushbutton, flat, momentary contact type, with holder, 1 NO+1 NC, L ED module with integrated LED 24 V AC/DC, screw terminal			ILLUMINATED PUSHBUTTON, RED		3SU1152-0AB20-1FA0		SIE		SIE.3SU1152-0AB20-1FA0			
=UBCJA10GH100+UBCJA10	S301	1	Illuminated mushroom pushbutton, 22 mm, round, metal, shiny, red, 40 mm, latching, Pull-to-unlatch mechanism			ILLUM. MUSHROOM PUSHBUTTON, 40MM, RED		3SU1051-1BA20-0AA0		SIE		SIE.3SU1051-1BA20-0AA0			
=UBCJA10GH100+UBCJA10	S301	1	PROTECTIVE COLLAR FOR EM. STOP MUSHROOM PUSHBUTTON, WITHOUT OR WITH RONIS LOCK, YELLOW, PLASTIC			PROTECTIVE COLLAR		3SU1900-0DY30-0AA0		SIE		SIE.3SU1900-0DY30-0AA0			
=UBCJA10GH100+UBCJA10	S301	1	Holder for 3 modules, metal, 1 NC, 1 NC, screw terminal			HOLDER, CONTACT MODULE 1NC,1NC		3SU1550-1AA10-1PA0		SIE		SIE.3SU1550-1AA10-1PA0			
=UBCJA10GH100+UBCJA10	SV1;SV2	2	2P DC Switch Disconnecter Nominal current: 20 A Insulation voltage: 1000 VDC			2-pole DC Switch Disconnector		C60NA-DC		SE		SE.A9N61690			
=UBCJA10GH100+UBCJA10	U50...U52	3	Linergy DS - screw distribution block 1P - 125A - 10 holes			Distribution block		Linergy DS		SE		SE.LGY112510			

155

157

Approved by Contractor			Reconstruction and Modernisation of HPP Perucica - Phase II		 A Voith Company	Unit KA2 control cubicle circuit diagrams		DRAWING No.:		REV No.:	= UBCJA10GH100				
Approved by Designer		Grga Kolić				01.10.2026.	Summarized parts list		PERU-01-19-170-31-002		02	+ UBCJA10			
Checked by		Antonio Aleksić				01.10.2026.			Designer No.:		SALES No.:		PAGE		
Drawn by		Tamara Trogrić				01.10.2026.							156		
PROJECT NAME		EMPLOYER		DESIGNER								PAGE			
1		2		3		4		5		6		7		8	

CONFIDENTIAL, ALL RIGHTS RESERVED DIN 34

Format ISO/DIN A3

CONFIDENTIAL, ALL RIGHTS RESERVED DIN 34

1		2		3		4		5		6		7		8	
Device Tag (Location + Displayed DT)		Qty.	Description				Designation	Type number	Manufacturer		Part number				
=UBCJA10GH100+UBCJA10	U101;U102	2	SITOP PSU8200M 20A stabilized power supply input: 120-230 V AC 110-220 V DC output: 24 V DC/20 A				Power supply	SITOP PSU8200	SIE		SIE.6EP1336-3BA10				
=UBCJA10GH100+UBCJA10	U201	1	VOITH Frequency converter with electrical isolation for measuring the speed from the residual voltage of the generator in connection with a speed transducer.				Measuring instrument	VFU1	VOITH		VOITH.VFU1				
=UBCJA10GH100+UBCJA10	U300;U301	2	24 V DC 8x 10/100 Mbit/s twisted pair ports with RJ45 sockets LED diagnostics Type: Scalance XB008 Order No.: 6GK5008-0BA10-1AB2				Ethernet switch	6GK5008-0BA10-1AB2	SIE		SIE.6GK5008-0BA10-1AB2				
=UBCJA10GH100+UBCJA10	V1;V2	2	Circuit configuration: Two diodes doubler circuit, two diodes common cathode, two diodes common anode, single diode Vf - Forward Voltage: 1.35 V Vr - Reverse Voltage: 800 V				Diode	DD100KB80	SanRex		DD100KB80				
=UBCJA10GH100+UBCJA10	V101	1	Input/output: DC 24-48V/40A Suitable for decoupling two SITOP power supplies with max. 20 A output current each				Redundancy module	SITOP RED1200	SIE		SIE.6EP4347-7RB00-0AX0				
=UBCJA10GH100+UBCJA10	X0;X10	7	Feed-through terminal block, nom. voltage: 800 V, nominal current: 32 A, number of connections: 2, connection method: Push-in connection, Rated cross section: 4 mm2, cross section: 0.2 mm2 - 6 mm2, mounting type: NS 35/7,5, NS 35/15, color: gray				PT 4 Feed-through terminal block	3211757	PXC		PXC.3211757				
=UBCJA10GH100+UBCJA10	X0;X13...X16;X51;X61 X62;X71...X73;X110 X131...X147	400	Feed-through terminal block, nom. voltage: 800 V nominal current: 24 A number of connections: 2 number of positions: 1 connection method: Push-in connection Rated cross section: 2.5 mm2 cross section: 0.14 mm2 - 4 mm2 mounting type: NS 35/7,5, NS 35/15 color: gray				PT 2,5 Feed-through terminal block	3209510	PXC		PXC.3209510				
=UBCJA10GH100+UBCJA10	X0;X61	4	Ground terminal, number of connections: 2, connection method: Push-in connection, cross section: 0.14 mm2 - 4 mm2, mounting type: NS 35/7,5, NS 35/15, color: green-yellow				PT 2,5-PE Ground terminal	3209536	PXC		PXC.3209536				
=UBCJA10GH100+UBCJA10	X50	5	PTTB 2,5-2DIO/O-UR/UL-UR - Component terminal block				Component terminal block	3215041	PXC		PXC.3215041				
=UBCJA10GH100+UBCJA10	X101	1	Rated voltage: 250V, 50Hz Rated current: 16A				Socket-outlet	A9A15310	SE		SE.A9A15310				
=UBCJA10GH100+UBCJA10	XT1...XT4	34	Test disconnect terminal block, nom. voltage: 500 V, nominal current: 41 A, connection method: Screw connection, 1 level, Rated cross section: 6 mm2, cross section: 0.5 mm2 - 10 mm2 , mounting type: NS 35/7,5, NS 35/15, NS 32, color: gray				URTK 6 Test disconnect terminal block	3026272	PXC		PXC.3026272				
=UBCJA10GH100+UBCJA10	XT1...XT4	13	Slide-type terminal block, with slide, nom. voltage: 400 V, nominal current: 41 A, number of connections: 2, connection method: Screw connection, 1 level, Rated cross section: 6 mm2, cross section: 0.5 mm2 - 10 mm2, mounting type: NS 35/7,5, NS 35/15, NS 32, color: gray				UGSK 6 Test disconnect terminal block	3026285	PXC		PXC.3026285				

156

Approved by Contractor			Reconstruction and Modernisation of HPP Perucica - Phase II		 A Voith Company Sintaksa - A Voith Company Ulica Domovinskog rata 104C, 21 000 Split, Hrvatska	Unit KA2 control cubicle circuit diagrams	Summarized parts list	DRAWING No.:	REV No.:	= UBCJA10GH100					
Approved by Designer	Grga Kolić	01.10.2026.						PERU-01-19-170-31-002	02	+ UBCJA10					
Checked by	Antonio Aleksić	01.10.2026.						Designer No.:	SALES No.:	PAGE	157				
Drawn by	Tamara Trogrlić	01.10.2026.						PROJECT NAME	EMPLOYER	DESIGNER	PAGE	157 / 157			
1		2		3		4		5		6		7		8	

Format ISO/DIN A3